


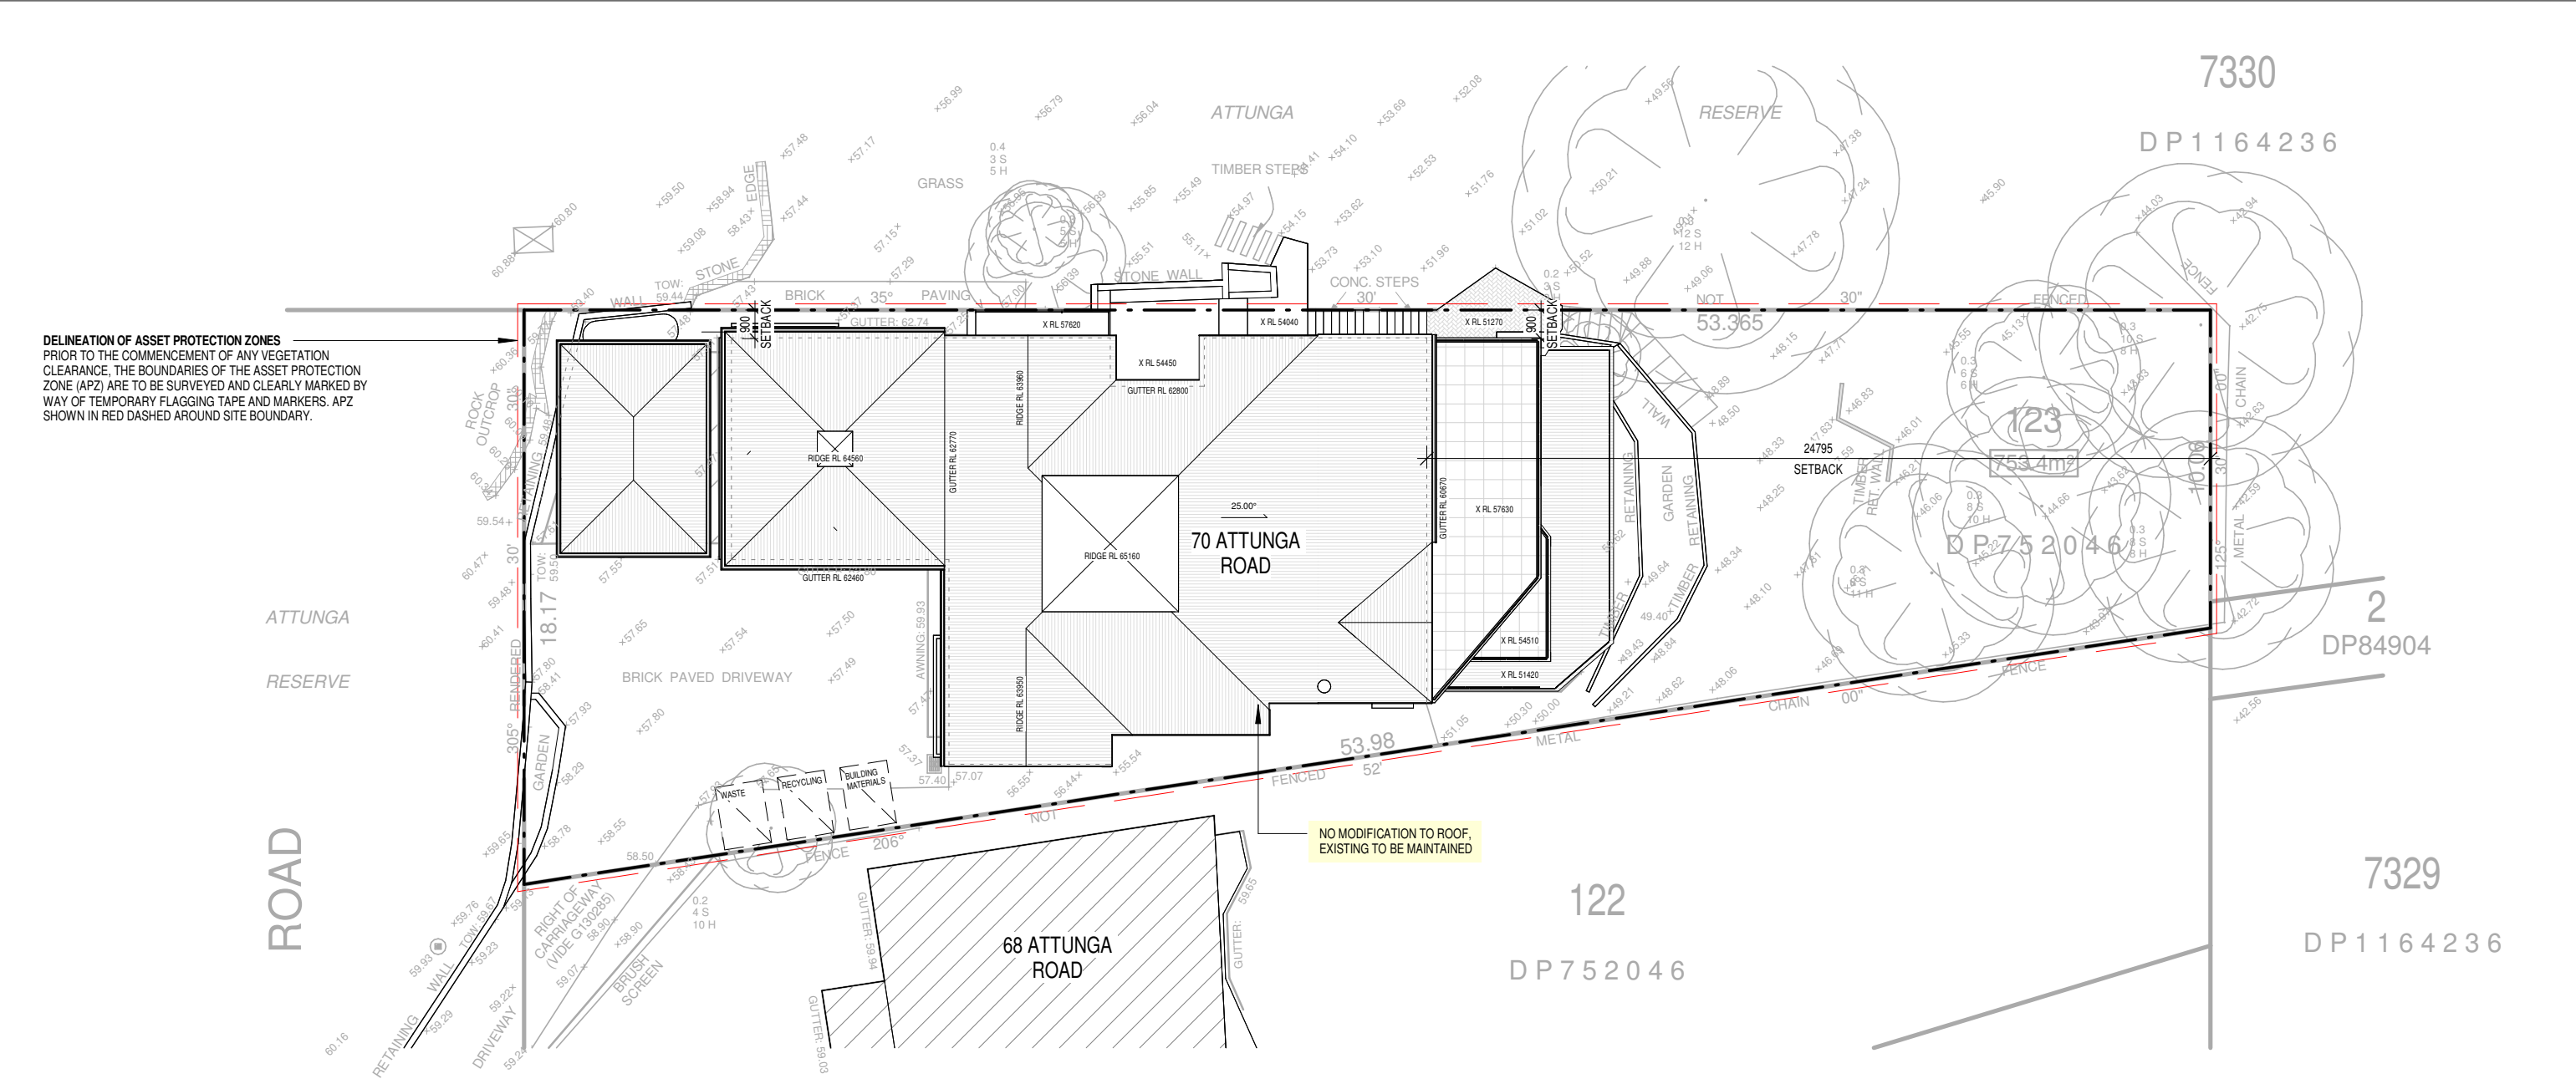

DELINEATION OF ASSET PROTECTION ZONES
PRIOR TO THE COMMENCEMENT OF ANY VEGETATION CLEARANCE, THE BOUNDARIES OF THE ASSET PROTECTION ZONE (APZ) ARE TO BE SURVEYED AND CLEARLY MARKED BY WAY OF TEMPORARY FLAGGING TAPE AND MARKERS. APZ SHOWN IN RED DASHED AROUND SITE BOUNDARY.

BUSHFIRE NOTES

BUILDING ELEVATION	CONSTRUCTION STANDARD (BUSHFIRE)
NORTH	BAL - FZ AS3959-2018
SOUTH	BAL - FZ
EAST	BAL - FZ
WEST	BAL - FZ

AS3959-2018 CONSTRUCTION STANDARDS FOR THE PROPOSED ALTERATIONS AND ADDITIONS TO THE EXISTING DWELLING

BUSHFIRE RECOMMENDATIONS:

THE PROPOSED CONSTRUCTION OF ALTERATIONS AND ADDITIONS TO THE EXISTING DWELLING ON THE SUBJECT LOT HAS BEEN ASSESSED AS BAL-FZ AND MUST BE CONSTRUCTED TO A VARIED SECTION 9 BAL-FZ OF AS 3959-2018.


THE EXISTING APZ IS DEEMED AN INNER PROTECTION AREA ON THE SUBJECT LOT AND AS SUCH ANY LANDSCAPING GARDENS AND THE LIKE SHOULD COMPLY WITH APPENDIX 4 PBP 018.

THE OCCUPANTS DEVELOP A BUSHFIRE EMERGENCY PLAN TO BE ABLE TO BE PREPARED FOR A BUSHFIRE EVENT IN THE VICINITY.

1 SITE PLAN
01 1 : 200

ARCHITECT'S WORK IS COPYRIGHT AND COVERED BY COPYRIGHT ACT 1968
DRAWINGS NOT TO BE SCALED, USE FIGURED DIMENSIONS ONLY. CHECK ALL DIMENSIONS ON SITE. PRIOR TO MANUFACTURE MEASURE ALL WINDOW/DOOR OPENINGS ON SITE. ELECTRONIC COPIES OF DRAWINGS SHOULD BE VERIFIED AGAINST PRINTED COPIES TO ENSURE NO LOSS OF INFORMATION. IF IN DOUBT ASK

ARCHITECT  reg# NSW 7417 - TIM WEST ph. 02 9918 5085 e. tim@thw.net.au m. Suite 101 - Level 1, 60 Old Barrenjoey rd, Avalon NSW, 2107	SURVEYOR DAW & WALTON CONSULTING SURVEYORS P: 02 8065 1156 E: SURVEY@DAW-WALTON.COM.AU	BIODIVERSITY ECOLOGICAL CONSULTANTS AUSTRALIA E: ECOLOGICALCA@OUTLOOK.COM M: 0488481929	GEOTECH ASCENT GEOTECHNICAL CONSULTANTS M: 02 9913 3179	PROJECT ALTERATIONS & ADDITIONS 70 ATTUNGA ROAD, NEWPORT, NSW, 2106	L	24/02/2023	SECTION 4.55	JOB NUM#	DRAWN BY	CHK. BY	PAGE SIZE
		H	16/06/2022	TENDER	185	MV	TW	A3			
		F	17/05/2022	REVISED CC	PROJECT NAME			SCALE			
		E	11/05/2022	CC	70 ATTUNGA RD			As indicated			
		D	29/04/2022	SYDNEY WATER	DRAWING NAME			DRAWING NUMBER			
		C	29/04/2022	CONSTRUCTION TRAFFIC MANAGEMENT PLAN	SITE & ROOF PLAN			A 01 -L			
	IS	DATE	COMMENTS								
CIVIL/STRUCTURAL/STORMWATER BARRENJOEY CONSULTING ENGINEERS E: LUCAS8CE@BIGPOND.COM M: 0418 620 330	BUSHFIRE THE FIRE CONSULTANTS P: 0418 460 517	SEWER MGP E: TBALD@MGP.COM.AU P: 02 9451 7555	CLIENT MICHAEL & SHONA LORIGAN COLMLORIGAN@GMAIL.COM								

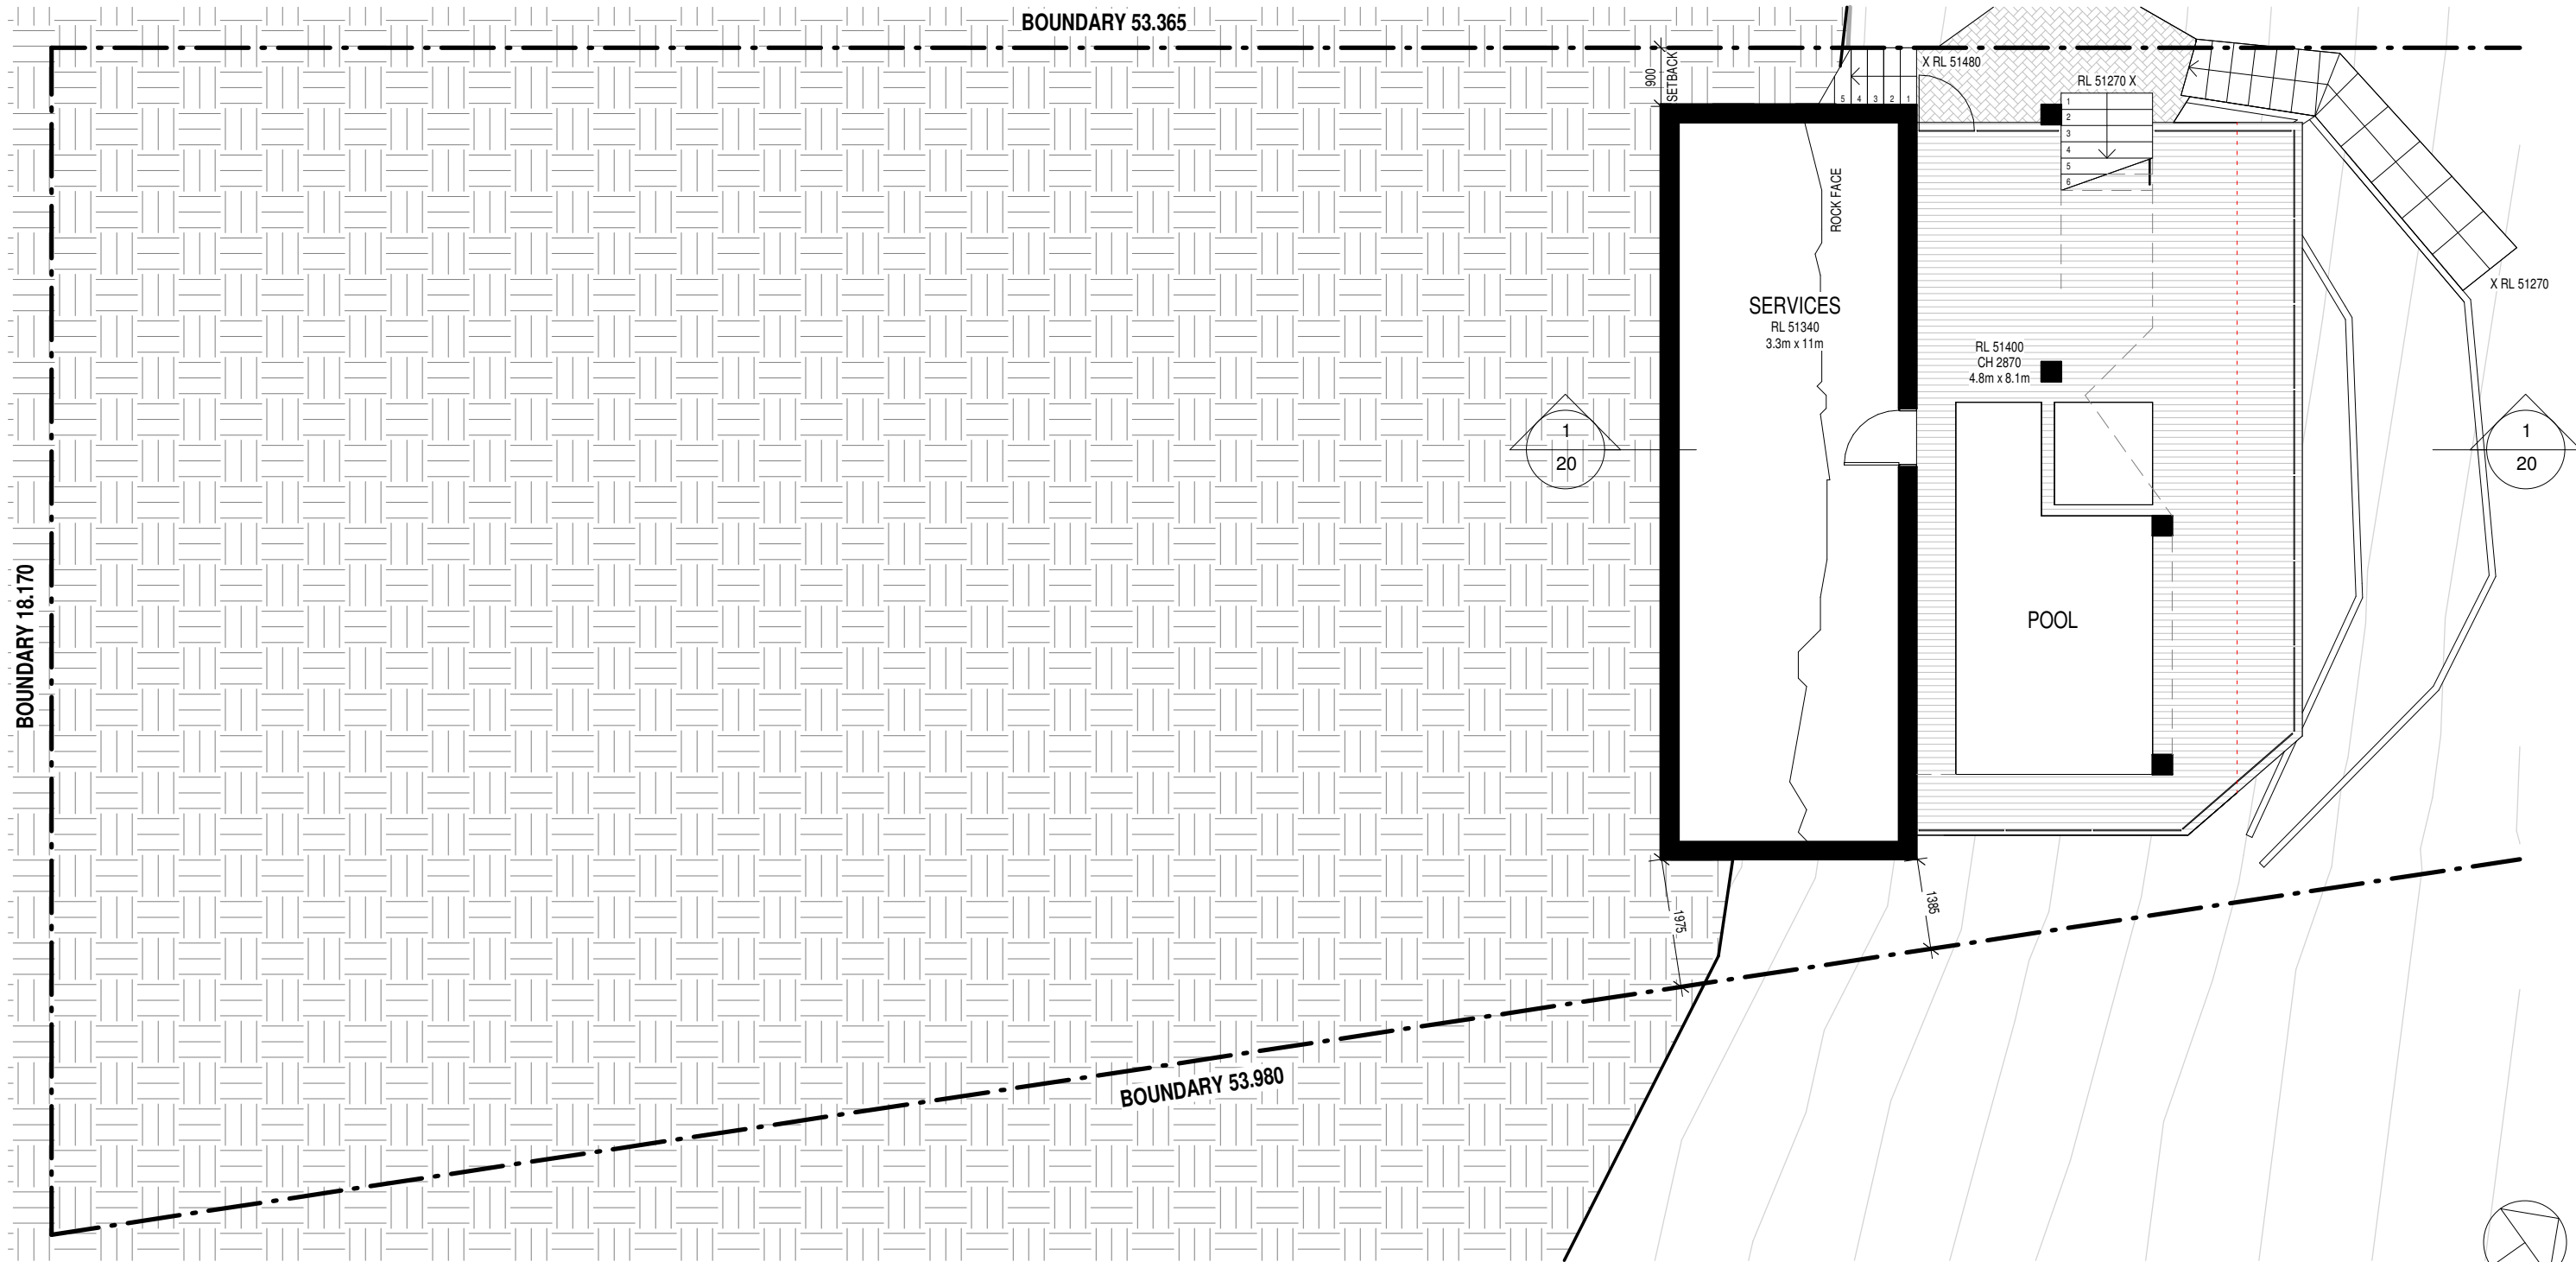

1 LEVEL 1 FLOOR PLAN
10 02 1:100

ARCHITECT'S WORK IS COPYRIGHT AND COVERED BY COPYRIGHT ACT 1968

DRAWINGS NOT TO BE SCALED. USE FIGURED DIMENSIONS ONLY. CHECK ALL DIMENSIONS ON SITE. PRIOR TO MANUFACTURE MEASURE ALL WINDOW/DOOR OPENINGS ON SITE. ELECTRONIC COPIES OF DRAWINGS SHOULD BE VERIFIED AGAINST PRINTED COPIES TO ENSURE NO LOSS OF INFORMATION. IF IN DOUBT ASK



reg# NSW 7417 - TIM WEST
ph. 02 9918 5085
e. tim@thw.net.au
m. Suite 101 - Level 1, 60 Old Barrenjoey rd, Avalon NSW, 2107

ARCHITECT

SURVEYOR
DAW & WALTON CONSULTING SURVEYORS
P: 02 8065 1156
E: SURVEY@DAW-WALTON.COM.AU

CIVIL/STRUCTURAL/STORMWATER
BARRENJOEY CONSULTING ENGINEERS
E: LUCAS8CE@BIGPOND.COM
M: 0418 620 330

BIODIVERSITY
ECOLOGICAL CONSULTANTS AUSTRALIA
E: ECOLOGICALCA@OUTLOOK.COM
M: 0488481929

BUSHFIRE
THE FIRE CONSULTANTS
P: 0418 460 517

GEOTECH
ASCENT GEOTECHNICAL CONSULTANTS
M: 02 9913 3179


SEWER
MGP
E: TBALD@MGP.COM.AU
P: 02 9451 7555

PROJECT
ALTERATIONS & ADDITIONS
70 ATTUNGA ROAD, NEWPORT, NSW, 2106

CLIENT
MICHAEL & SHONA LORIGAN
COLMLORIGAN@GMAIL.COM

L	24/02/2023	SECTION 4.55
H	16/06/2022	TENDER
F	17/05/2022	REVISED CC
E	11/05/2022	CC
A	27/09/2021	DA
IS	DATE	COMMENTS

JOB NUM# 185	DRAWN BY MV	CHK. BY TW	PAGE SIZE A3
PROJECT NAME 70 ATTUNGA RD			SCALE 1:100
DRAWING NAME LEVEL 1 FLOOR PLAN			DRAWING NUMBER A 02 -L

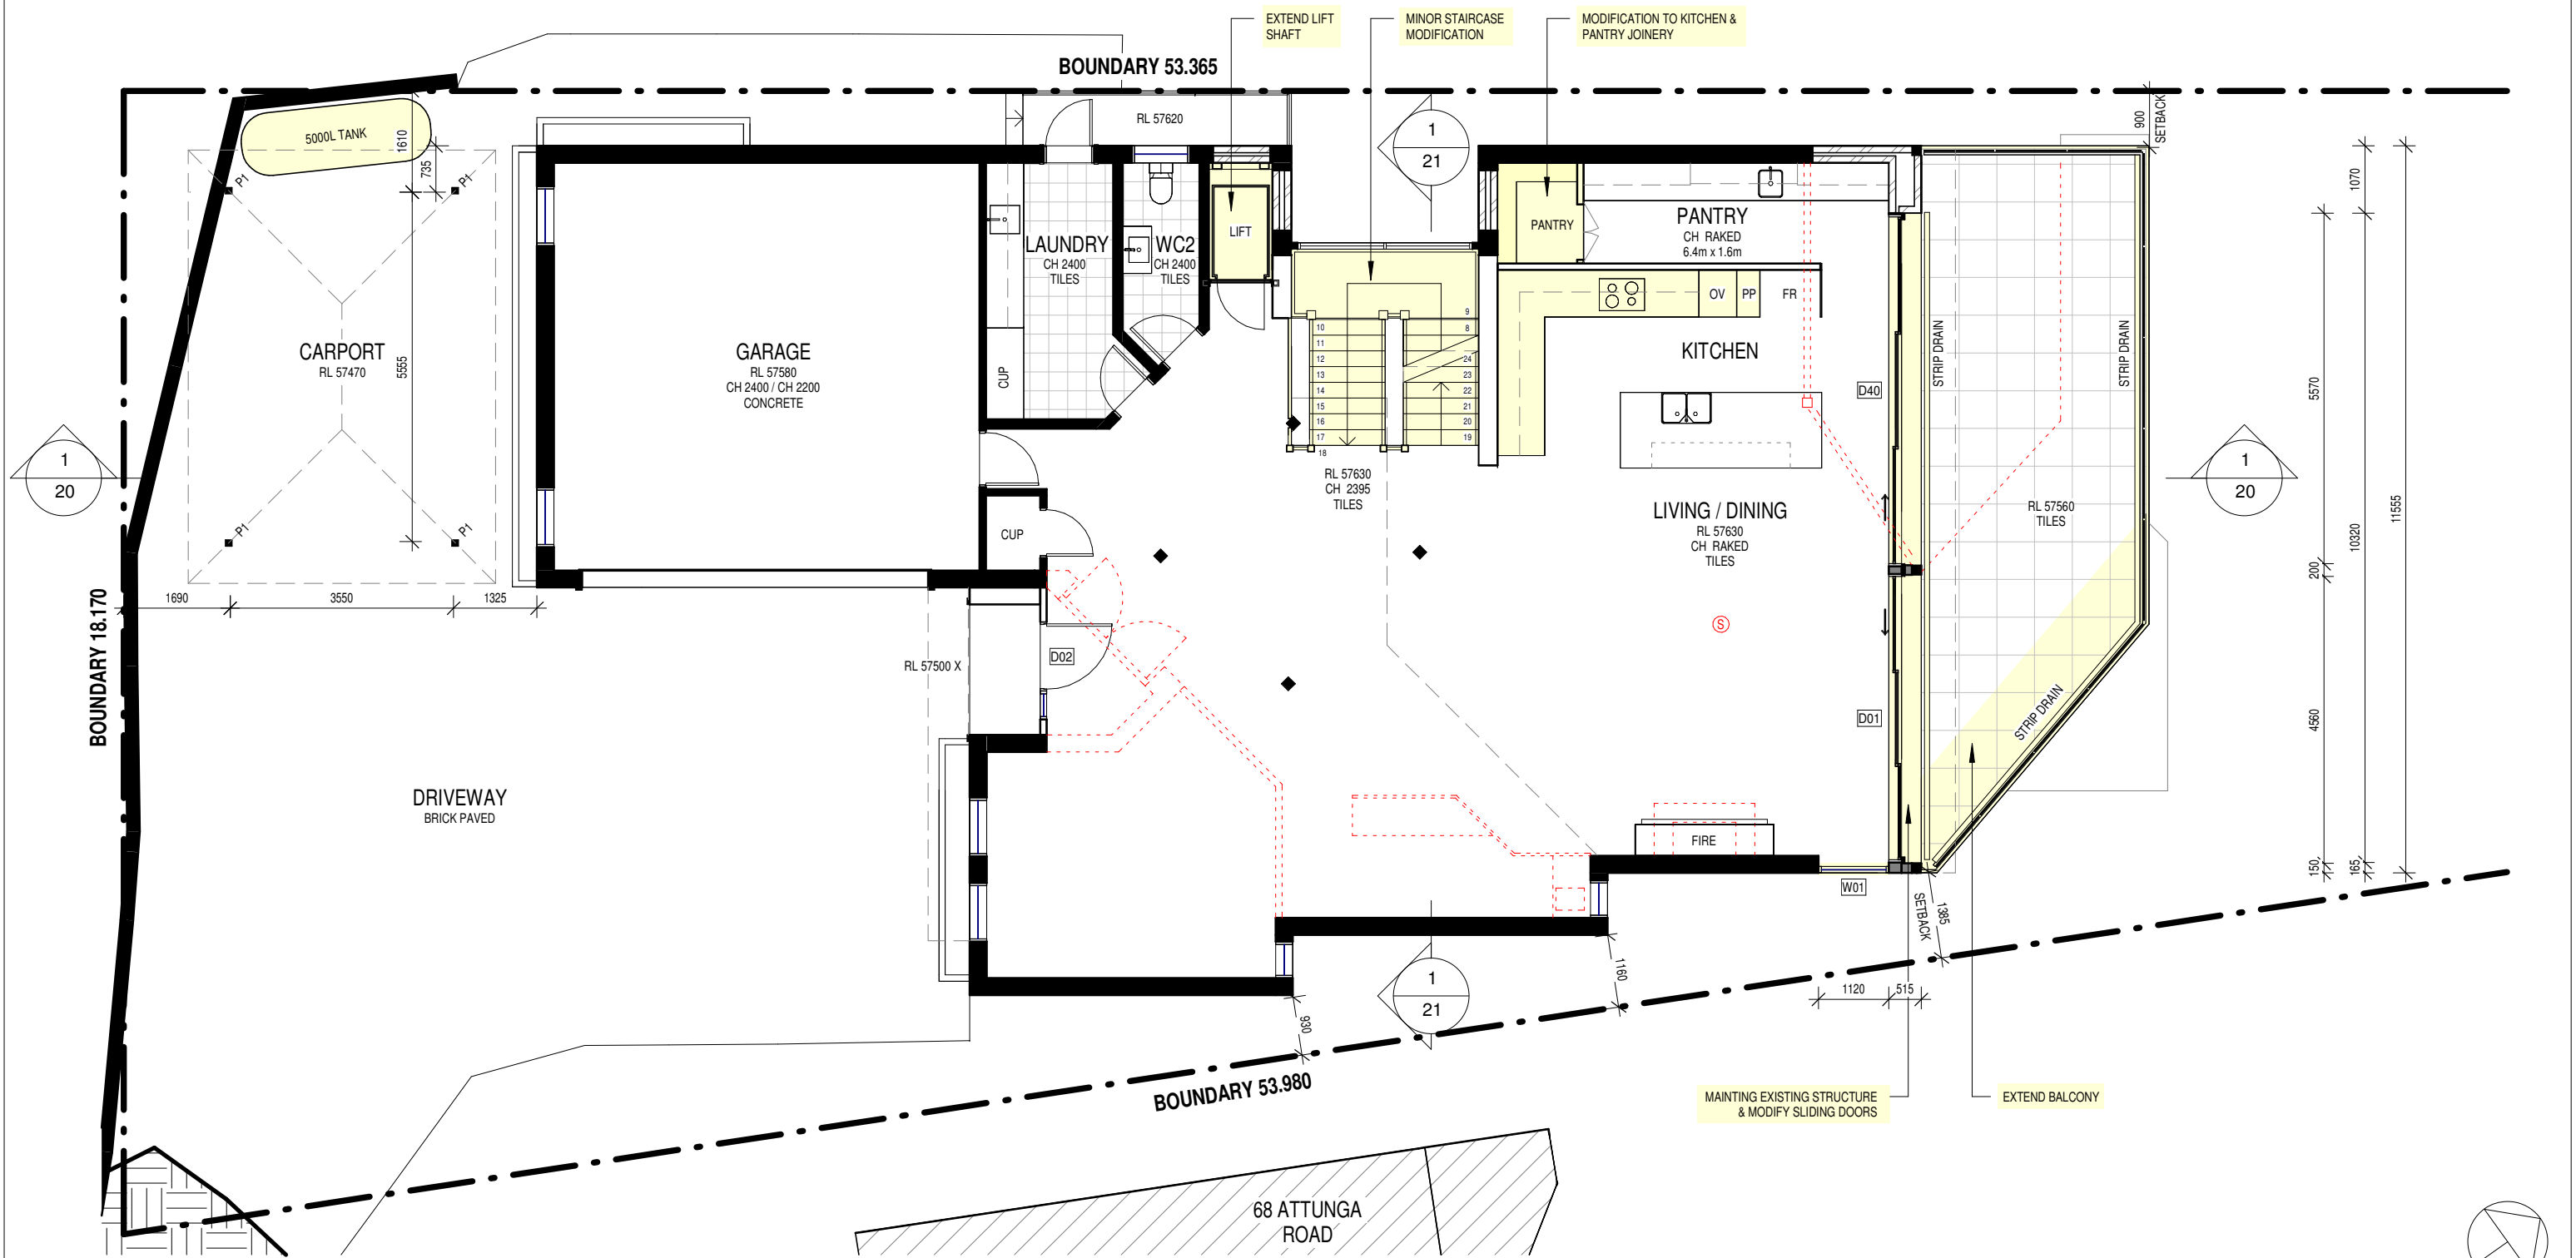

LEVEL 3 FLOOR PLAN

1
10 04
1 : 100

- STUD WALL
- SINGLE BRICK
- DOUBLE BRICK
- SMOKE ALARM (S)
- DEMOLISHED
- HIDDEN
- OVERHEAD
- EXISTING
- PROPOSED
- NEW WORKS

0 5 10 m

ARCHITECT'S WORK IS COPYRIGHT AND COVERED BY COPYRIGHT ACT 1968

DRAWINGS NOT TO BE SCALED. USE FIGURED DIMENSIONS ONLY. CHECK ALL DIMENSIONS ON SITE. PRIOR TO MANUFACTURE MEASURE ALL WINDOW/DOOR OPENINGS ON SITE. ELECTRONIC COPIES OF DRAWINGS SHOULD BE VERIFIED AGAINST PRINTED COPIES TO ENSURE NO LOSS OF INFORMATION. IF IN DOUBT ASK



reg# NSW 7417 - TIM WEST
ph. 02 9918 5085
e. tim@thw.net.au
m. Suite 101 - Level 1, 60 Old Barrenjoey rd, Avalon NSW, 2107

SURVEYOR

DAW & WALTON CONSULTING SURVEYORS
P: 02 8065 1156
E: SURVEY@DAW-WALTON.COM.AU

CIVIL/STRUCTURAL/STORMWATER

BARRENJOEY CONSULTING ENGINEERS
E: LUCAS8CE@BIGPOND.COM
M: 0418 620 330

BIODIVERSITY

ECOLOGICAL CONSULTANTS AUSTRALIA
E: ECOLOGICALCA@OUTLOOK.COM
M: 0488481929

BUSHFIRE

THE FIRE CONSULTANTS
P: 0418 460 517

GEOTECH

ASCENT GEOTECHNICAL CONSULTANTS
M: 02 9913 3179

SEWER

MGP
E: TBALD@MGP.COM.AU
P: 02 9451 7555

PROJECT


ALTERATIONS & ADDITIONS
70 ATTUNGA ROAD, NEWPORT, NSW, 2106

CLIENT

MICHAEL & SHONA LORIGAN
COLMLORIGAN@GMAIL.COM

L	24/02/2023	SECTION 4.55
K	16/02/2023	STAIR & JOINERY AMENDMENT
I	02/12/2022	LIFT UPDATE
H	16/06/2022	TENDER
F	17/05/2022	REVISED CC
E	11/05/2022	CC
A	27/09/2021	DA
IS	DATE	COMMENTS

JOB NUM#	185	DRAWN BY	MV	CHK. BY	TW	PAGE SIZE	A3
PROJECT NAME						SCALE	
70 ATTUNGA RD						1 : 100	
DRAWING NAME						DRAWING NUMBER	
LEVEL 3 FLOOR PLAN						A 04 -L	

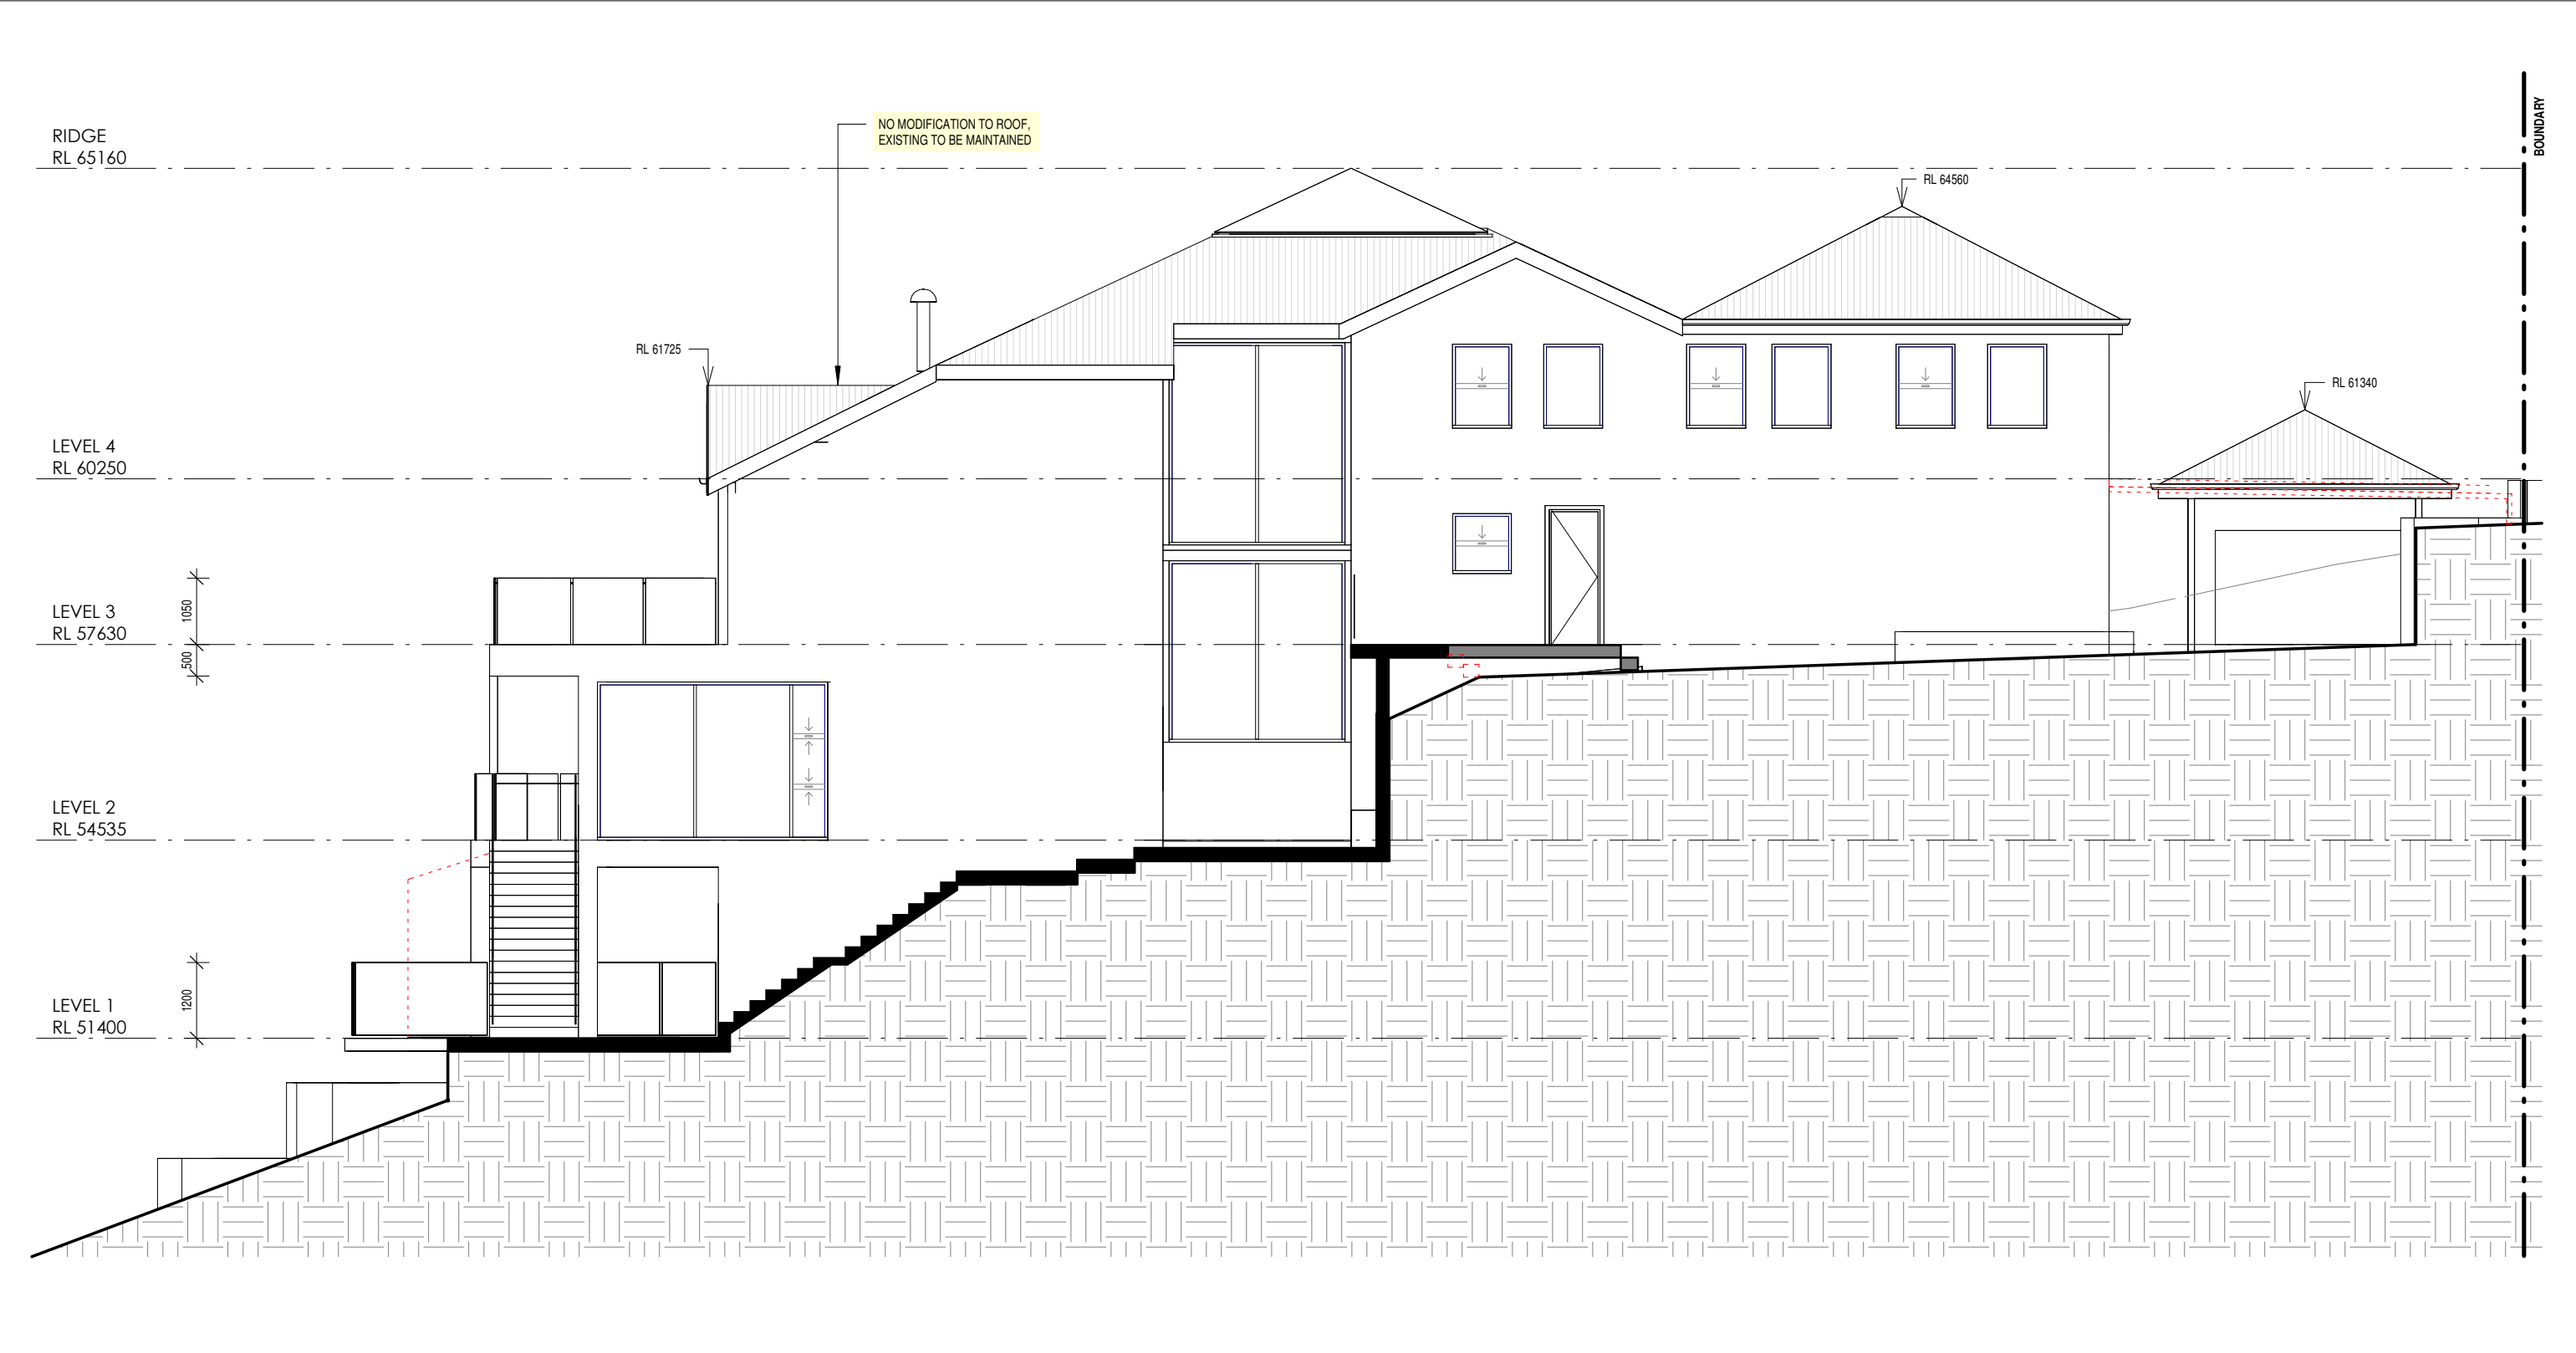


1 NORTH ELEVATION
10 1 : 100

ARCHITECT'S WORK IS COPYRIGHT AND COVERED BY COPYRIGHT ACT 1968
DRAWINGS NOT TO BE SCALED. USE FIGURED DIMENSIONS ONLY. CHECK ALL DIMENSIONS ON SITE. PRIOR TO MANUFACTURE MEASURE ALL WINDOW/DOOR OPENINGS ON SITE. ELECTRONIC COPIES OF DRAWINGS SHOULD BE VERIFIED AGAINST PRINTED COPIES TO ENSURE NO LOSS OF INFORMATION. IF IN DOUBT ASK

0510m

DEMOLISHED
HIDDEN
OVERHEAD
EXISTING
PROPOSED
NEW WORKS

ARCHITECT THW ARCHITECTS reg# NSW 7417 - TIM WEST ph. 02 9918 5085 e. tim@thw.net.au m. Suite 101 - Level 1, 60 Old Barrenjoey rd, Avalon NSW, 2107	SURVEYOR DAW & WALTON CONSULTING SURVEYORS P: 02 8065 1156 E: SURVEY@DAW-WALTON.COM.AU	BIODIVERSITY ECOLOGICAL CONSULTANTS AUSTRALIA E: ECOLOGICALCA@OUTLOOK.COM M: 0488481929	GEOTECH ASCENT GEOTECHNICAL CONSULTANTS M: 02 9913 3179	PROJECT ALTERATIONS & ADDITIONS 70 ATTUNGA ROAD, NEWPORT, NSW, 2106				JOB NUM# 185	DRAWN BY MV	CHK. BY TW	PAGE SIZE A3
	CIVIL/STRUCTURAL/STORMWATER BARRENJOEY CONSULTING ENGINEERS E: LUCAS8CE@BIGPOND.COM M: 0418 620 330	BUSHFIRE THE FIRE CONSULTANTS P: 0418 460 517	SEWER MGP E: TBALD@MGP.COM.AU P. 02 9451 7555	CLIENT MICHAEL & SHONA LORIGAN COLMLORIGAN@GMAIL.COM	L	24/02/2023	SECTION 4.55	PROJECT NAME 70 ATTUNGA RD		SCALE 1 : 100	
					H	16/06/2022	TENDER	DRAWING NAME ELEVATIONS		DRAWING NUMBER A 10 -L	
					F	17/05/2022	REVISED CC				
					E	11/05/2022	CC				
A	27/09/2021	DA	IS	DATE	COMMENTS						

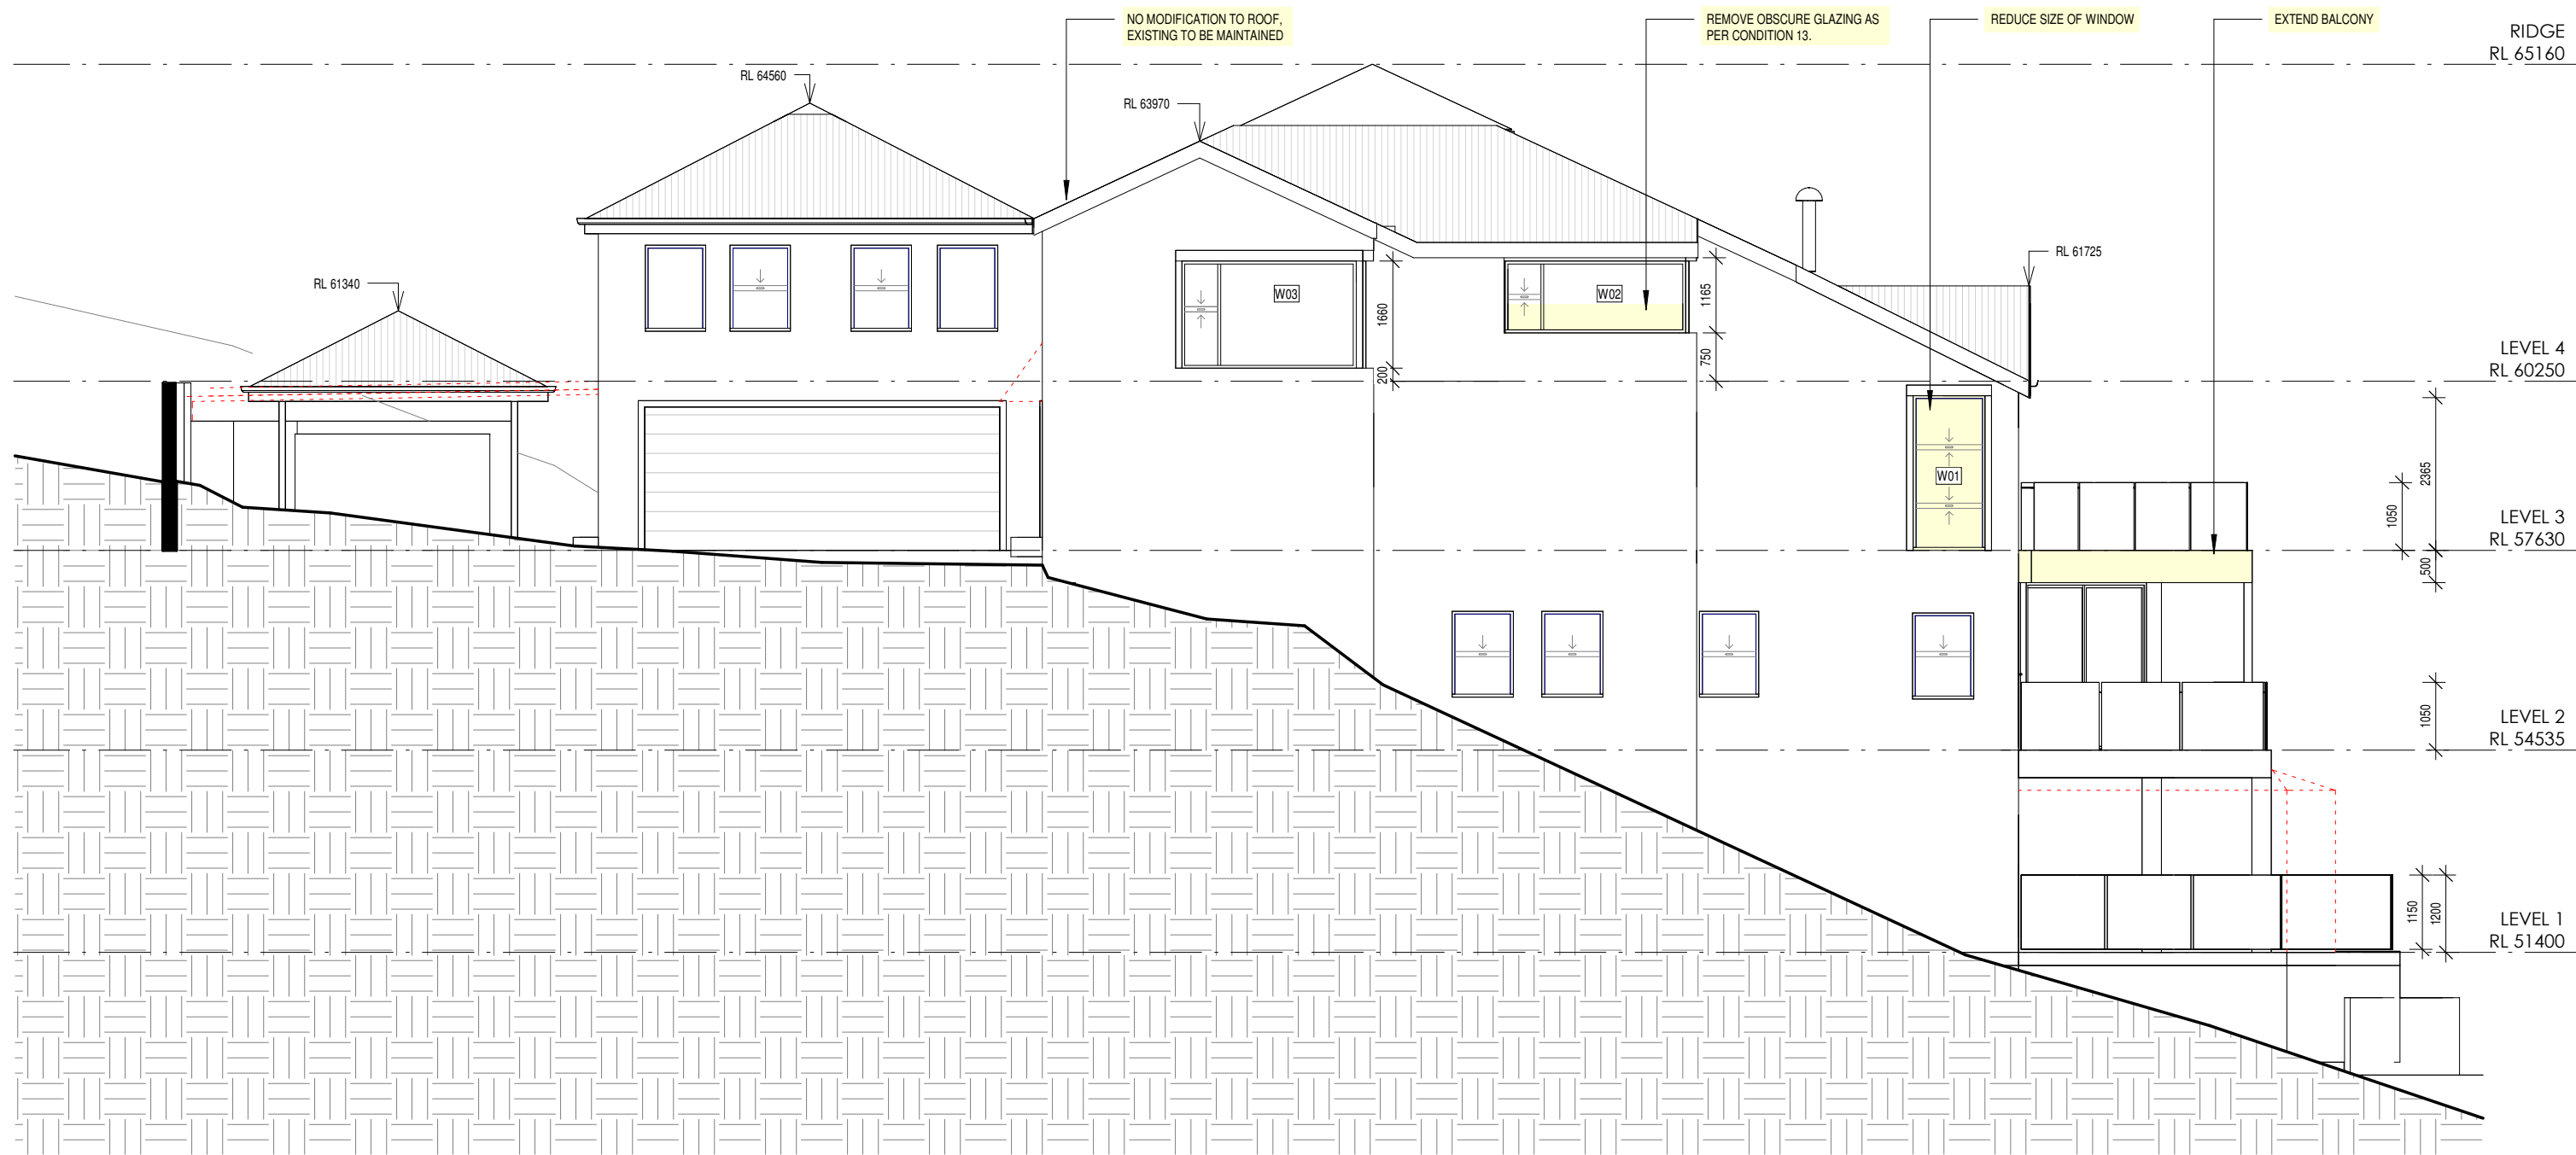

1 SOUTH ELEVATION
11 1:100

ARCHITECT'S WORK IS COPYRIGHT AND COVERED BY COPYRIGHT ACT 1968

DRAWINGS NOT TO BE SCALED. USE FIGURED DIMENSIONS ONLY. CHECK ALL DIMENSIONS ON SITE. PRIOR TO MANUFACTURE MEASURE ALL WINDOW/DOOR OPENINGS ON SITE. ELECTRONIC COPIES OF DRAWINGS SHOULD BE VERIFIED AGAINST PRINTED COPIES TO ENSURE NO LOSS OF INFORMATION. IF IN DOUBT ASK

ARCHITECT

THW
ARCHITECTS

reg# NSW 7417 - TIM WEST
ph. 02 9918 5085
e. tim@thw.net.au
m. Suite 101 - Level 1, 60 Old Barrenjoey rd, Avalon NSW, 2107

SURVEYOR
DAW & WALTON CONSULTING SURVEYORS
P: 02 8065 1156
E: SURVEY@DAW-WALTON.COM.AU

CIVIL/STRUCTURAL/STORMWATER
BARRENJOEY CONSULTING ENGINEERS
E: LUCAS8CE@BIGPOND.COM
M: 0418 620 330

BIODIVERSITY
ECOLOGICAL CONSULTANTS AUSTRALIA
E: ECOLOGICALCA@OUTLOOK.COM
M: 0488481929

BUSHFIRE
THE FIRE CONSULTANTS
P: 0418 460 517

GEOTECH
ASCENT GEOTECHNICAL CONSULTANTS
M: 02 9913 3179


SEWER
MGP
E: TBALD@MGP.COM.AU
P: 02 9451 7555

PROJECT
ALTERATIONS & ADDITIONS
70 ATTUNGA ROAD, NEWPORT, NSW, 2106

CLIENT
MICHAEL & SHONA LORIGAN
COLMLORIGAN@GMAIL.COM

L	24/02/2023	SECTION 4.55
H	16/06/2022	TENDER
E	17/05/2022	REVISED CC
F	11/05/2022	CC
A	27/09/2021	DA
IS	DATE	COMMENTS

JOB NUM#	185	DRAWN BY	MV	CHK. BY	TW	PAGE SIZE	A3
PROJECT NAME	70 ATTUNGA RD					SCALE	1:100
DRAWING NAME	ELEVATIONS					DRAWING NUMBER	A 11 -L

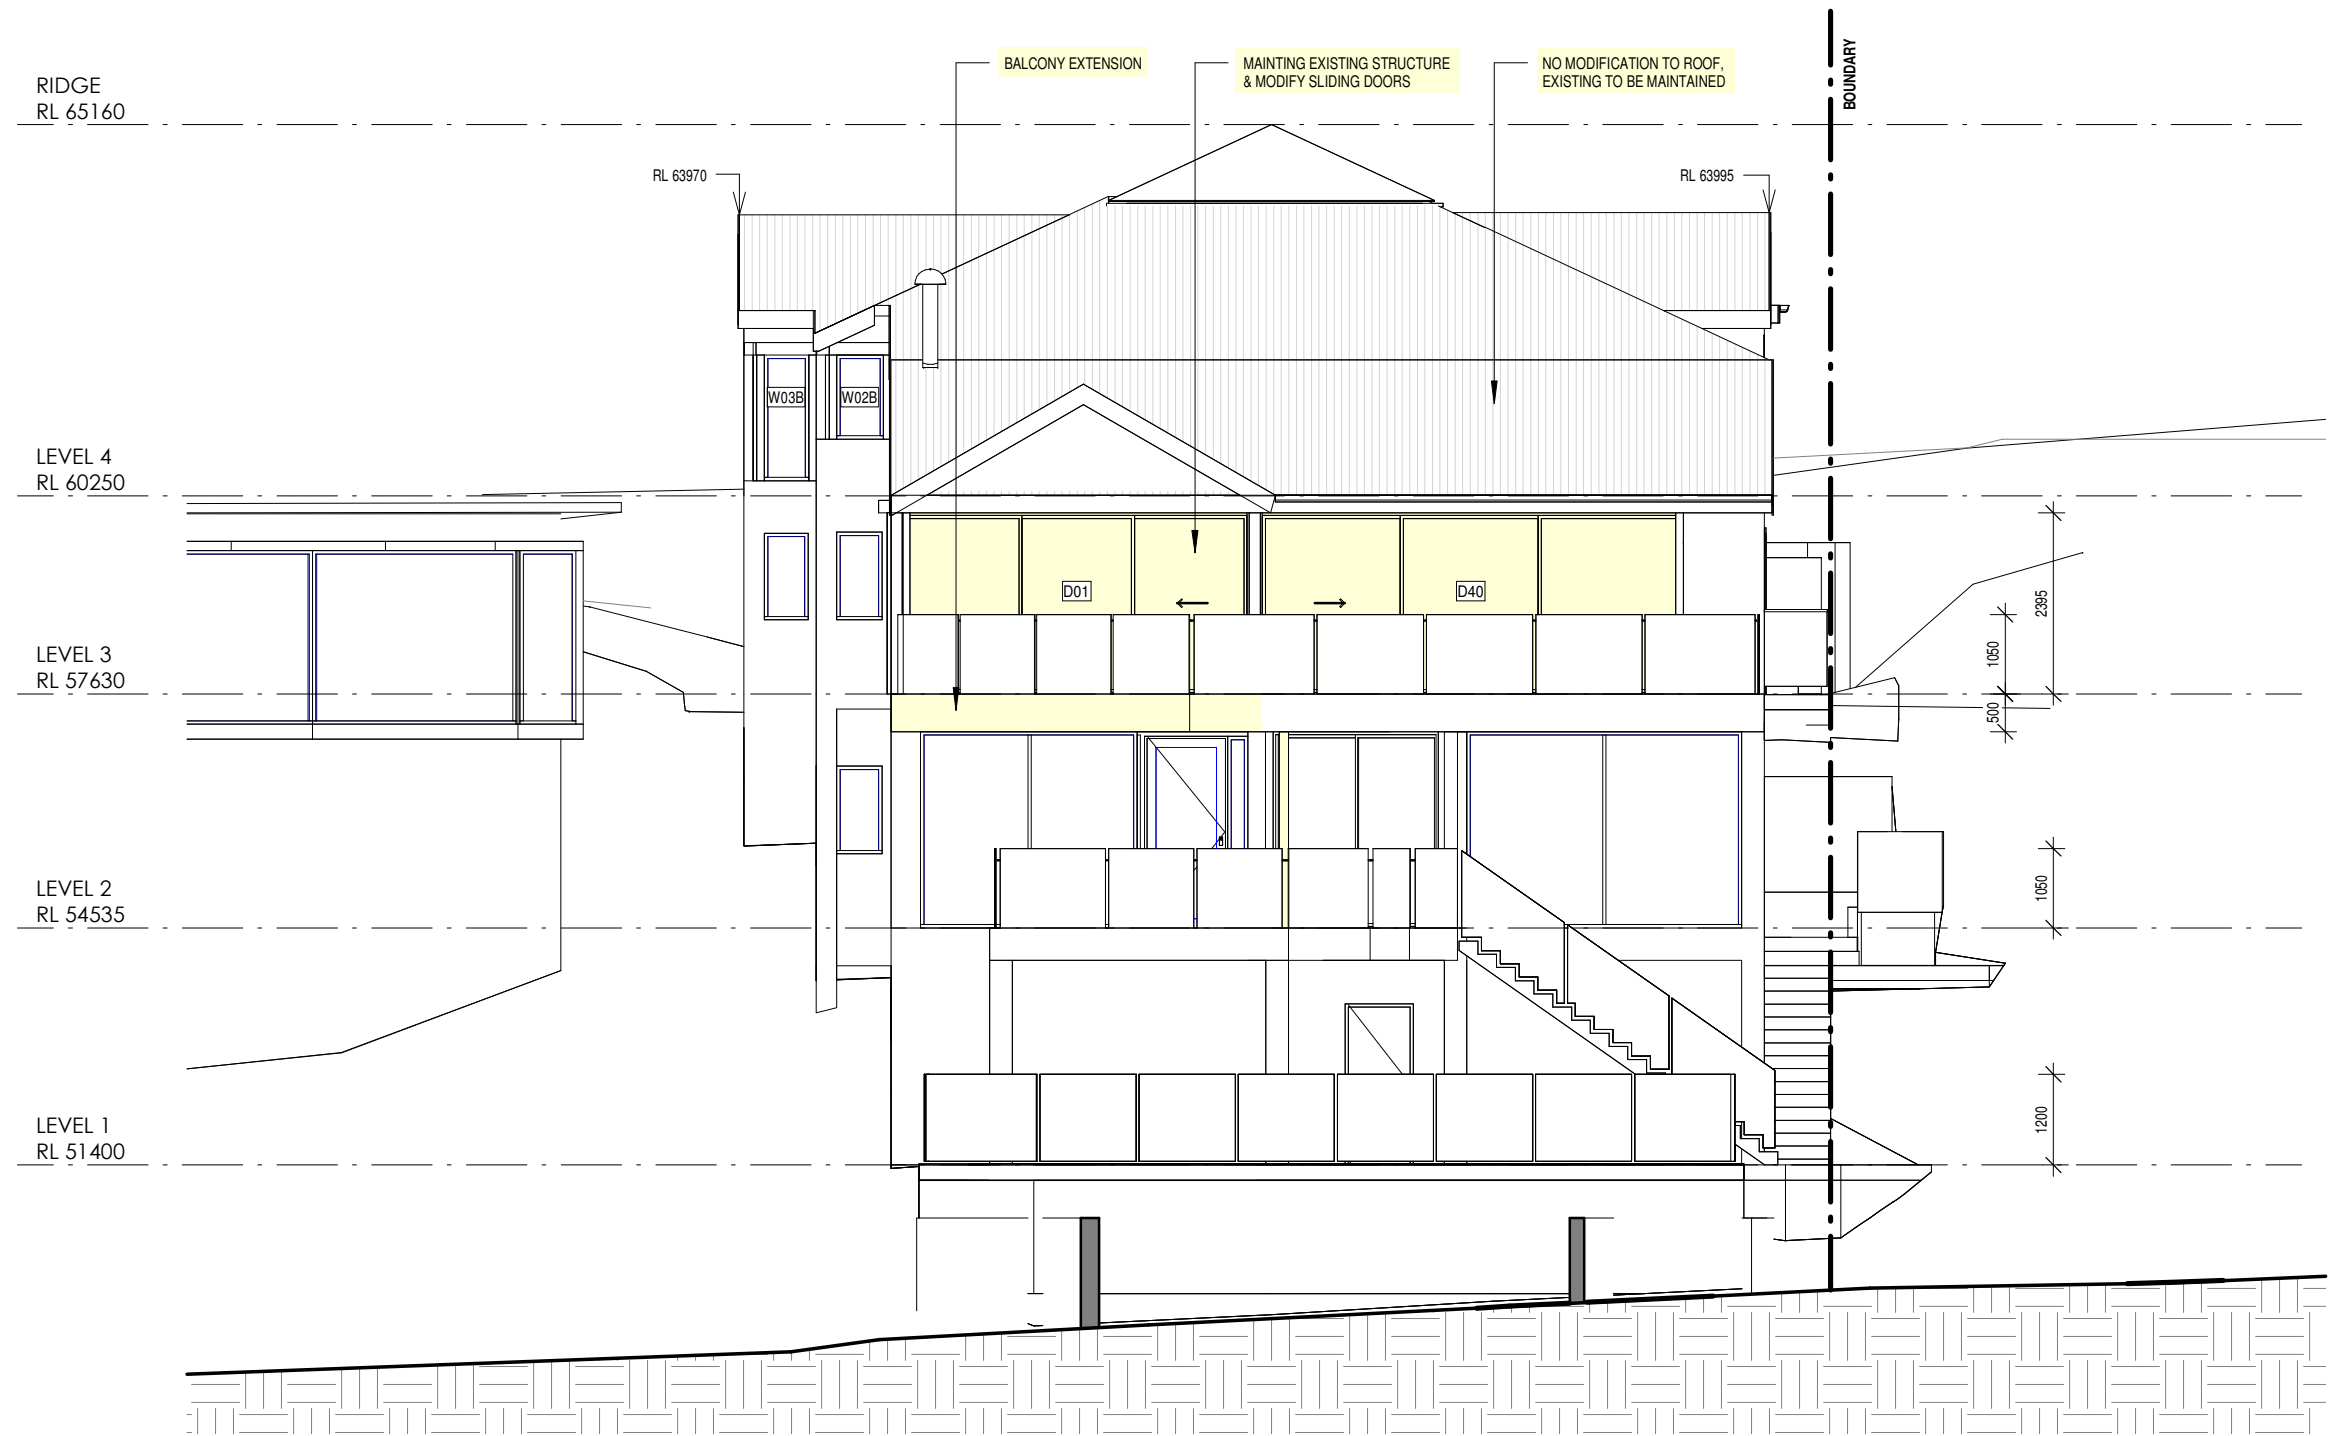

ARCHITECT'S WORK IS COPYRIGHT AND COVERED BY COPYRIGHT ACT 1968
DRAWINGS NOT TO BE SCALED. USE FIGURED DIMENSIONS ONLY. CHECK ALL DIMENSIONS ON SITE. PRIOR TO MANUFACTURE MEASURE ALL WINDOW/DOOR OPENINGS ON SITE. ELECTRONIC COPIES OF DRAWINGS SHOULD BE VERIFIED AGAINST PRINTED COPIES TO ENSURE NO LOSS OF INFORMATION. IF IN DOUBT ASK



reg# NSW 7417 - TIM WEST
ph. 02 9918 5085
e. tim@thw.net.au
m. Suite 101 - Level 1, 60 Old Barrenjoey rd, Avalon NSW, 2107

SURVEYOR

DAW & WALTON CONSULTING SURVEYORS
P: 02 8065 1156
E: SURVEY@DAW-WALTON.COM.AU

CIVIL/STRUCTURAL/STORMWATER

BARRENJOEY CONSULTING ENGINEERS
E: LUCAS8CE@BIGPOND.COM
M: 0418 620 330

BIODIVERSITY

ECOLOGICAL CONSULTANTS AUSTRALIA
E: ECOLOGICALCA@OUTLOOK.COM
M: 0488481929

BUSHFIRE

THE FIRE CONSULTANTS
P: 0418 460 517

GEOTECH

ASCENT GEOTECHNICAL CONSULTANTS
M: 02 9913 3179

SEWER

MGP
E: TBALD@MGP.COM.AU
P: 02 9451 7555

PROJECT


ALTERATIONS & ADDITIONS
70 ATTUNGA ROAD, NEWPORT, NSW, 2106

CLIENT


MICHAEL & SHONA LORIGAN
COLMLORIGAN@GMAIL.COM

L	24/02/2023	SECTION 4.55
H	16/06/2022	TENDER
F	17/05/2022	REVISED CC
E	11/05/2022	CC
A	27/09/2021	DA
IS	DATE	COMMENTS

JOB NUM#	DRAWN BY	CHK. BY	PAGE SIZE
185	MV	TW	A3
PROJECT NAME			SCALE
70 ATTUNGA RD			1 : 100
DRAWING NAME			DRAWING NUMBER
ELEVATIONS			A 12 -L

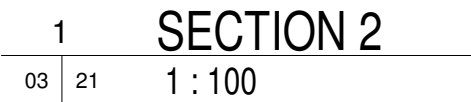


ARCHITECT  reg# NSW 7417 - TIM WEST ph. 02 9918 5085 e. tim@thw.net.au m. Suite 101 - Level 1, 60 Old Barrenjoey rd, Avalon NSW, 2107	SURVEYOR DAW & WALTON CONSULTING SURVEYORS P: 02 8065 1156 E: SURVEY@DAW-WALTON.COM.AU	BIODIVERSITY ECOLOGICAL CONSULTANTS AUSTRALIA E: ECOLOGICALCA@OUTLOOK.COM M: 0488481929	GEOTECH ASCENT GEOTECHNICAL CONSULTANTS M: 02 9913 3179	PROJECT ALTERATIONS & ADDITIONS 70 ATTUNGA ROAD, NEWPORT, NSW, 2106				JOB NUM# 185	DRAWN BY MV	CHK. BY TW	PAGE SIZE A3
	CIVIL/STRUCTURAL/STORMWATER BARRENJOEY CONSULTING ENGINEERS E: LUCASBCE@BIGPOND.COM M: 0418 620 330	BUSHFIRE THE FIRE CONSULTANTS P: 0418 460 517	SEWER MGP E: TBALD@MGP.COM.AU P: 02 9451 7555	CLIENT MICHAEL & SHONA LORIGAN COLMLORIGAN@GMAIL.COM	L	24/02/2023	SECTION 4.55	PROJECT NAME 70 ATTUNGA RD		SCALE 1 : 100	
					H	16/06/2022	TENDER				
					F	17/05/2022	REVISED CC	DRAWING NAME SECTION		DRAWING NUMBER A 21 -L	
E	11/05/2022	CC									
A	27/09/2021	DA									
IS	DATE	COMMENTS									

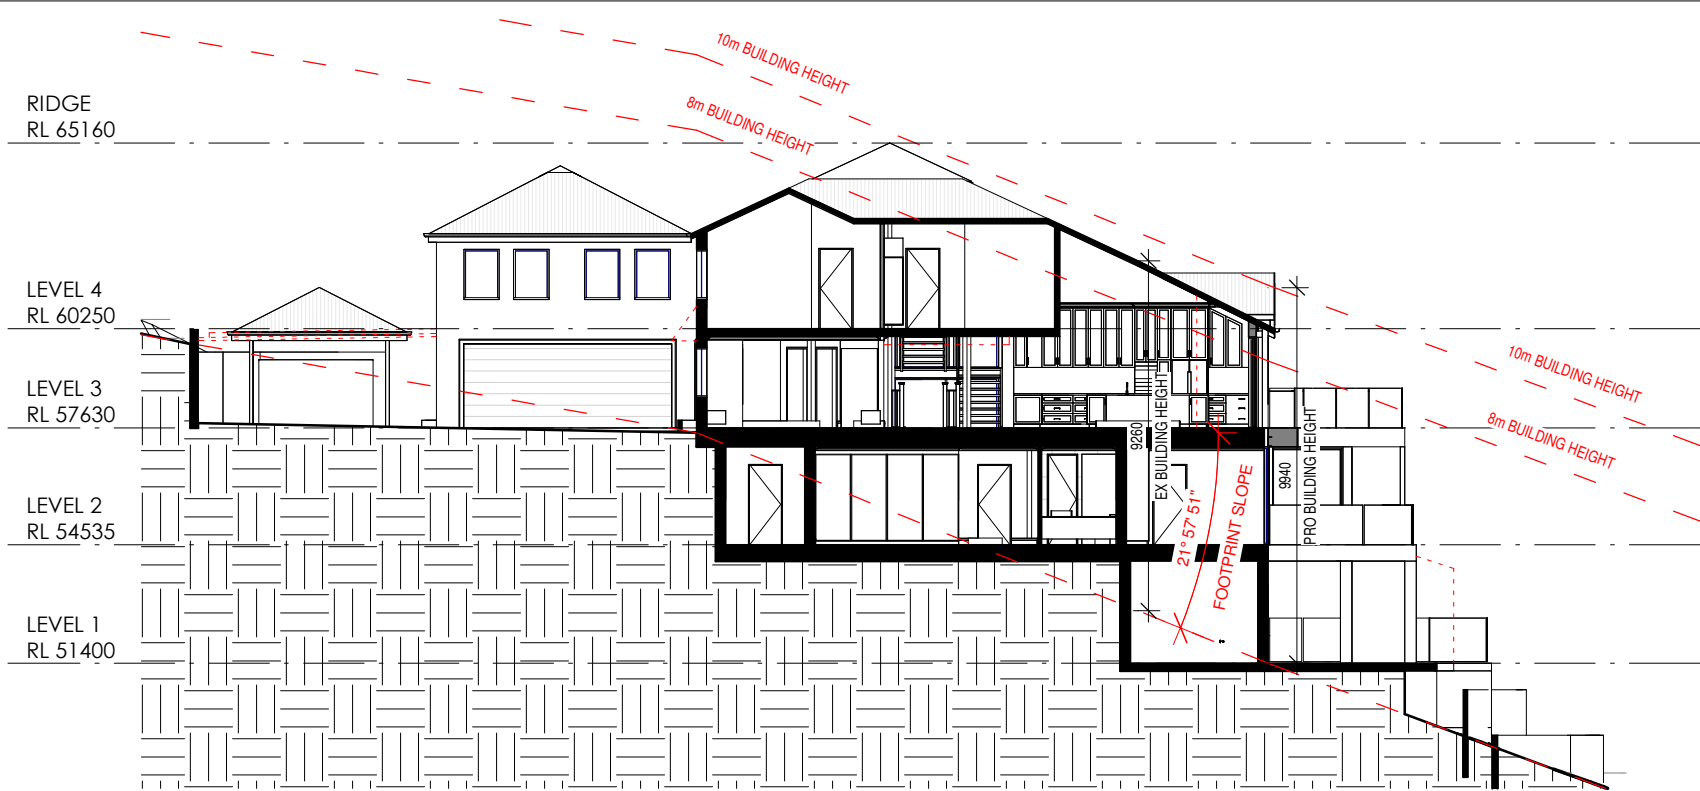


- LEGEND:**
- BUILDING ENVELOPE
 - BOUNDARY
 - EXISTING
 - PROPOSED
 - NEW WORKS
 - EX SITE FOOTPRINT
 - PRO SITE FOOTPRINT
 - EX HARD PAVING
 - PRO HARD PAVING
 - LANDSCAPED AREA
 - NON COMPLIANCE

1 ANALYSIS BUILDING HEIGHT & SLOPE
101 1 : 200

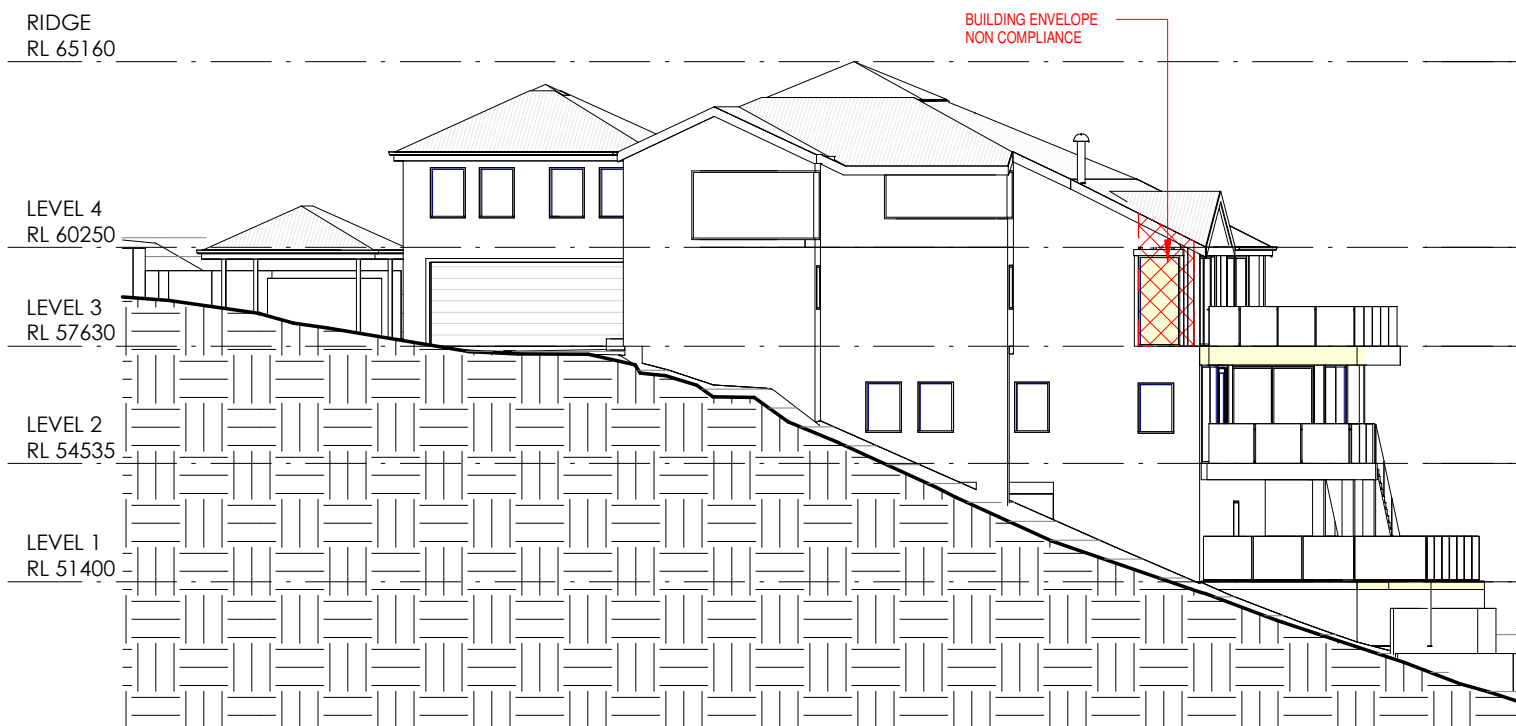


3 BUILDING ENVELOPE 2
101 1 : 200

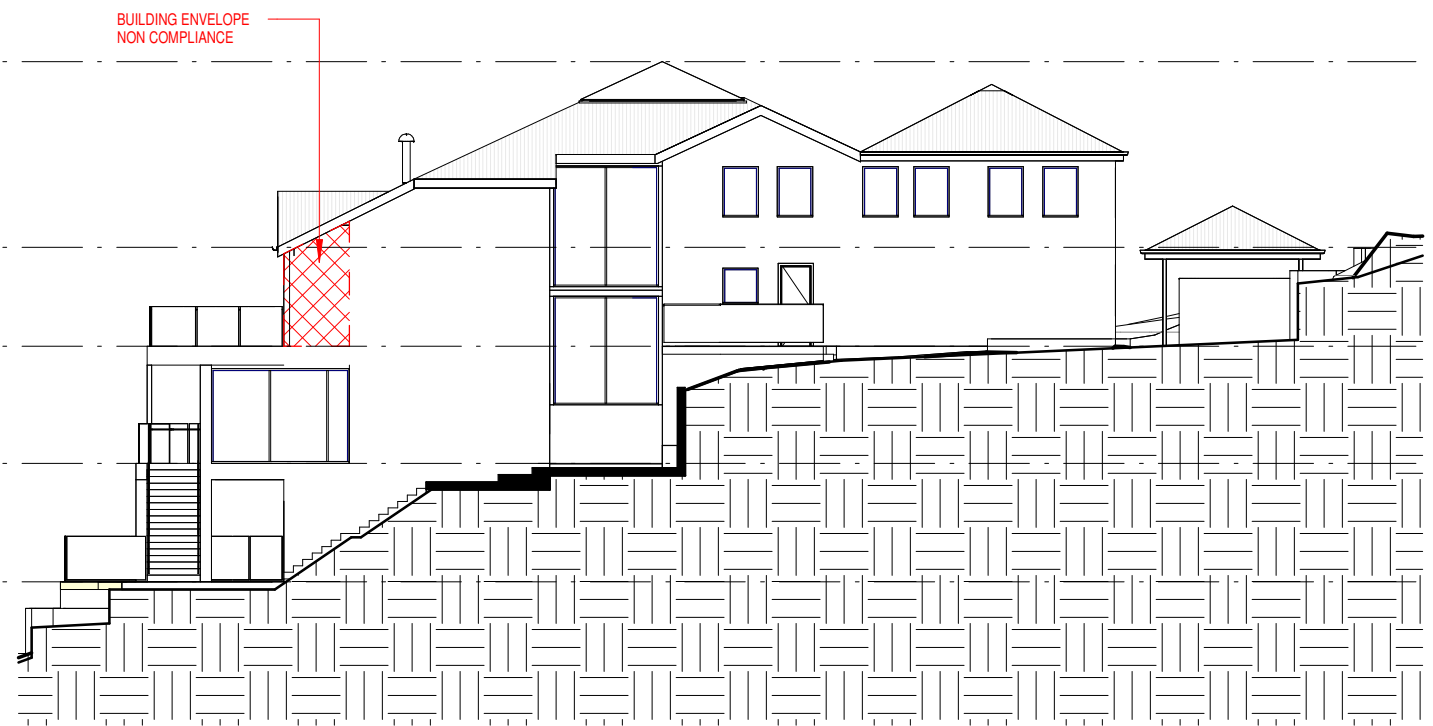


2 BUILDING ENVELOPE 1
101 1 : 200


ARCHITECT'S WORK IS COPYRIGHT AND COVERED BY COPYRIGHT ACT 1968
DRAWINGS NOT TO BE SCALED. USE FIGURED DIMENSIONS ONLY. CHECK ALL DIMENSIONS ON SITE. PRIOR TO MANUFACTURE MEASURE ALL WINDOW/DOOR OPENINGS ON SITE. ELECTRONIC COPIES OF DRAWINGS SHOULD BE VERIFIED AGAINST PRINTED COPIES TO ENSURE NO LOSS OF INFORMATION. IF IN DOUBT ASK

ARCHITECT  reg# NSW 7417 - TIM WEST ph. 02 9918 5085 e. tim@thw.net.au m. Suite 101 - Level 1, 60 Old Barrenjoey rd, Avalon NSW, 2107	SURVEYOR DAW & WALTON CONSULTING SURVEYORS P: 02 8065 1156 E: SURVEY@DAW-WALTON.COM.AU CIVIL/STRUCTURAL/STORMWATER BARRENJOEY CONSULTING ENGINEERS E: LUCAS8CE@BIGPOND.COM M: 0418 620 330	BIODIVERSITY ECOLOGICAL CONSULTANTS AUSTRALIA E: ECOLOGICALCA@OUTLOOK.COM M: 0488481929 BUSHFIRE THE FIRE CONSULTANTS P: 0418 460 517	GEOTECH ASCENT GEOTECHNICAL CONSULTANTS M: 02 9913 3179 SEWER MGP E: TBALD@MGP.COM.AU P: 02 9451 7555	PROJECT ALTERATIONS & ADDITIONS 70 ATTUNGA ROAD, NEWPORT, NSW, 2106 CLIENT MICHAEL & SHONA LORIGAN COLMLORIGAN@GMAIL.COM	L 24/02/2023 B 13/10/2021 A 27/09/2021 IS DATE	SECTION 4.55 ANALYSIS REVISION DA COMMENTS	JOB NUM# 185	DRAWN BY MV	CHK. BY TW	PAGE SIZE A3
							PROJECT NAME 70 ATTUNGA RD			SCALE 1 : 200
							DRAWING NAME SITE ANALYSIS			DRAWING NUMBER A 101 -L

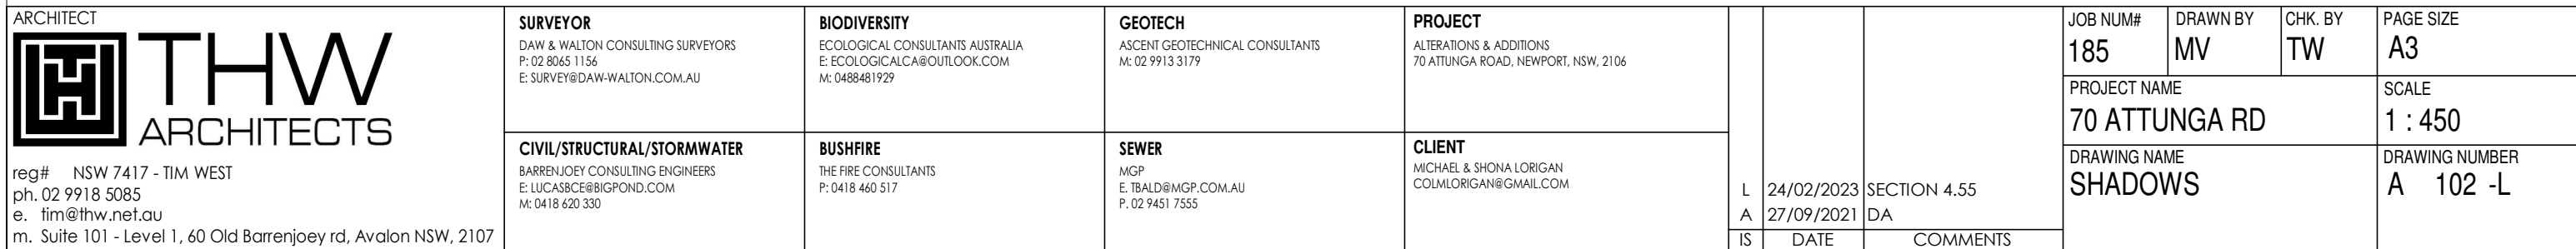


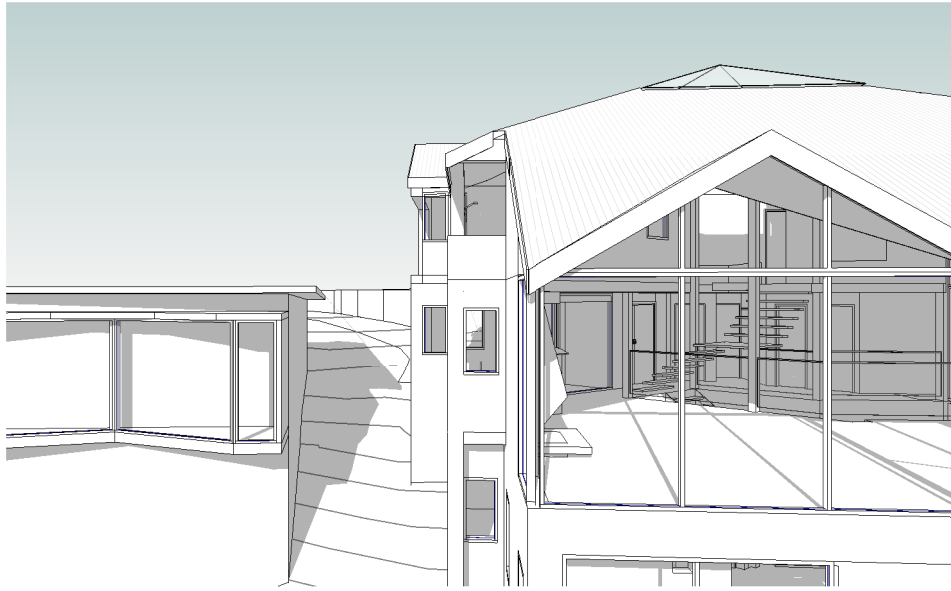


1 EX SHADOWS 9AM JUNE 21ST
103

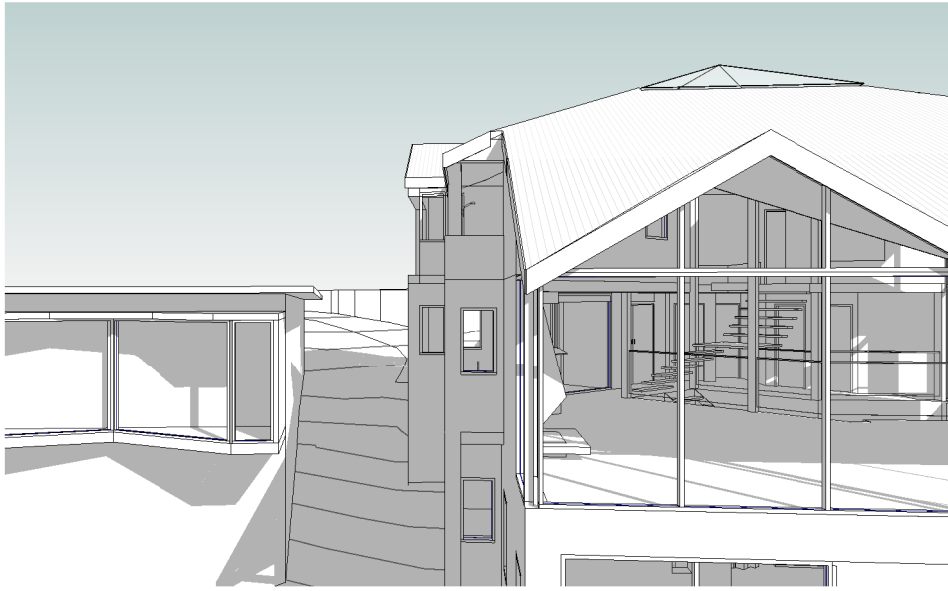

2 EX SHADOWS 12PM JUNE 21ST
103

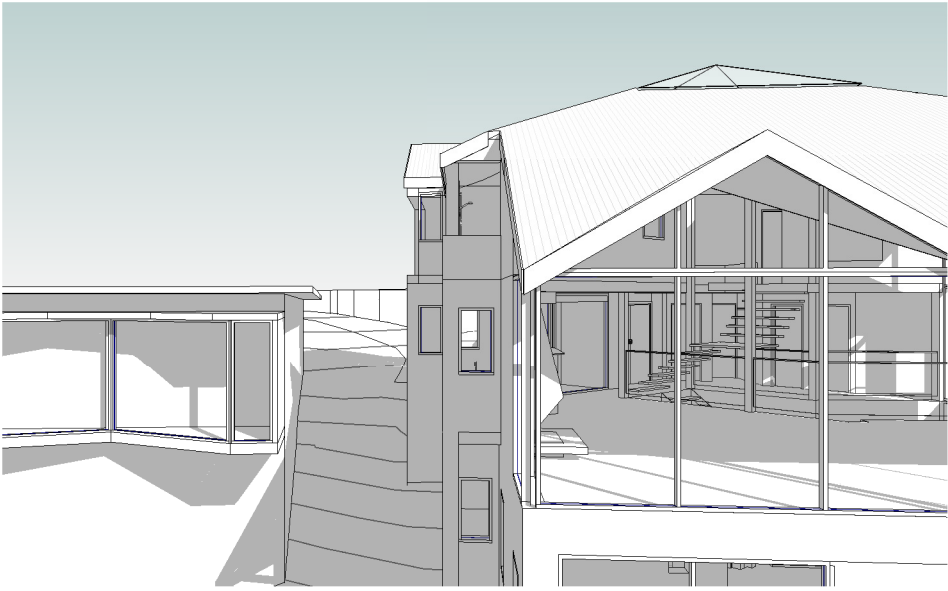


3 EX SHADOWS 3PM JUNE 21ST
103

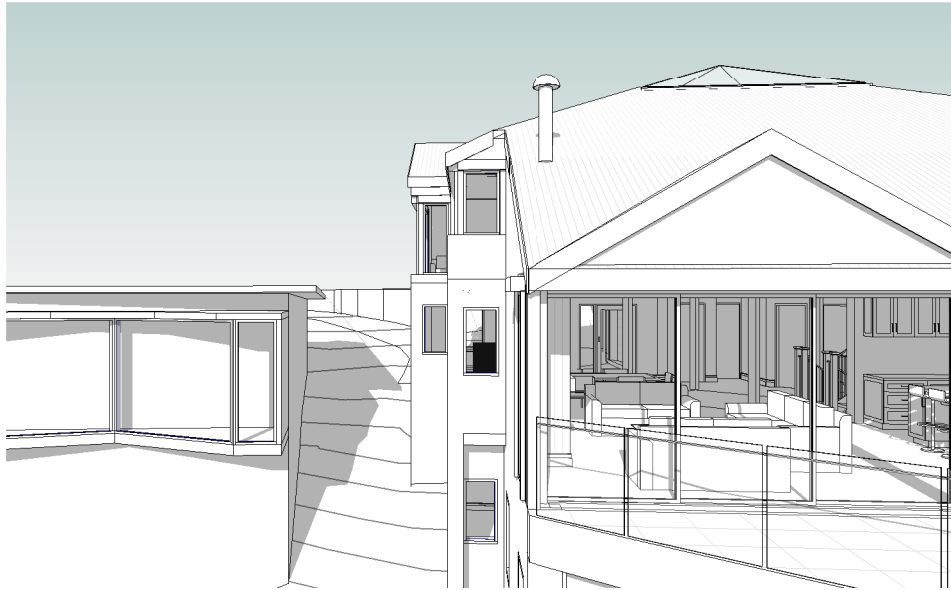

4 PRO SHADOWS 9AM JUNE 21ST
103



5 PRO SHADOWS 12PM JUNE 21ST
103

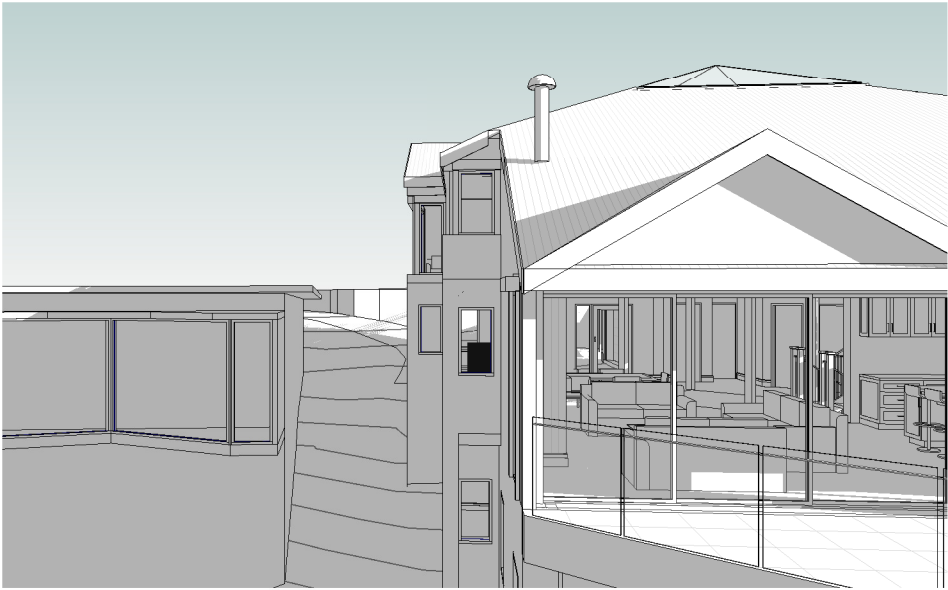

6 PRO SHADOWS 3PM JUNE 21ST
103

ARCHITECT'S WORK IS COPYRIGHT AND COVERED BY COPYRIGHT ACT 1968
DRAWINGS NOT TO BE SCALED. USE FIGURED DIMENSIONS ONLY. CHECK ALL DIMENSIONS ON SITE. PRIOR TO MANUFACTURE MEASURE ALL WINDOW/DOOR OPENINGS ON SITE. ELECTRONIC COPIES OF DRAWINGS SHOULD BE VERIFIED AGAINST PRINTED COPIES TO ENSURE NO LOSS OF INFORMATION. IF IN DOUBT ASK

ARCHITECT  reg# NSW 7417 - TIM WEST ph. 02 9918 5085 e. tim@thw.net.au m. Suite 101 - Level 1, 60 Old Barrenjoey rd, Avalon NSW, 2107	SURVEYOR DAW & WALTON CONSULTING SURVEYORS P: 02 8065 1156 E: SURVEY@DAW-WALTON.COM.AU	BIODIVERSITY ECOLOGICAL CONSULTANTS AUSTRALIA E: ECOLOGICALCA@OUTLOOK.COM M: 0488481929	GEOTECH ASCENT GEOTECHNICAL CONSULTANTS M: 02 9913 3179	PROJECT ALTERATIONS & ADDITIONS 70 ATTUNGA ROAD, NEWPORT, NSW, 2106	L A IS 24/02/2023 27/09/2021 DATE SECTION 4.55 DA COMMENTS	JOB NUM# 185	DRAWN BY MV	CHK. BY TW	PAGE SIZE A3
	CIVIL/STRUCTURAL/STORMWATER BARRENJOEY CONSULTING ENGINEERS E: LUCAS8CE@BIGPOND.COM M: 0418 620 330	BUSHFIRE THE FIRE CONSULTANTS P: 0418 460 517	SEWER MGP E: TBALD@MGP.COM.AU P: 02 9451 7555	CLIENT MICHAEL & SHONA LORIGAN COLMLORIGAN@GMAIL.COM		PROJECT NAME 70 ATTUNGA RD			SCALE
						DRAWING NAME SHADOWS			DRAWING NUMBER A 103 -L



ROOF: COLORBOND MEDIUM GREY FINISH



GARAGE DOOR: COLORBOND HORIZONTAL PATTERN WHITE FINISH



GUTTER, FACIA, SOFFIT: COLORBOND GUTTER AND FACIA LIGHT GREY W/ WHITE SOFFIT



WINDOW FRAME: COLORBOND PC FINISH WHITE



ROOF: EXISTING LIGHT GREY ROOF



1 EXTERNAL FINISHES

105

ARCHITECT'S WORK IS COPYRIGHT AND COVERED BY COPYRIGHT ACT 1968
DRAWINGS NOT TO BE SCALED. USE FIGURED DIMENSIONS ONLY. CHECK ALL DIMENSIONS ON SITE. PRIOR TO MANUFACTURE MEASURE ALL WINDOW/DOOR OPENINGS ON SITE. ELECTRONIC COPIES OF DRAWINGS SHOULD BE VERIFIED AGAINST PRINTED COPIES TO ENSURE NO LOSS OF INFORMATION. IF IN DOUBT ASK

ARCHITECT  reg# NSW 7417 - TIM WEST ph. 02 9918 5085 e. tim@thw.net.au m. Suite 101 - Level 1, 60 Old Barrenjoey rd, Avalon NSW, 2107	SURVEYOR DAW & WALTON CONSULTING SURVEYORS P: 02 8065 1156 E: SURVEY@DAW-WALTON.COM.AU	BIODIVERSITY ECOLOGICAL CONSULTANTS AUSTRALIA E: ECOLOGICALCA@OUTLOOK.COM M: 0488481929	GEOTECH ASCENT GEOTECHNICAL CONSULTANTS M: 02 9913 3179	PROJECT ALTERATIONS & ADDITIONS 70 ATTUNGA ROAD, NEWPORT, NSW, 2106	L A IS	24/02/2023 27/09/2021 DATE	SECTION 4.55 DA COMMENTS	JOB NUM# 185	DRAWN BY MV	CHK. BY TW	PAGE SIZE A3
	PROJECT NAME 70 ATTUNGA RD			SCALE As indicated							
	DRAWING NAME EXTERNAL FINISHES			DRAWING NUMBER A 105 -L							
CIVIL/STRUCTURAL/STORMWATER BARRENJOEY CONSULTING ENGINEERS E: LUCAS8CE@BIGPOND.COM M: 0418 620 330	BUSHFIRE THE FIRE CONSULTANTS P: 0418 460 517	SEWER MGP E: TBALD@MGP.COM.AU P: 02 9451 7555	CLIENT MICHAEL & SHONA LORIGAN COLMLORIGAN@GMAIL.COM								