


NOTE-
PROPOSED S96 AMENDMENTS
SHOWN IN RED

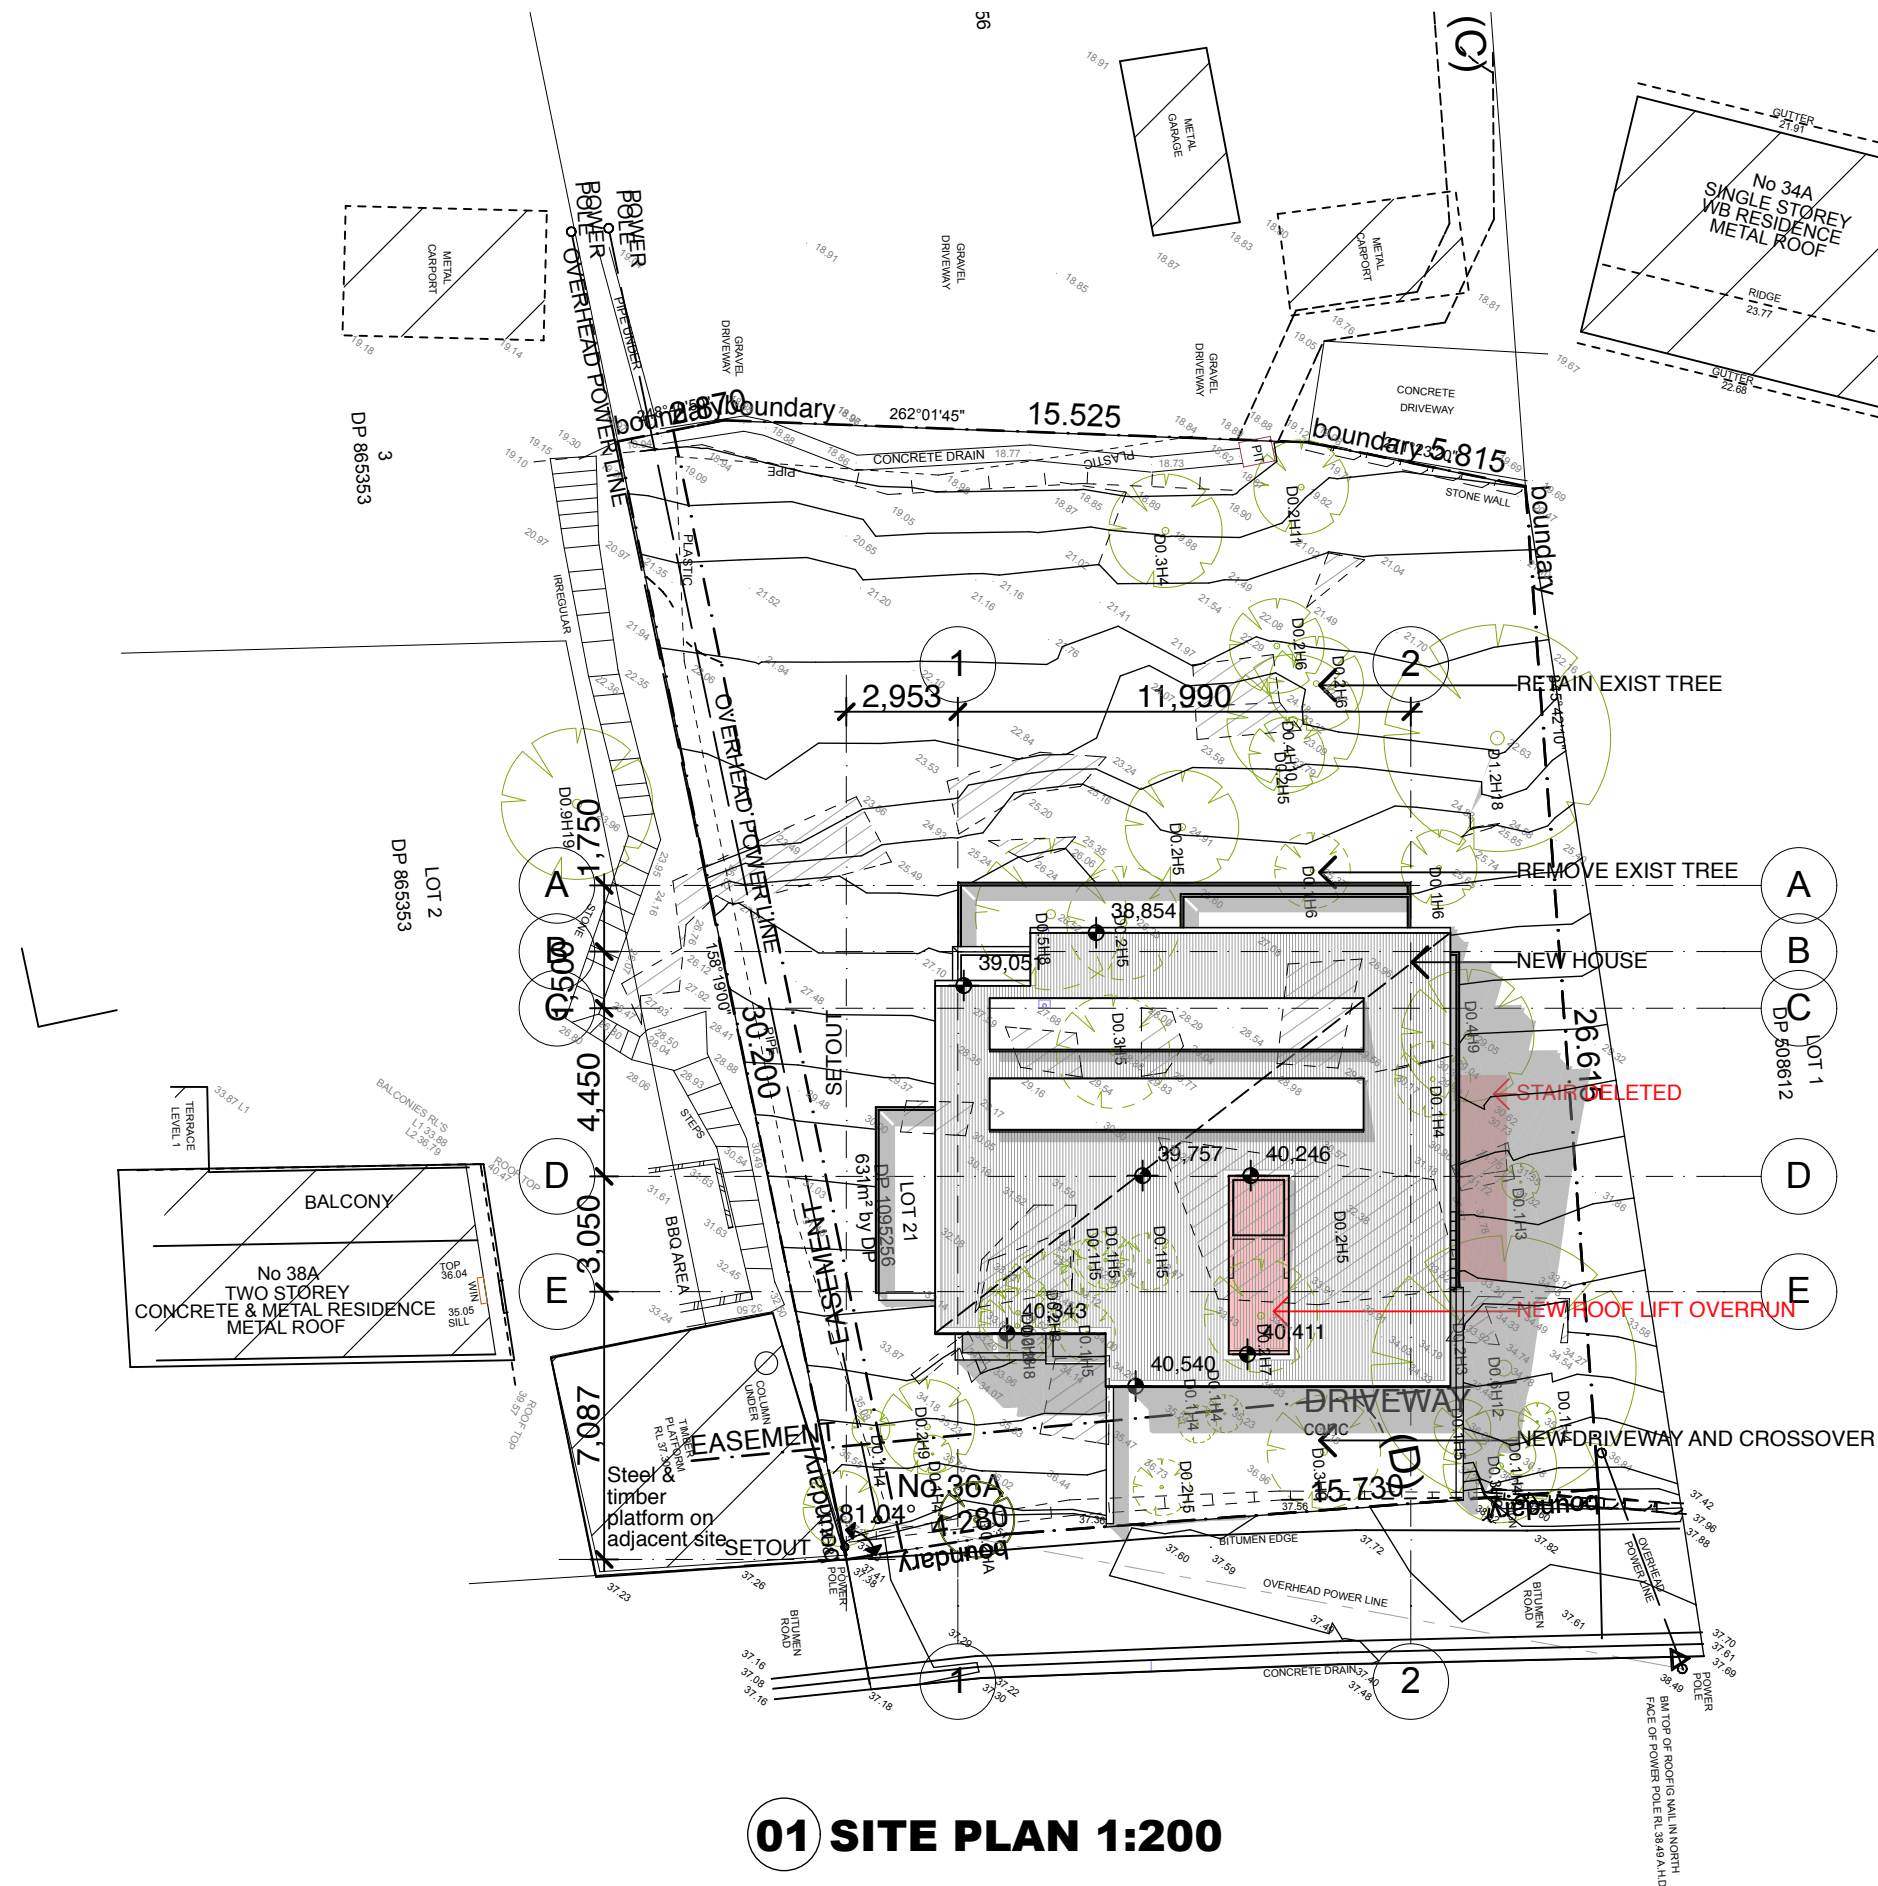

01 SITE PLAN 1:200

Part of Ku-ring-gai National Park



A	ISSUED FOR COMMENT	28/02/17
---	--------------------	----------

Amendments

Architect



Fortey + Grant Architecture
Studio 3/Level 3, 35 Buckingham Street
Surry Hills NSW 2010
mob: 0401 822 223
email: james@fgarch.com.au

Project Details

NEW HOUSE AT

**36A COWAN DRIVE
COTTAGE POINT NSW
2087**

This drawing should be read in conjunction with all relevant contracts, specifications, reports and drawings. All dimensions used to be figured dimensions only. Do not scale from drawings. Report any discrepancies to the Architect for a decision before proceeding with work.

Drawn JG	Approved JG	Date Printed 28/02/2017
-------------	----------------	----------------------------

Job Number 1703

Scale As shown @ A3

Drawing name


SITE PLAN

Drawing Number

S96-01

Amendment

A

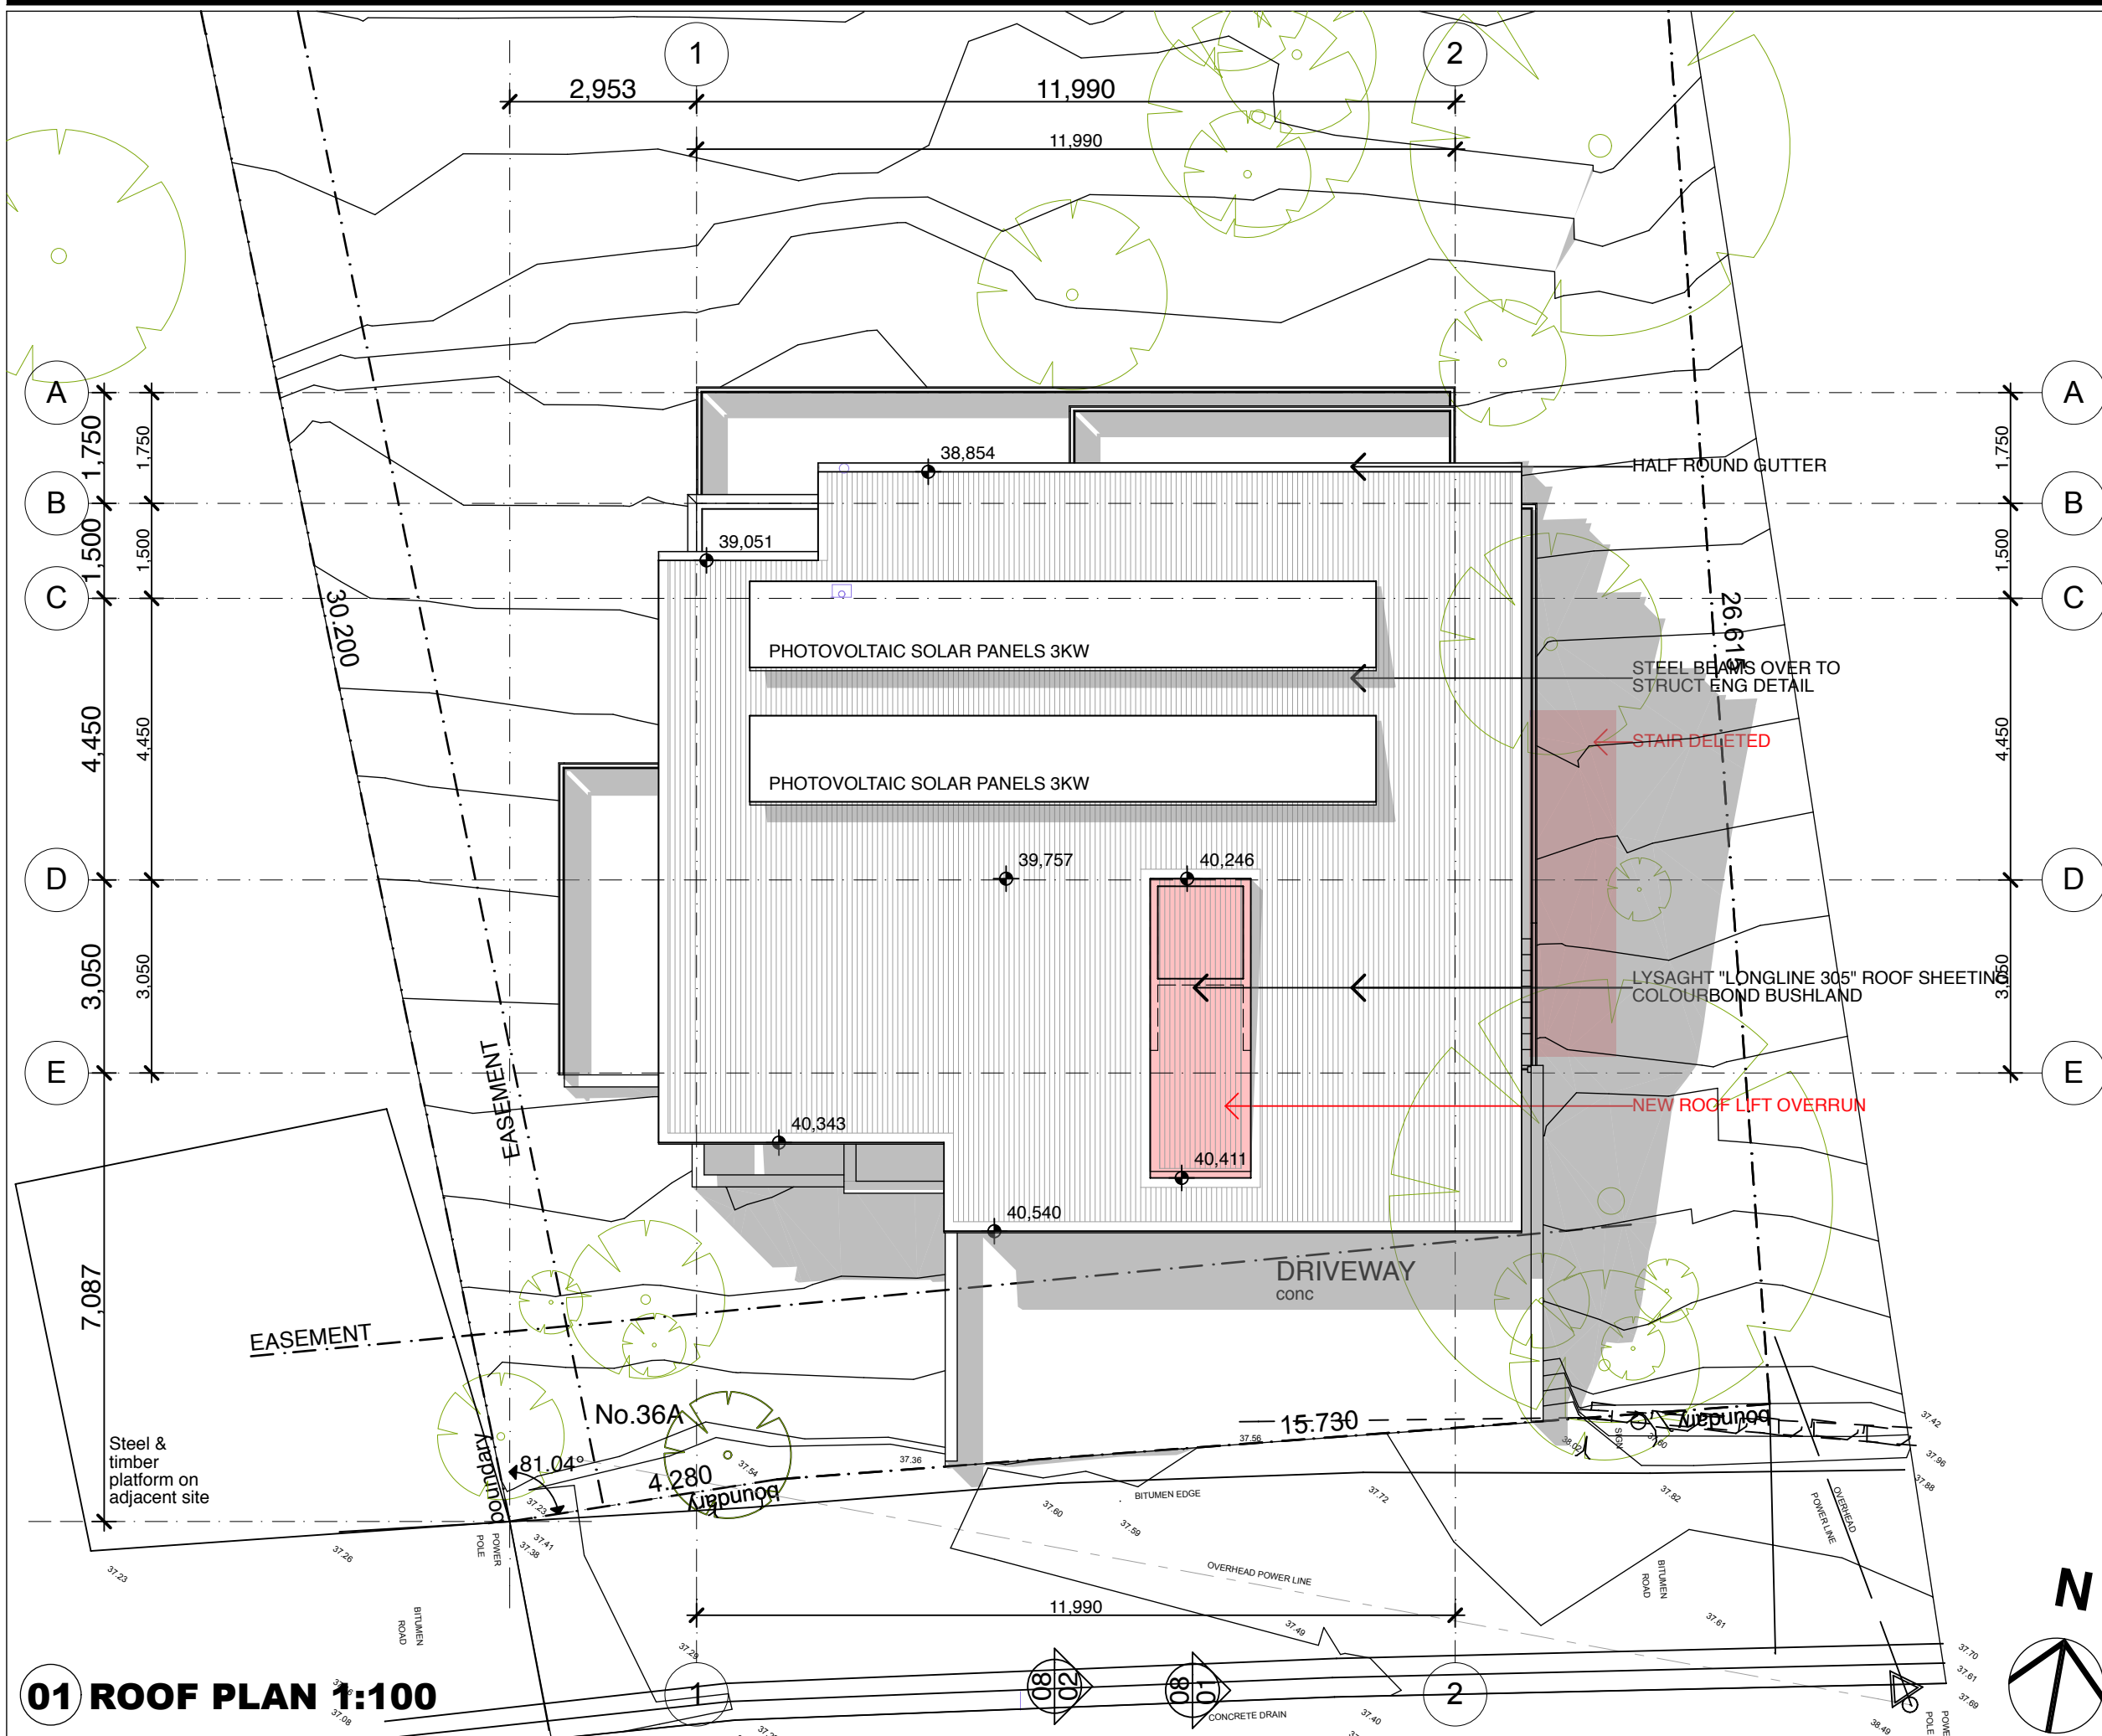

NOTE-
PROPOSED S96 AMENDMENTS
SHOWN IN RED

A ISSUED FOR COMMENT28/02/17

Amendments

Architect



Fortey + Grant Architecture
Studio 3/Level 3, 35 Buckingham Street
Surry Hills NSW 2010
mob: 0401 822 223
email: james@fgarch.com.au

Project Details

NEW HOUSE AT

**36A COWAN DRIVE
COTTAGE POINT NSW
2087**

This drawing should be read in conjunction with all relevant contracts, specifications, reports and drawings. All dimensions used to be figured dimensions only. Do not scale from drawings. Report any discrepancies to the Architect for a decision before proceeding with work.

Drawn JG	Approved JG	Date Printed 28/02/2017
Job Number 1703		
Scale As shown @ A3		
Drawing name		

ROOF PLAN


Drawing Number
S96-05

Amendment
A

NOTE-
PROPOSED S96 AMENDMENTS
SHOWN IN RED

01 EAST ELEVATION 1:100

02 WEST ELEVATION 1:100

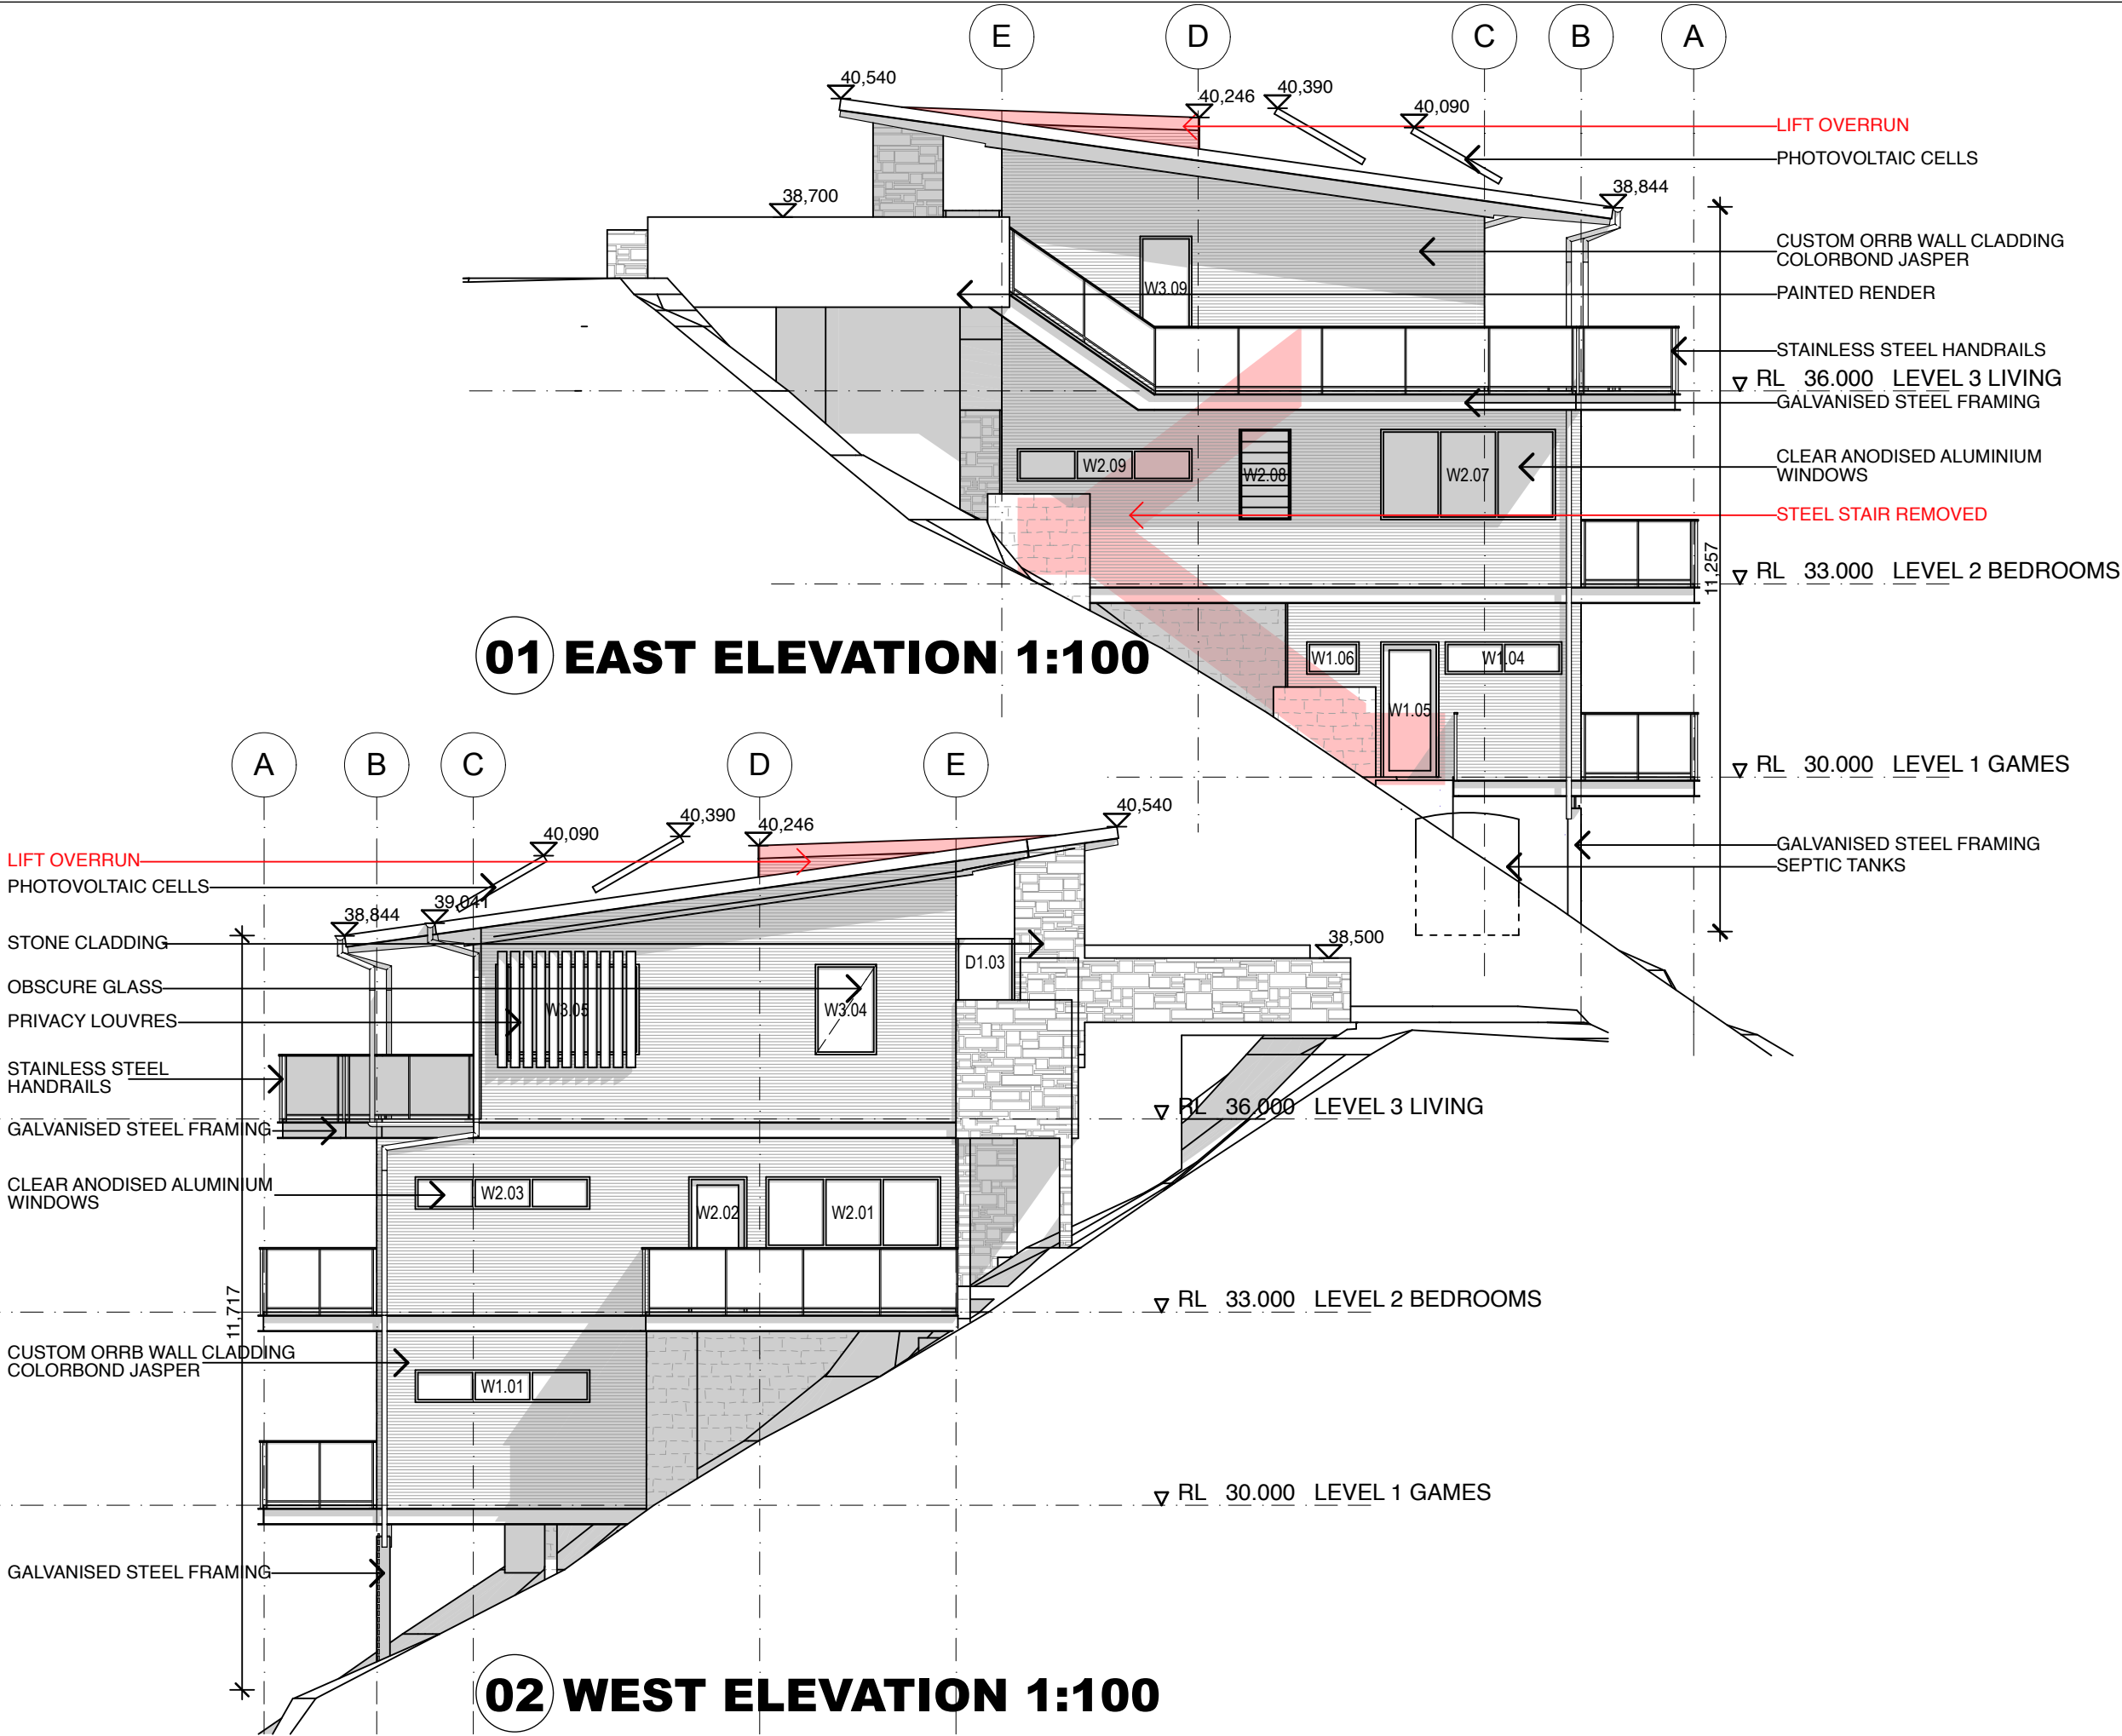

A ISSUED FOR COMMENT 28/02/17

Amendments

Architect

Fortey + Grant Architecture
Studio 3/Level 3, 35 Buckingham Street
Surry Hills NSW 2010
mob: 0401 822 223
email: james@fgarch.com.au

Project Details

NEW HOUSE AT

**36A COWAN DRIVE
COTTAGE POINT NSW
2087**

This drawing should be read in conjunction with all relevant contracts, specifications, reports and drawings. All dimensions used to be figured dimensions only. Do not scale from drawings. Report any discrepancies to the Architect for a decision before proceeding with work.

Drawn JG	Approved JG	Date Printed 28/02/2017
-------------	----------------	----------------------------


Job Number 1703

Scale As shown @ A3

Drawing name

**EAST & WEST
ELEVATIONS**

Drawing Number S96-06	Amendment A
---------------------------------	-----------------------

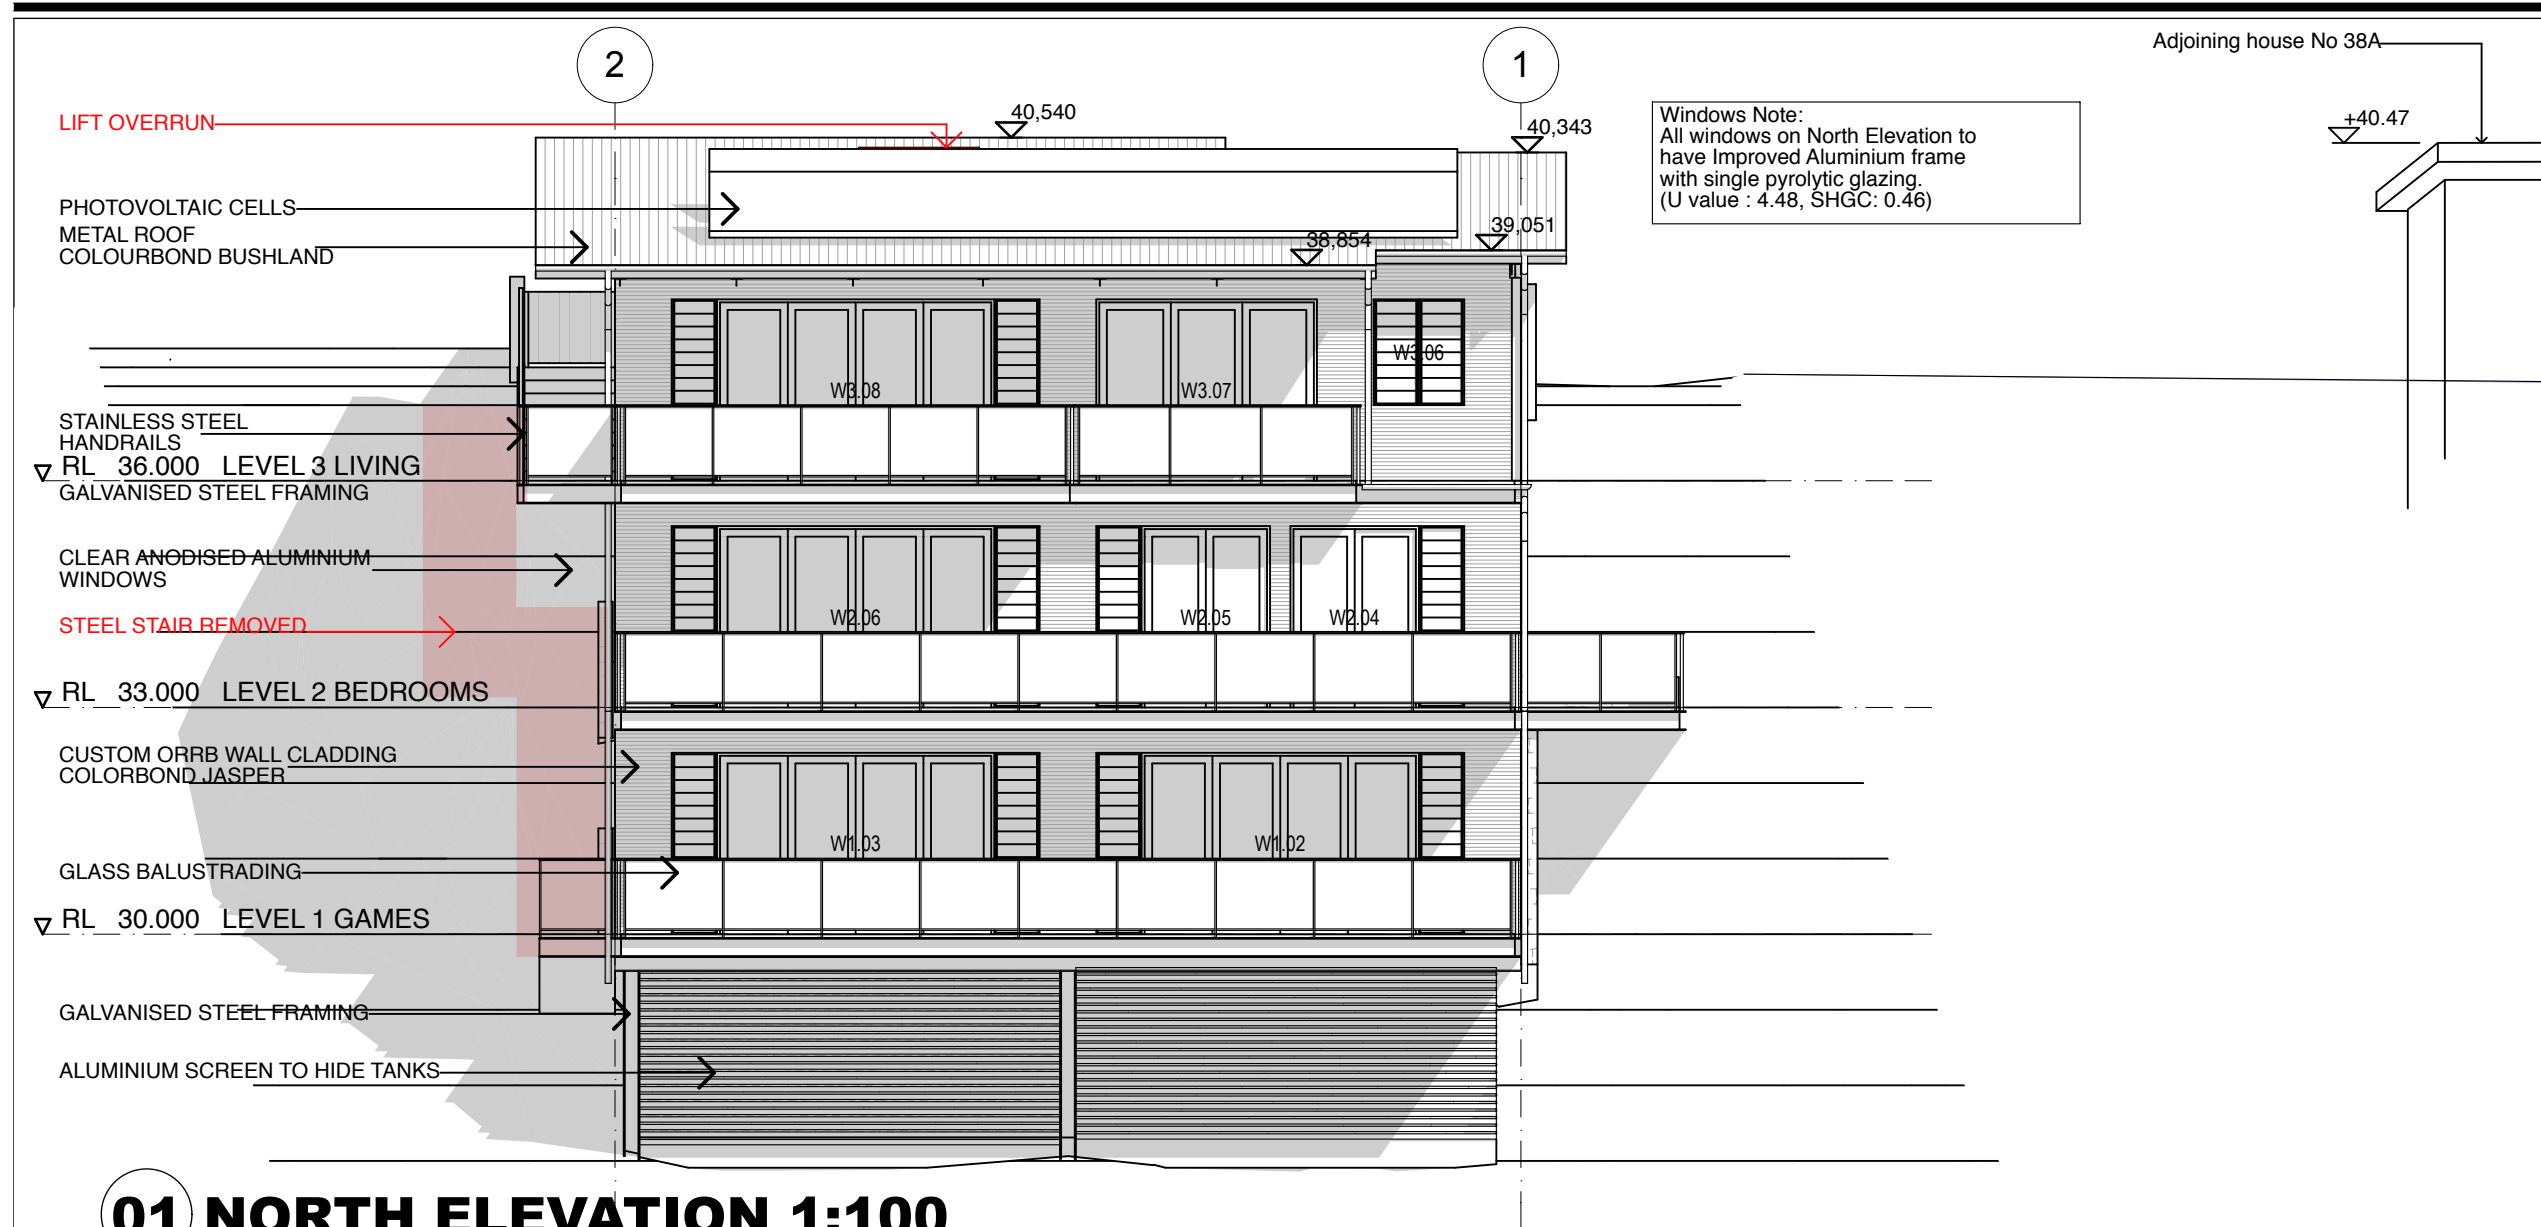

NOTE-
PROPOSED S96 AMENDMENTS
SHOWN IN RED

A ISSUED FOR COMMENT 28/02/17

Amendments

Architect

Fortey + Grant Architecture
Studio 3/Level 3, 35 Buckingham Street
Surry Hills NSW 2010
mob: 0401 822 223
email: james@fgarch.com.au

Project Details

NEW HOUSE AT

**36A COWAN DRIVE
COTTAGE POINT NSW
2087**

This drawing should be read in conjunction with all relevant contracts, specifications, reports and drawings. All dimensions used to be figured dimensions only. Do not scale from drawings. Report any discrepancies to the Architect for a decision before proceeding with work.

Drawn JG	Approved JG	Date Printed 28/02/2017
-------------	----------------	----------------------------

Job Number 1703

Scale As shown @ A3


Drawing name

NORTH & SOUTH ELEVATIONS

Drawing Number	Amendment
----------------	-----------

S96-07

A

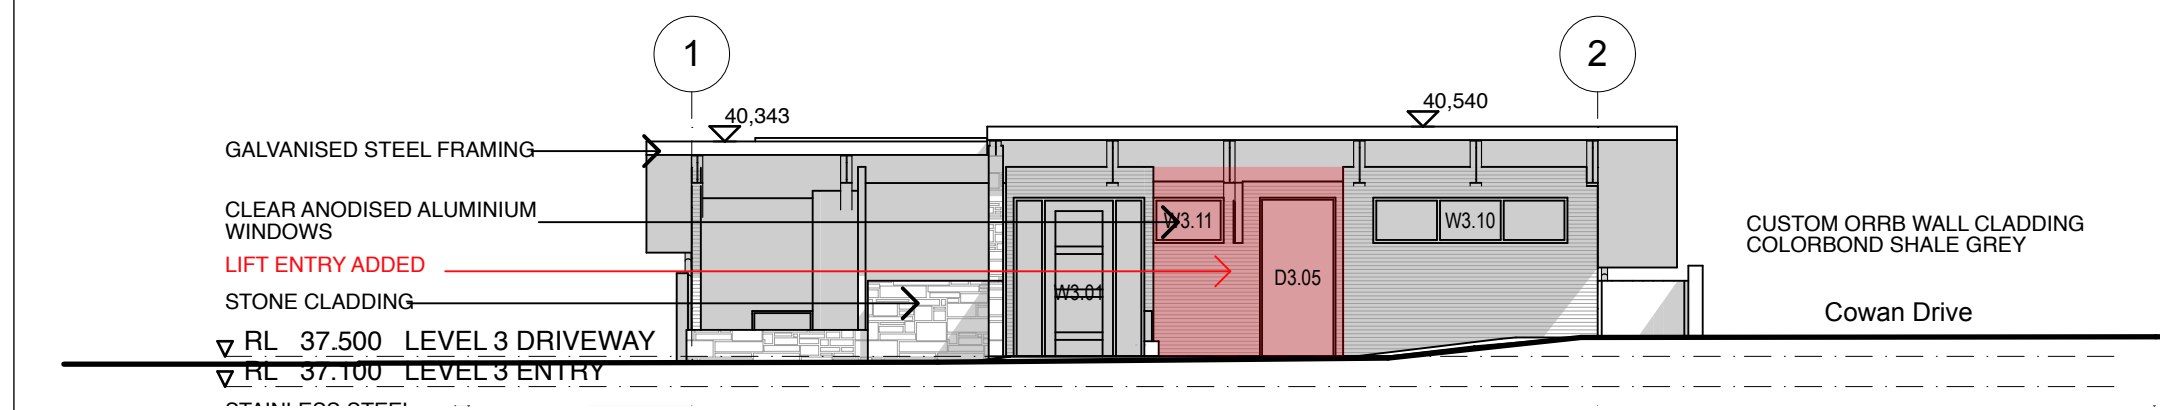

02 SOUTH ELEVATION 1:100