

OCUEDUU E OE OOG AMENDMENTO	DEVELOR
SCHEDULE OF S96 AMENDMENTS	No:
ACCESS GATE AND STAIR FROM POOL ENCLOSURE TO ALLOW ACCESS TO STREET	DA-00
FRONT LANDSCAPE AREA	DA-01
STREET FRONT ACCESS STAIR AMENDED TO SUIT ROCK FACE AND ENTRY STURCTURE	<del>DA-02</del>
REMOVED	DA-03
REAR FIRST FLOOR DECK PEGOLA REVOMED AND NEW ROOF OVER DECK	DA-04
TANK ROOM AND WALLS REMOVED - A RAINWATER TANK RELOACTED TO	DA-05
COMBINED OSD/RAINWATER TANK BELOW POOL STRUCTURE	DA-06
COMMS ROOM/EDB ADDED AND STORE	DA-07
DIVISION WALLS SHOWN  A FRONT ENTRY GATE + VESTIBULE AND	DA-08
POND ADDED	DA-09
FLOOR LEVELS AMENDED NOTE NO IMPACT ON HEIGHT	DA-10
ROOF LEVEL NOT CHANGED	DA-11
EXTENT OF GLAZING TO CINEMA ROOM REDUCED	<del>DA-12</del>
BOUNDARY POOL PRIVACY SCREEN ADDED TO TOP OF WALL - 1500 HIGH REFER	<del>DA-13</del>
SECTION ON DA-11	<del>DA-14</del>
ENTRY PERGOLA STRUCTURE REMOVED + FRAMED VIEWING WINDOW AND WINDOW SLOTS ADDED/AMENDED	DA-15
MASTER BEDROOM GLAZING EXTENT TO SOUTH ELEVATION AMENDED	

MASTER BEDROOM DAY BED - OBSCURE GLASS TO 1650 HIGH WINDOW SLOTS ADDED EAST ELEVATION


DEVELO	OPMENT APPLICATION DRAWING LIST
No:	Drawing Name
DA-00	COVER SHEET
DA-01	SITE PLAN
<del>DA-02</del>	SITE ANALYSIS
DA-03	BASEMENT
DA-04	GROUND FLOOR
DA-05	FIRST FLOOR
DA-06	SECOND FLOOR
DA-07	ROOF PLAN
DA-08	SOUTH + WEST
DA-09	NORTH + EAST
DA-10	SECTION A + B + C
DA-11	SECTION D + E
<del>DA-12</del>	SECTION F + G
<del>DA-13</del>	SHADOW DIAGRAMS + OPEN LANDSCAPE CALC
<del>DA-14</del>	- IMAGES-
DA-15	SUPPORTING IMAGES




## GARLING HOUSE SECTION 96 APPLICATION PROPOSED NEW RESIDENCE 24 LANCASTER CRESCENT, COLLAROY







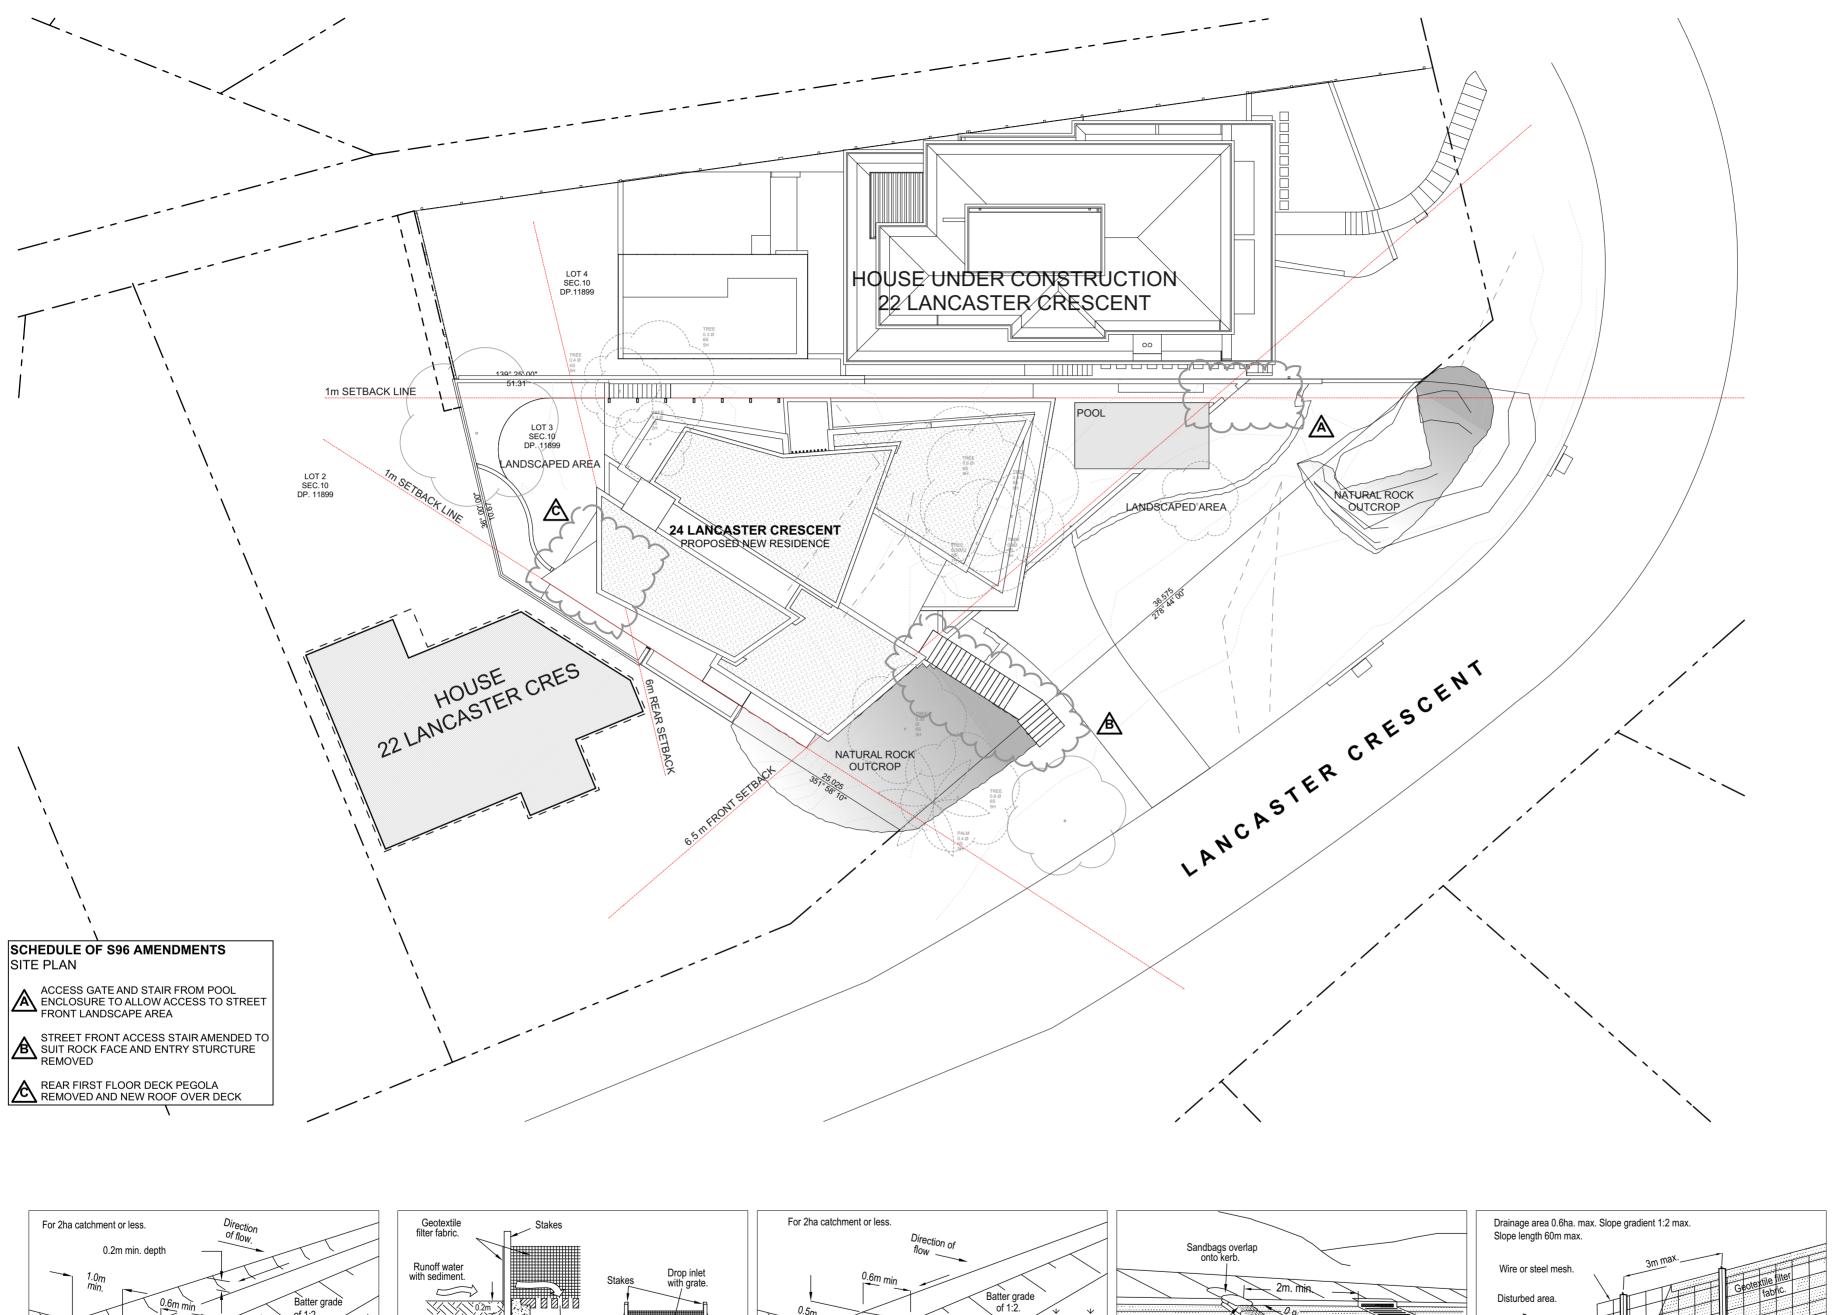





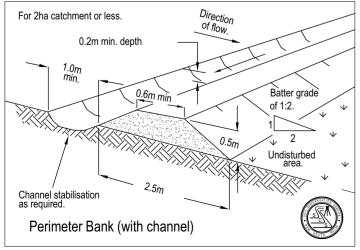

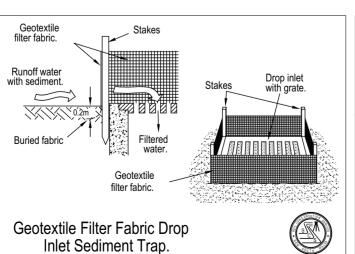

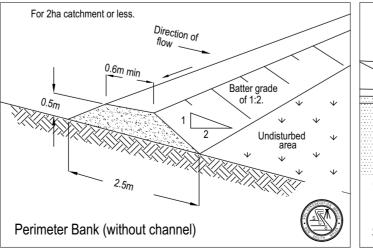

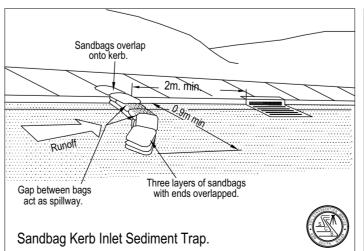

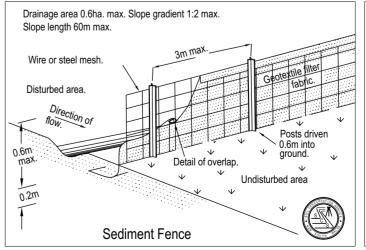

## CONSTRUCTION SEQUENCE:


- PROVIDE SOIL EROSION SEDIMENT CONTROL MEEASURES SUCH AS SILT FENCING AND STRAW BALES AS INDICATED.
- PROVIDE SHAKER PAD AND ENSURE SITE ACCESS IS LIMITED TO ONE LOCATION. ENSURE ALL VEHICLE MOVEMENTS IN AND OUT OF THE SITE PASS OVER THE SHAKER PADS.
- UNDERTAKE BULK EARTHWORKS ENSURING THAT ALL SEDIMENT CONTROL MEASURES ARE REGULARLY MAINTAINED AND IN GOOD WORKING ORDER.


G	A	$\overline{X}$	N	EΕ	Z	RC	)V	ΔT		
Α	R	С	Н	ı	т	E	C	т	S	
					A 4	7/90	MONA PO	VALE R		


	Issue Date	Rev	Description	Drawn	Checked	PROJECT
ı	15/09/2016	Α	ISSUED FOR DEVELOPMENT APPLICATION	DVI	LT	GARLING HOUSE
	07/02/2017	В	DEFERRED COMMENCEMENT - DA AMENDMENTS	DVI	LT	PROPOSED NEW RESIDEN
	13/03/2017	С	SECTION 96 - LIGHTWELL	DVI	LT	24 LANCASTER CRESCENT
	24/05/2019	D	SECTION 96	DVI	LT	LOT 3 DP.11899
	APRIL 2020	F	REVISED SECTION 96	DVI	LT	FOR MR & MRS GARLING


PROJECT	DRA
GARLING HOUSE	P
PROPOSED NEW RESIDENCE	SI
24 LANCASTER CRESCENT, COLLAROY NSW	SCA
LOT 3 DP.11899	1:2


	PLANS		
	SITE PLAN		
V	SCALE	DRAWN BY	PLO
	1:200, 1:100 @ A2	LT/DVI	9/04/
	PROJECT NO. 1612	DA-01	RE

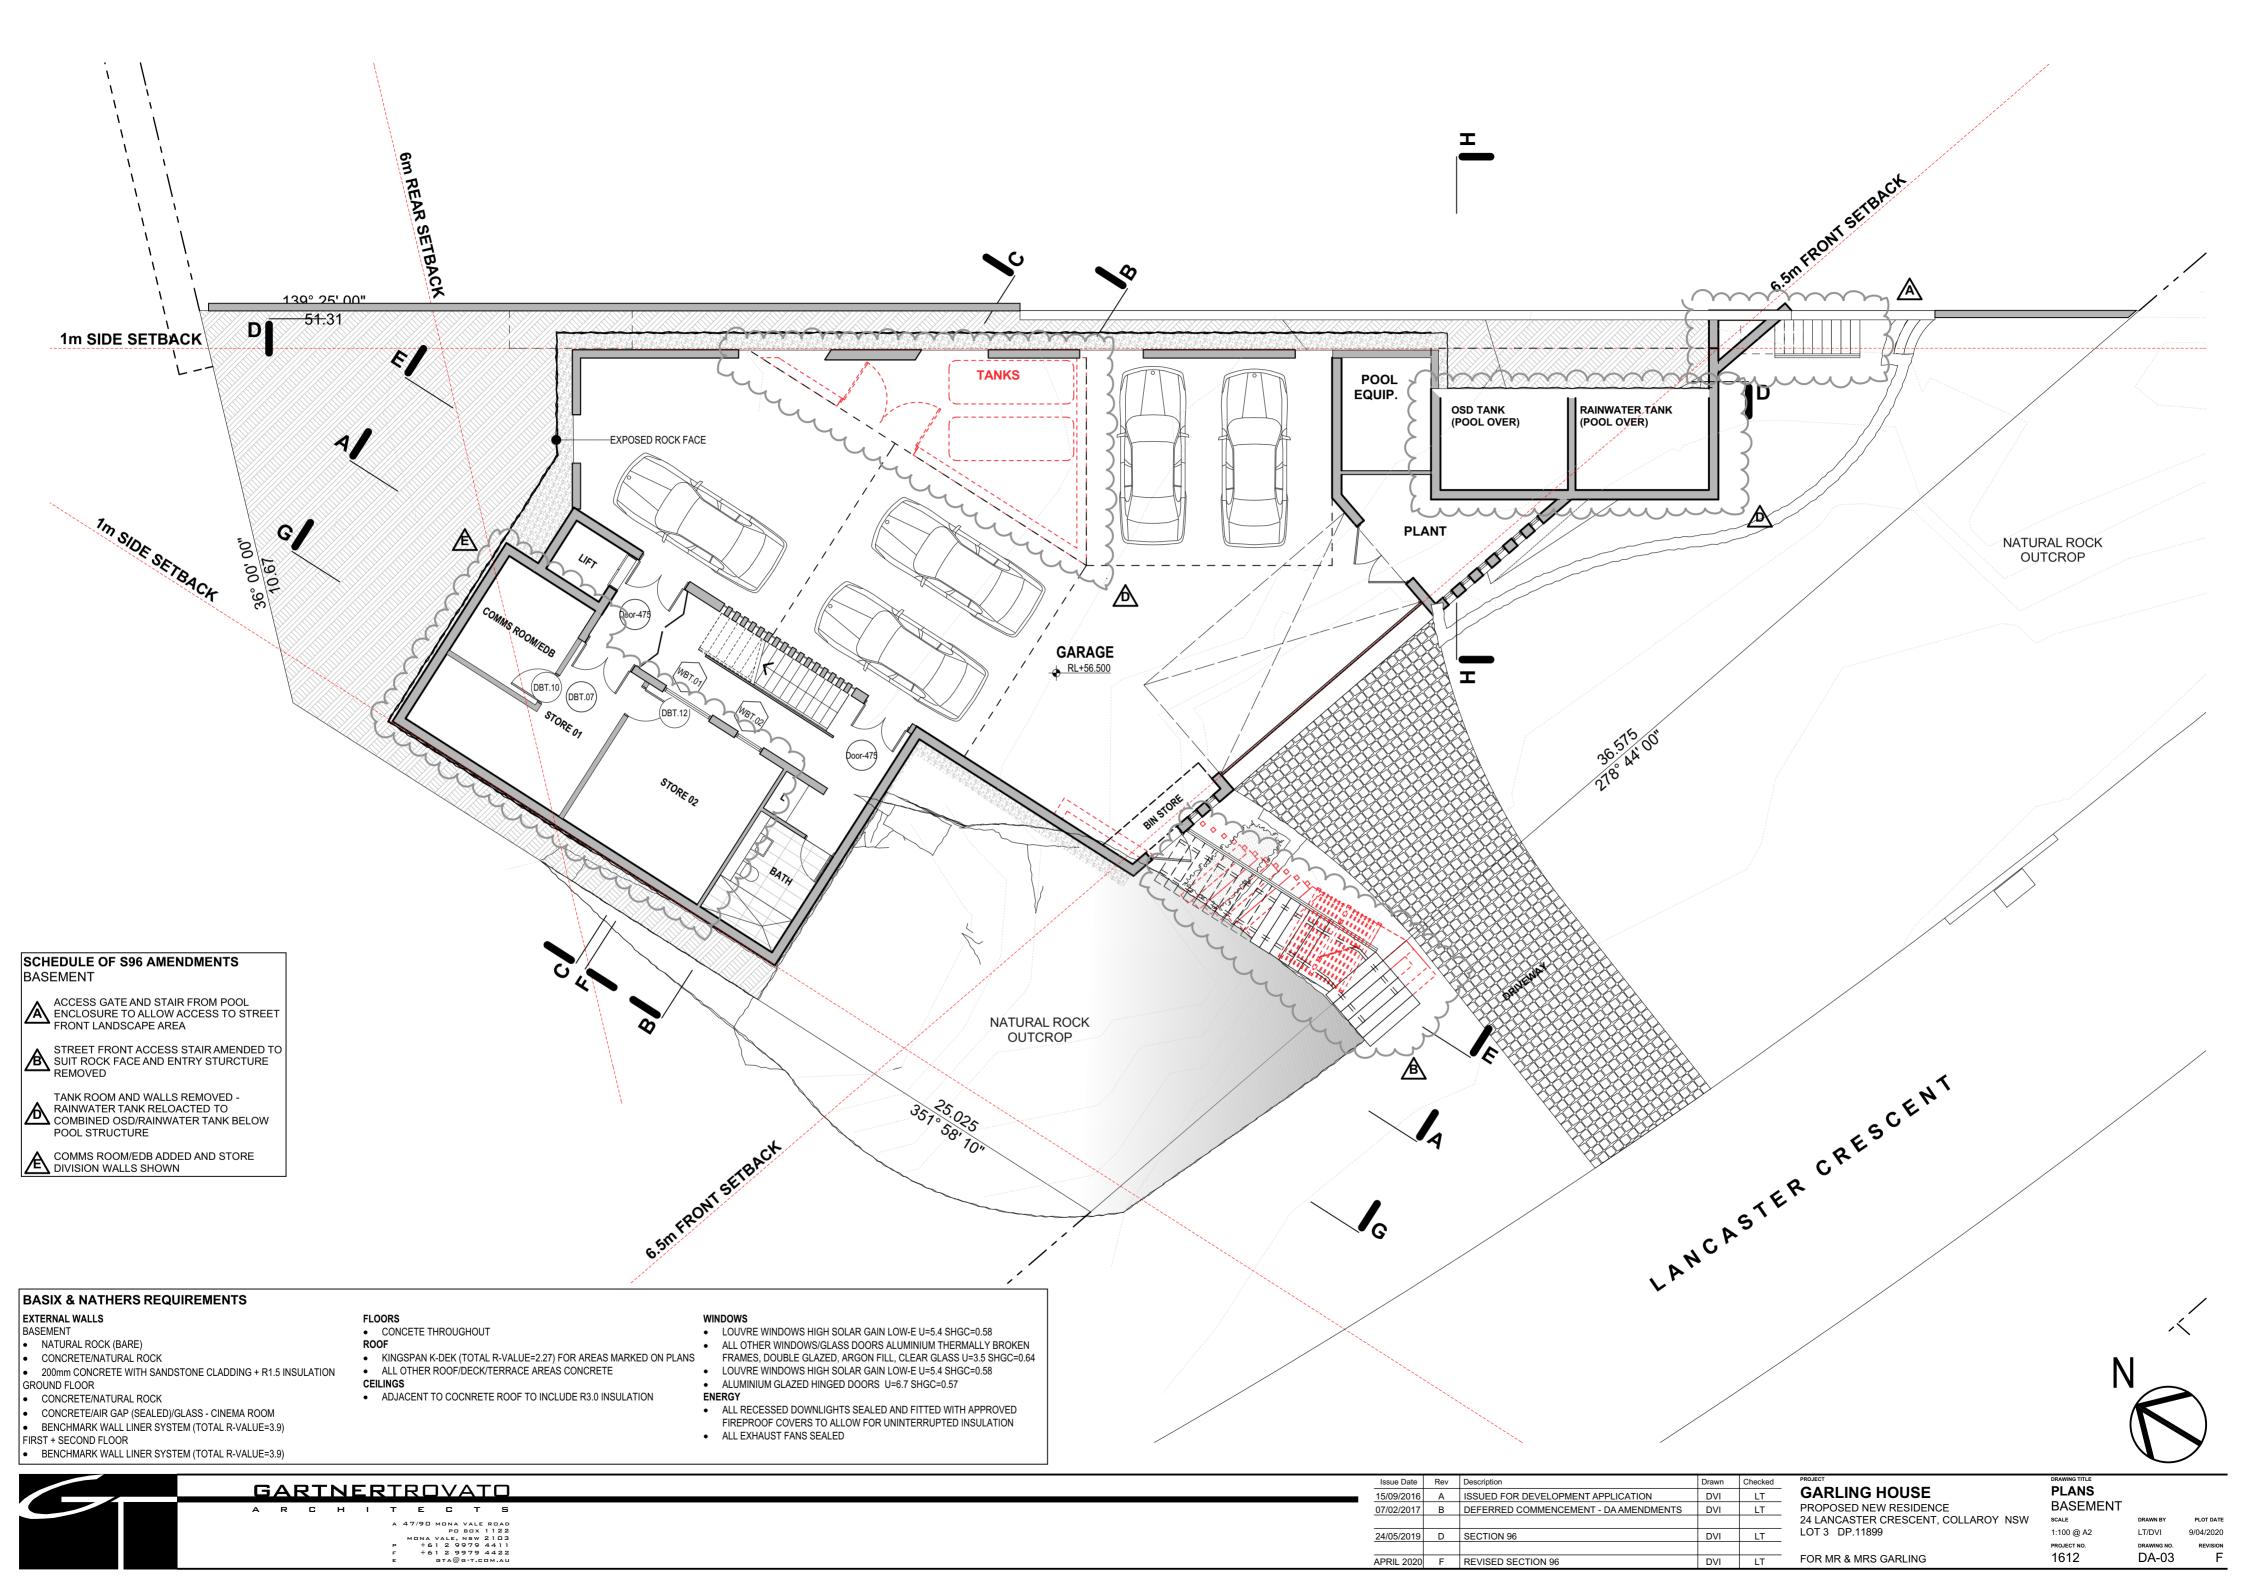


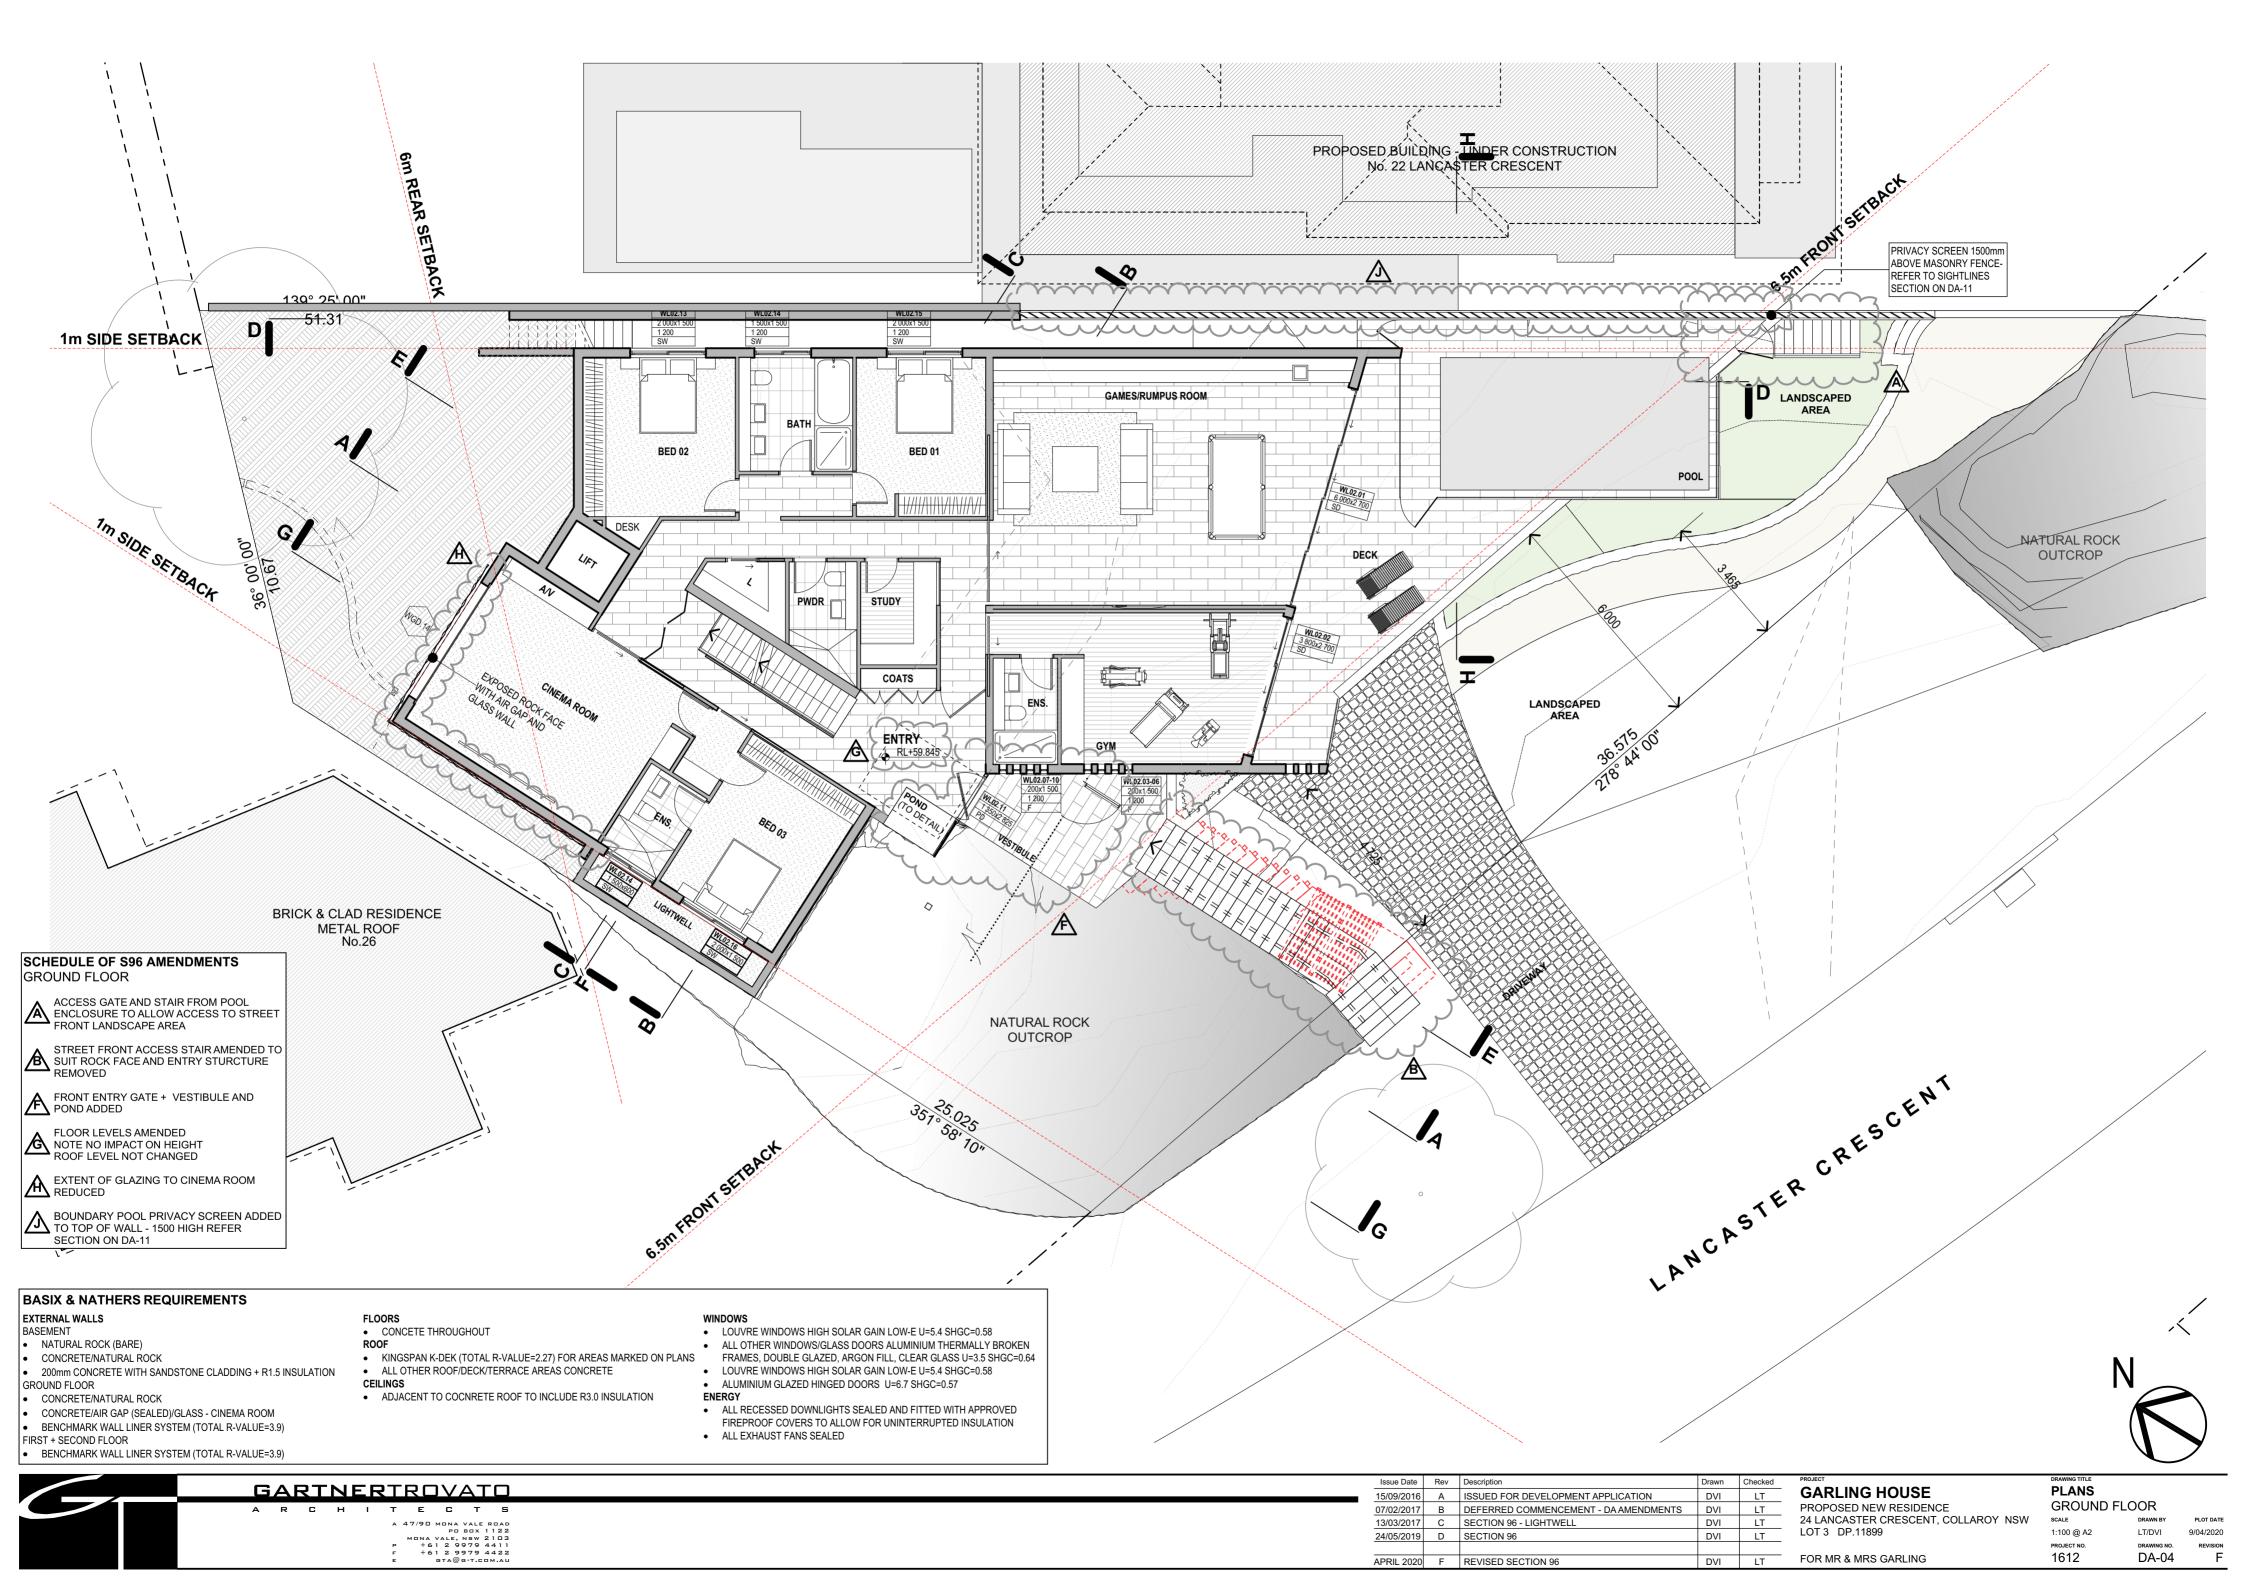


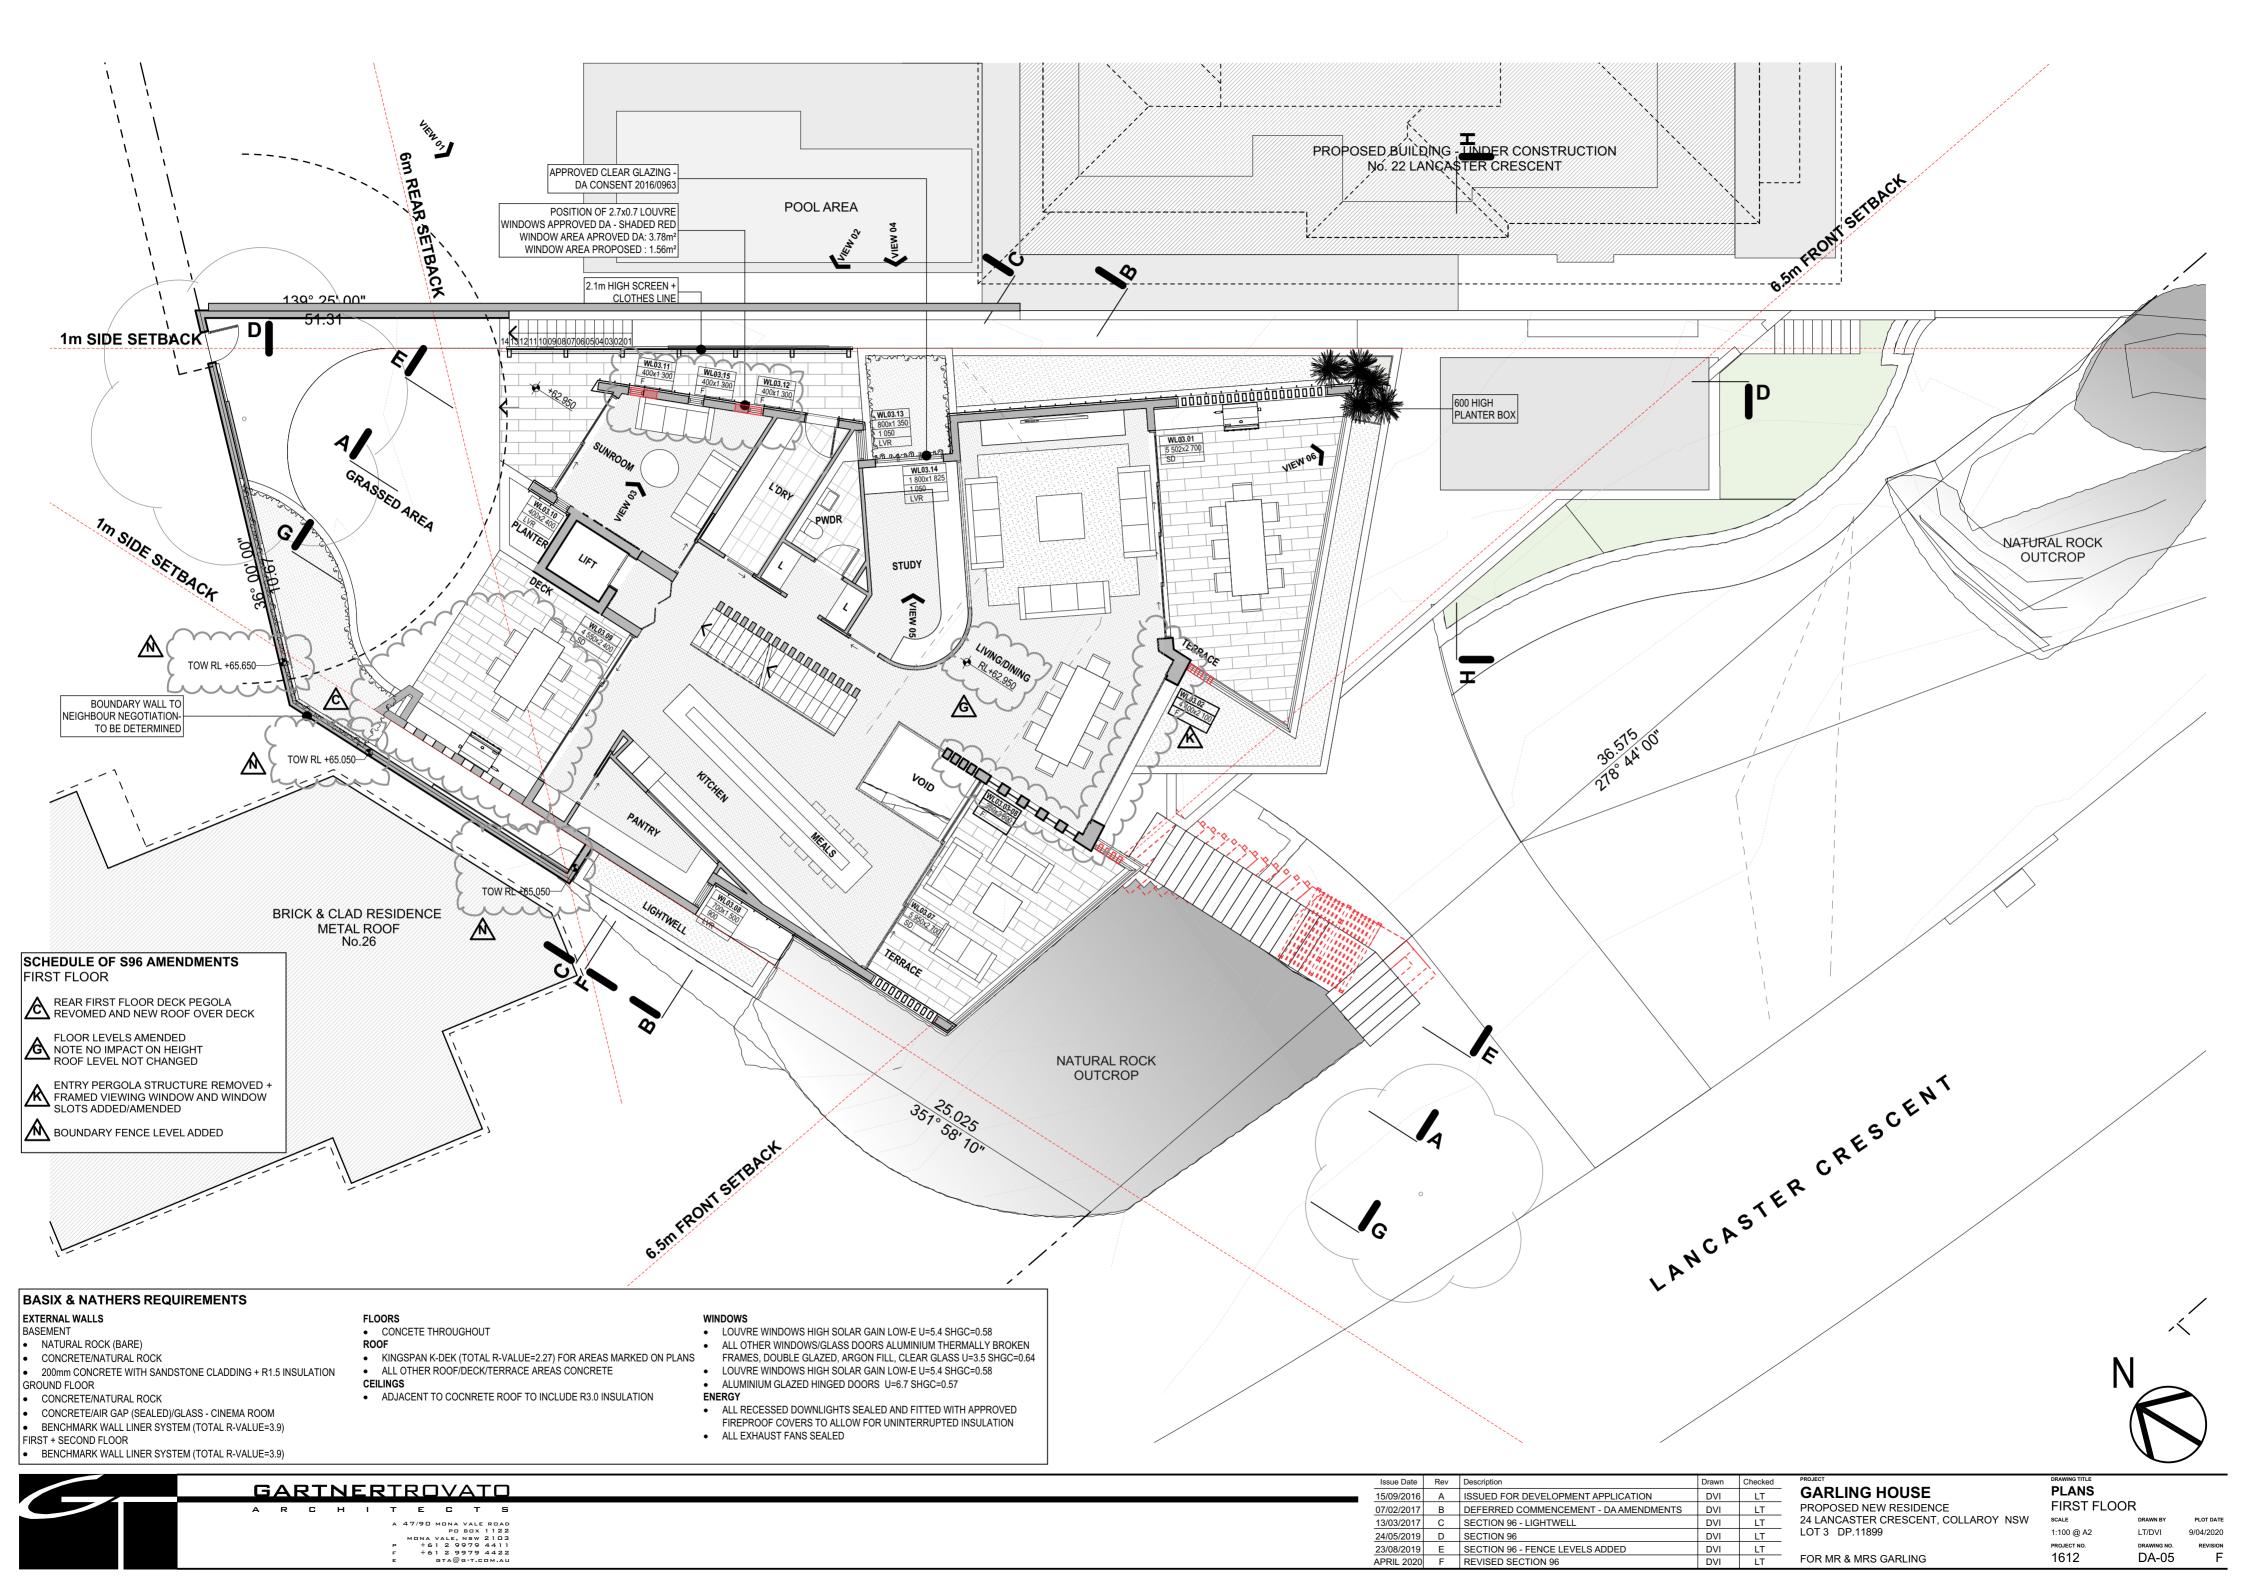


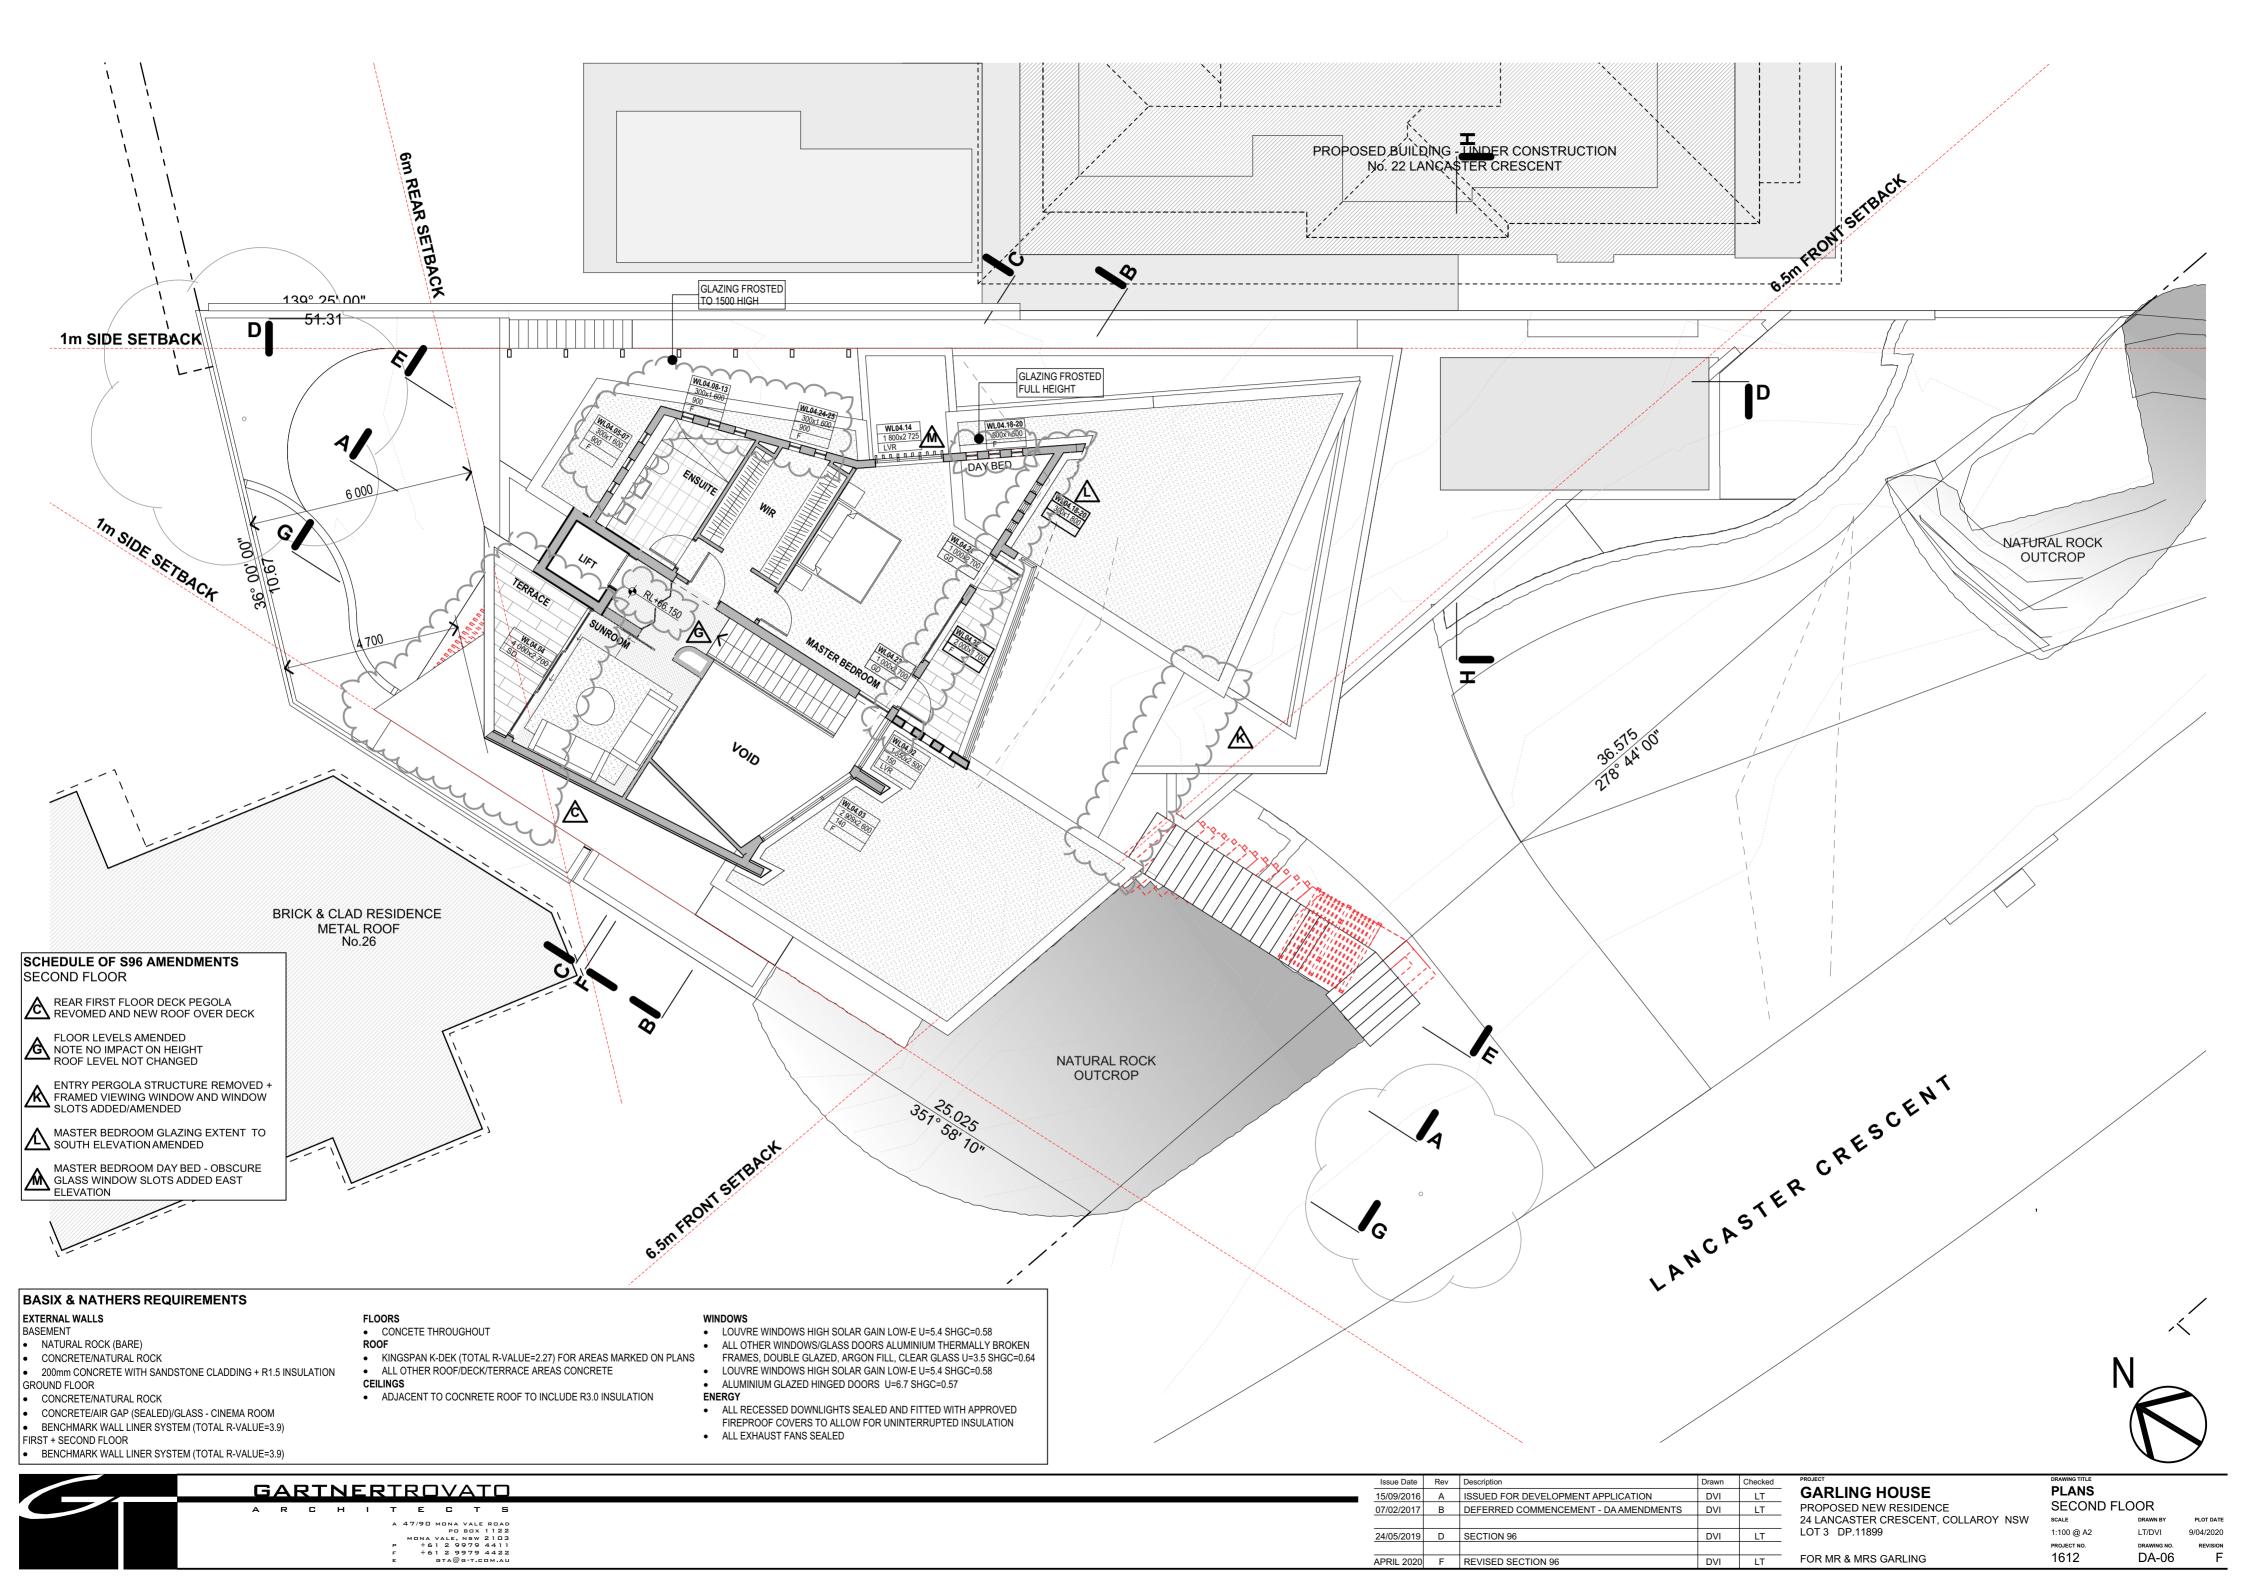


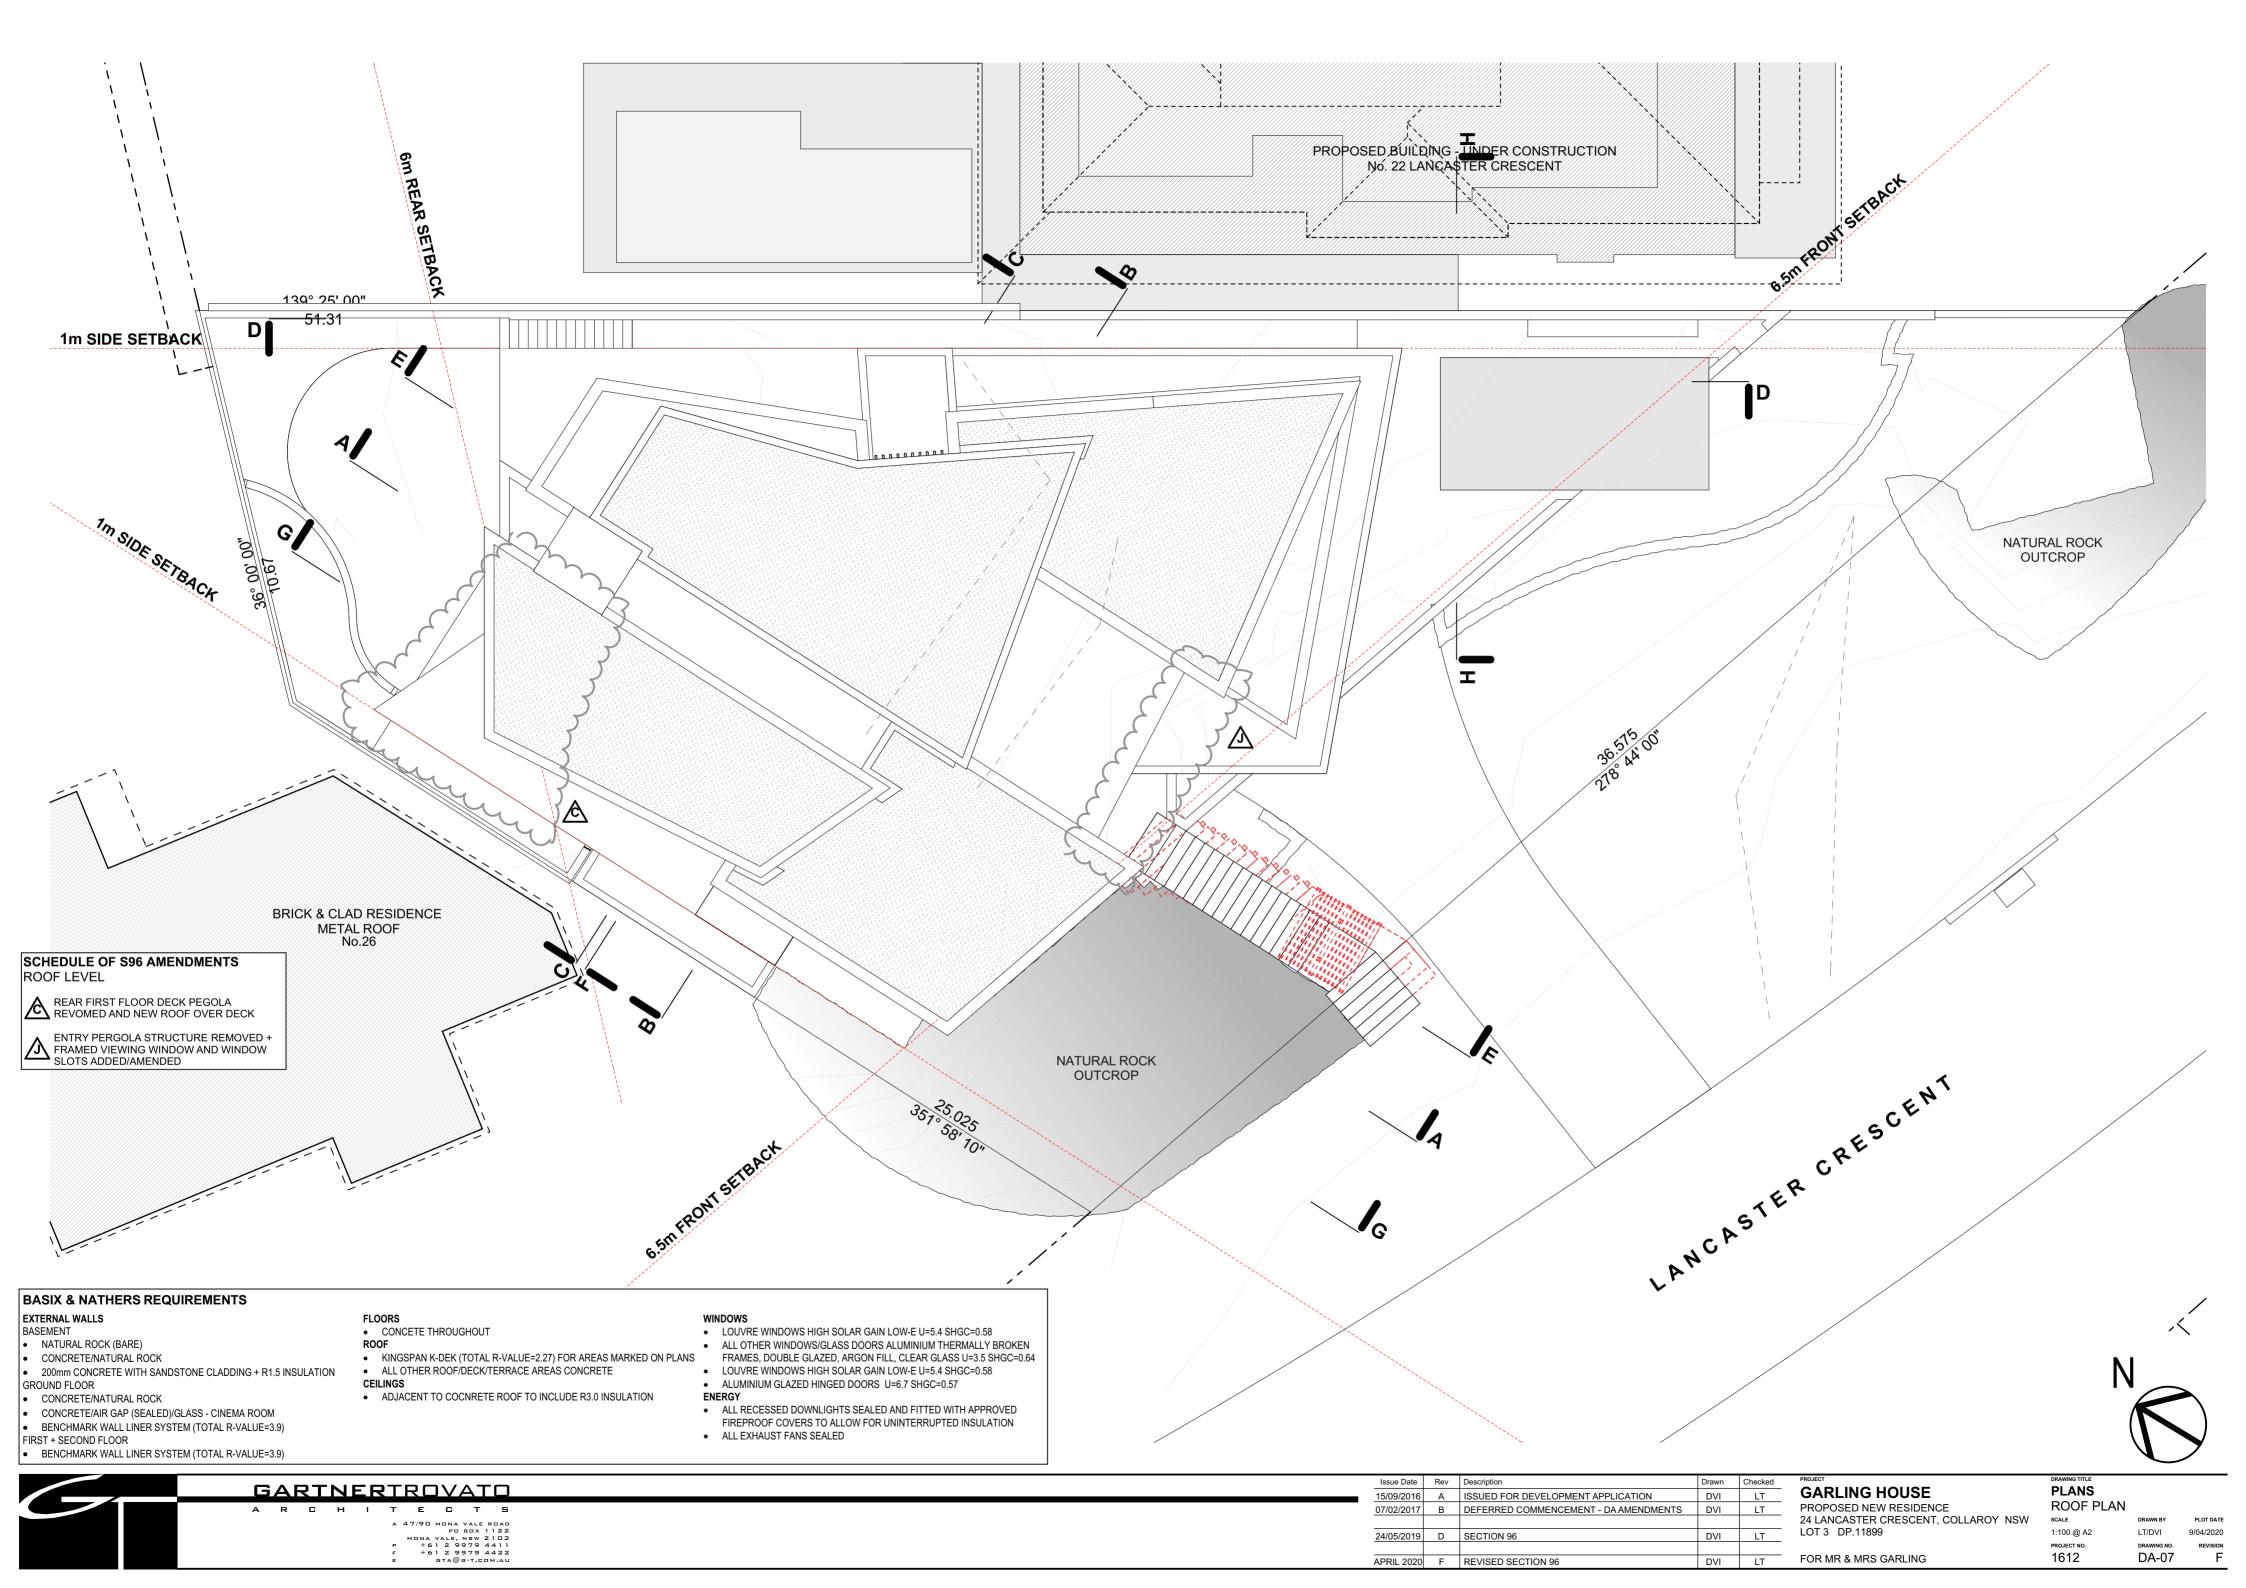

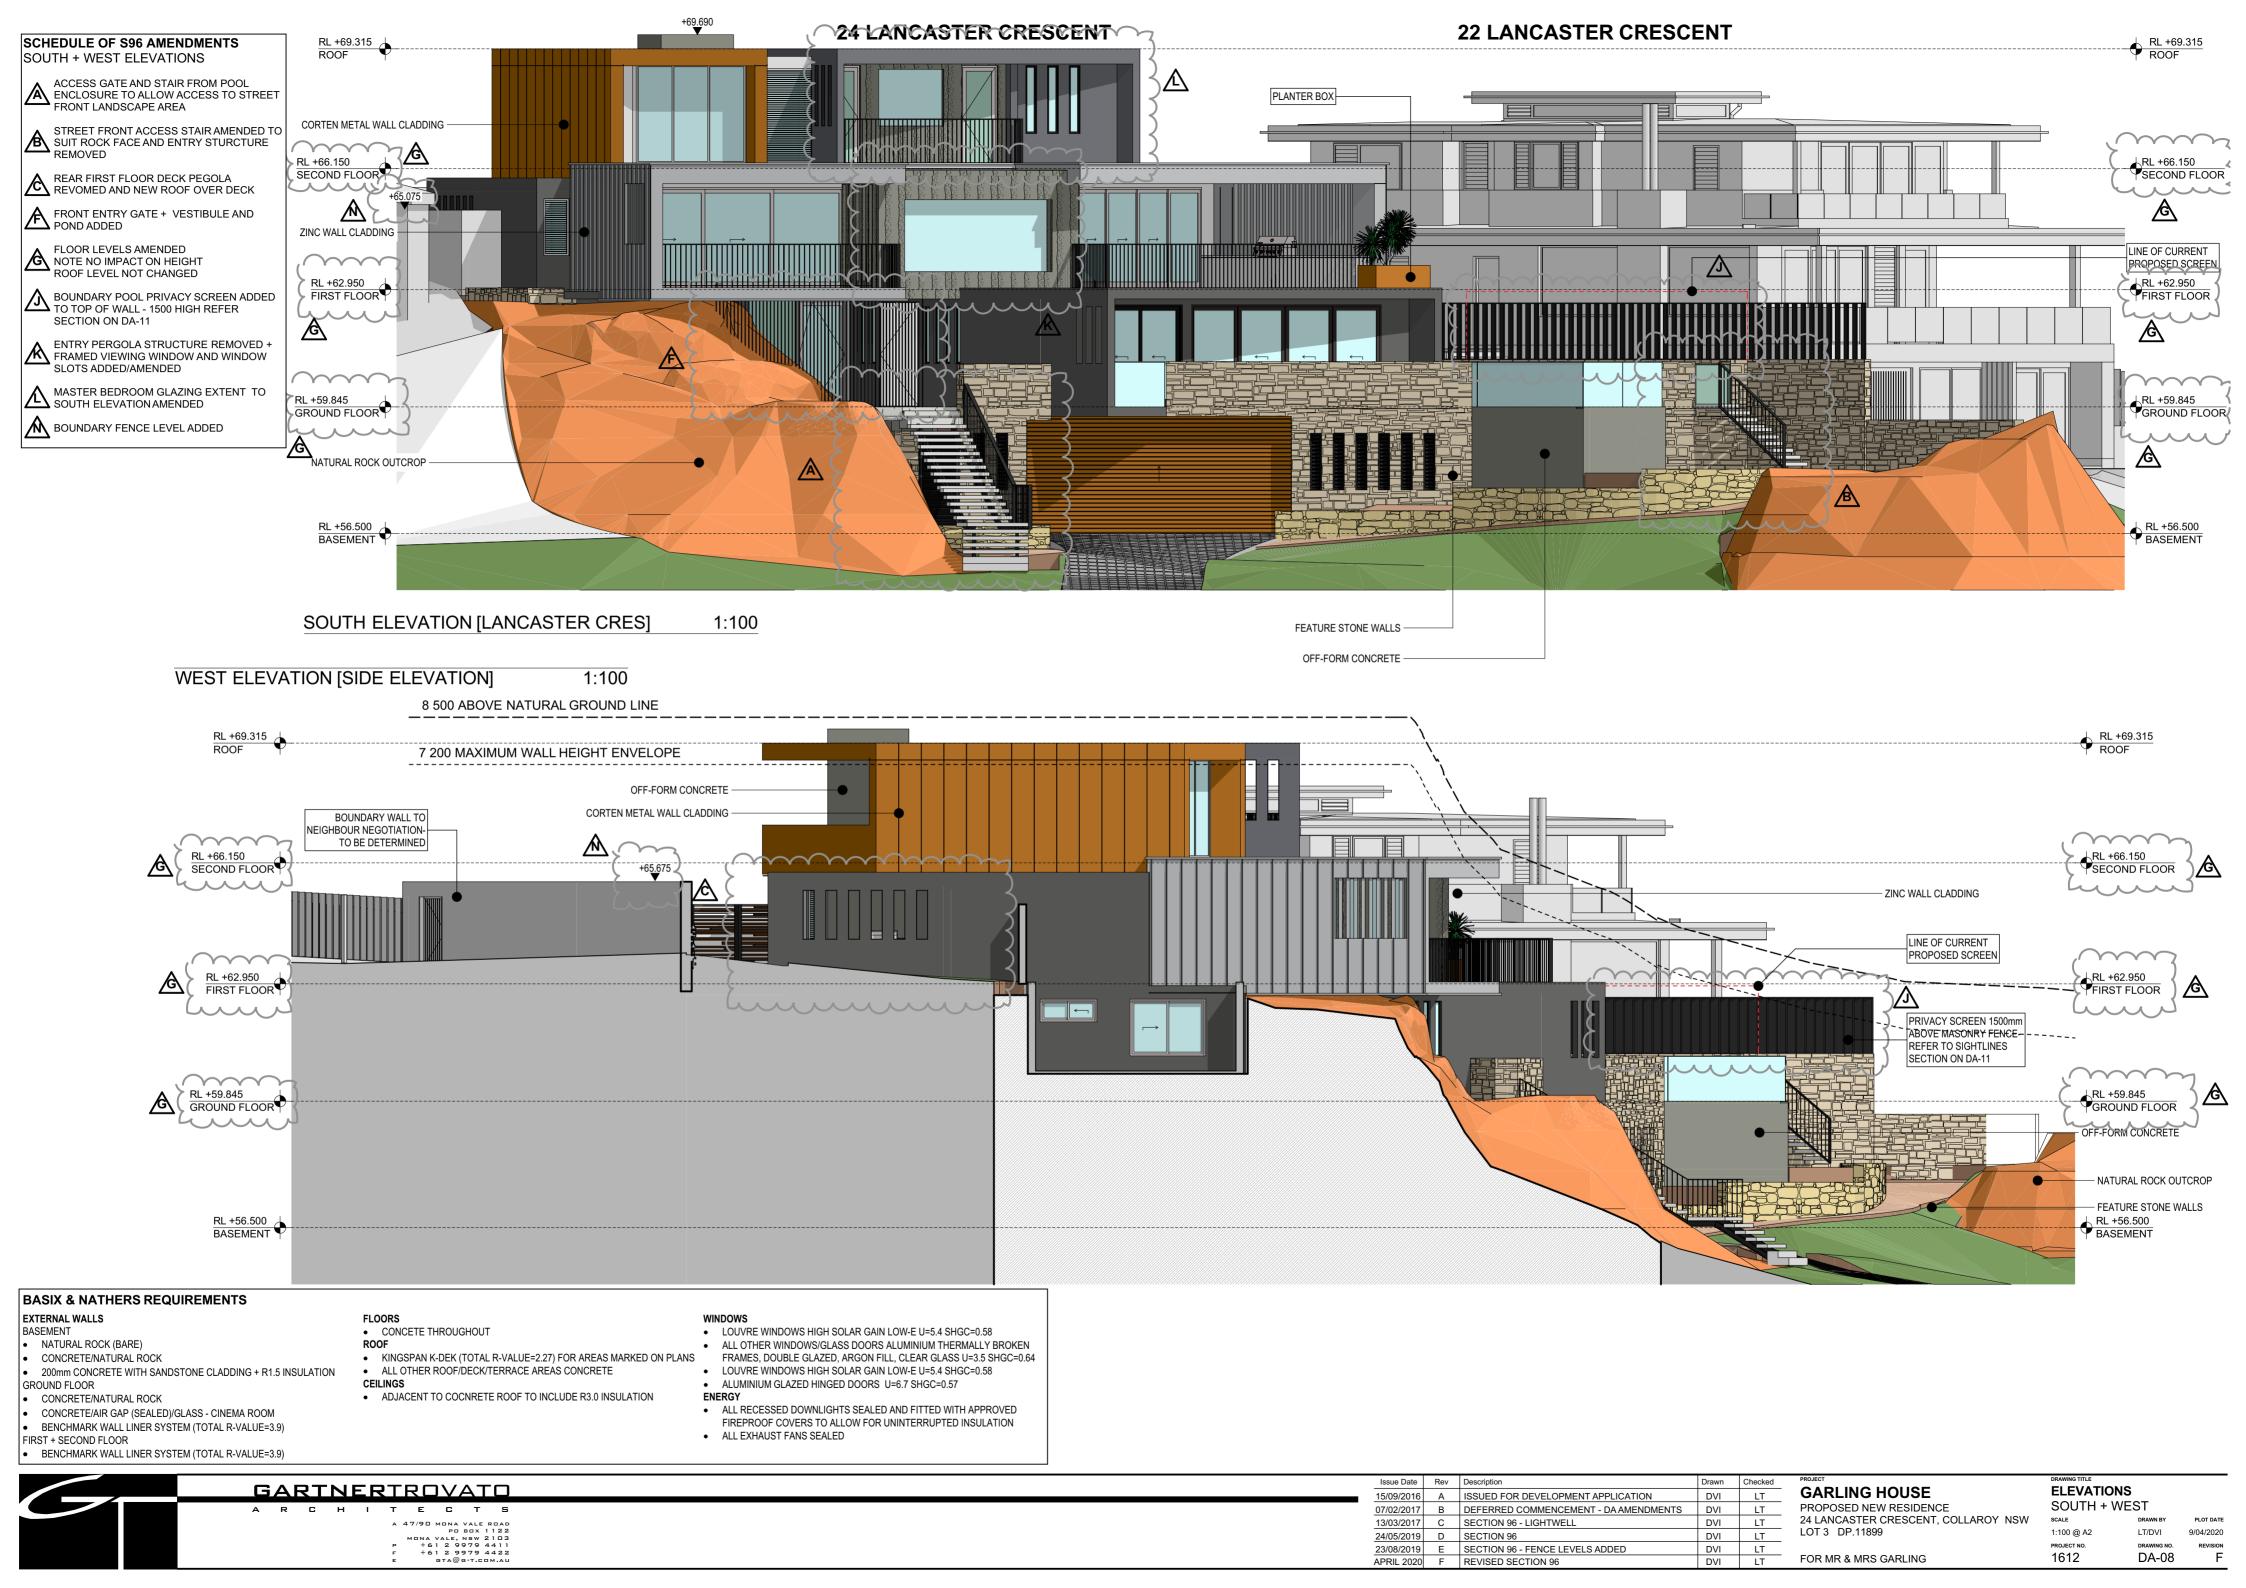

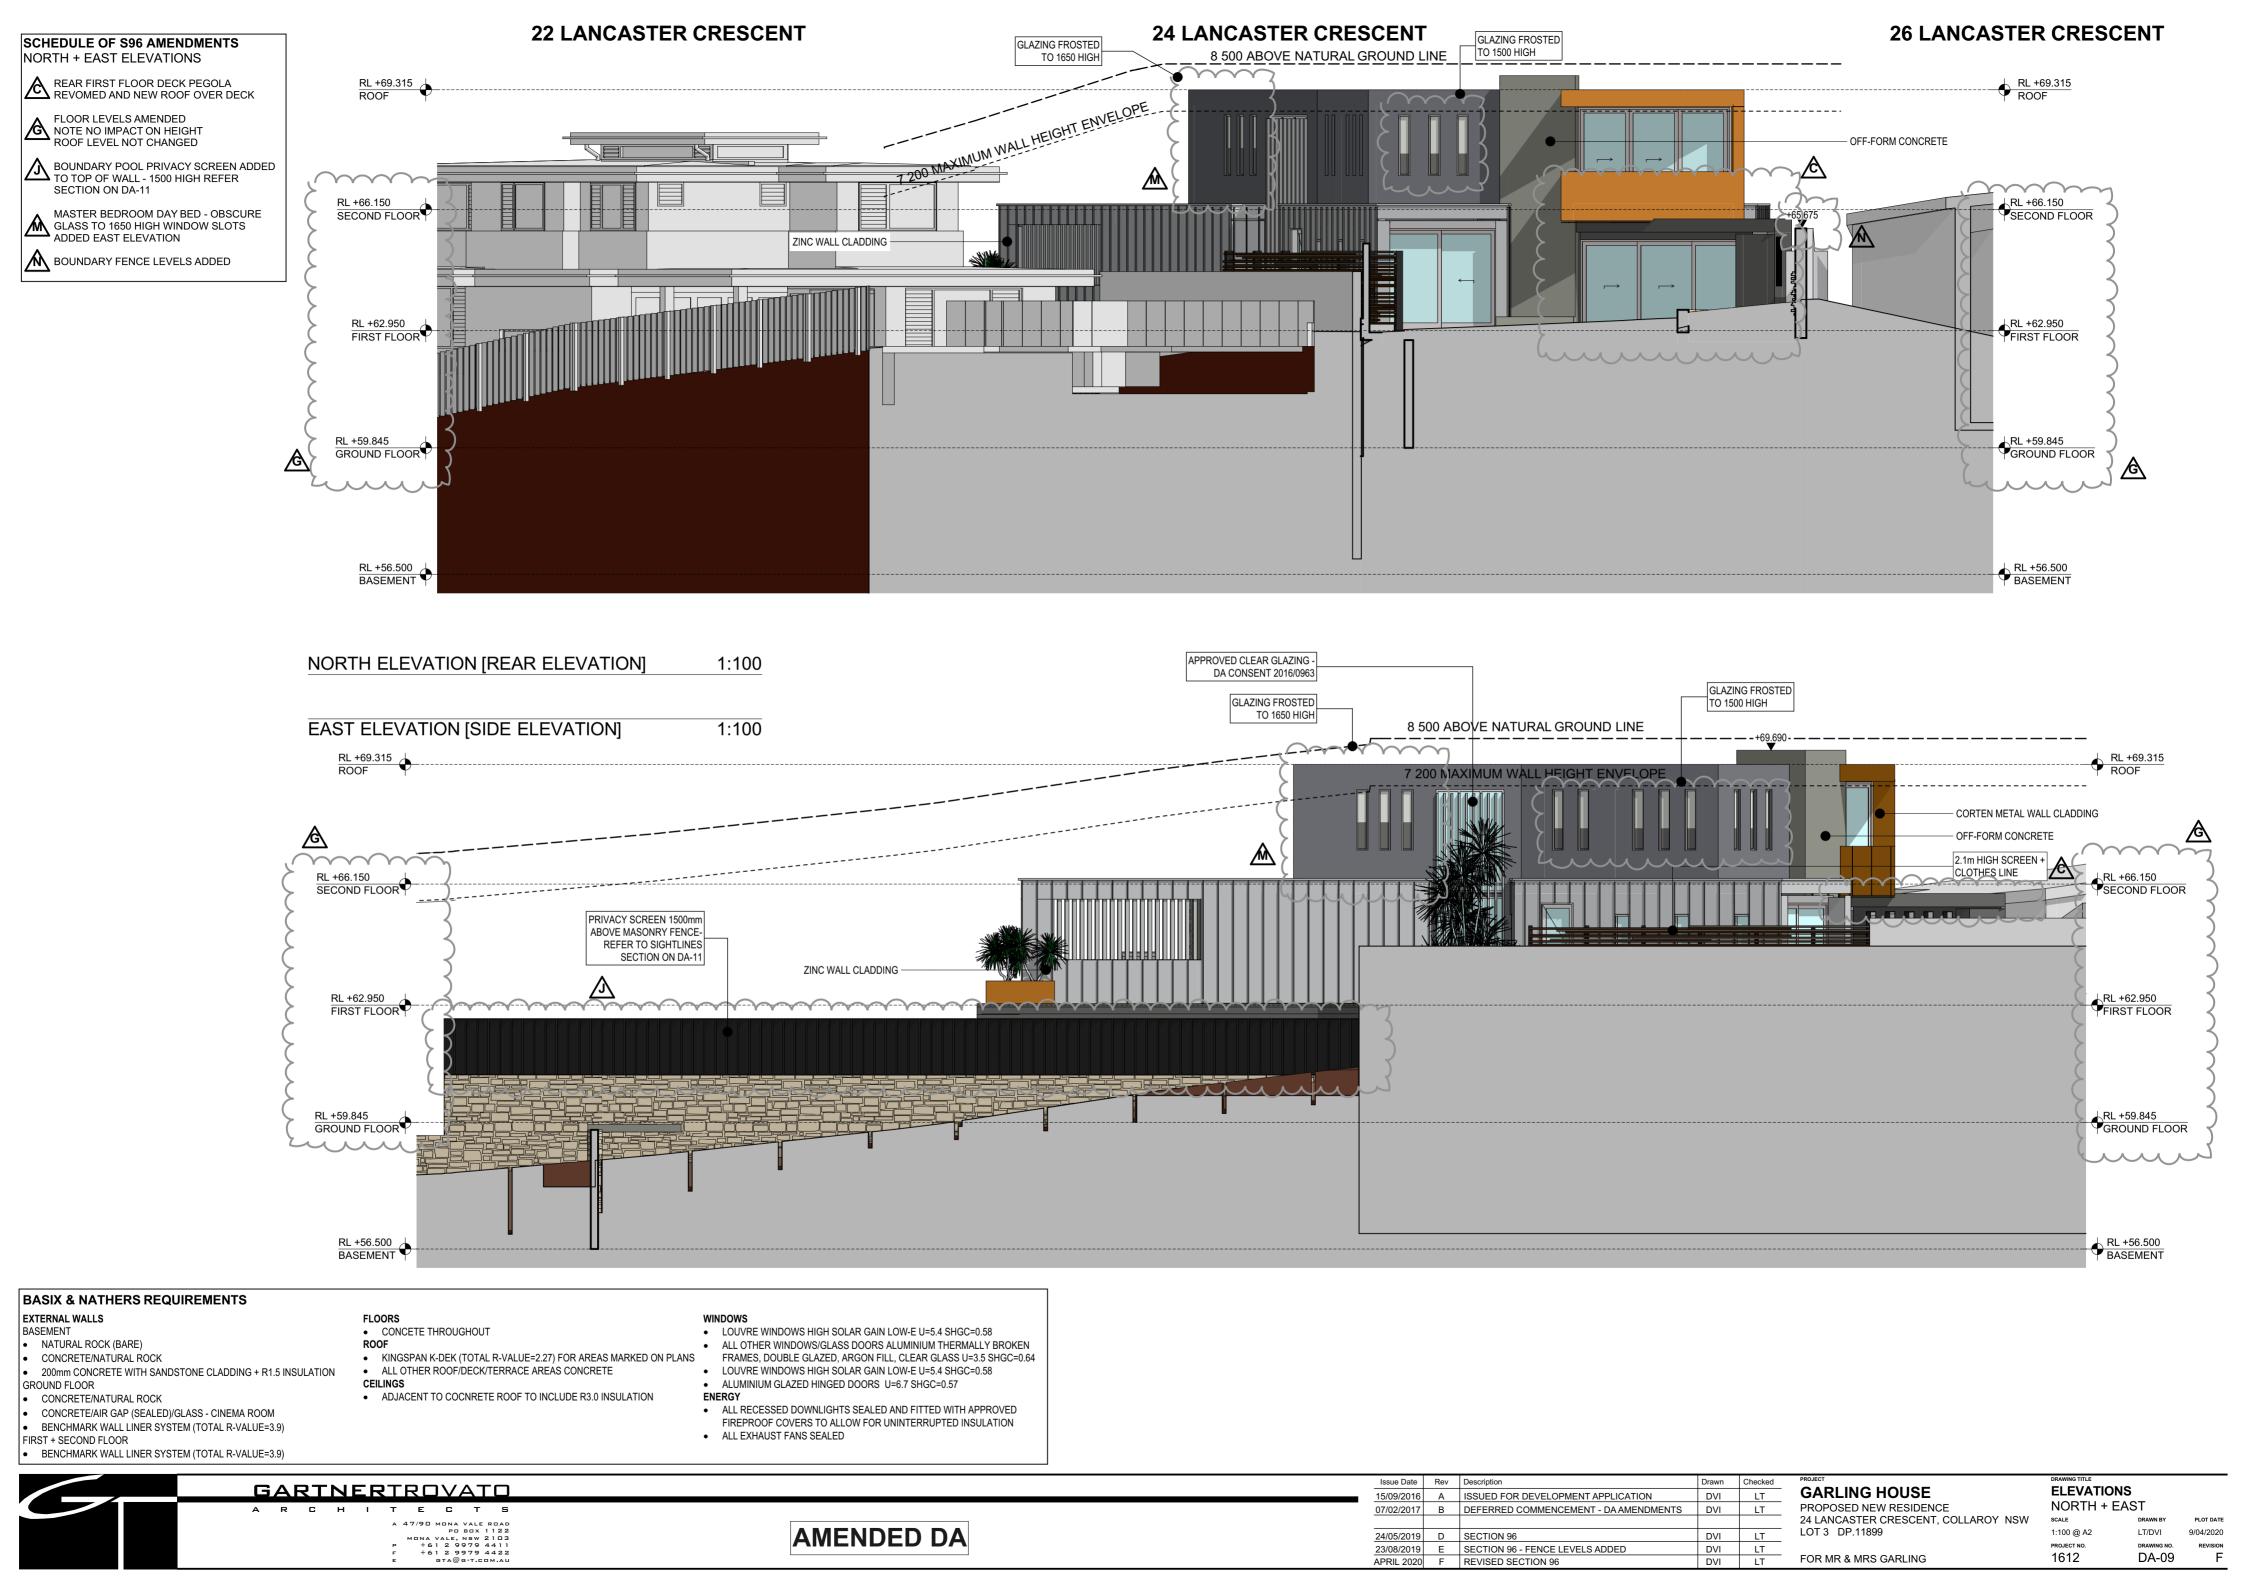

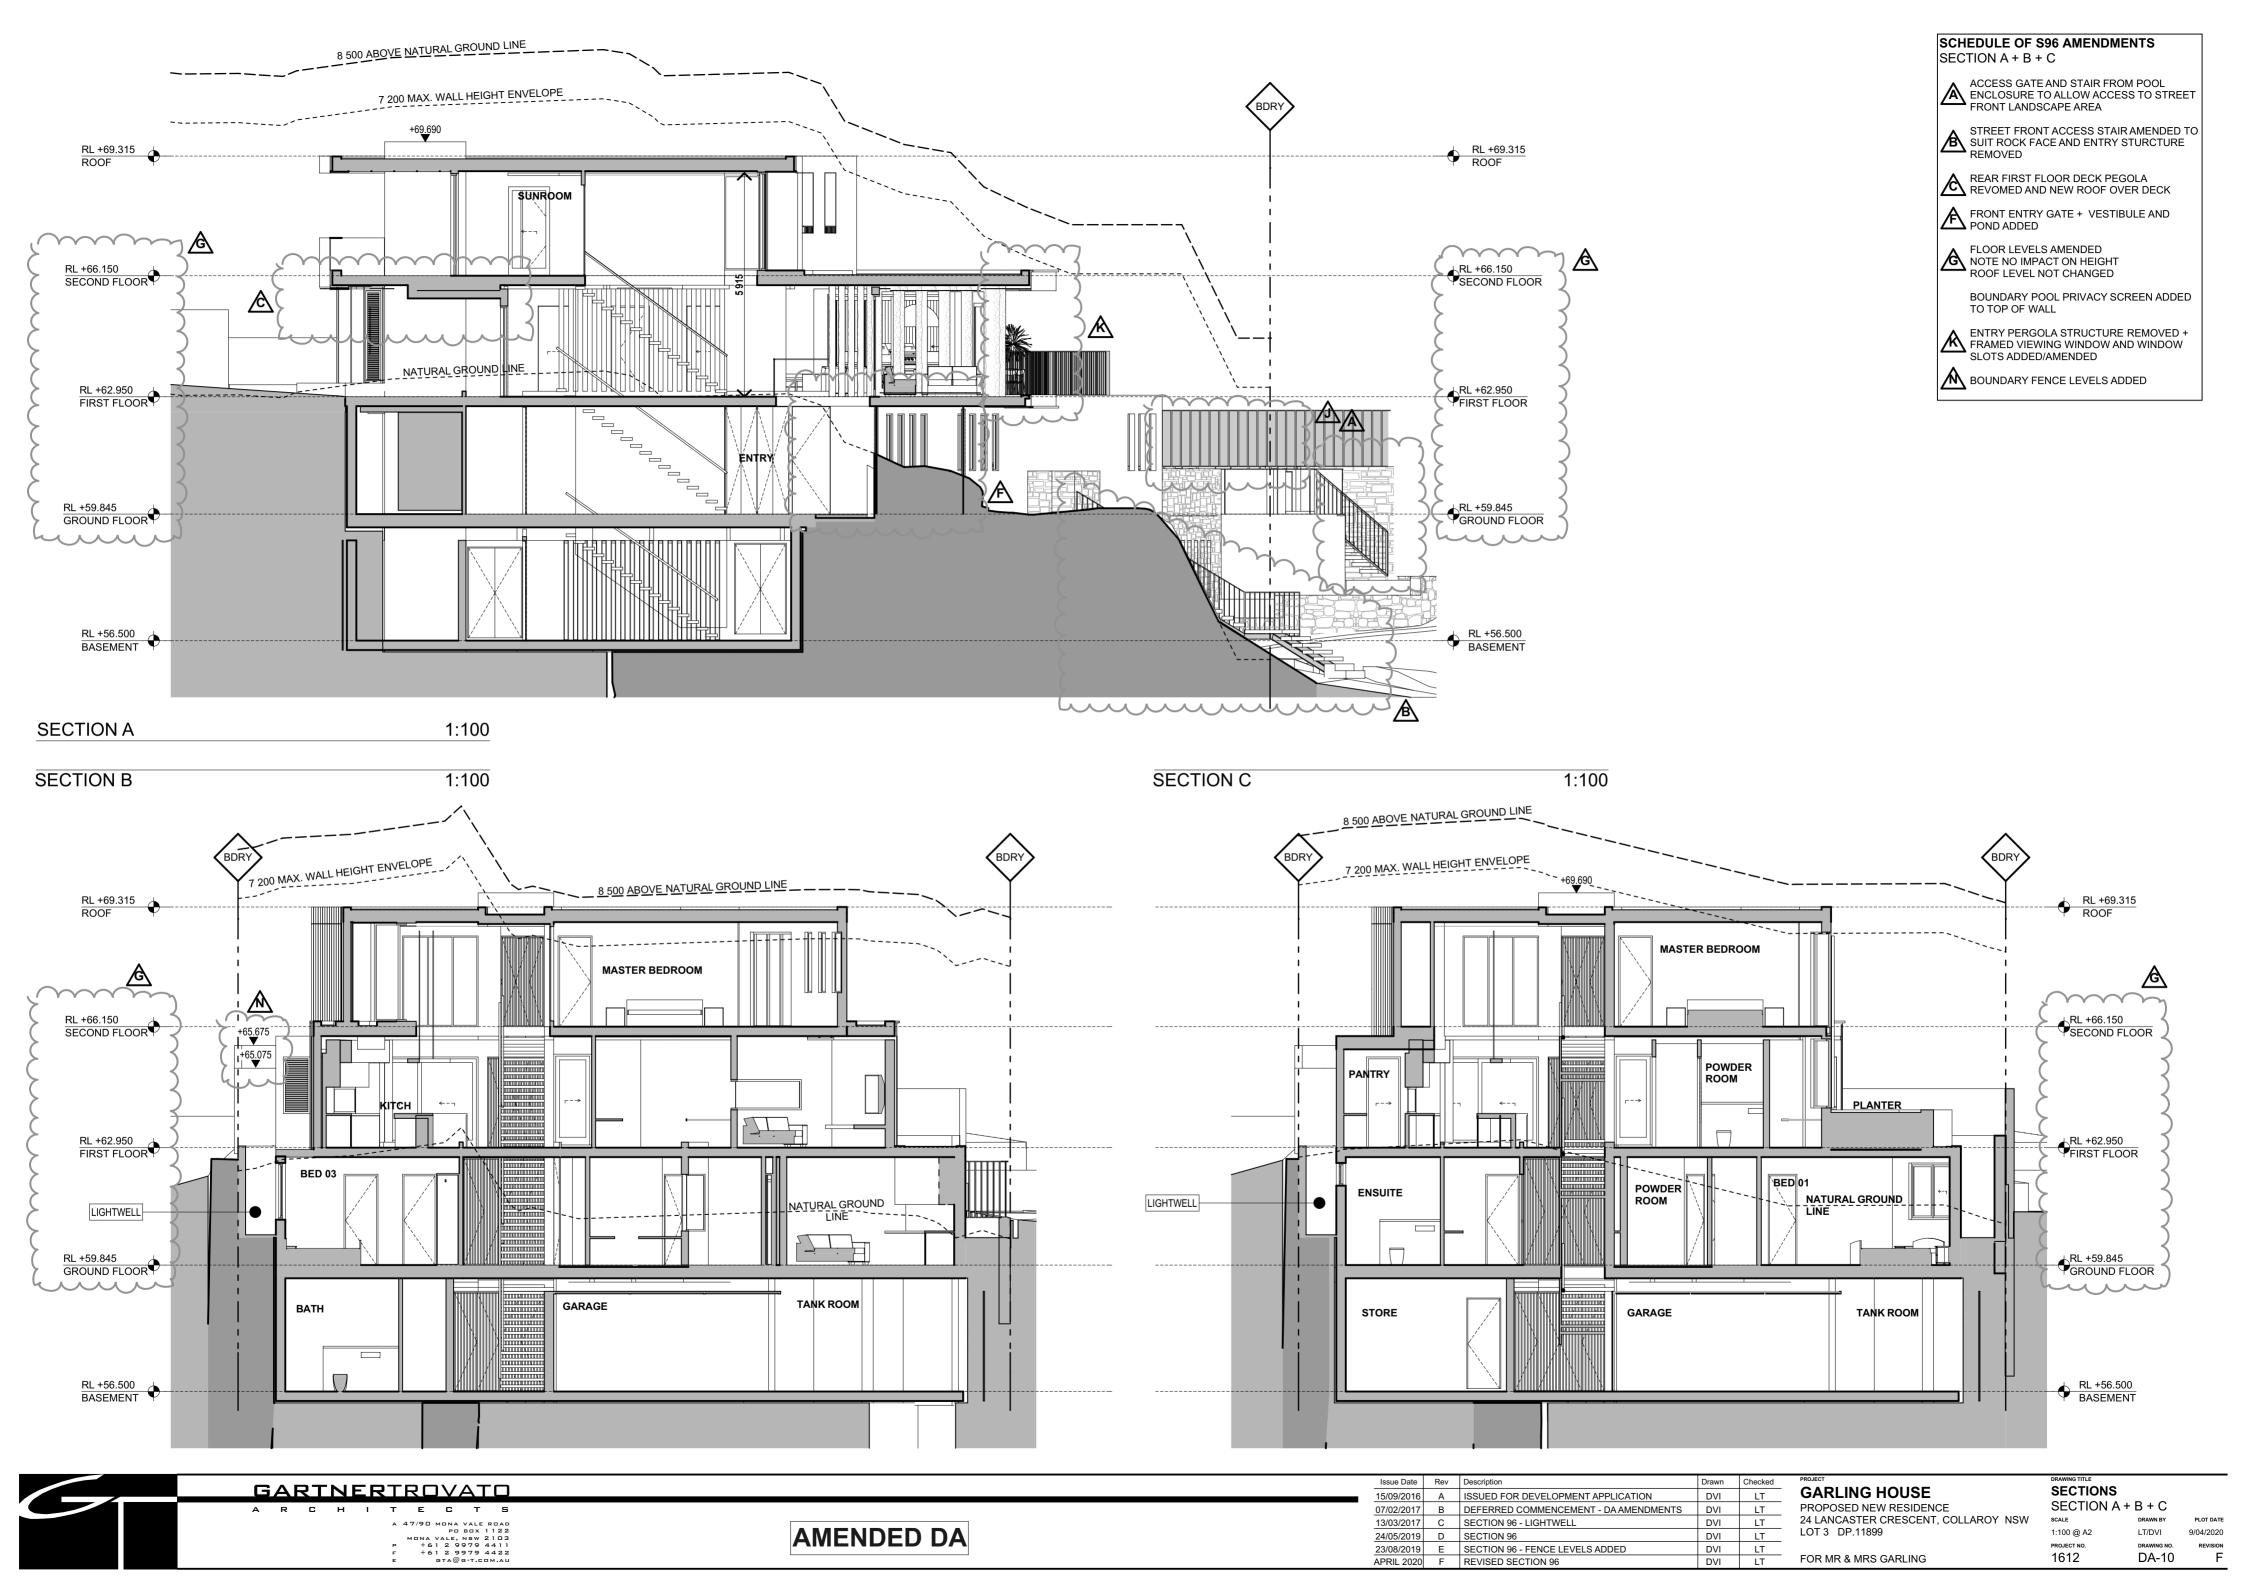

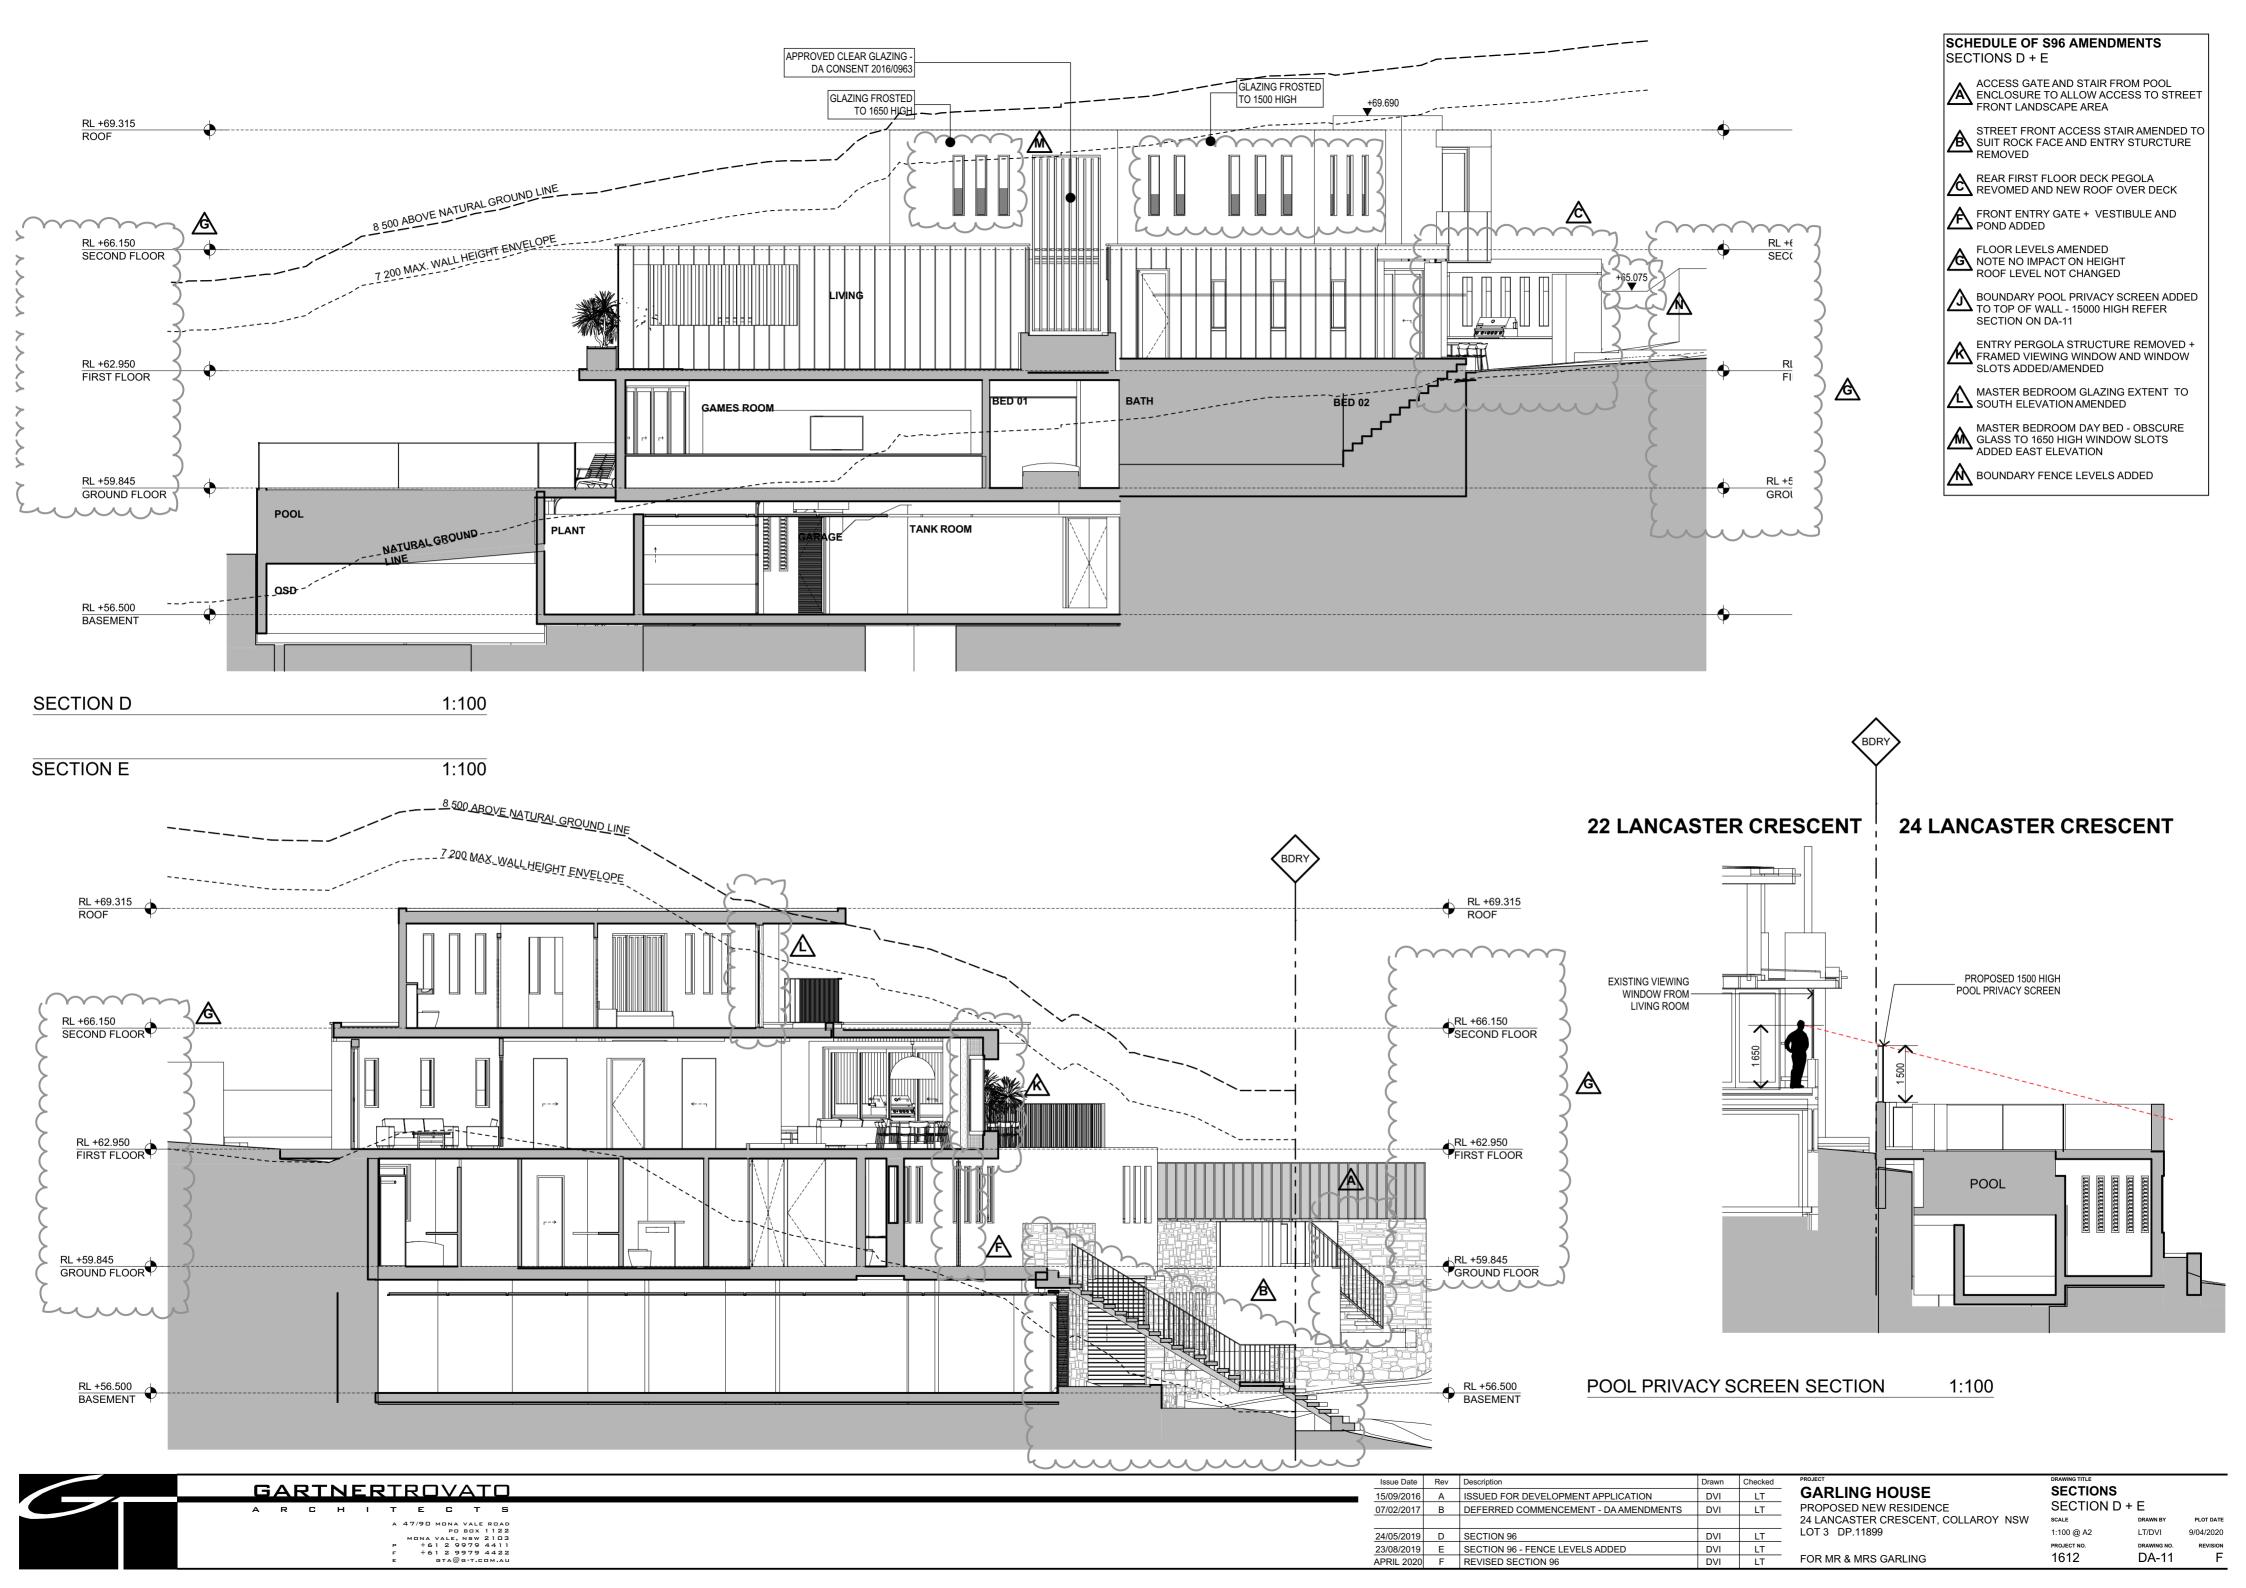




VIEW 01 22 LANCASTER REAR - POOL VIEW NORTH




VIEW 04 22 LANCASTER - POOL VIEW SOUTH



VIEW 06 VIEW FROM FIRST FLOOR TERRACE - NO PLANTER BOX

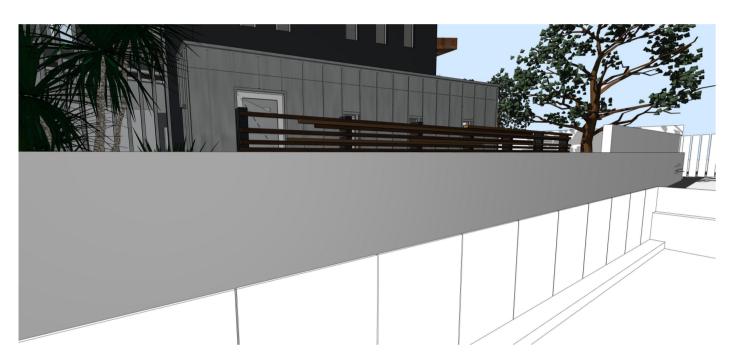

VIEW 02 22 LANCASTER - POOL VIEW SOUTH

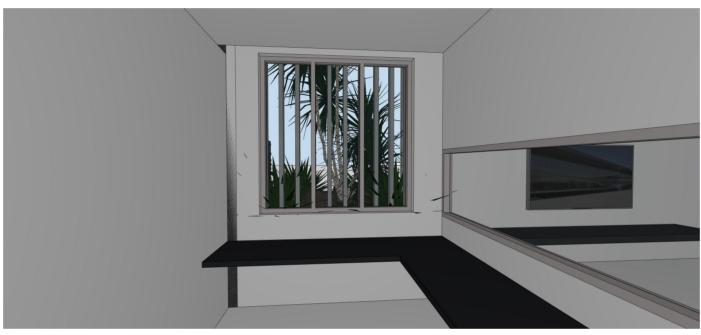

VIEW 05 VIEW FROM STUDY



VIEW 06 VIEW FROM FIRST FLOOR TERRACE - PLANTER BOX



VIEW 03 VIEW FROM SUNROOM

GARTNERTROVATO	Issue Date Rev Description Drawn Checked PROJECT CARLING LIQUISE	DRAWING TITLE SUPPORTING	IMAGE	
GARINERIROVATO	GARLING HOUSE	SUPPORTING	INIAGE	
ARCHITECTS	PROPOSED NEW RESIDENCE			,
A 47/90 MONA VALE ROAD	24 LANCASTER CRESCENT, COLLAROY NSW	SCALE	DRAWN BY	PLOT DATE
PO BOX 1122 Mona Vale, NSW 2103	LOT 3 DP.11899	@ A2	####	14/04/2020
P +61 2 9979 4411			DRAWING NO.	REVISION
F +61 2 9979 4422 E GTA@G-T.COM.AU	APRIL 2020 F REVISED SECTION 96 DVI LT FOR MR & MRS GARLING	1612	DA-15	F













RESENE HALF FOUNDRY



FRAMELESS GLASS BALUSTRADE



OFF FORM CONCRETE PRECAST WALL PANEL



WINDOW FRAMES: ANODISED ALUMINIUM



CONCRETE ROOF BALAST RIVER PEBBLE

FEATURE STONE WALLS



FEATURE STONE WALLS



CORTEN METAL WALL CLADDING WITH EXPRESSED JOINTS



ZINC WALL CLADDING STANDING SEAM TO EXTERNAL WALL EXPRESSED JOINTS TO SOFFITS



## PLANT SCHEDULE revised 28.05.2019

Email selena@selenalandscapedesign.com.au

Botanical Name	Common Name	Height x Spread at	Pot size, minimum	Qty
		Maturity (mm)	mmmam	
TREES AND TALL S	CREENING SHRU	BS		
* Local native species				
* Banksia ericifolia	Heath Banksia	5000 x 3000	200mm	2
To be grown from				
local provenance seed			000	2
* Banksia integrifolia	Coastal Banksia	8000 x 6000	200mm	2
To be grown from				
local provenance seed	NZOshbasa	5000 x 2000	100L	1
Cordyline australis	NZ Cabbage	5000 X 2000	1001	'
C Li-fi-if-li-	Tree (green)  Dwarf Gum	4000 x 4000	45L	2
Corymbia ficifolia cvs	'Summer Red',	4000 x 4000	402	_
'Summer Red' and	Summer 'Orange'			
'Summer Orange' Dracaena marginata	Dracaena	4000 x 2000	Site tp	1
* Leptospermum	Coastal Tea Tree	3000 x 2000	200mm	3
laevigatum	Oodotal rod rivo			
Magnolia grandiflora	Teddy Bear	3000 x 2000	300mm	5
'Teddy Bear'	Magnolia			
Plumeria acutifolia	Frangipani	5000 x 4000	Site tp	1
Syzygium luehmannii	Riberry	3000 x 1500	45L	5

Botanical Name	Common Name	Height x Spread at Maturity (mm)	Pot size, minimum	Qty
GROUNDCOVERS A	ND CLIMBERS AN	D SUCCULEN	ITS	
Anigozanthos 'Amber Velvet', 'Ruby Velvet'	Kangaroo Paws, (Ozbreed)	500 x 500	150mm	20
Bromeliads, various	Bromeliads	400 x 400	200mm	15
Grevillea 'Bronze Rambler'	Grevillea Bronze Rambler	300 x 2000	200mm	3
Grevillea lanigera 'Mt Tamboritha'	Woolly Grevillea Mt Tamboritha	300 x 1000	150mm	10
* Hibbertia scandens	Snake Vine	1000 x 2000	150mm	10
Kalanchoe 'Flap Jacks'	Flap Jacks	500 x 500	200mm	12
Liriope 'Just Right'	Turf Lily Just Right	400 x 450	150mm	50
Lomandra 'Nyalla'	Mat Rush Nyalla	600 x 600	150mm	25
Lomandra 'Tanika'	Tanika Lomandra	500 x 500	150mm	50
* Lomandra longifolia	Mat Rush	1000 x 100	150mm	10
* Myoporum parvifolium	Creeping Boobialla	150 x 1000	150mm	10
* Pandorea pandorana	Wonga Wonga	3000 x 4000	200mm	
Senecio serpens	Blue Chalk Sticks	300 x 500	150mm	1
* Viola hederacea	Native Violet	50 x 500	100mm	4

Botanical Name	Common Name	Height x Spread at	Pot size, minimum	Qty
		Maturity (mm)		
SHRUBS AND ACCE	NT PLANTS			
* Asplenium australasicum	Birds Nest Fern	1000 x 1000	300mm	2
Blechnum 'Silver Lady'	Water Fern 'Silver Lady'	500 x 500	200mm	3
Cordyline australis	NZ Cabbage Palm 'Peko'	1500 x 500	200mm	9
Cordyline terminalis 'Caruba Black'	Ti Tree 'Caruba Black'	1500 x 600	200mm	3
* Correa alba	Coastal Correa	600 x 600	150mm	10
* Macrozamia communis	Burrawang	1500 x 1500	45L	3
Syzygium 'Cascade'	Cascade Lillypilly	2000 x 1000	300mm	6
* Westringia fruticosa	Coastal Rosemary	400 x 400	200mm	17

Botanical Name	Common Name	Height x Spread at Maturity (mm)	Pot size, minimum	Qty
ROAD RESERVE - 1		E SMALL TR	EES,	
SHRUBS AND GROU	JNDCOVERS			
* Banksia spinulosa	Hairpin Banksia	1000 x 1000	100mm	tba
* Correa alba	Coastal Correa	600 x 600	100mm	tba
* Leptospermum laevigatum	Coastal Tea Tree	3000 x 2000	100mm	tba
* Lomandra longifolia	Mat Rush	1000 x 100	100mm	tba
* Macrozamia communis	Burrawang	1500 x 1500	200mm	tba
* Myoporum parvifolium	Creeping Boobialla	150 x 1000	100mm	tba
* Westringia fruticosa	Coastal Rosemary	400 x 400	100mm	tba

