


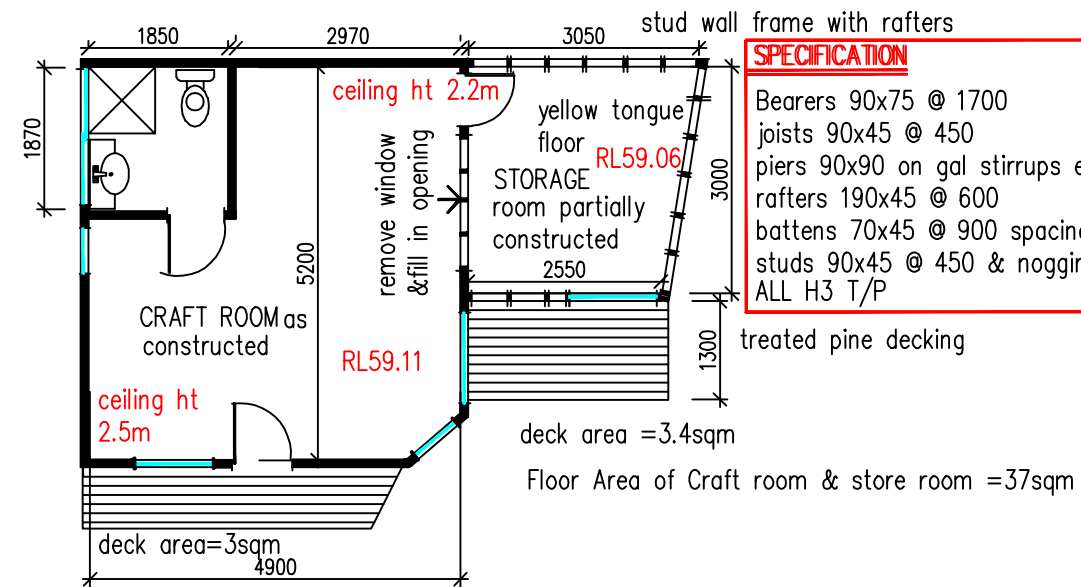


AS CONSTRUCTED FLOOR PLAN OF CRAFT ROOM WITH ANCILLARY STORE ROOM

SPECIFICATION
 Bearers 90x75 @ 1700
 joists 90x45 @ 450
 piers 90x90 on gal stirrups embedded in concrete
 rafters 190x45 @ 600
 battens 70x45 @ 900 spacing
 studs 90x45 @ 450 & noggins 90x45
 ALL H3 T/P

NORTH

PART SITE PLAN 1-100
 see Survey prepared by WATERVIEW 01/06/25
 2040ident 1

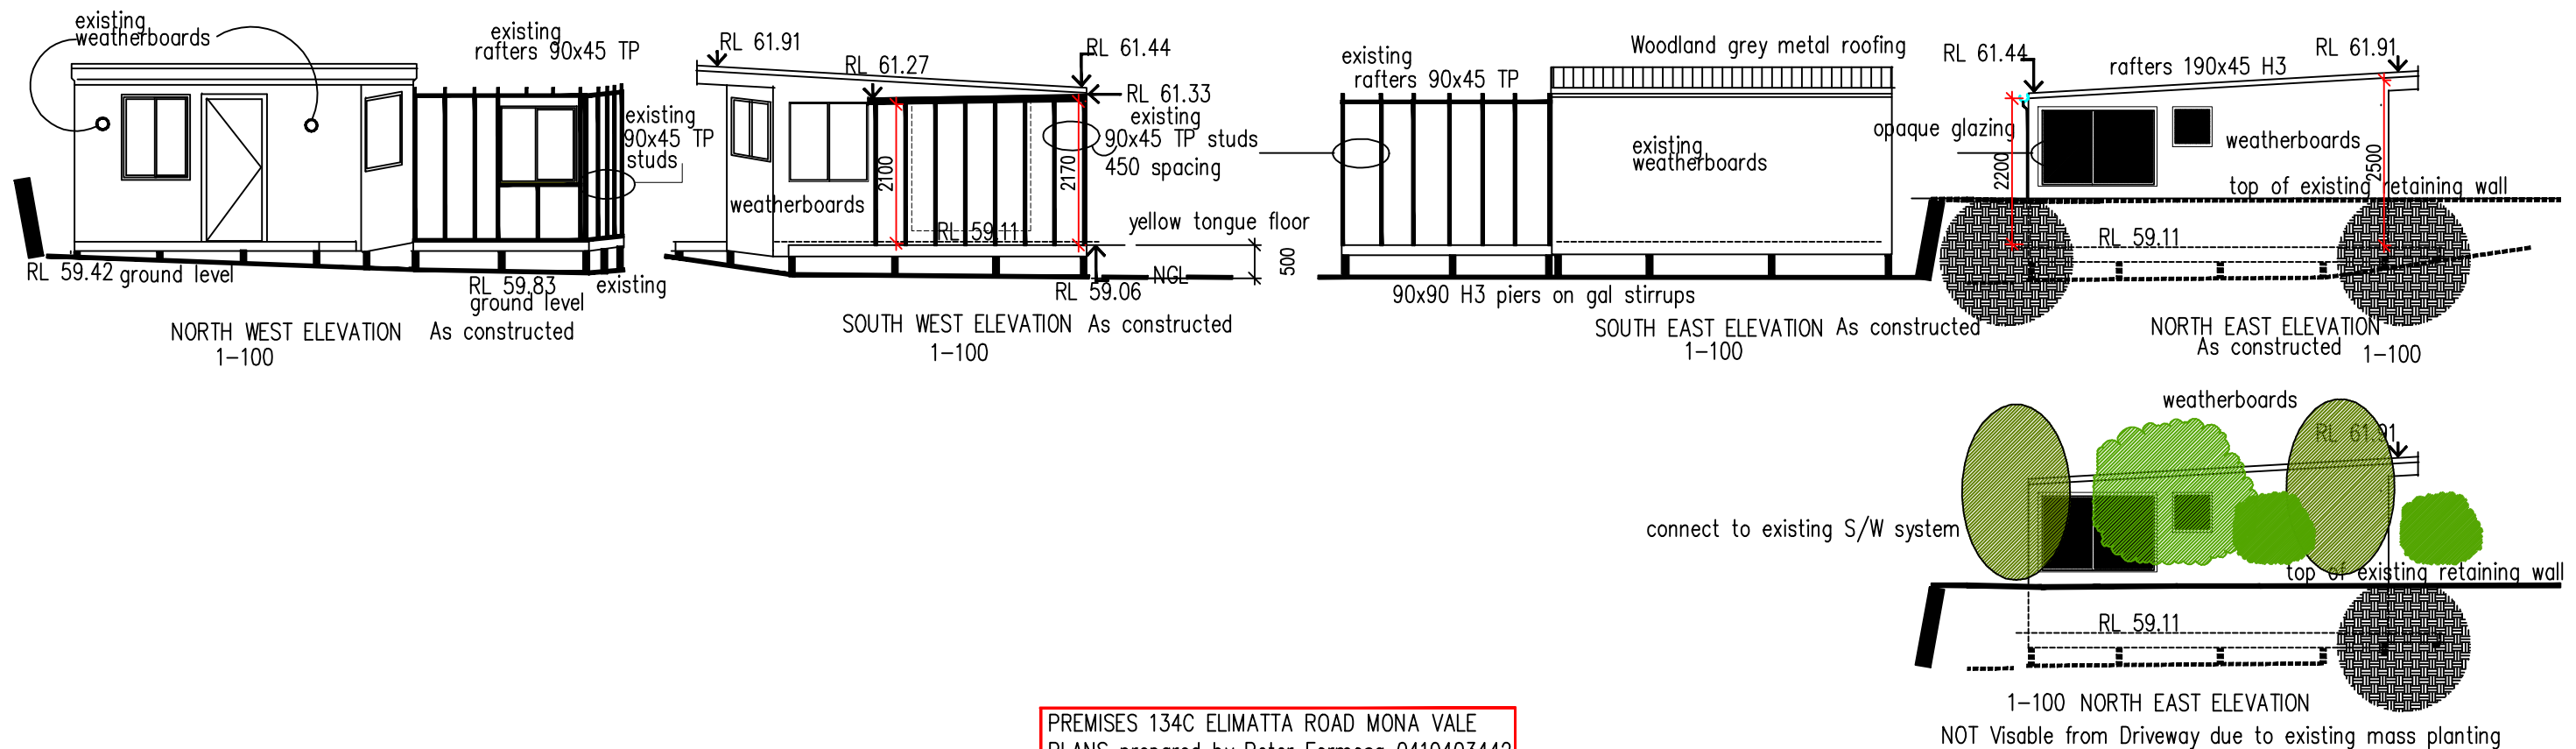

PREMISES 134C ELIMATTA ROAD MONA VALE
 PLANS prepared by Peter Formosa 0410403442
 8/07/2025 DWG No 134 A-1 scale 1-100