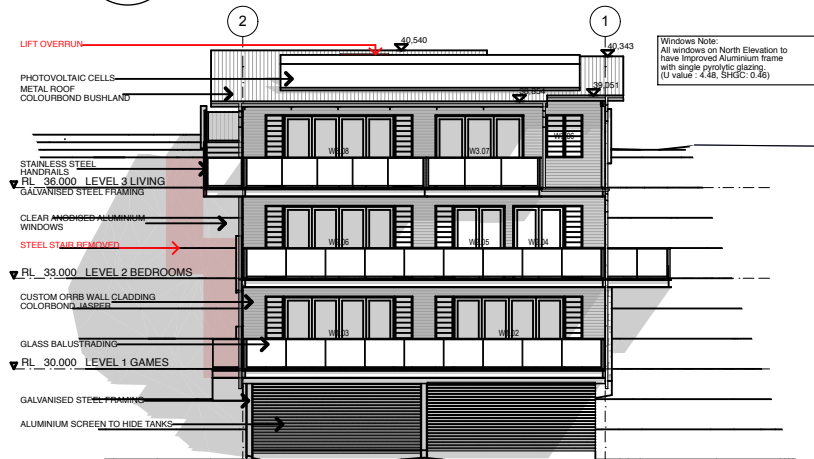
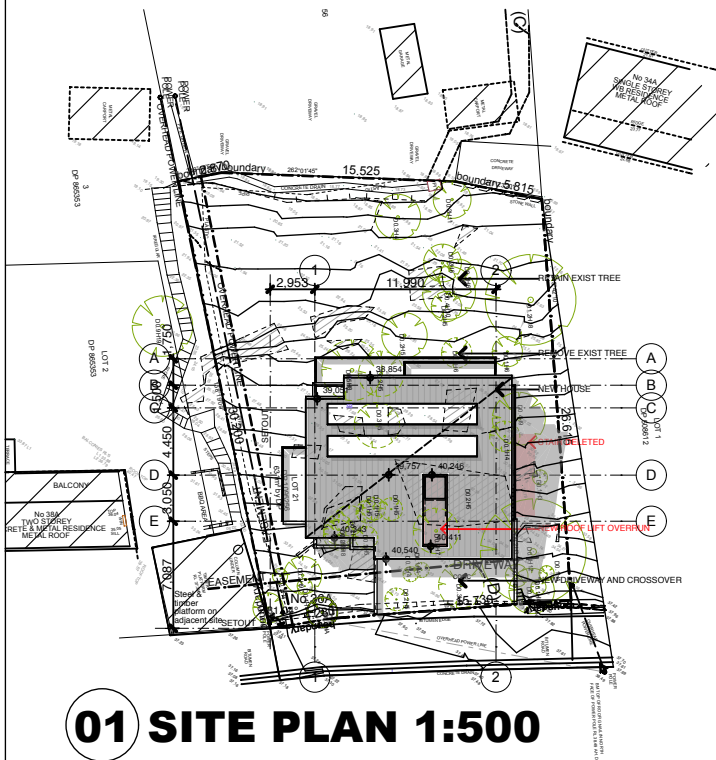
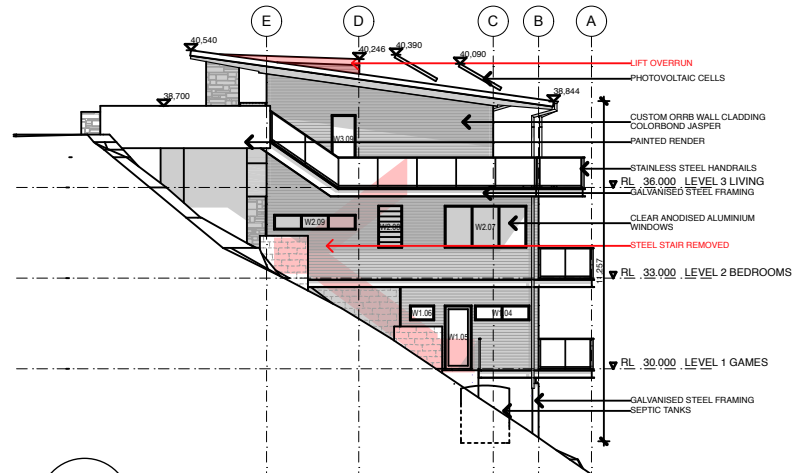
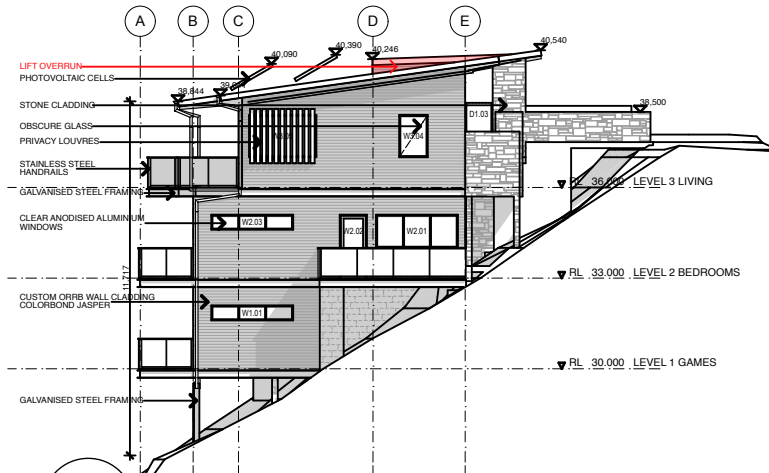


NOTE-
PROPOSED S96 AMENDMENTS
SHOWN IN RED

Adjoining house No 38A
A
ISSUED FOR COMMENT
28/02/17

Amendments

Architect

Fortey + Grant Architecture
Studio 3/Level 3, 35 Buckingham Street
Surry Hills NSW 2010
mob: 0401 822 223
email: james@fgarch.com.au

Project Details

NEW HOUSE AT

**36A COWAN DRIVE
COTTAGE POINT NSW
2087**

This drawing should be read in conjunction with all relevant contracts, specifications, reports and drawings. All dimensions used to be figured dimensions only. Do not scale from drawings. Report any discrepancies to the Architect for a decision before proceeding with work.

Drawn JG Approved JG Date Printed 28/02/2017

Job Number 1703

Scale As shown @ A3

Drawing name

NOTIFICATION PLAN

Drawing Number Amendment

S96-09 A