

18 ALEXANDER STREET COLLAROY

ISSUE FOR DEVELOPMENT APPLICATION APPROVAL

1	~ ~~	A A A A	Y~
	NUMBER	SHEET NAME	REVISION
	DA000	COVER PAGE & DRAWING LIST	В
	DA010	SITE ANALYSIS	А
	DA102	PROPOSED SITE PLAN	В
	DA110	BASEMENT PLAN	В
-	DA111	UNDERCROFT FLOOR PLAN	В
	DA112	LEVEL 1 FLOOR PLAN	В
	DA113	LEVEL 2 FLOOR PLAN	В
_	DA114	ROOF PLAN	В
	DA201	BUILDING SECTIONS - SHEET 1	В
	DA202	BUILDING SECTIONS - SHEET 2	В
	DA203	BUILDING SECTIONS - SHEET 3	В
	DA300	ELEVATIONS	В
	DA400	AREA CALCULATIONS - GFA	В
	DA401	AREA CALCULATIONS - LANDSCAPE	В
-	DA500	SHADOW DIAGRAMS - 9AM JUNE 21ST	В
	DA502	SHADOW DIAGRAMS - 12PM JUNE 21ST	В
	DA503	SHADOW DIAGRAMS - 3PM JUNE 21ST	В
_	DA511	VIEWS FROM THE SUN - 9, 10 & 11AM	В
	DA512	VIEWS FROM THE SUN - 12, 1, 2PM	В
	DA513	VIEWS FROM THE SUN - 3PM	В

4.55 MODIFICATION

05.09.22

18 ALEXANDER ST COLLAROY NSW

Regulated Design Re	cord				
ddress: 18 ALEXANDER ST COLLAROY NSW					
	Body Corporate Reg No: NA	15 AL EXAMPLES			
	Drawing No: DA102	15 ALEXANDER STREET 2 STOREY DWELLING	13 ALEXANDER STREET		
Title: PROPOSED SITE PLAN			13 ALEXANDER STREET 1 STOREY DWELLING		
Date Description	DP Full Name Reg No		11 11 500		
24.05.2022 FOR CONSTRUCTION	SCOTT WALSH DEP0001107		11 ALEXANDER STREET 2 STOREY DWELLING		
				9 ALEXANDER STREET 2 STOREY DWELLING	
				7 ALEXANDER STREET 1 STOREY DWELLING	
					4 COLLAD
					YHA YOUTH HOSTEL
		POWER POLE O			
KS MUST COMPLY WITH THE FOLLOWING PROVISIONS OF THE BCA:					
- MATERIALS & FORMS CONSTRUCTIONS IRE RESISTING CONSTRUCTION NON-COMBUSTIBLE BUILDING ELEMENT					
FIRE HAZARD PROPERTIES PERFORMANCE OF EXTERNAL WALLS IN A FIRE					
· VERTICAL SEPARATION OF OPENINGS IN EXTERNAL WALLS – SEPARATION OF EQUIPMENT	T ·				
- ELECTRICITY SUPPLY SYSTEM - ACCEPTABLE METHODS OF PROTECTION (OF OPENINGS)			ALEXANDED		
- OPENING IN FIRE ISOLATED EXITS - OPENINGS FOR SERVICE INSTALLATIONS - DISCHARGE FROM EXITS			ALEXANDER STREET		
INSTALLATIONS IN EXITS AND PATHS OF TRAVEL – GOINGS AND RISERS					
LANDINGS - THRESHOLDS - BALUSTRADES			O DOMES -		
– HANDRAILS – OPERATION OF LATCH			POWER POLE		
– SIGN ON DOORS – PROTECTION OF OPENABLE WINDOWS			0006		
GENERAL BUILDING ACCESS REQUIREMENTS PARTS OF BUILDING TO BE ACCESSIBLE IDENTIFICATION OF ACCESSIBLE FACILITIES, SERVICES AND FEATURES	24 AI FYANDED		9 ₀₀₀		
TACTILE INDICATORS SPRINKLERS	24 ALEXANDER STREET 1 STOREY DWELLING 22 ALEXANDER STRE 3 STOREY DWELL		9600 9800		
WATERPROOFING OF WET AREAS 1.10 - DAMP PROOFING	3 STOREY DWELLIN	REET	2086		
CONSTRUCTION OF SANITARY COMPARTMENTS ITING AND VENTILATION SOUND INSULATION OF FLOORS			00001		
SOUND INSULATION OF WALLS SOUND INSULATION OF SERVICES			0020j		
SOUND INSULATION OF PUMPS					10 AL TYLIN
					10 ALEXANDER STREET 3 STOREY MULTI-UNIT HOUSING 8 ALEXANDER STREET
					8 ALEXANDER STREET 3 STOREY MULTI-UNIT HOUSING
				14 ALEXANDER STREET	1 11005
TES TES				14 ALEXANDER STREET 2 STOREY DWELLING	
RITTEN DIMENSIONS TO TAKE PRECEDENCE OVER SCALED DIMENSIONS. DO AWING. CONSULT ARCHITECT IF ANY CLARIFICATION IS REQUIRED.	NOT SCALE				
DIMENSIONS ARE IN MILLIMETRES UNLESS OTHERWISE STATED			11200		
ARCHITECTURAL DRAWINGS MUST BE READ IN CONJUNCTION WITH RELI				12 ALEXANDER 2 STOREY DW	STREET Sept 2022 BSA R Building Sustainability Assessments Ph
NTRACTS, ARCHITECTURAL REPORTS, SCHEDULES AND SPECIFICATIONS A NSULTANT DOCUMENTATION	ND ALL OTHER		a 11400		enquiries@buildingsustainability.net.au www. buildingsusta
Y DISCREPANCIES IN DOCUMENTATION ARE TO BE NOTIFIED TO THE PROJ O ARCHITECT PRIOR TO THE COMMENCEMENT OF WORK.	ECT MANAGER				The following specification was used to achieve the thermal performance value the Assessor Certificate. If the proposed construction varies to those details
ER TO MATERIALS AND FINISHES SCHEDULE FOR DETAILS ON MATERIAL S	SELECTION AND	20 ALEXANDER STREET	0091		Assessor and NatHERS certificates will no longer be valid. Assessments a BCA provisions for building sealing & ventilation are complied with at const
CIFICATIONS. ER TO DEVELOPMENT APPLICATION NOTICE OF DECISION FOR ANY AND A	ALL APPROVAL	20 ALEXANDER STREET 4 STOREY DWELLING			In NSW both BASIX & the BCA variations must be complied with, in particular to the complex of th
DITIONS.	I I				- Thermal breaks for Class 1 dwellings in accordance with Part 3.12.1.2(c)
WORK TO COMPLY WITH THE NATIONAL CONSTRUCTION CODE INCLUDIN TRALIAN STANDARDS AND REQUIREMENTS OF THE BUILDING CODE OF AU TRALIAN WORK HEALTH AND SAFETY LEGISLATION			16 ALEXANDED CO.		- Floor insulation for Class 1 dwellings as per Part 3.12.1.5(a)(ii), (iii) & (e)
RALIAN WORK HEALTH AND SAFETY LEGISLATION K RELATING TO ACCESSIBLE REQUIREMENTS TO MEET AS1428.1, UNLESS	S NOTED ,		16 ALEXANDER STREET 2 STOREY DWELLING		External Wall Construction Lightweight
ERWISE. IF A DISCREPANCY EXISTS REFER TO PROJECT MANAGER FOR C	ELARIFICATION.	I LEVIV			
IZ DEL A LINIC LO CUE E CITUE E CASCULTO CON ACCOUNT A LINICES MOTES ATLI	ERWISE. IF A				Internal Wall Construction Plasterboard on studs (internal to units)
			1280		Plasterboard + stud + shaft liner + stud + plasterboard (party wall between Concrete + Plasterboard (adjacent to lift/stair cores)
REPANCY EXISTS REFER TO PROJECT MANAGER FOR CLARIFICATION. VARIATION IN CONSTRUCTION METHODOLOGY OR IN MATERIAL TYPE OF E RECORDED & COMMUNICATED TO THE ARCHITECT & RELATIVE CONSUI			7000		
REPANCY EXISTS REFER TO PROJECT MANAGER FOR CLARIFICATION. VARIATION IN CONSTRUCTION METHODOLOGY OR IN MATERIAL TYPE OF E RECORDED & COMMUNICATED TO THE ARCHITECT & RELATIVE CONSUI JRE ACCURATE WORK AS EXECUTED DRAWINGS.	LTANTS TO		Control of the Contro		Coiling Construction
CREPANCY EXISTS REFER TO PROJECT MANAGER FOR CLARIFICATION. VARIATION IN CONSTRUCTION METHODOLOGY OR IN MATERIAL TYPE OF SE RECORDED & COMMUNICATED TO THE ARCHITECT & RELATIVE CONSULURE ACCURATE WORK AS EXECUTED DRAWINGS. IGN DRAWINGS ARE BASED ON SURVEY INFORMATION. PRIOR TO DETAILE STRUCTION, THE CONTRACTOR IS TO UNDERTAKE A FULL SURVEY TO VE	ED DESIGN AND RIFY ALL				Plasterboard R3.5 to ceilings adjacent to roof












Alternate products may be used if the U SHGC is within the range specified Shade elements (eaves, veranda All shade elements modelled as drawn Ceiling Penetrations (downlights, exhaus Modelled as drawn and/or to comply with the ventilation and sealing required
CREPANCY EXISTS REFER TO PROJECT MANAGER FOR CLARIFICATION. (VARIATION IN CONSTRUCTION METHODOLOGY OR IN MATERIAL TYPE OF BE RECORDED & COMMUNICATED TO THE ARCHITECT & RELATIVE CONSUITS. (SIGN DRAWINGS ARE BASED ON SURVEY INFORMATION. PRIOR TO DETAILE INSTRUCTION, THE CONTRACTOR IS TO UNDERTAKE A FULL SURVEY TO VEILENSIONS AND CONFIRM LOCATION OF EXISTING STRUCTURE, SERVICES, ED. SITE FEATURES. TALLATION OF SYSTEMS AND PROPRIETARY PRODUCTS TO BE STRICTLY IN MANUFACTURERS RECOMMENDATIONS CATION AND SPECIFICATION OF ALL ELECTRICAL SERVICES, FIXTURES AND THE NATIONAL CONSTRUCTION CODE OF AUSTRALIA. CATION AND SPECIFICATION OF ALL MECHANICAL SERVICES, FIXTURES AND THE NATIONAL CONSTRUCTION CODE OF AUSTRALIA. CATION AND SPECIFICATION OF ALL MECHANICAL SERVICES, FIXTURES AND THE NATIONAL CONSTRUCTION CODE OF AUSTRALIA. CATION AND SPECIFICATION OF ALL HYDRAULIC SERVICES, FIXTURES AND THE NATIONAL CONSTRUCTION CODE OF AUSTRALIA. CONSULTANT DRAWING INFORMATION SHOWN ON THE ARCHITECTURAL BE USED AS A GUIDE ONLY. BUILDER TO ENSURE THEY OVERLAY LATEST CANNING. STRUCTURAL COLUMN DIMENSIONS SHOWN ON THE ARCHITECTURAL COLUMN DIMENSIONS SHOWN ON THE ARCHITECTURAL COLUMN DIMENSIONS SHOWN ON THE ARCHITECTURAL CANNINGS ARE FOR SETOUT PURPOSES ONLY AND SHOULD BE CONFIRMED EXPRENT STRUCTURAL DRAWINGS	LTANTS TO ED DESIGN AND RIFY ALL BUILDING FABRIC IN ACCORDANCE D FITTINGS TO BE TION. ALL AN STANDARDS ID FITTINGS TO BE ATION. ALL AN STANDARDS FITTINGS TO BE TION. ALL AN STANDARDS L DRAWINGS ARE CONSULTANT DINCRETE SETOUT		13800		Plasterboard R3.5 to ceilings adjacent to roof a Roof Construction Colour (Solar Absorptance) Act Concrete Any Metal Any Foil Floor Construction Covering Act Concrete As drawn (if not noted default values used) Concrete As drawn (if not noted default values used) Concrete SHGC Range Performance glazing Type A 5.40 0.44 - 0.54 Performance glazing Type B 5.40 0.52 - 0.64 Type A windows are awning windows, bifolds, casements, tilt 'n 'turn' windows, entry default to the sum of the su




Fyshwick ACT 2609 E: scott@walsharchitects.com.au P: 0466 049 880

Nominated Architect : Scott Walsh ACT 2624 | NSW 10366

PRELIMINARY ISSUE FOR DA APPROVAL 4.55 MODIFICATION

PRUPUSED SITE PLAN 15.08.21 SHEET NUMBER 03.09.21 REVISION 05.09.22 SCALE @ A1 18 ALEXANDER ST COLLAROY NSW


1:200

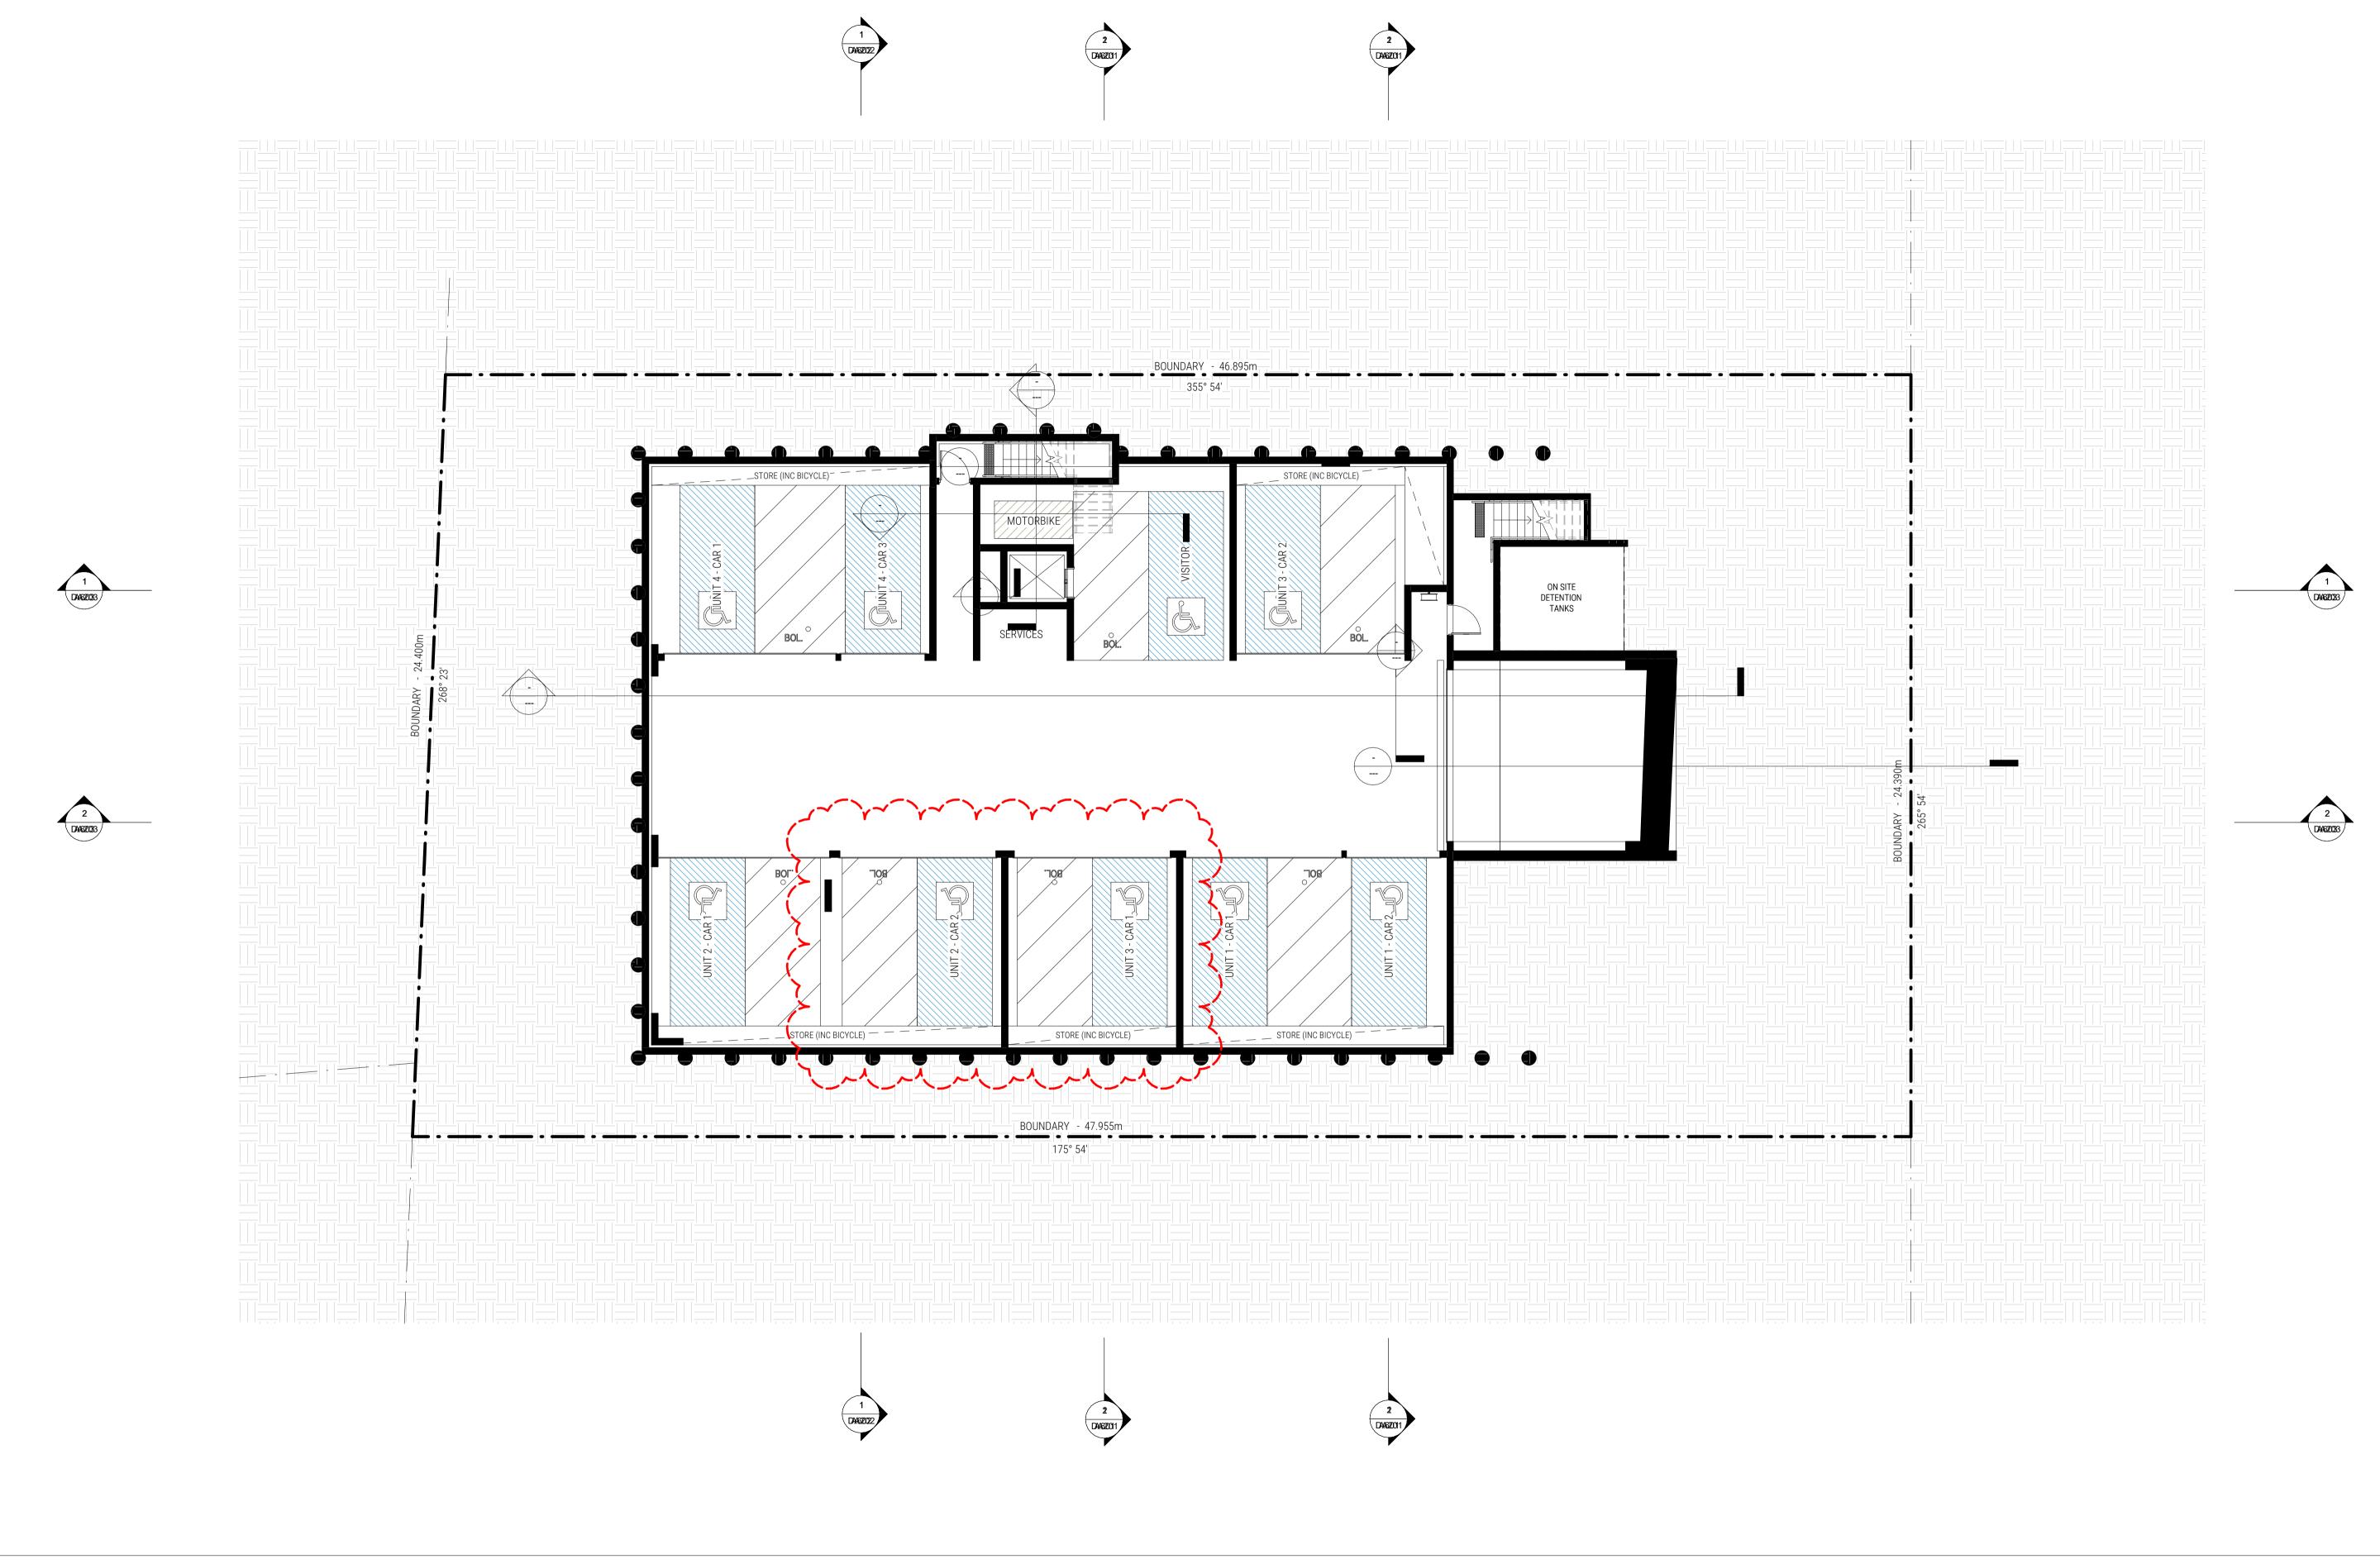





18 ALEXANDER ST COLLAROY NSW

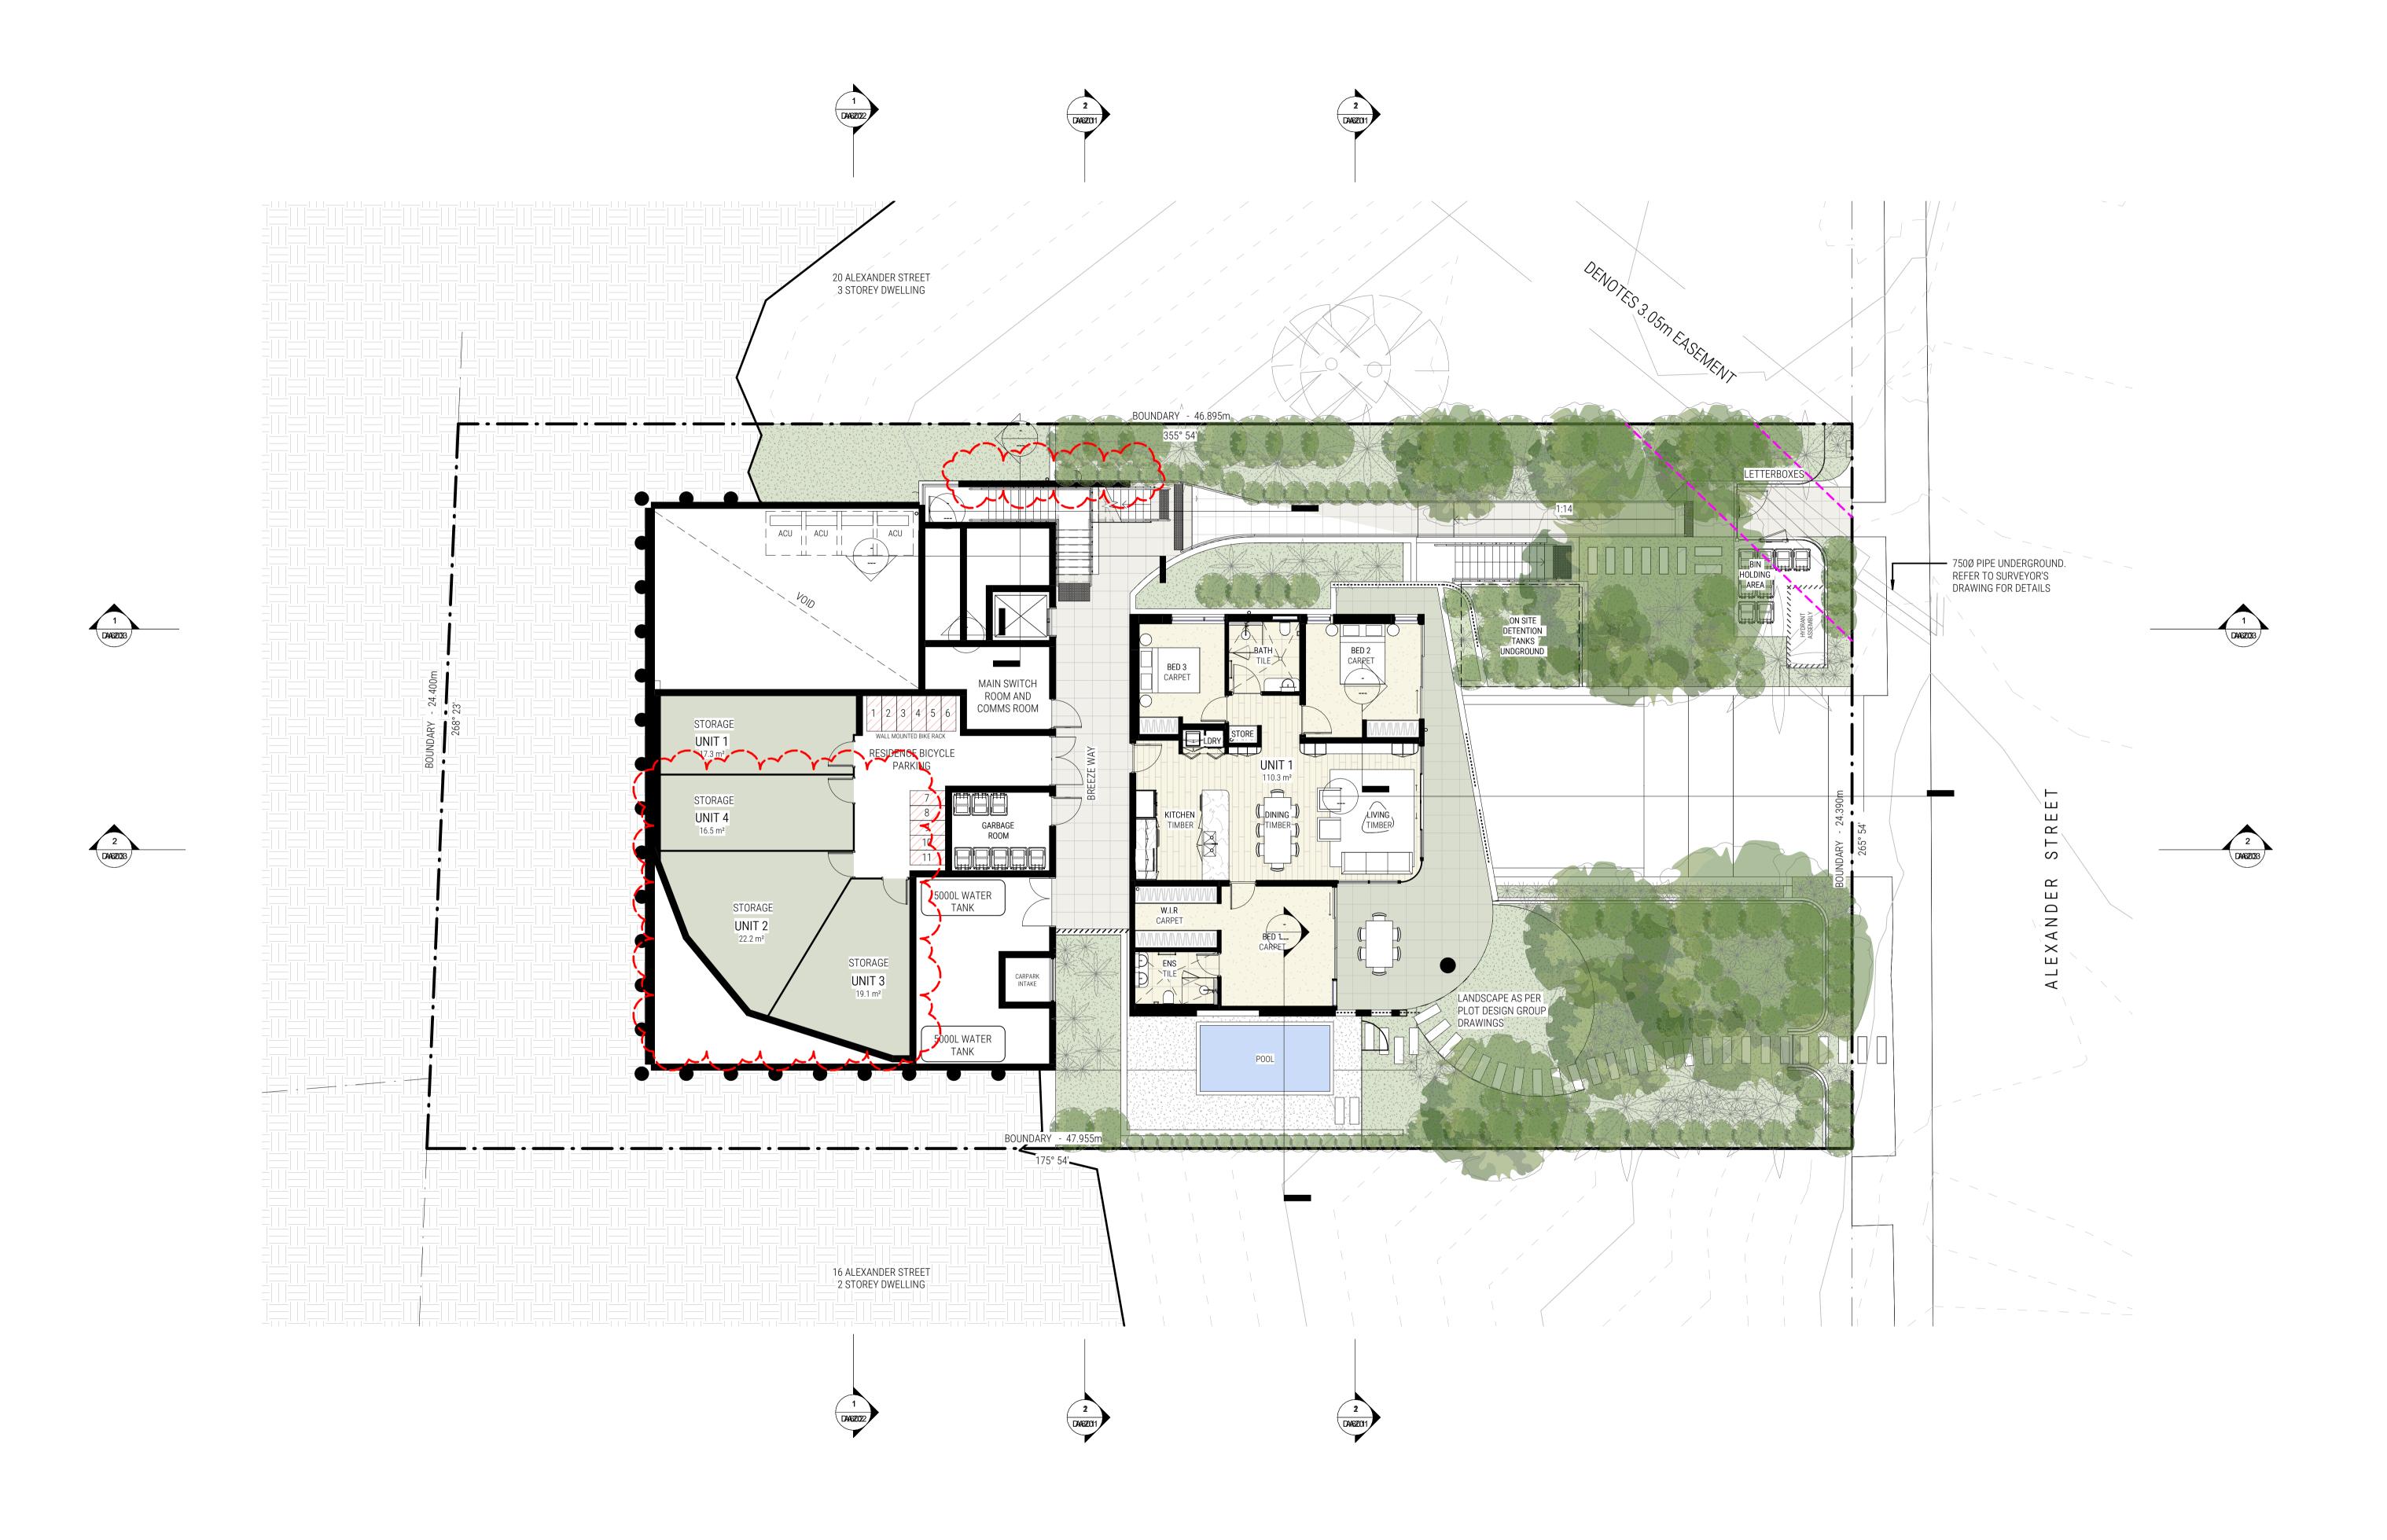




Building 3.3/1 Dairy Rd, Fyshwick ACT 2609

E: scott@walsharchitects.com.au P: 0466 049 880



4.55 MODIFICATION

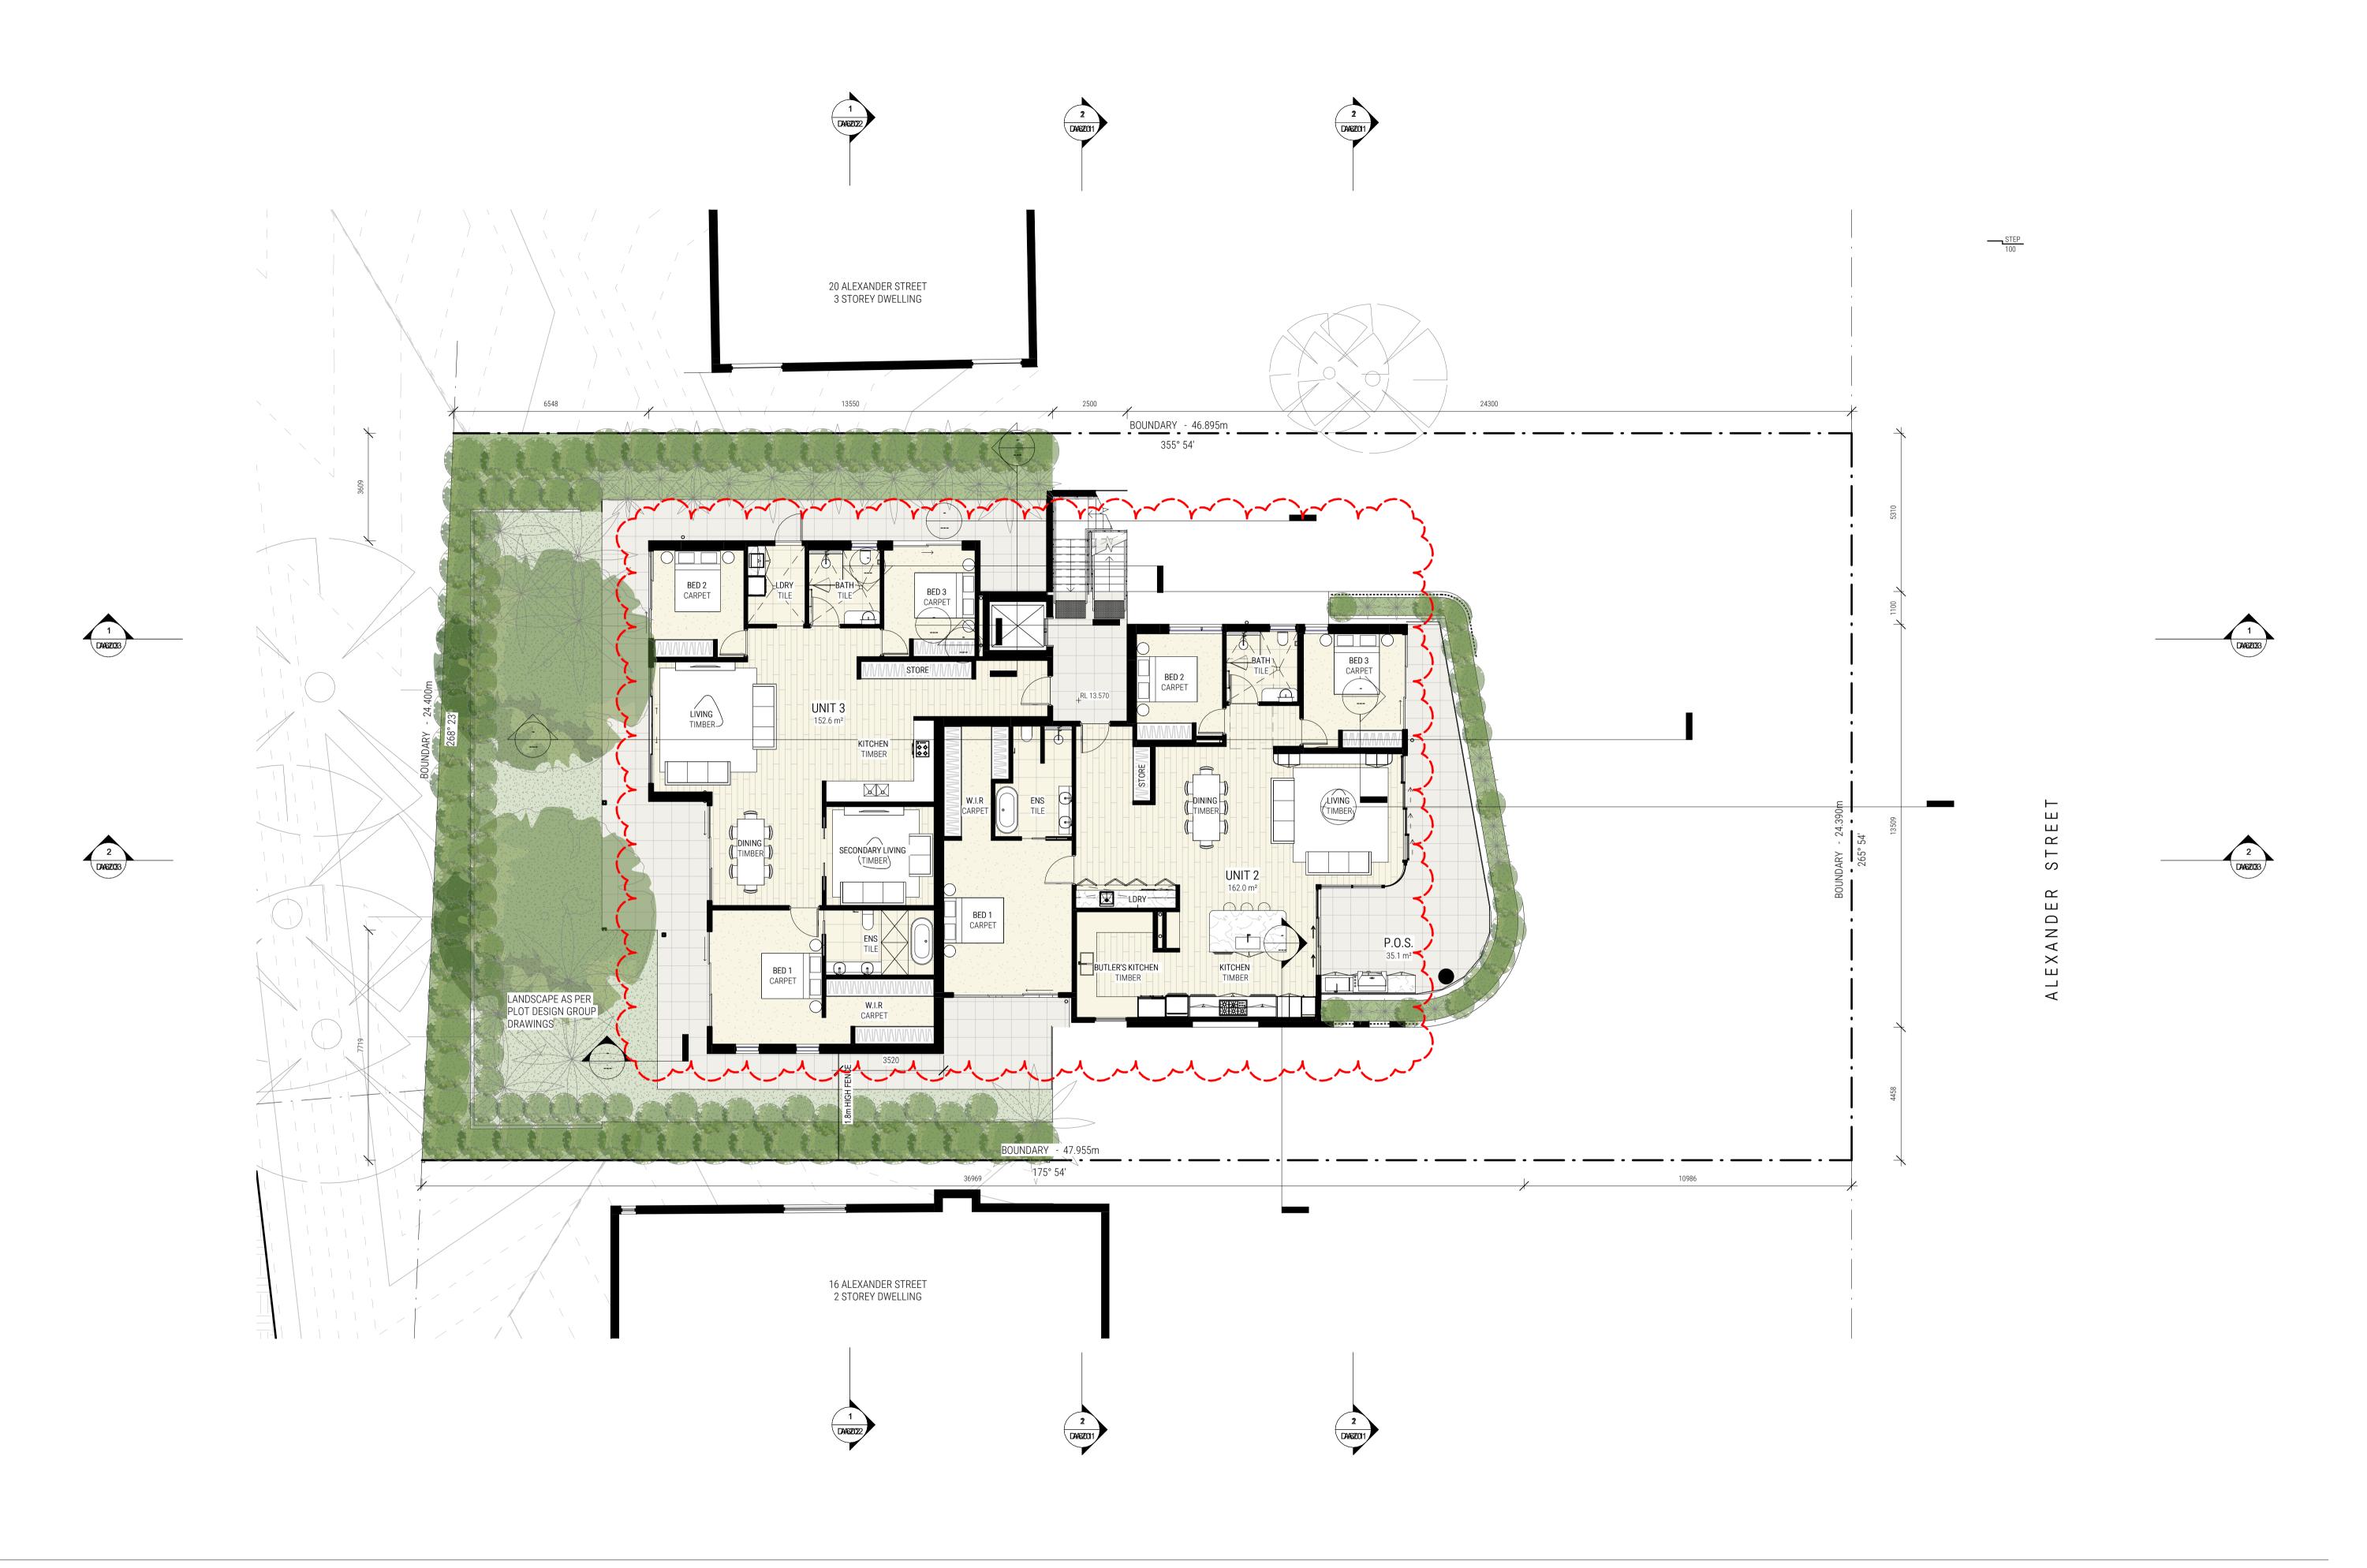




Building 3.3/1 Dairy Rd, Fyshwick ACT 2609


E: scott@walsharchitects.com.au P: 0466 049 880



4.55 MODIFICATION

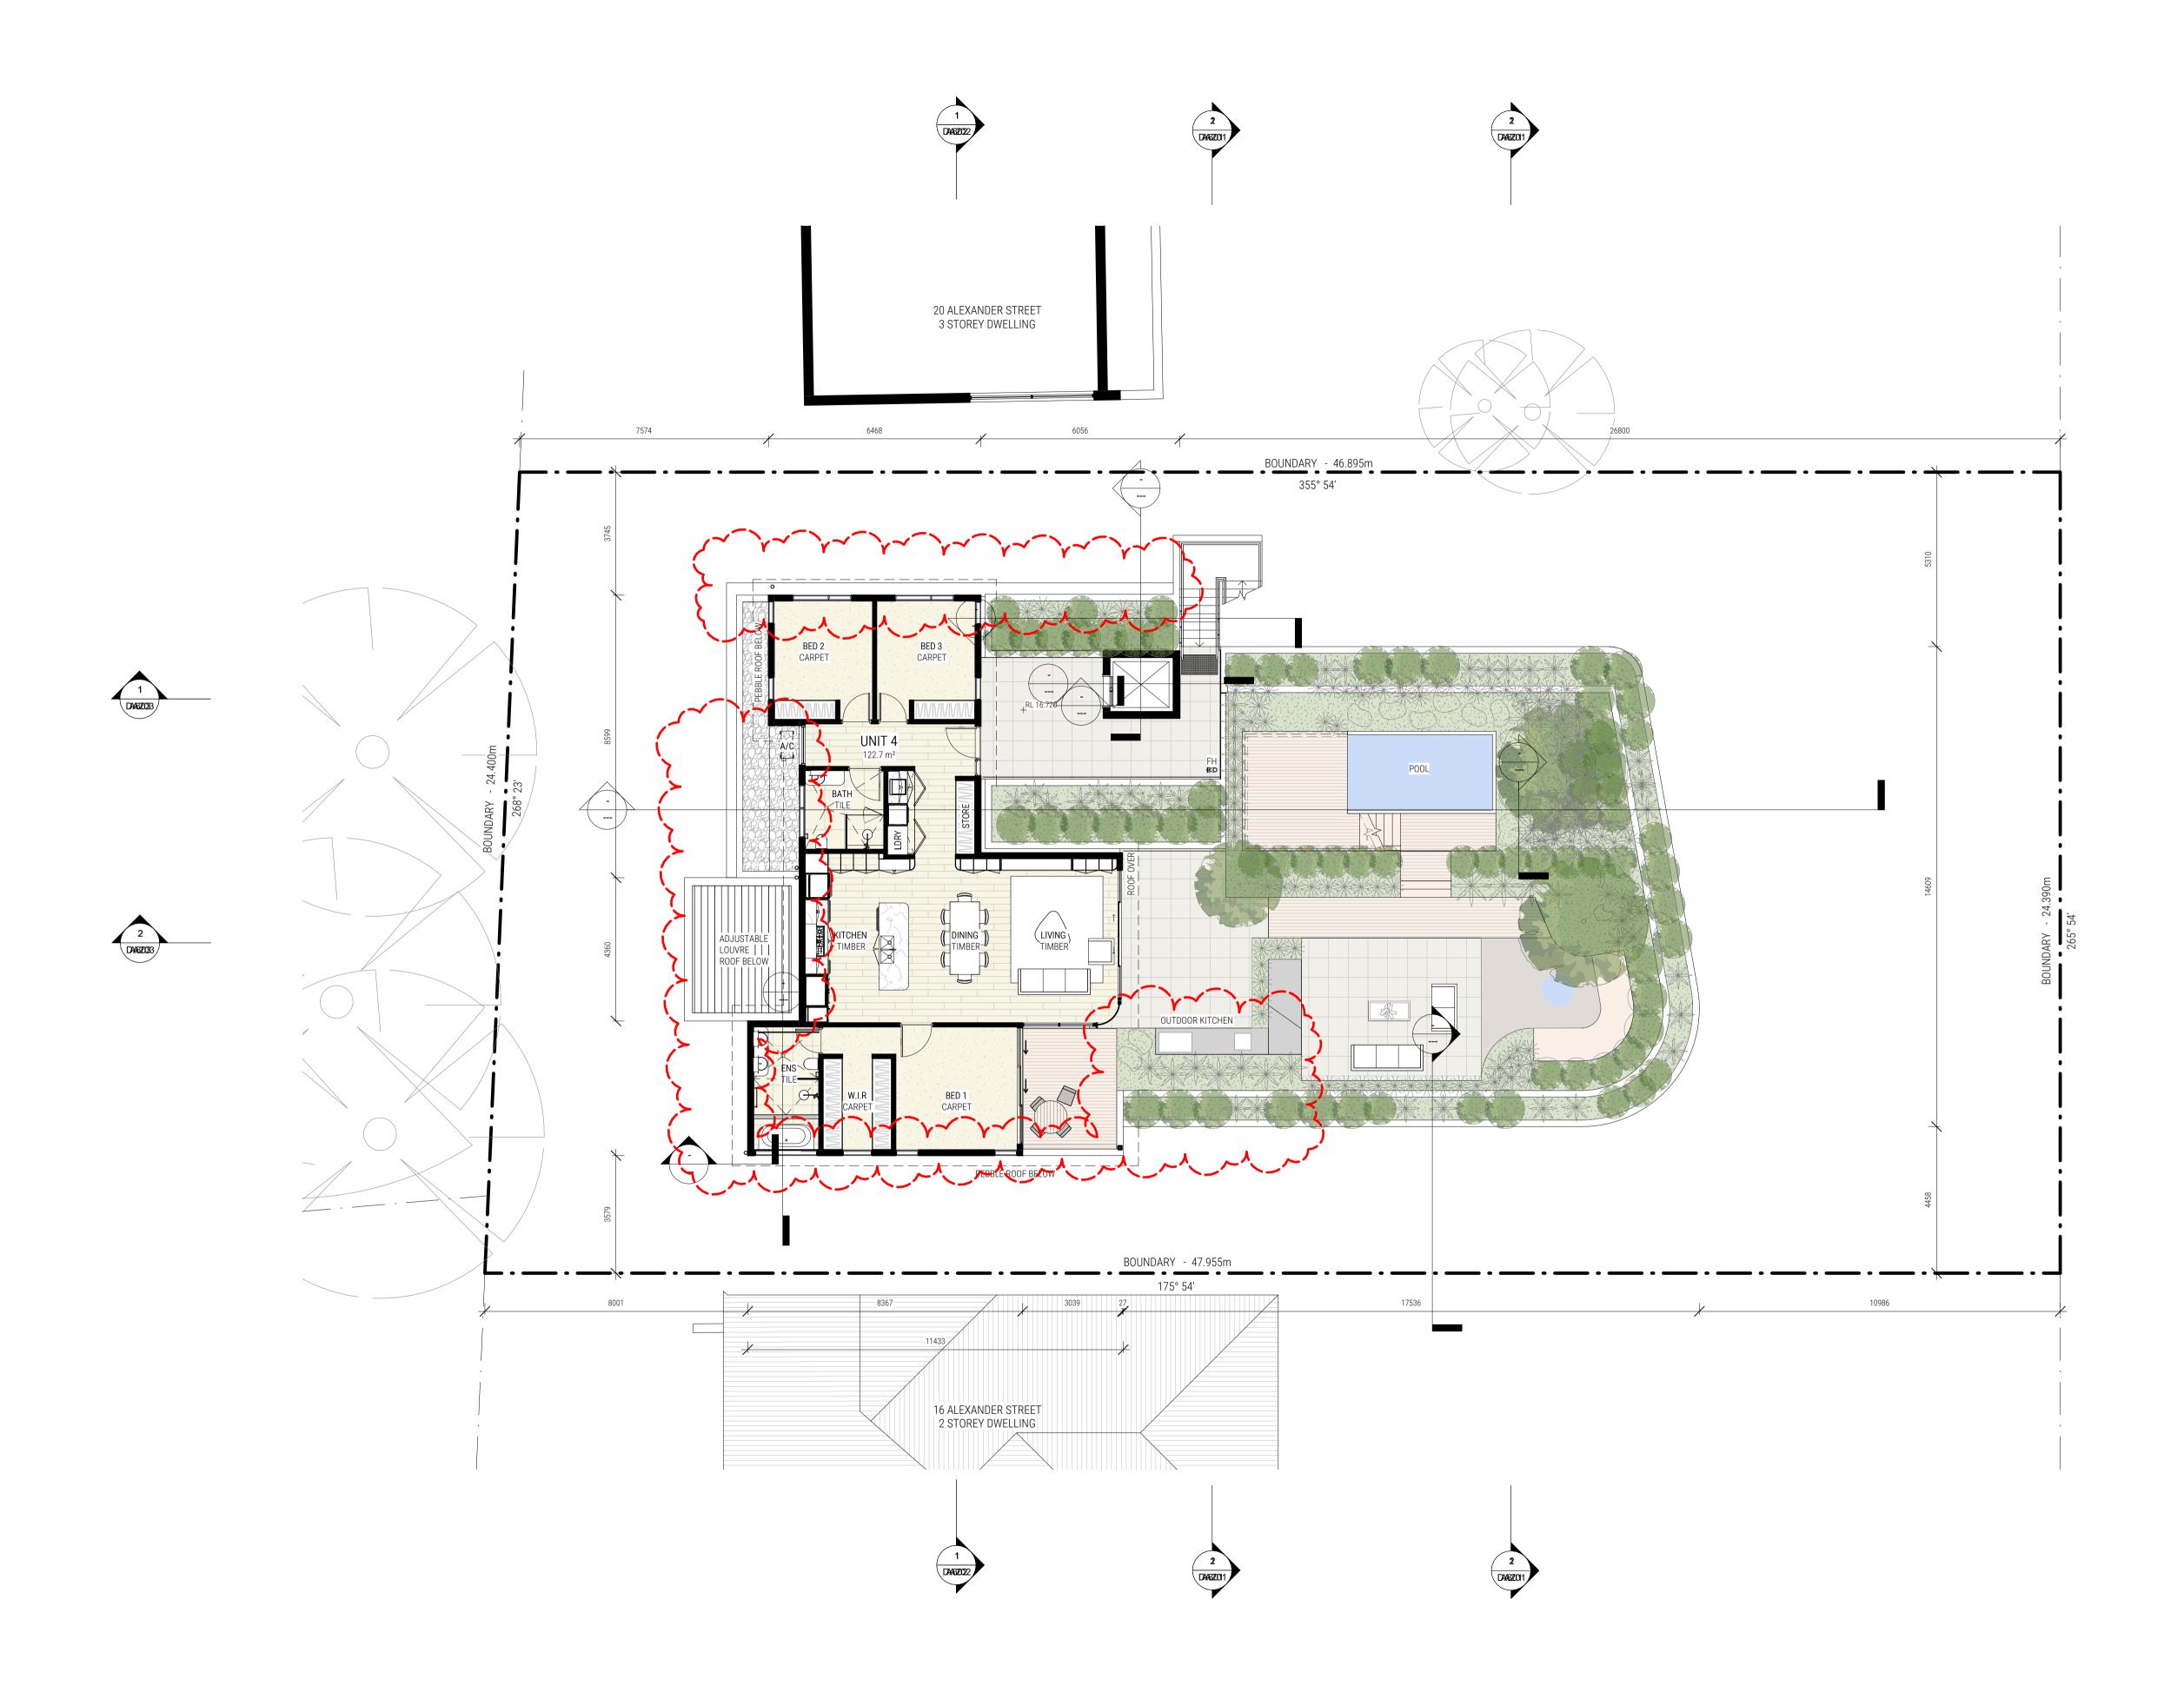



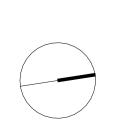



4.55 MODIFICATION

REV DATE 28.08.21 03.09.21

05.09.22


LEVEL 2 FLOOR PLAN
SHEET NUMBER DA113
REVISION B
SCALE @ A1 1:100
18 ALEXANDER ST COLLAROY NSW



Building 3.3/1 Dairy Rd,
Fyshwick ACT 2609


E: scott@walsharchitects.com.au
P: 0466 049 880

Nominated Architect: Scott Walsh
ACT 2624 | NSW 10366

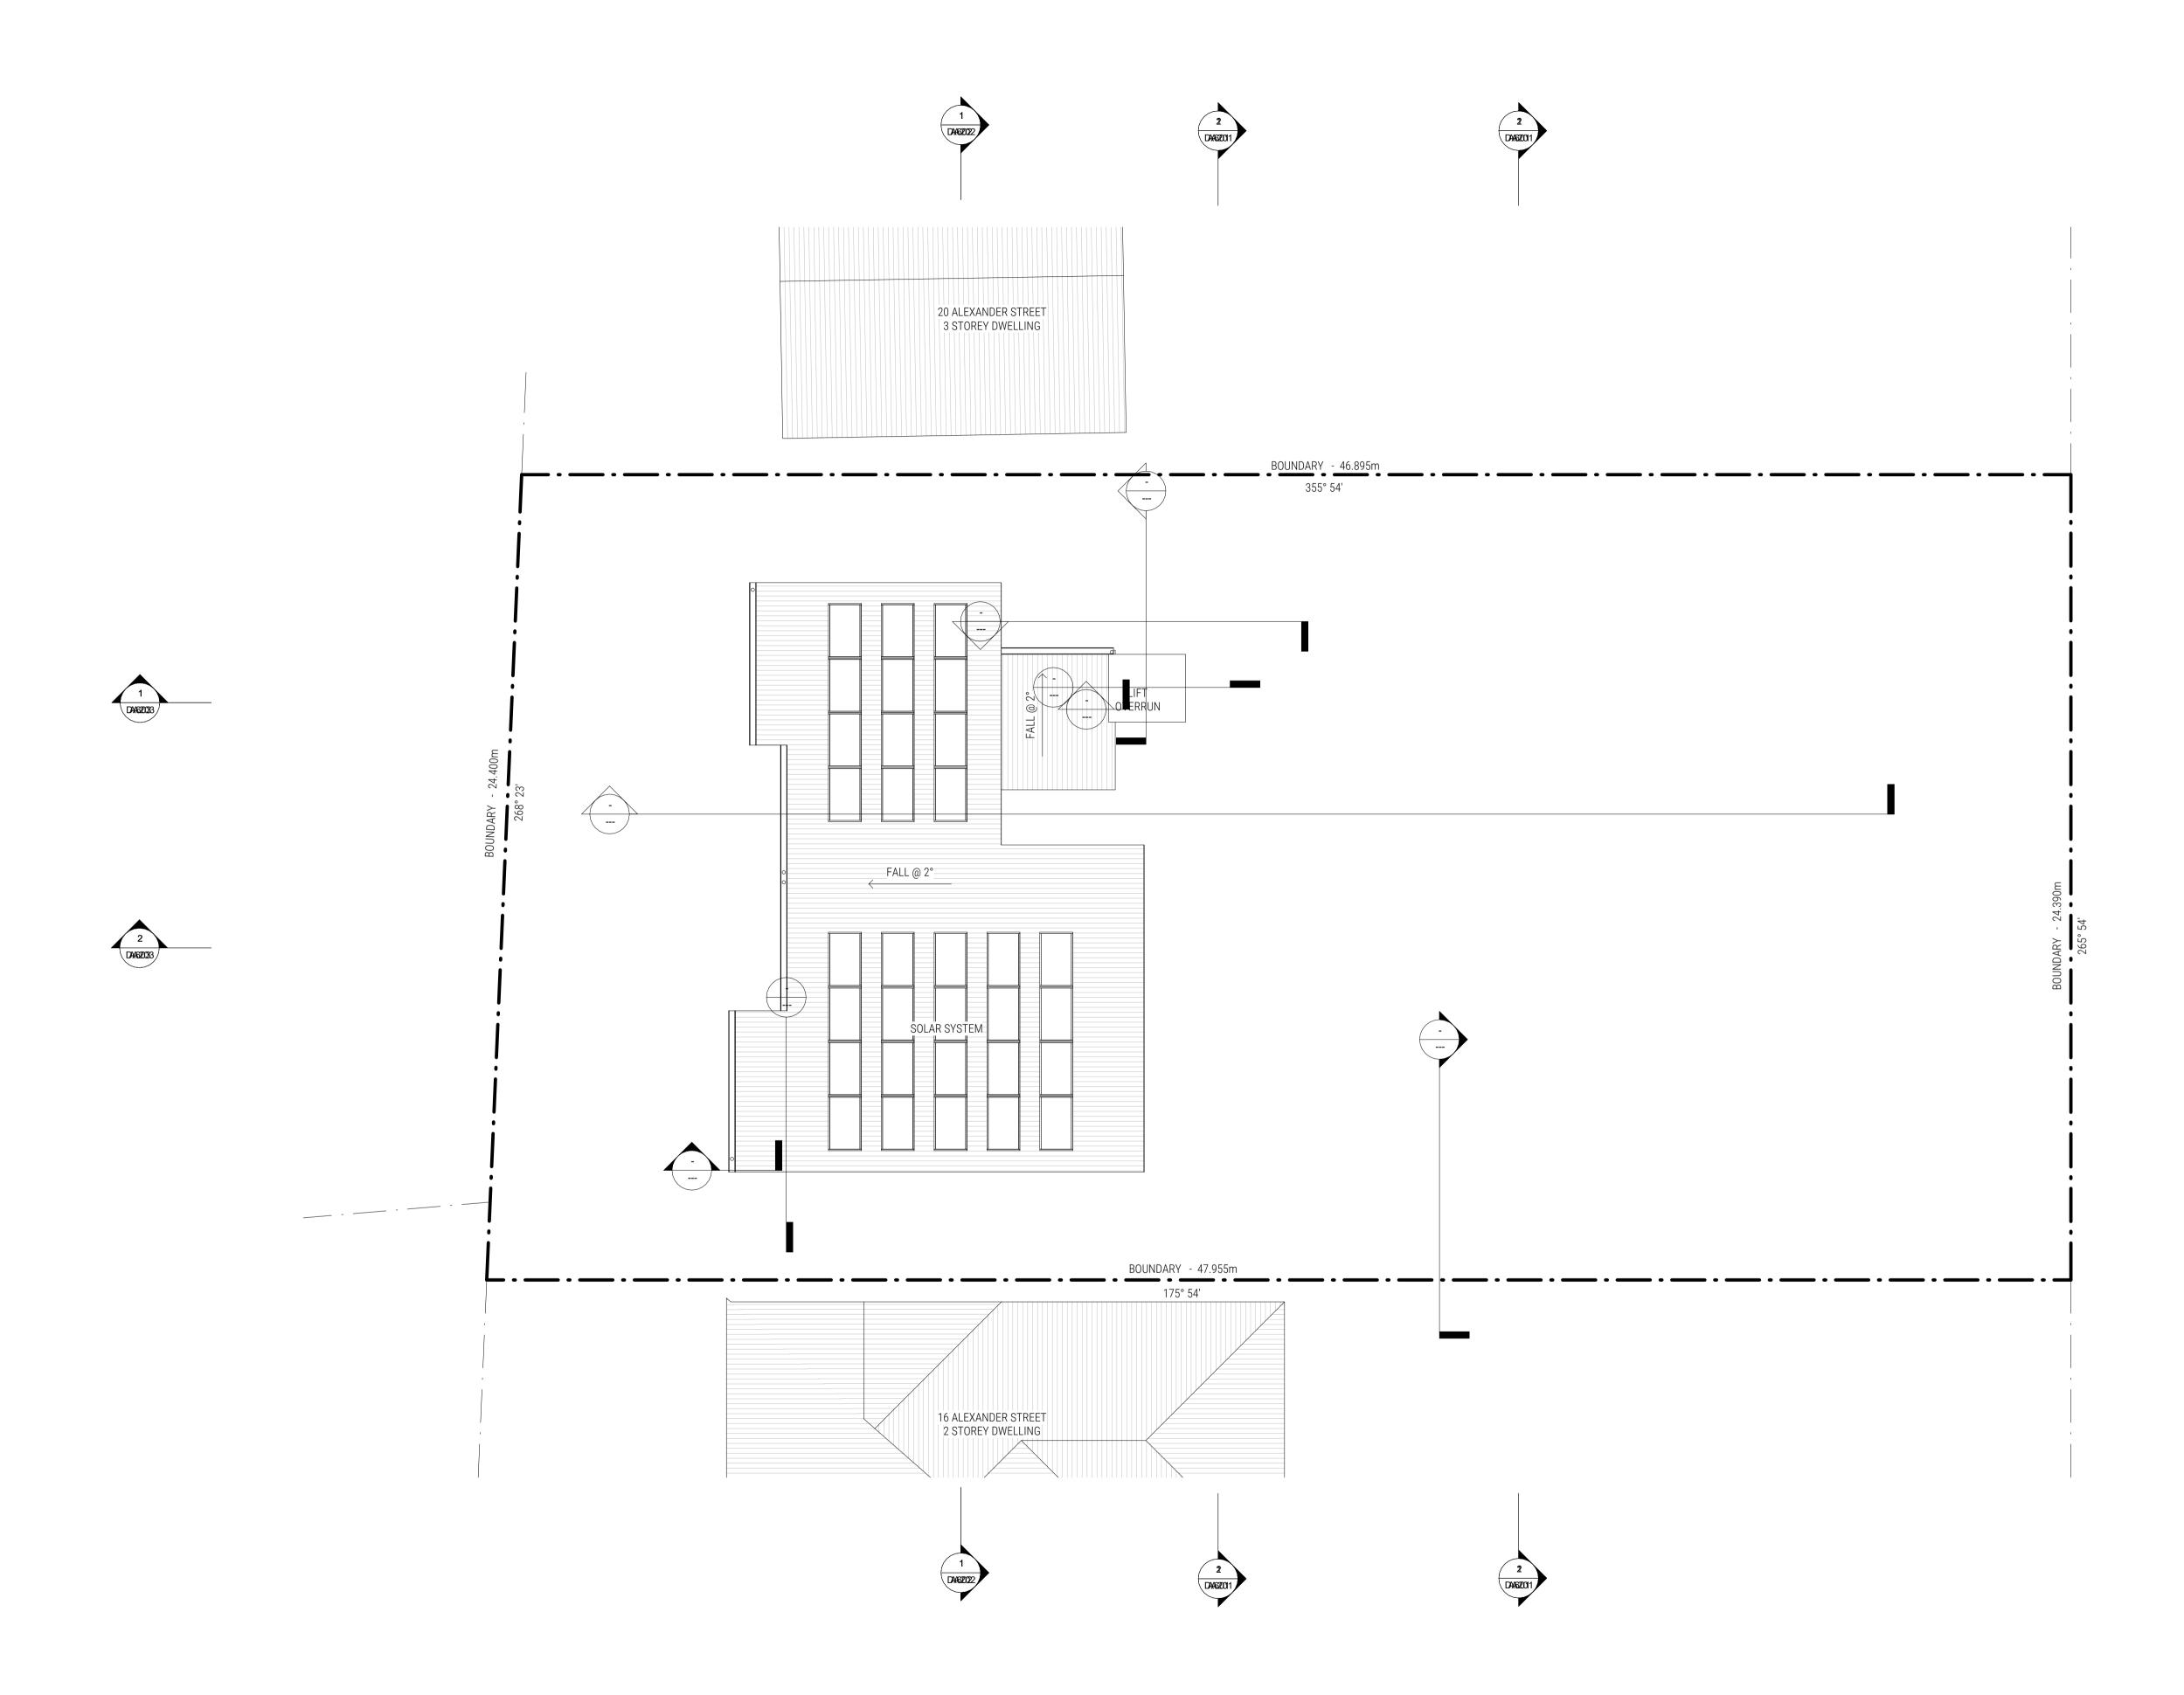





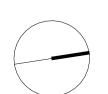




REV DATE 28.08.21 03.09.21


05.09.22

ROOF PLAN SHEET NUMBER DA114 REVISION SCALE @ A1 1:100

Building 3.3/1 Dairy Rd, Fyshwick ACT 2609


Г					
		Regulated Design F	Record		
Project A	Address: 18 AL	EXANDER ST COLLAROY NSW			
Project ⁻	Title: THE P	PALMS	Body Corpo	orate Reg No: NA	
Consent	t No: DA202	21/1766	Drawing No	DA201	
Drawing	Title: BUILD	ING SECTIONS - SHEET 1			
Rev	Date	Description		DP Full Name	Reg No
Α	24.05.2022	FOR CONSTRUCTION		SCOTT WALSH	DEP0001107

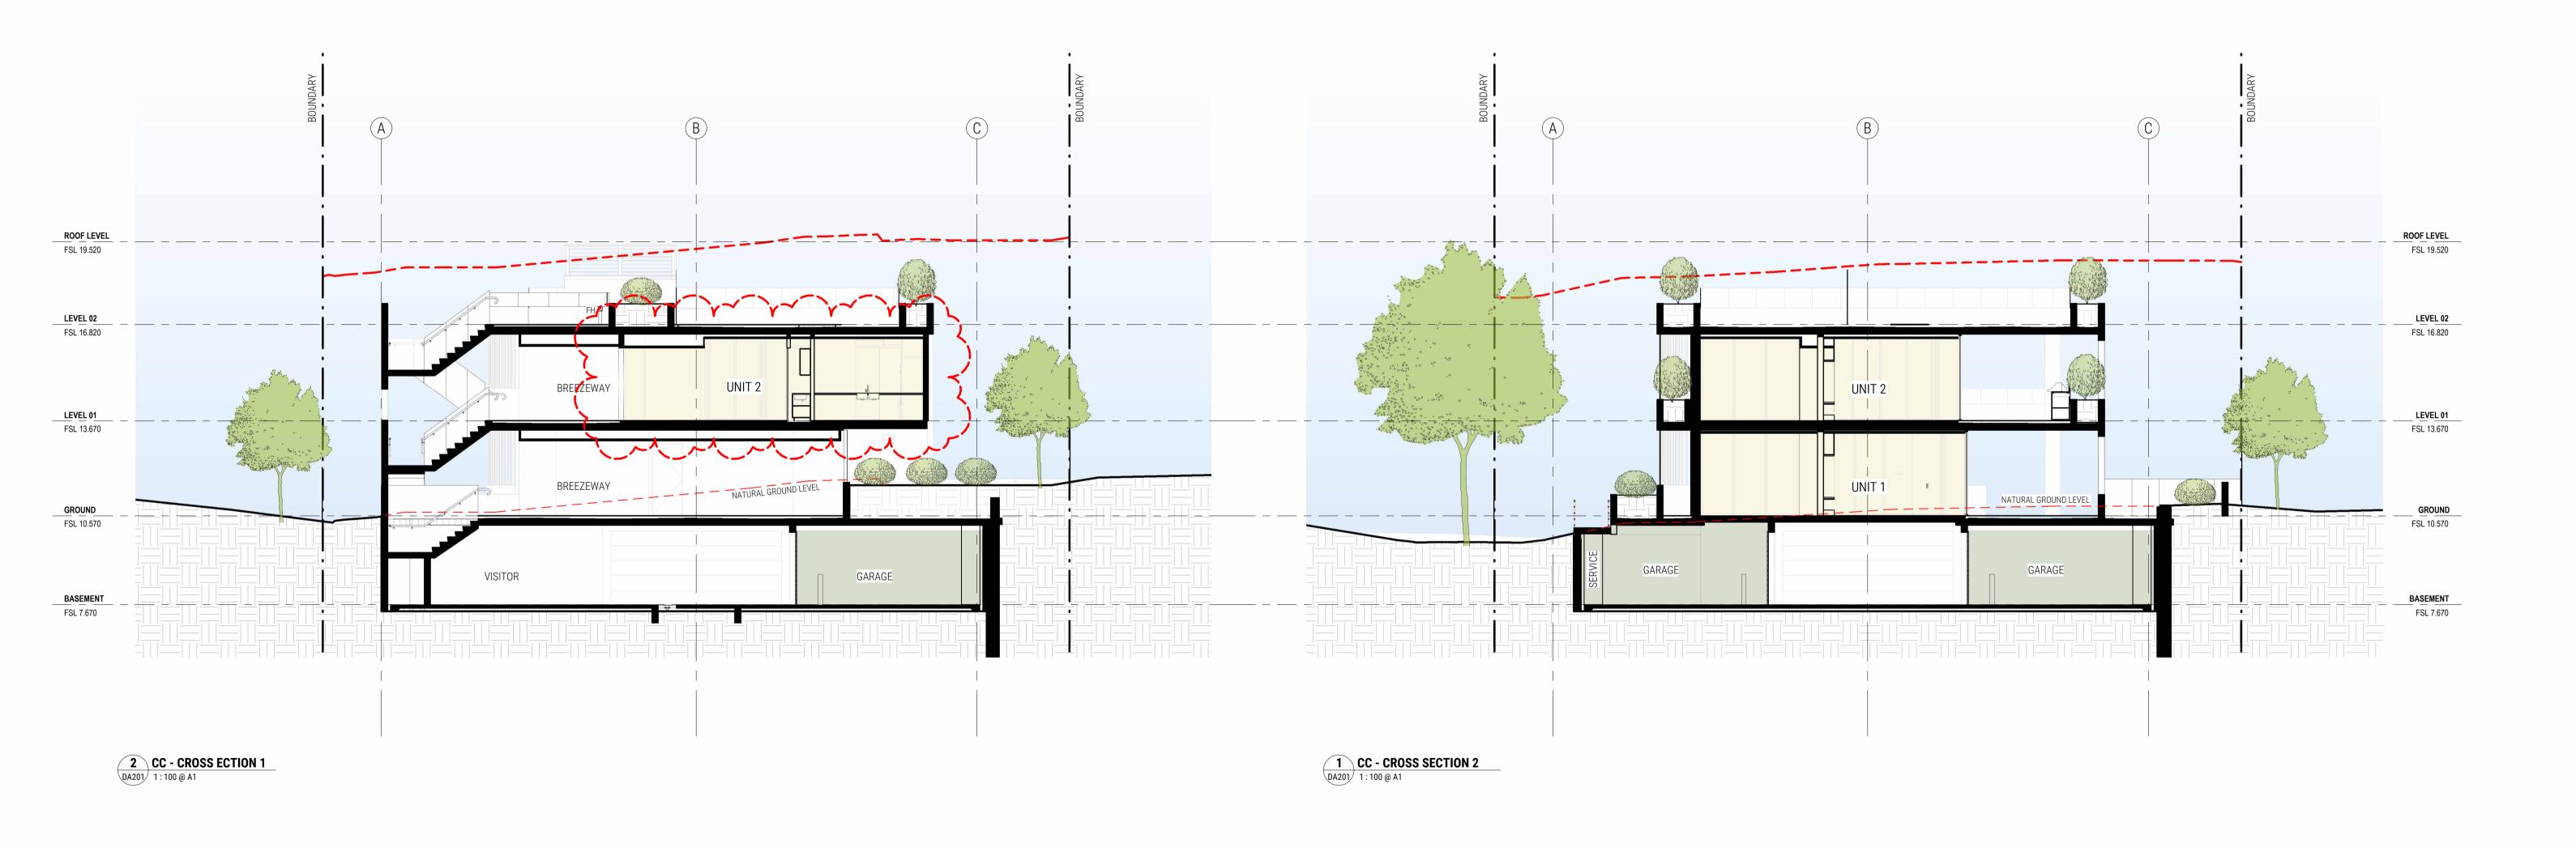

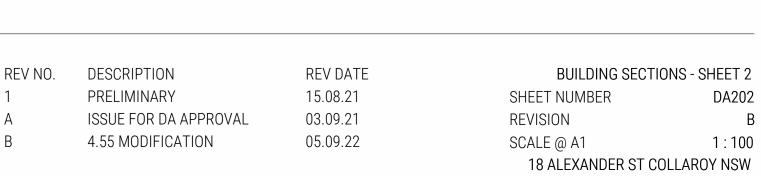

DA202

1:100

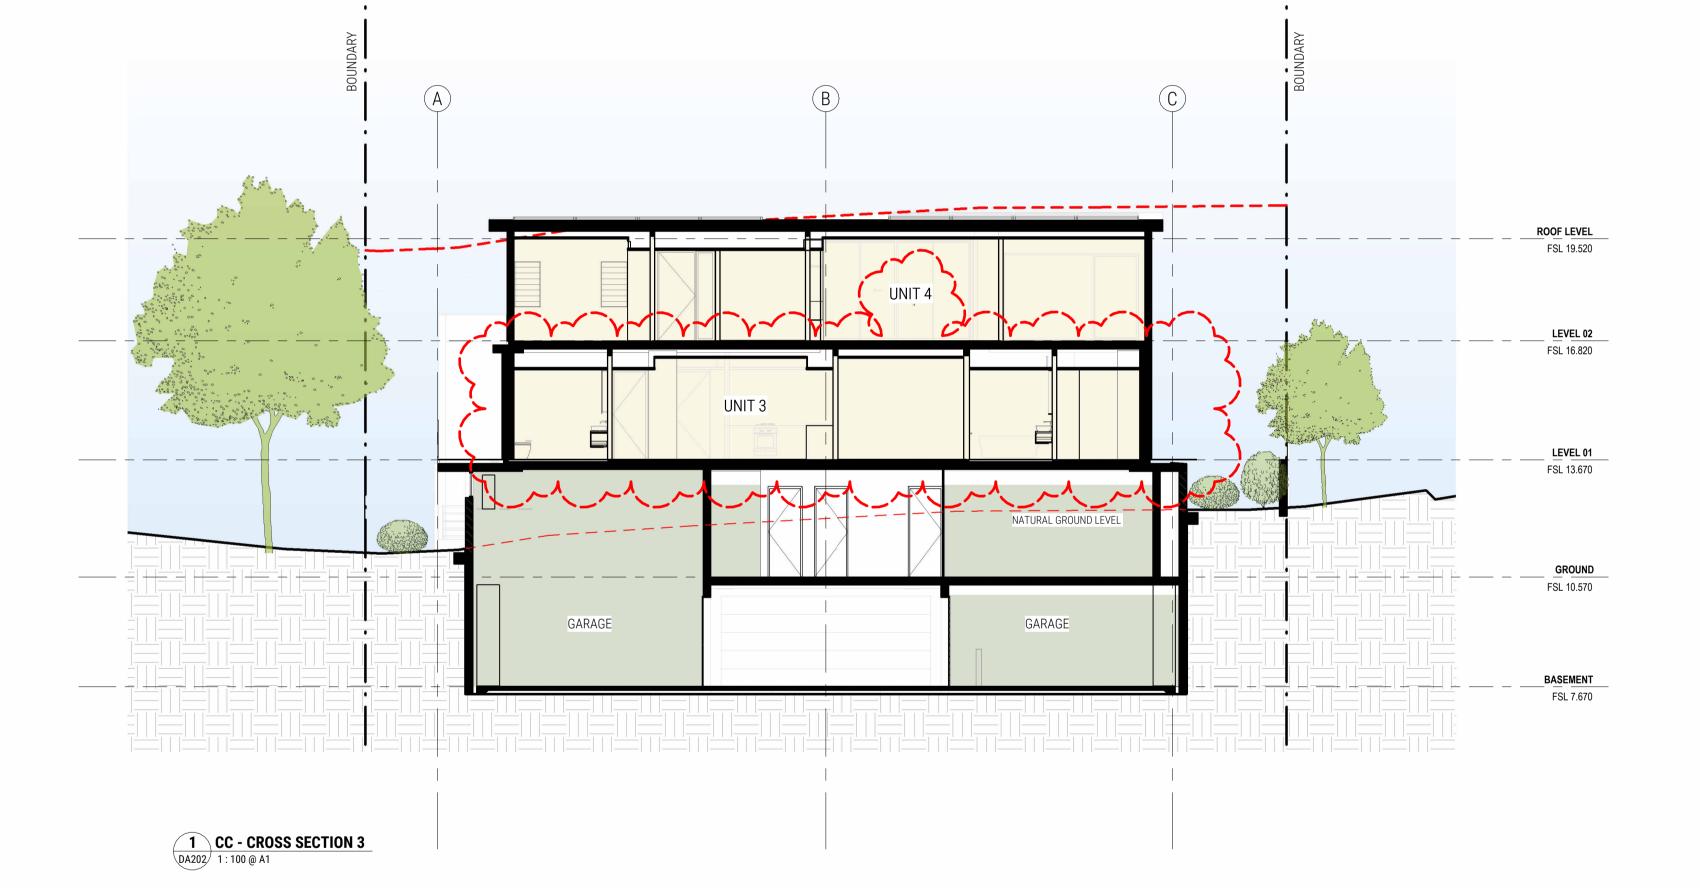







2 CC - LONG SECTION - DRIVEWAY
1:100 @ A1



Building 3.3/1 Dairy Rd,
Fyshwick ACT 2609

E: scott@walsharchitects.com.au
P: 0466 049 880

Nominated Architect : Scott Walsh
ACT 2624 | NSW 10366

REV NO. DESCRIPTION REV DATE
1 PRELIMINARY 15.08.21
A ISSUE FOR DA APPROVAL 03.09.21
B 4.55 MODIFICATION 05.09.22

BUILDING SECTIONS - SHEET 3

SHEET NUMBER DA203

REVISION B

SCALE @ A1 1:100


18 ALEXANDER ST COLLAROY NSW





PROPOSED NORTH ELEVATION
1:100 @ A1

PROPOSED SOUTH ELEVATION
1:100 @ A1

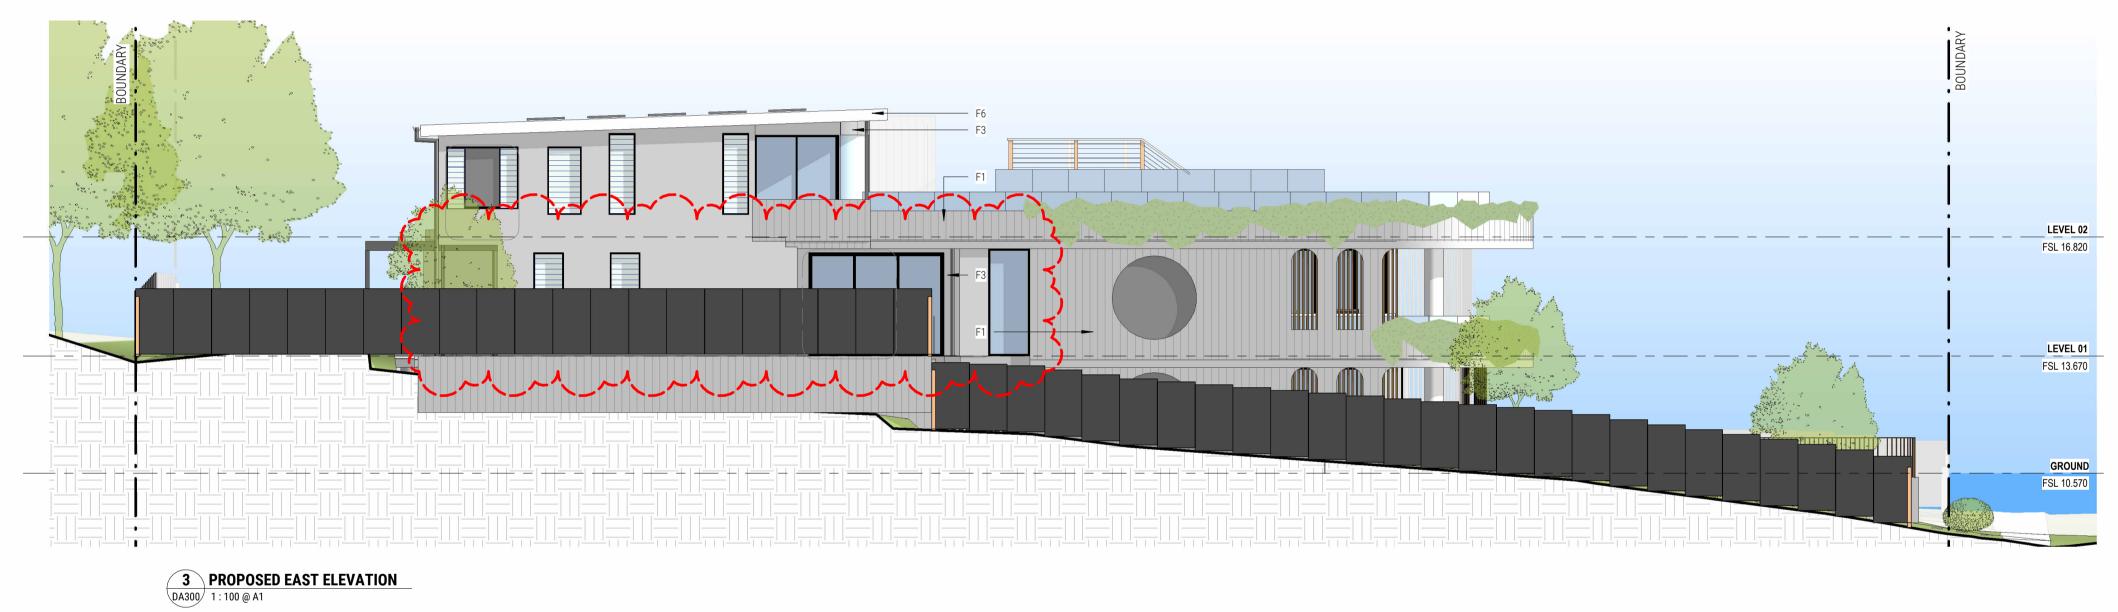



EXTERNAL FINISHES SCHEDULE

<u>CODES</u>	<u>EXTERIOR</u>
F1	- BOARD-FORMED INSITU CONCRETE
F2	- POWDER COATED ALUMINIUM BATTENS
F3	- WHITE - PAINTED EASYLAP FC
F4	- SANDSTONE - EXTERIOR BASEMENT WALL
	RETAINING WALLS

RETAINING WALLS - ALUMINIUM WINDOW FRAME - NIGHT SKY - LYSAGHT METAL ROOF - SURFMIST


Building 3.3/1 Dairy Rd, Fyshwick ACT 2609 E: scott@walsharchitects.com.au P: 0466 049 880

WALSH ARCHITECTS

Nominated Architect : Scott Walsh ACT 2624 | NSW 10366

REV NO.	DESCRIPTION	REV DATE
2	FOR CONSULTANT CO-ORDINATION	28.08.21
Α	ISSUE FOR DA APPROVAL	03.09.21
В	4.55 MODIFICATION	05.09.22




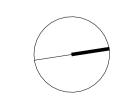



NO. DESCRIPTION REV DATE
FOR CONSULTANT 28.08.21
CO-ORDINATION
ISSUE FOR DA APPROVAL 03.09.21
4.55 MODIFICATION 05.09.22

AREA CALCULATIONS - GFA
SHEET NUMBER DA400
REVISION B
SCALE @ A1 1 : 200
18 ALEXANDER ST COLLAROY NSW

3 GFA - LEVEL 02 1 : 200 @ A1

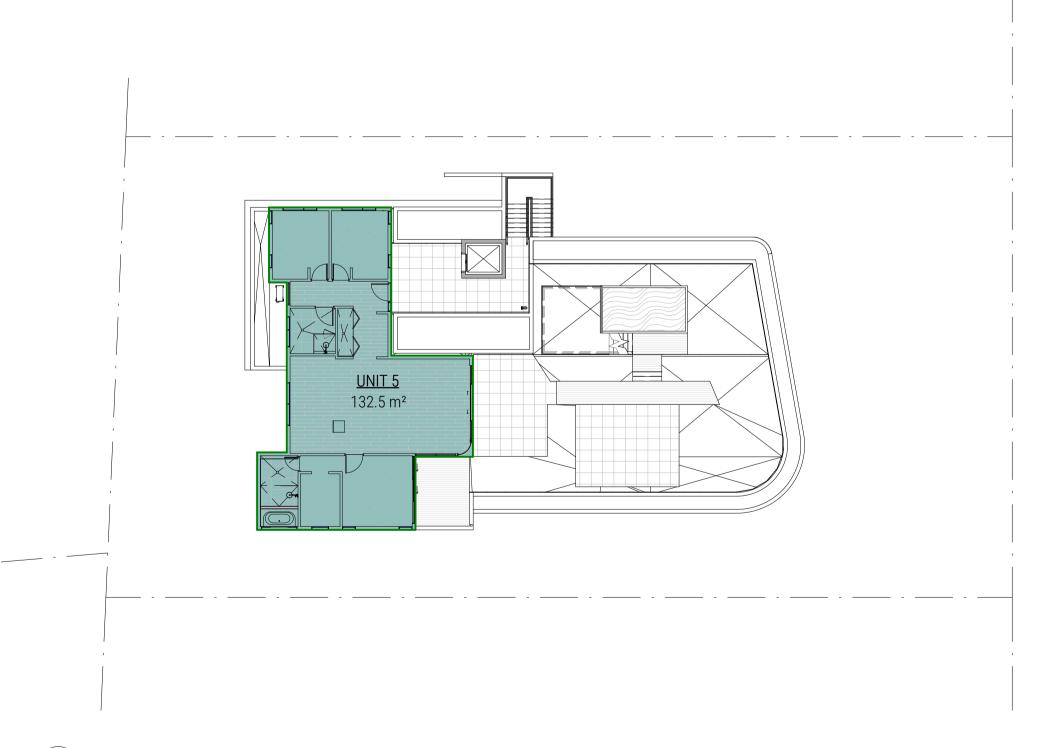

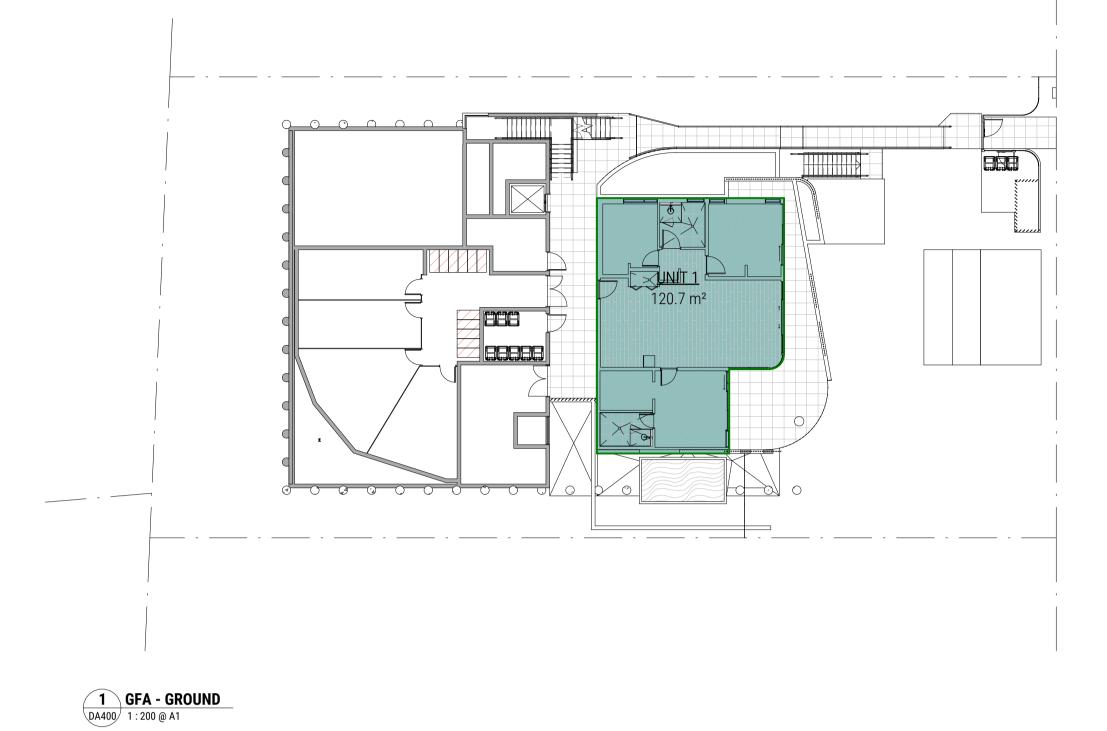

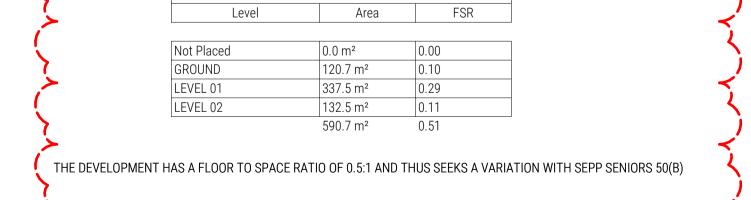

(B) DENSITY AND SCALE: IF THE DENSITY AND SCALE OF THE BUILDINGS WHEN EXPRESSED AS A FLOOR SPACE RATIO IS 0.5:1 OR LESS,


A CONSENT AUTHORITY MUST NOT REFUSE CONSENT TO A DEVELOPMENT APPLICATION MADE PURSUANT TO THIS CHAPTER FOR THE CARRYING OUT OF DEVELOPMENT FOR THE PURPOSE OF A SELF-CONTAINED DWELLING (INCLUDING IN-FILL SELF-CARE HOUSING AND SERVICED SELF-CARE HOUSING) ON ANY OF THE FOLLOWING GROUNDS—

AREA SCHEDULE - GFA

SEPP SENIORS 2004
50 STANDARDS THAT CANNOT BE USED TO REFUSE DEVELOPMENT CONSENT FOR SELF-CONTAINED DWELLINGS





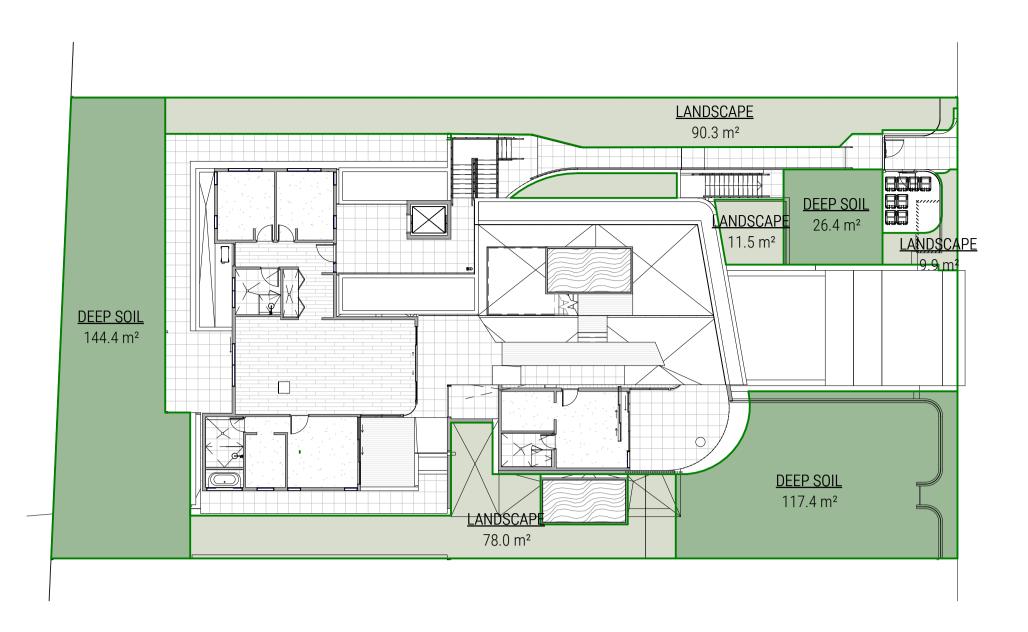

50 STANDARDS THAT CANNOT BE USED TO REFUSE DEVELOPMENT CONSENT FOR SELF-CONTAINED DWELLINGS
A CONSENT AUTHORITY MUST NOT REFUSE CONSENT TO A DEVELOPMENT APPLICATION MADE PURSUANT TO THIS CHAPTER FOR THE CARRYING OUT OF
DEVELOPMENT FOR THE PURPOSE OF A SELF-CONTAINED DWELLING (INCLUDING IN-FILL SELF-CARE HOUSING AND SERVICED SELF-CARE HOUSING) ON ANY
OF THE FOLLOWING GROUNDS—

(C) LANDSCAPED AREA: IF-

(II) IN ANY OTHER CASE—A MINIMUM OF 30% OF THE AREA OF THE SITE IS TO BE LANDSCAPED,

(D) DEEP SOIL ZONES: IF, IN RELATION TO THAT PART OF THE SITE (BEING THE SITE, NOT ONLY OF THAT PARTICULAR DEVELOPMENT, BUT ALSO OF ANY OTHER ASSOCIATED DEVELOPMENT TO WHICH THIS POLICY APPLIES) THAT IS NOT BUILT ON, PAVED OR OTHERWISE SEALED, THERE IS SOIL OF A SUFFICIENT DEPTH TO SUPPORT THE GROWTH OF TREES AND SHRUBS ON AN AREA OF NOT LESS THAN 15% OF THE AREA OF THE SITE (THE DEEP SOIL ZONE). TWO-THIRDS OF THE DEEP SOIL ZONE SHOULD PREFERABLY BE LOCATED AT THE REAR OF THE SITE AND EACH AREA FORMING PART OF THE ZONE SHOULD HAVE A MINIMUM DIMENSION OF 3 METRES,


LANDSCAPE AREA DEFINITION UNDER THE SEPP

LANDSCAPED AREA MEANS A PART OF A SITE USED FOR GROWING PLANTS, GRASSES AND TREES, BUT DOES NOT INCLUDE ANY BUILDING, STRUCTURE OR HARD PAVED AREA'.

	LANDSCAPED AR	EA		
Name	LANDSCAPE AREA	PERCENTAGE OF SITE AREA		
DEEP SOIL	288.2 m²	24.9%		
LANDSCAPE	199.8 m²	17.3%		
	488.0 m ²	42.2%		

THE DEVELOPMENT HAS A LANDSCAPE AREA >30% ANDD THUS COMPLIES WITH SEPP SENIORS 50(C)

THE DEVELOPMENT HAS A DEEP SOIL ZONE >15% ANDD THUS COMPLIES WITH SEPP SENIORS 50(D)

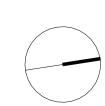





PROPOSED SHADOW DIAGRAM - 9AM JUNE 21ST
1:200 @ A1

4.55 MODIFICATION





PROPOSED SHADOW DIAGRAM - 12PM JUNE 21ST
1:200 @ A1

4.55 MODIFICATION

28.08.21


03.09.21

05.09.22


18 ALEXANDER ST COLLAROY NSW





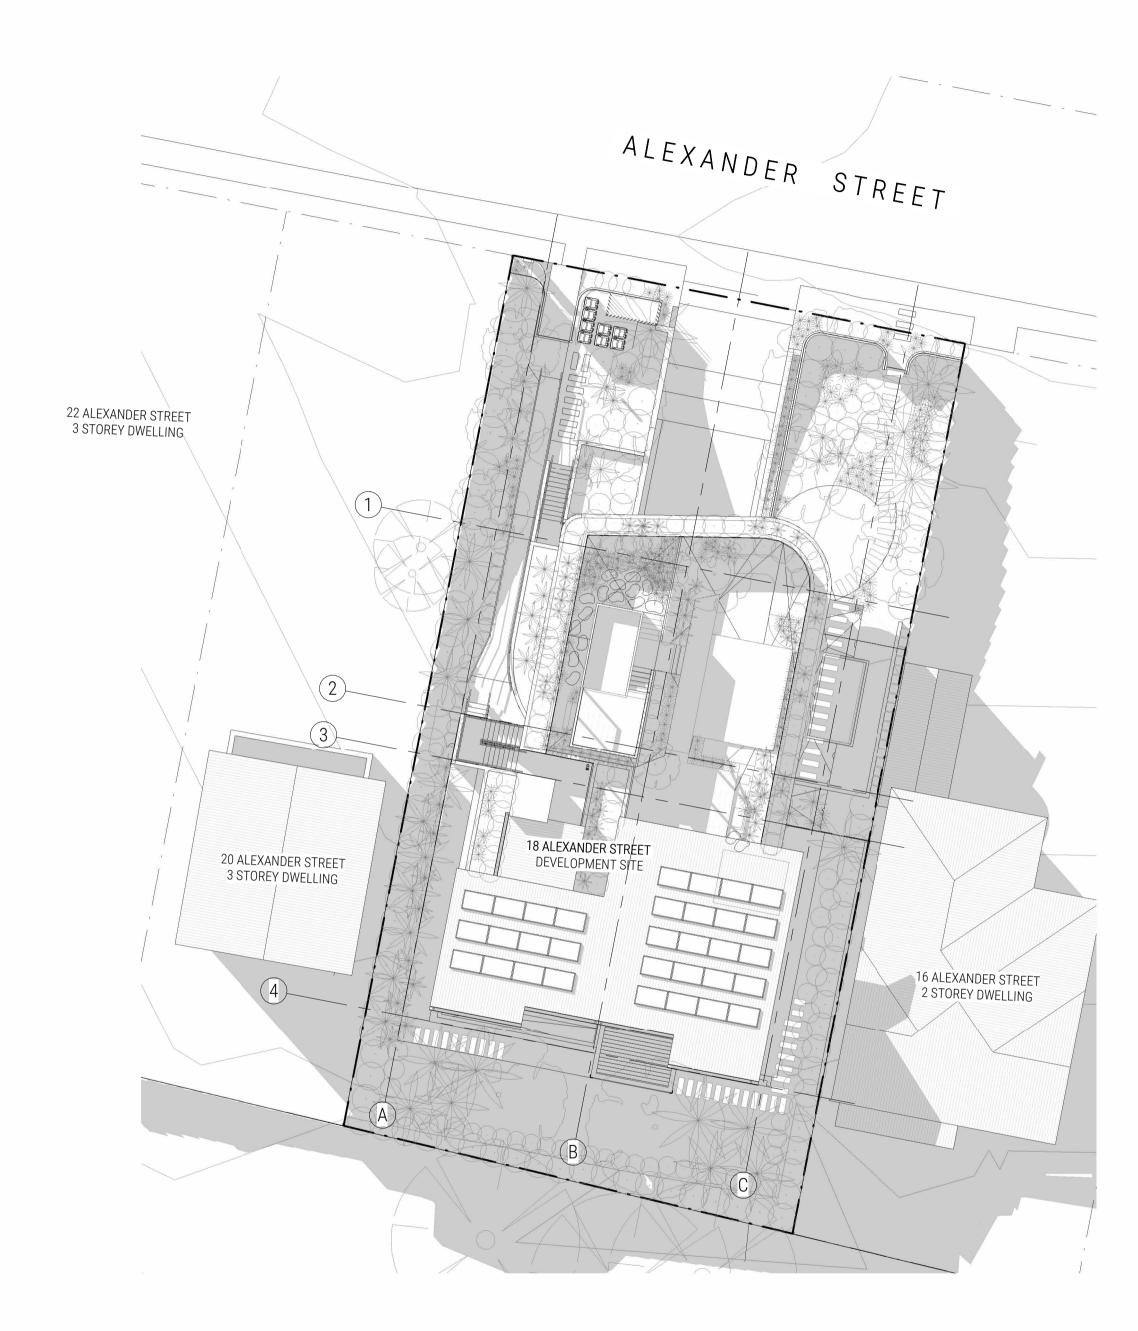



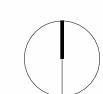

4.55 MODIFICATION



FOR CONSULTANT CO-ORDINATION ISSUE FOR DA APPROVAL 4.55 MODIFICATION

REV NO. DESCRIPTION


28.08.21 03.09.21 05.09.22


REV DATE


VIEWS FROM THE SUN - 9, 10 & 11AM SHEET NUMBER REVISION SCALE @ A1 18 ALEXANDER ST COLLAROY NSW







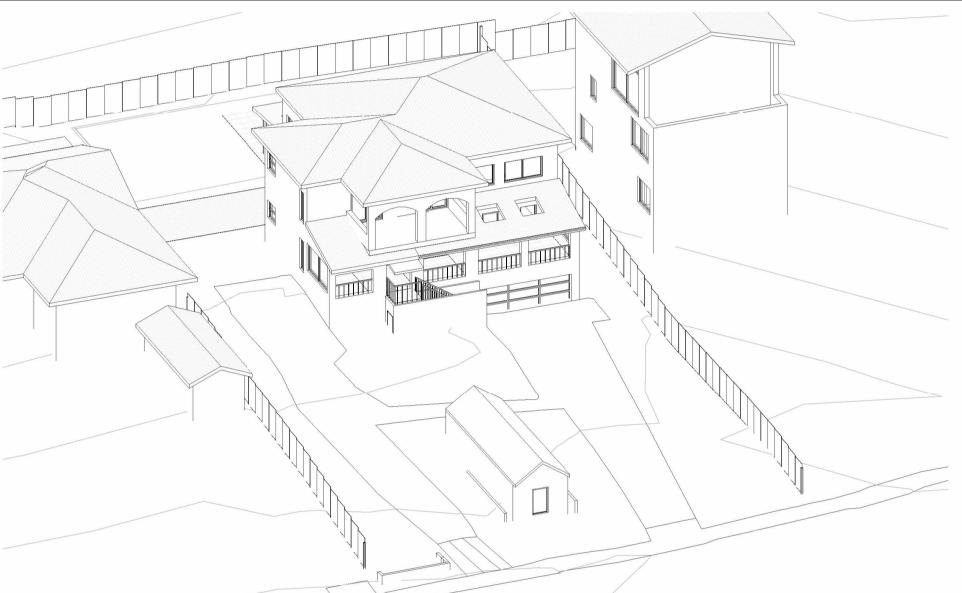


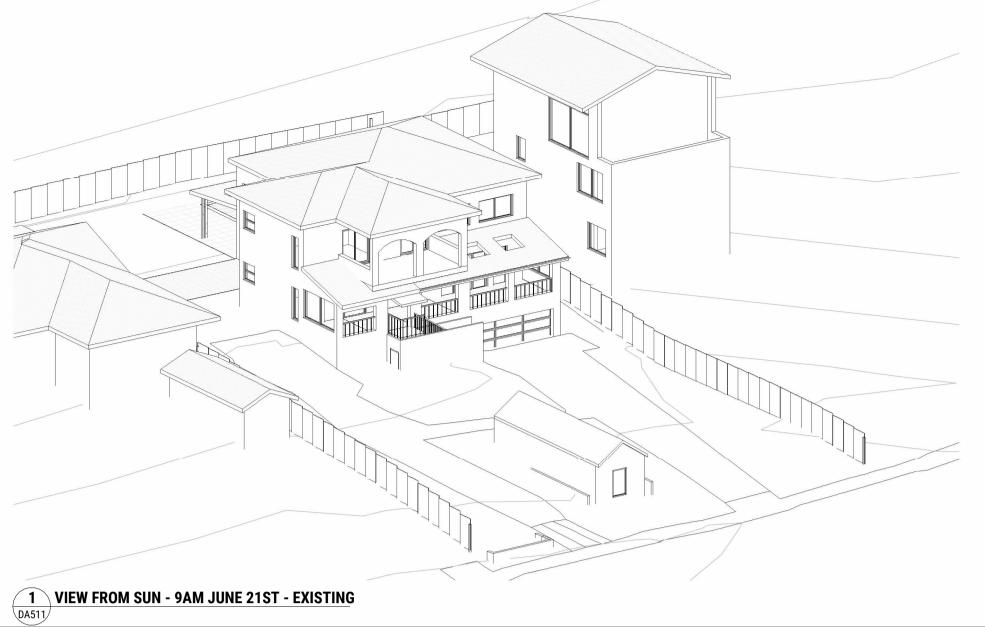

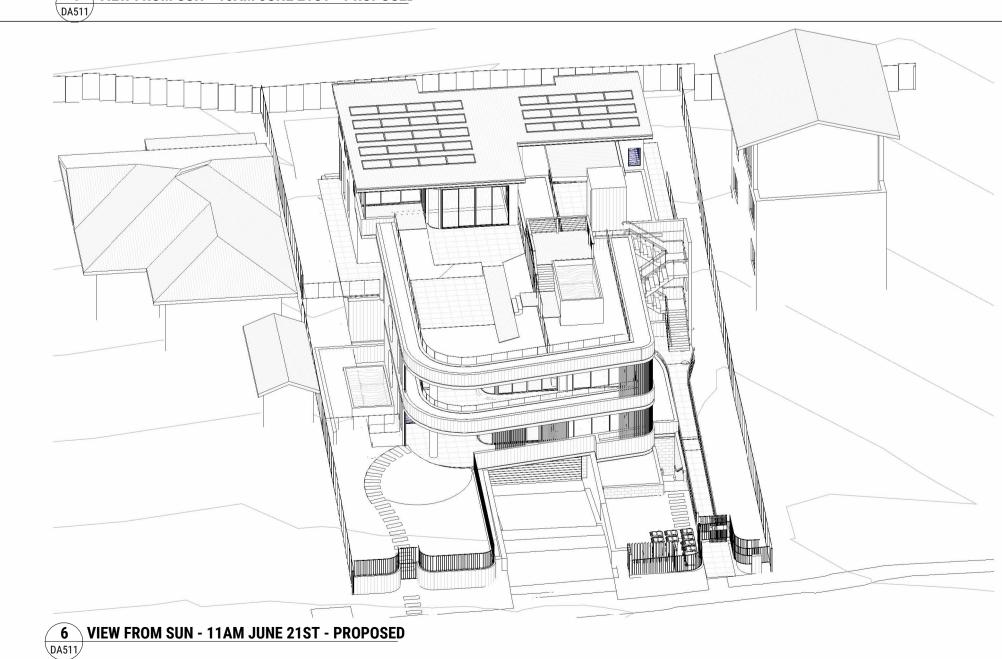

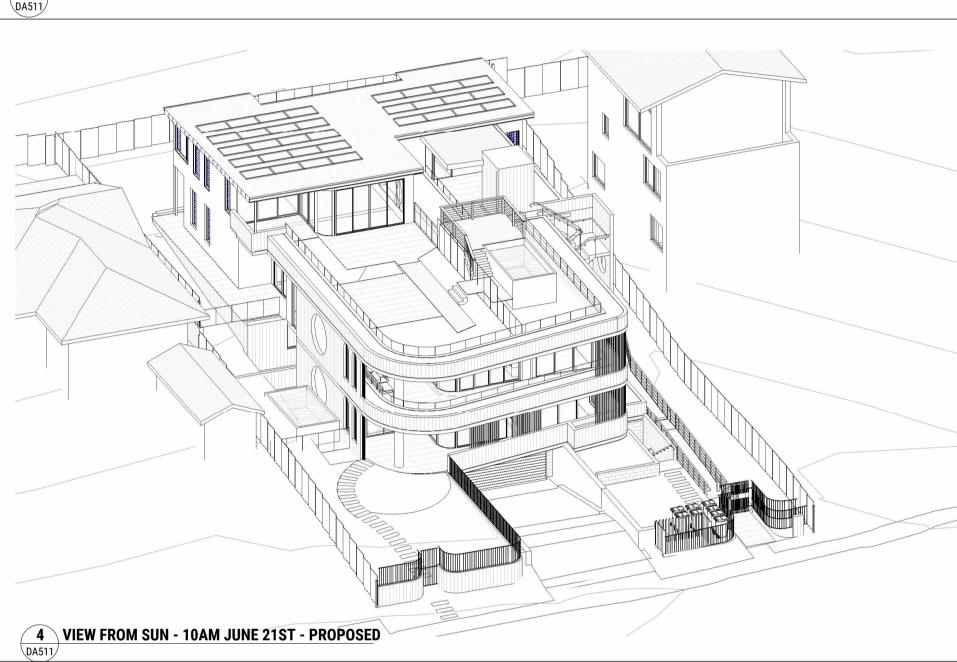

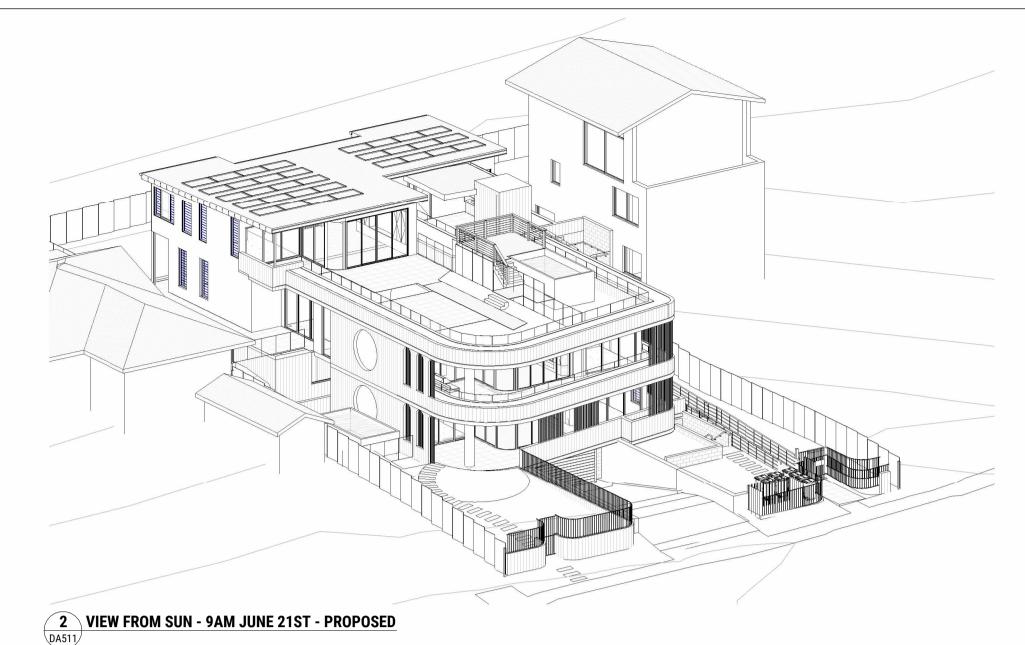

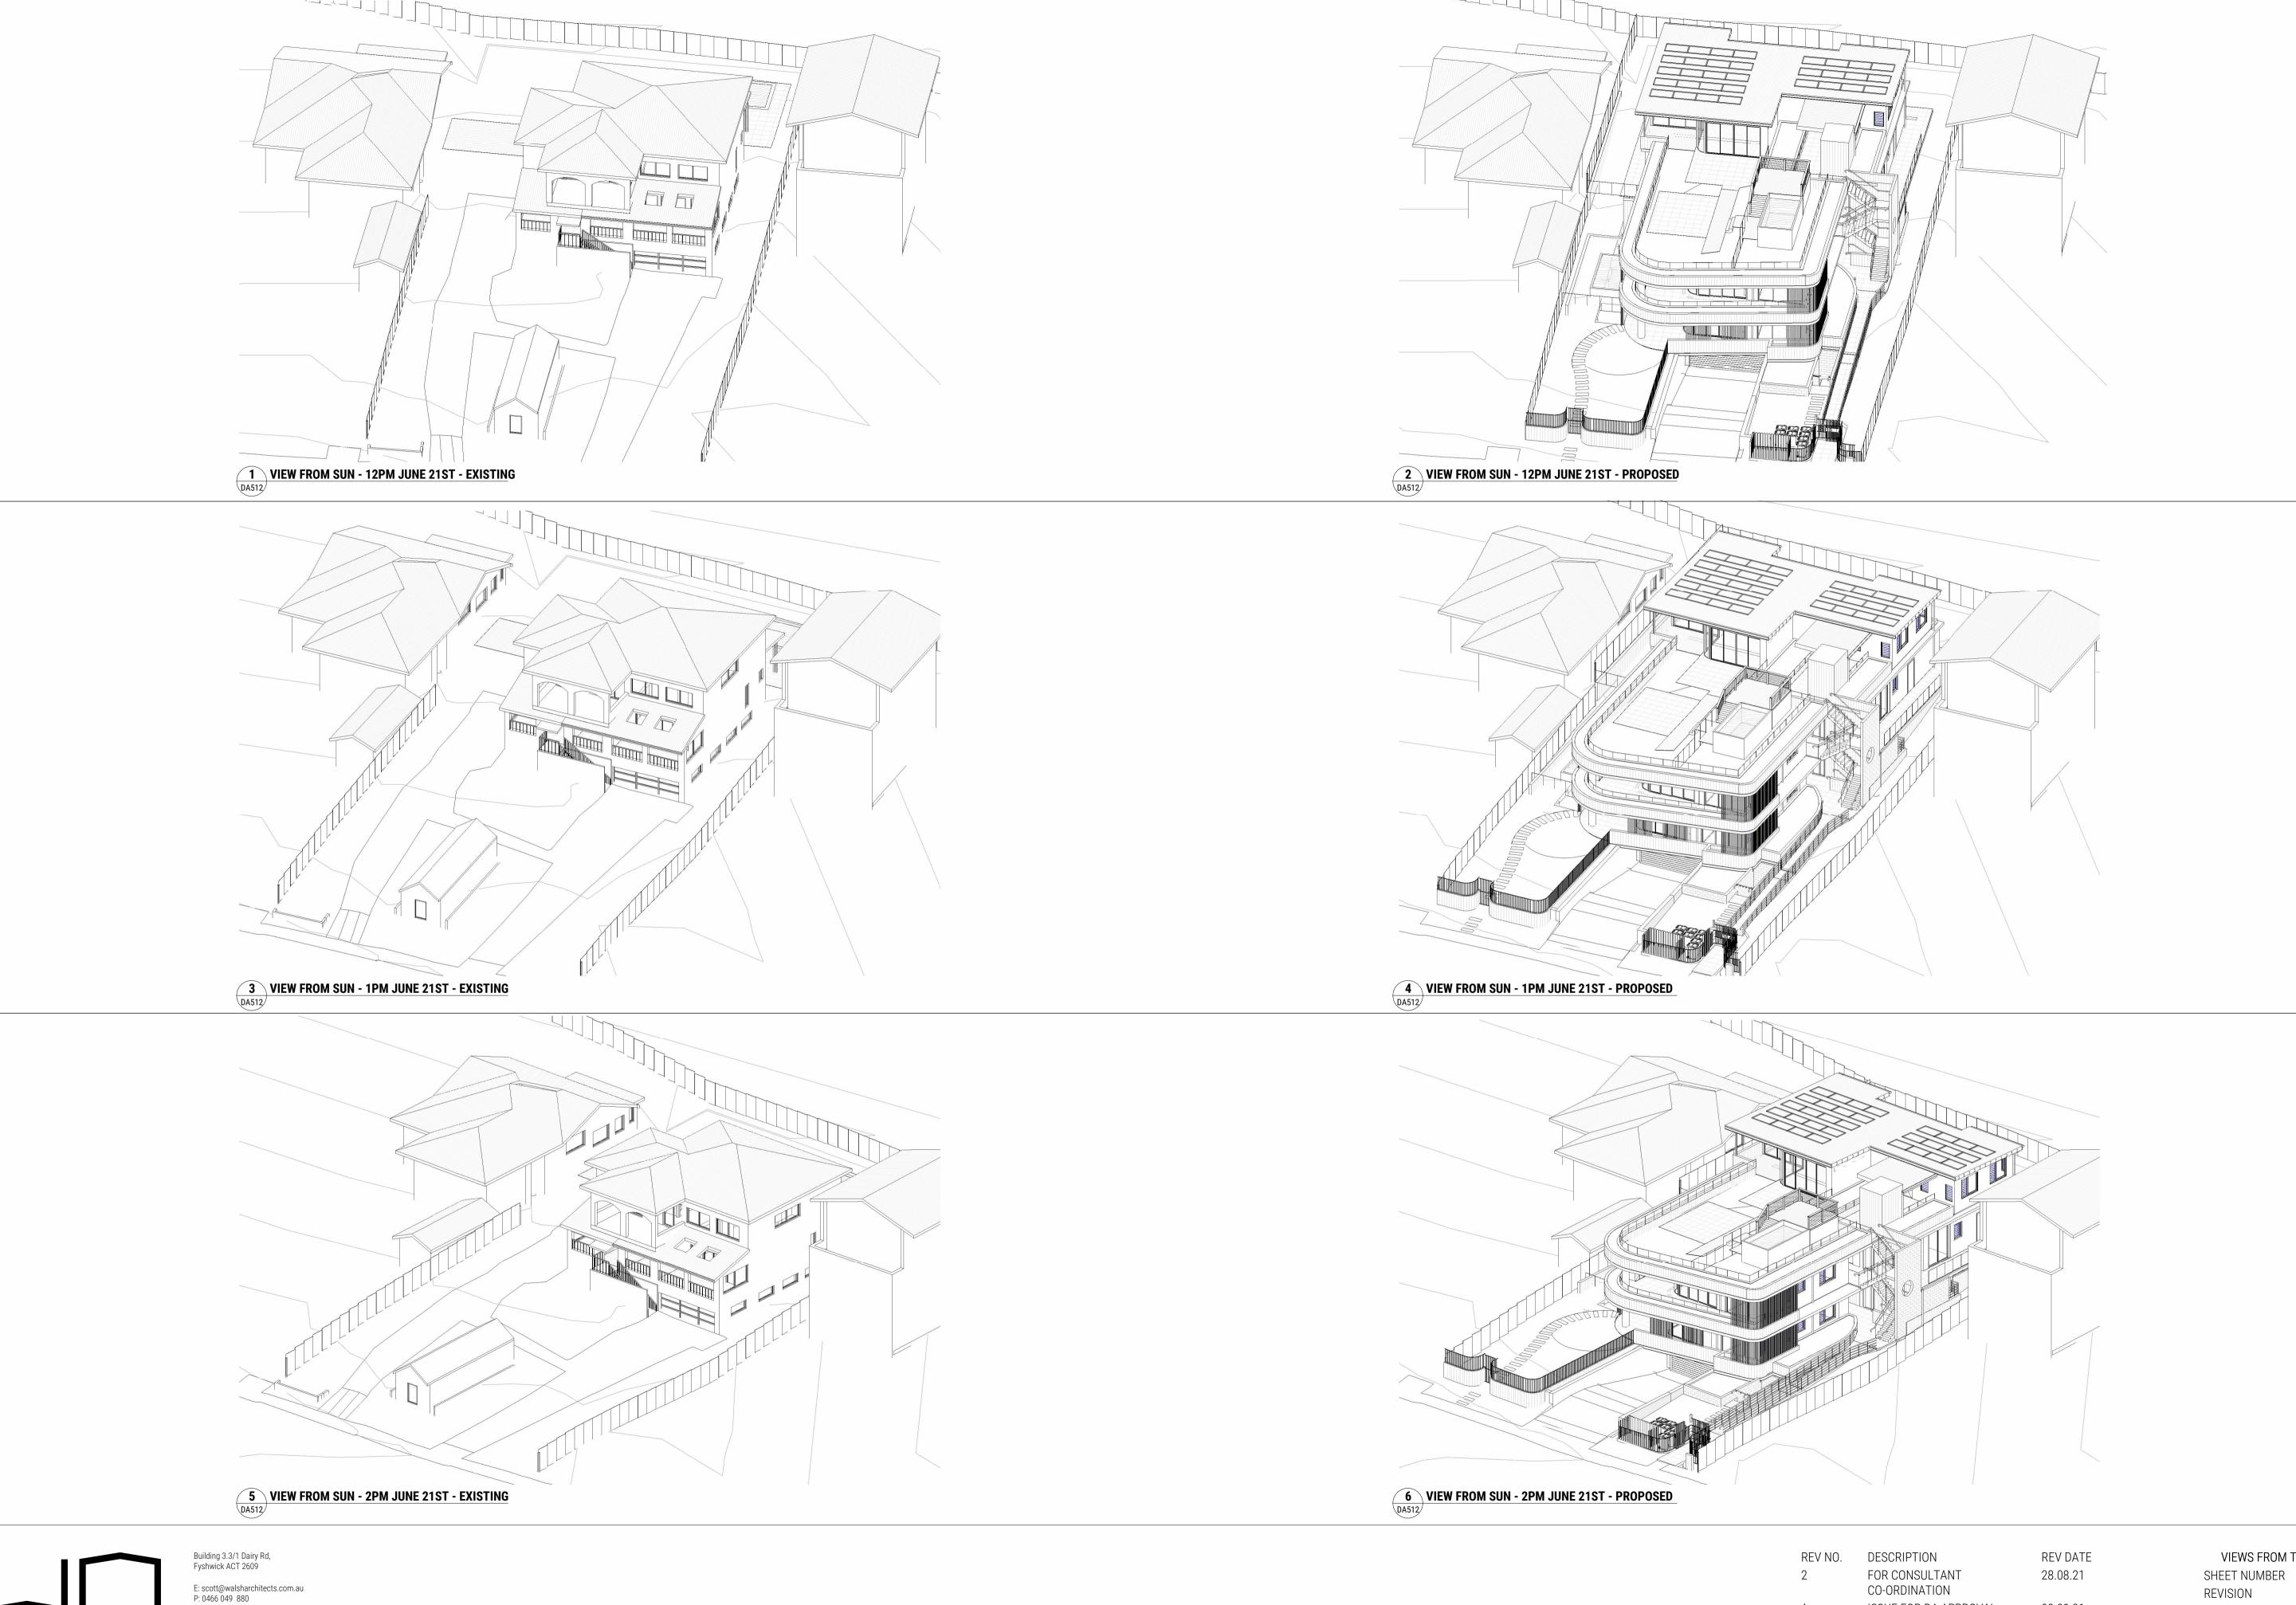


WALSH ARCHITECTS

Nominated Architect : Scott Walsh ACT 2624 | NSW 10366

CO-ORDINATION

ISSUE FOR DA APPROVAL 03.09.21 4.55 MODIFICATION 05.09.22


VIEWS FROM THE SUN - 12, 1, 2PM SHEET NUMBER REVISION SCALE @ A1 18 ALEXANDER ST COLLAROY NSW

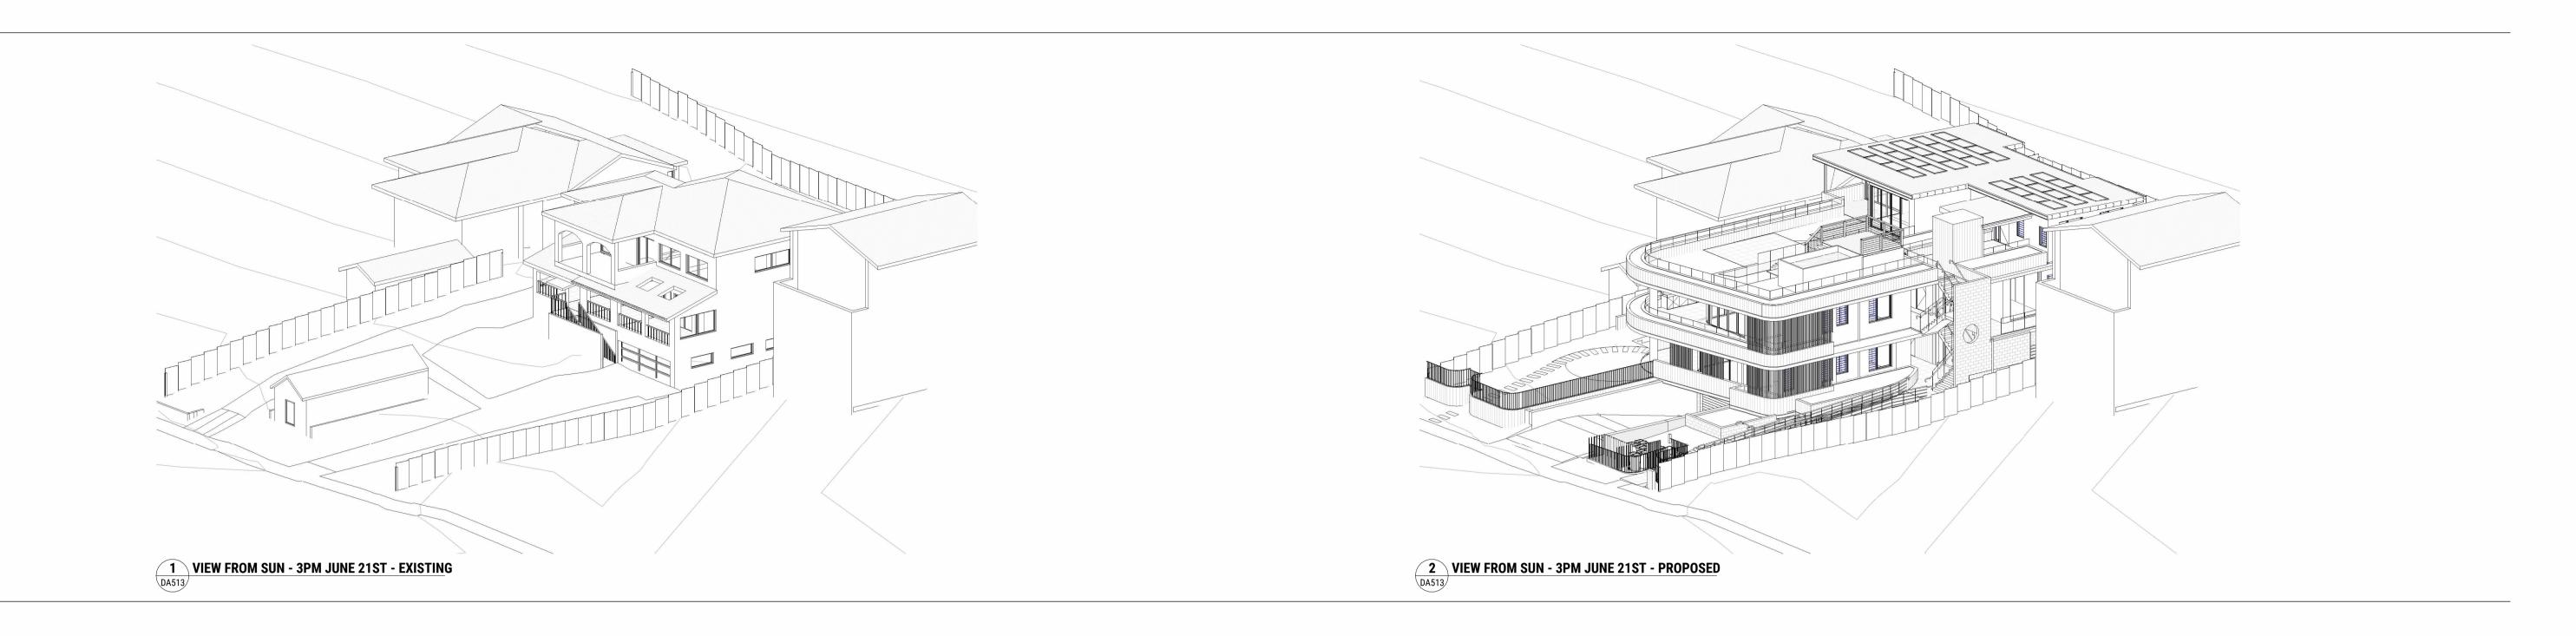


DA513

28.08.21

03.09.21

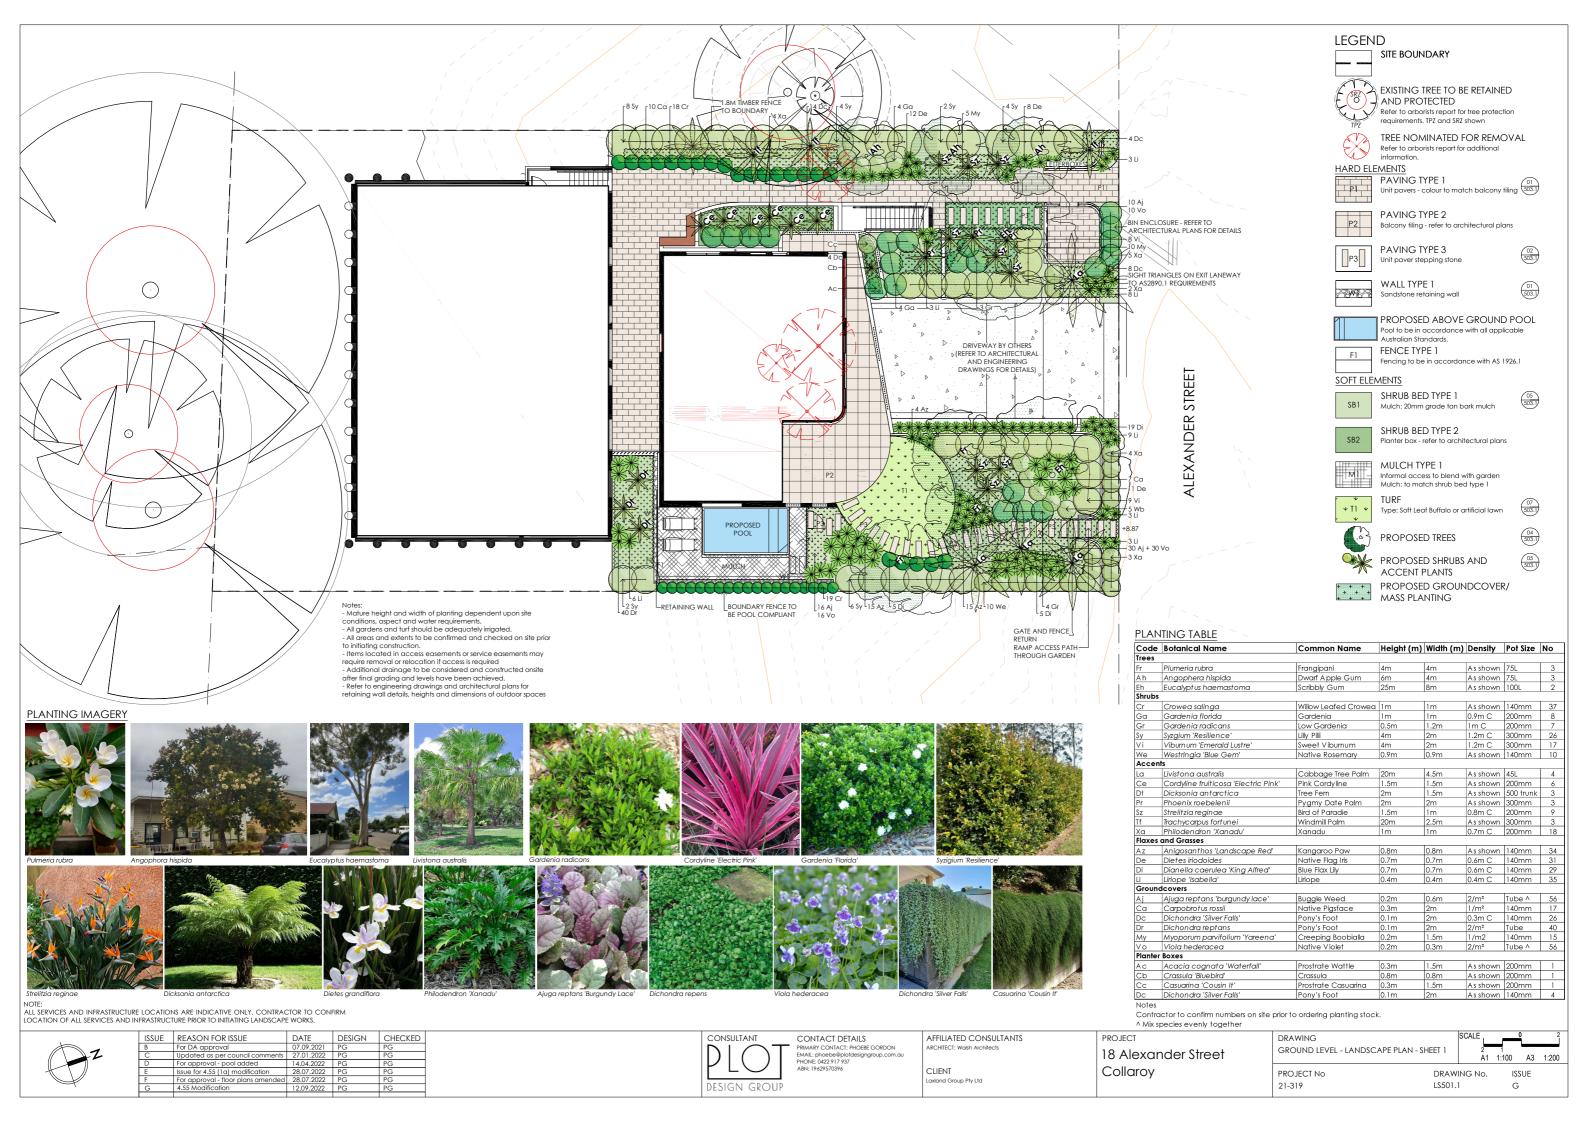

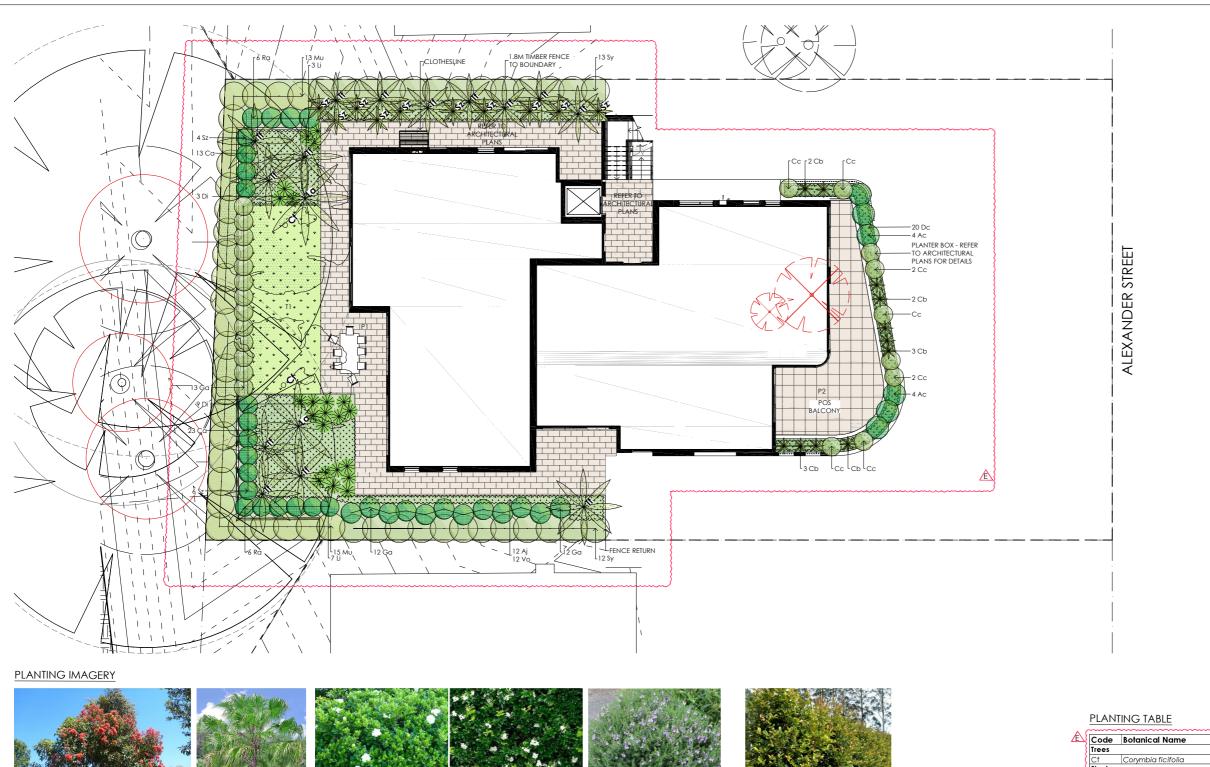

Code	Botanical Name	Common Name	Height (m)	Width (m)	Density	Pot Size	No
Trees						•	
Cf	Corymbia ficifolia	Flowering Gum	10m	5m	As shown	75L	2
Shrubs							
Ga	Gardenia florida	Gardenia	1m	1m	0.9m C	200mm	37
Mυ	Murraya paniculata	Mock Orange	4m	3m	1.2m C	300mm	28
Sy	Syzgium 'Resilience'	Lilly Pilli	4m	2m	1.2m C	300mm	25
Accent	s						
La	Livistona australis	Cabbage Tree Palm	20m	4.5m	As shown	45L	2
Sz	Strelitzia reginae	Bird of Paradie	1.5m	lm	0.8m C	140mm	20
Tf	Trachycarpus fortunei	Windmill Palm	20m	2.5m	As shown	300mm	14
Flaxes (and Grasses						
Di	Dianella caerulea 'King Alfred'	Blue Flax Lily	0.7m	0.7m	0.6m C	140mm	12
Li	Liriope 'Isabella'	Liriope	0.4m	0.4m	0.4m C	140mm	10
Ground	lcovers						
Αj	Ajuga reptans 'burgundy lace'	Buggle Weed	0.2m	0.6m	2/m²	Tube ^	12
Ca	Carpobrot us rossii	Native Pigsface	0.3m	2m	1/m²	140mm	36
Vο	Viola hederacea	Native Violet	0.2m	0.3m	2/m²	Tube ^	12
Planter	Boxes						
Ac	Acacia cognata 'Waterfall'	Prostrate Wattle	0.3m	1.5m	As shown	200mm	8
Cb	Crassula 'Bluebird'	Crassula	0.8m	0.8m	As shown	200mm	11
Сс	Casuarina 'Cousin It'	Prostrate Casuarina	0.3m	1.5m	As shown	200mm	9
Dc	Dichondra 'Silver Falls'	Pony's Foot	0.1m	2m	As shown	140mm	20

LEGEND

HARD ELEMENTS
PAVING TYPE 1
Unit pavers - colour to

SOFT ELEMENTS

SB2

SITE BOUNDARY

PAVING TYPE 2

PAVING TYPE 3

WALL TYPE 1

Unit paver stepping stone

SHRUB BED TYPE 1 Mulch: 20mm grade tan bark mulch

SHRUB BED TYPE 2

MULCH TYPE 1

PROPOSED TREES

PROPOSED SHRUBS AND ACCENT PLANTS

PROPOSED GROUNDCOVER/ MASS PLANTING

Notes:

- Mature height and width of planting dependent upon site conditions, aspect and water requirements.

- All gardens and turf should be adequately irrigated.

- All areas and extents to be confirmed and checked on site prior to initiating construction.

- Items located in access easements or service easements may require removal or relocation if access is required

- Additional drainage to be considered and constructed onsite after final grading and levels have been achieved.

- Refer to engineering drawings and architectural plans for retaining wall details, heights and dimensions of outdoor spaces

Planter box - refer to architectural plans

Informal access to blend with garden Mulch: to match shrub bed type 1

Type: Soft Leaf Buffalo or artificial lawn

EXISTING TREE TO BE RETAINED AND PROTECTED
Refer to arborists report for tree protection requirements. TPZ and SRZ shown

TREE NOMINATED FOR REMOVAL
Refer to arborists report for additional
information.

Unit pavers - colour to match balcony tiling 503.1

503.1

05 503.1

07 503.1

Balcony tiling - refer to architectural plans

ALL SERVICES AND INFRASTRUCTURE LOCATIONS ARE INDICATIVE ONLY. CONTRACTOR TO CONFIRM LOCATION OF ALL SERVICES AND INFRASTRUCTURE PRIOR TO INITIATING LANDSCAPE WORKS.

	ISSUE	REASON FOR ISSUE	DATE	DESIGN	CHECKED
	Α	Draft for client review	27.08.2021	PG	PG
// <u>1</u> 2	В	For DA approval	07.09.2021	PG	PG
	С	Updated as per council comments	27.01.2022	PG	PG
\times \ $/$	D	For approval - floor plans amended	28.07.2022	PG	PG
	E	4.55 Modification	12.09.2022	PG	PG

DESIGN GROUP

CONTACT DETAILS

PRIMARY CONTACT: PHOEBE GORDON

EMAIL: phoebe@blotdesigngroup.com.au

PHONE: 0422 917 937

ABN: 19629570396

AFFILIATED CONSULTANTS ARCHITECT: Walsh Architects

CLIENT Laxland Group Pty Ltd PROJECT 18 Alexander Street Collaroy

^ Mix species evenly together


LLTLL I LINDOCALLI LANT-SIILLI Z		LEVEL 1 - LANDSCAPE PLAN - SHEET 2
22,22, 2,4,200,4,2,2,4, 0,122,2		22 / 22 / 2 / 1 / 2 / 2 / 2 / 2 / 2 / 2


PROJECT No


21-319

DRAWING No. ISSUE LS501.2 E


Di
Li
Ground
Aj
Ca
Vo
Planter
Ac
Cb
Cc
Dc
Notes

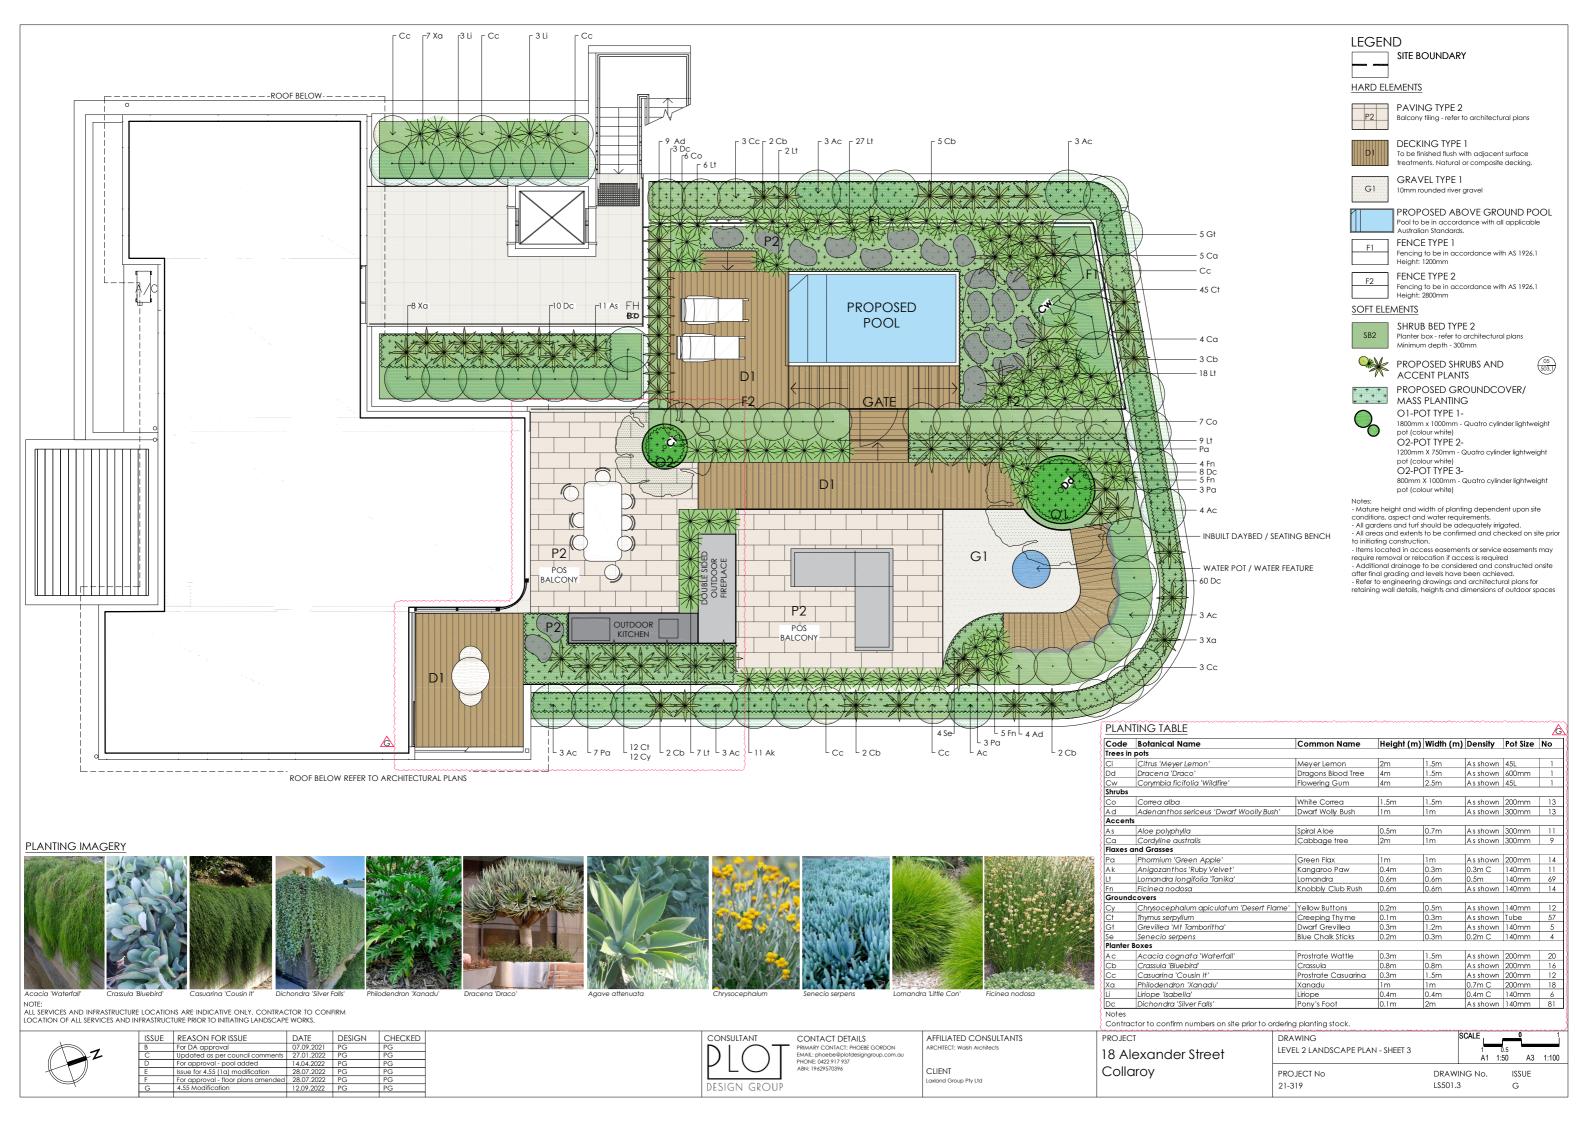


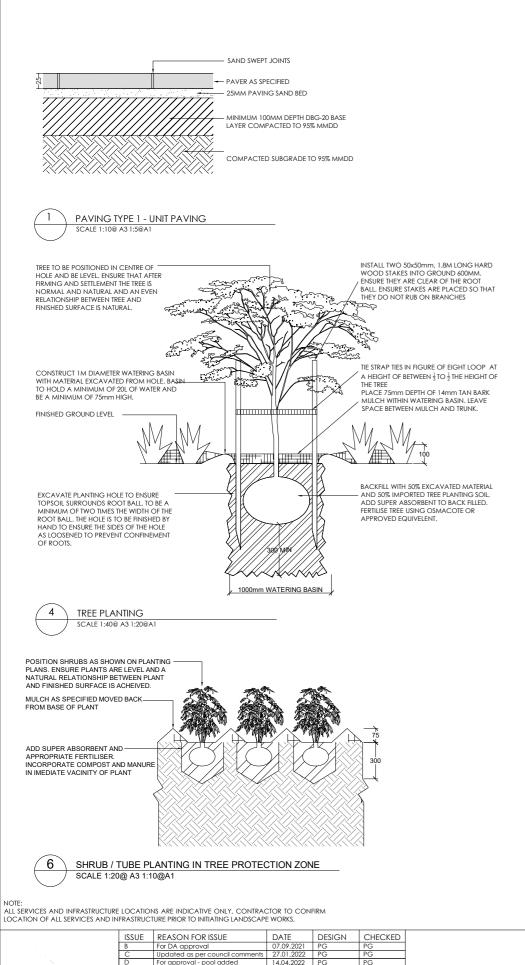

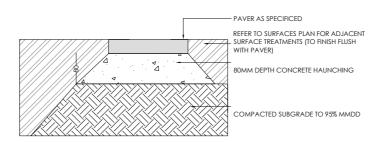


PAVING TYPE 2 - STEPPING STONES

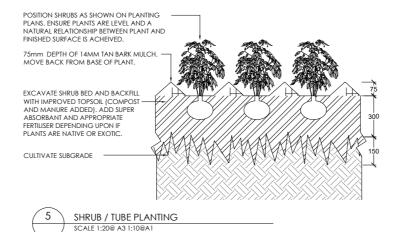

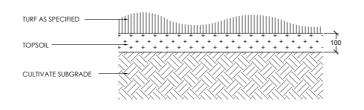

SCALE 1:20@ A3 1:10@A

DESIGN GROU

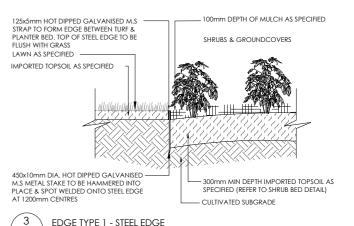

SCALE 1:20@ A3 1:10@A

LANDSCAPE SPECIFICATION NOTES

SITE PREPARATION

Locate any underground and overground services & ensure no damage occurs. Levels on plan are nominal only & all dimensions to be checked on site prior to commencement. Final structural integrity of all items shall be the sole responsibility of landscape contractor.

on site prior to commencement. I PROTECTION OF EXISTING TREES:

Prior to commencement of work, a continuous Tree Protection Fence shall be erected around the perimeter of the Tree Protection Zone (TPZ) in accordance with the tree protection requirements set out in the associated arboricultural report. The Tree Protection Fence shall be a minimum

of 1800mm high chain link fabric on 2400mm star picket or 50 /mm GWI pipe anchor posts driven 600mm into the ground.

Take necessary precautions to protect the Structural Root Zone(SRZ) as per AS 4970-2009 Australian Standard for Protection of Trees on Development Sites. Tree protection measures shall remain intact until the completion of lonastruction works. A 600mm x 450mm prohibition sign complying with ASB319 stating "NO ENTRY - TREE PROTECTION ZONE" and including contact details of the site foreman is to be attached to the

Prohibited Works or material storage within the TPZ as per AS 4970-2009 except with approval of council:

- Prohibited Works or material storage within the IPZ as per A entry of machinery or storage of building materials parking of any kind of vehicle erection or placement of site facilities removal or stockpiling of soil or site debris disposal of liquid waste including paint & concrete wash

- aisposal of liquia waste including paint & concrete wash
 excavation or trenching of any kind (including irrigation or electrical connections).
 attaching any signs or any other objects to the tree
 placement of waste disposal or skip bins
 pruning and removal of branches, other than those by a qualified Arborist
 Compacted Ground/Caring: Avoid compaction of the ground under trees. If compaction nevertheless occurs loosen the soil by Coring, Coring to be carried out by a qualified Arborist.

ELIMINATE WEEDS

Remove all existing weeds by hand, wiping or spraying with a glyphosate based herbicide. Weed control shall never be performed by mechanical

cultivation or by scraping. Herbicide spraying is 1 spraying with a glypinate base interactive. Week colline strainty cultivation or by scraping, Herbicide spraying is to be used to eliminate all existing weeds 30 days prior to planting.
EXCAVATION & SUB SOIL PREPARATION
Excavate garden beds to the depth required and rip or scarify base & sides of pit to a minimum depth of 150mm.
SUB SOIL DRAINAGE

Install drainage layer where there is surface water runoff draining into garden bed areas & where the existing sub-soil has more than 50% clay

composition & there is a risk of subsurface water ponding.

Install perforated corrugated ag, line 75-100mm Dia, with geotextile filter sock & backfill to a minimum 200mm using free draining material, reclaimed/recycled where available. Direct flows at a minimum 0.5% fall to sw system. In areas isolated from stormwater system excavate & backfill an appropriate water dispersion pit.

backfill an appropriate water dispersion pit.

REUSE EXISTING TOPSOIL

Existing site topsoil should be salvaged & appropriately stockpiled where possible.

IMPORTED TOPSOIL

Quality System: AS 4419 or as specified below.

Turf Areas: "Turf Underlay" as supplied by, ANL p: 02 9450 1444 or approved alternative.

Tree Pit and Shrub Planting: "Premium Garden Mix" as supplied by, ANL p: 02 9450 1444 or approved alternative.

PLANING
Health & Vigour: Supply plants with foilage size, texture & colour consistent with that shown in healthy specimens of the species.
Balance of Crown: Supply plants with max. variation in crown bulk on opposite sides of stem axis, +/- 20%.
Stock selection should be based on NATSPEC Guide Specifying Trees: a Guide to Assessment of Tree Quality.

STAKING

Quality system: AS 4454

Install 2 x 1800mm 40x40 hardwood timber stakes with hessian ties to all trees. Provide appropriate support considering exposure to prevailing winds. Stakes and hessian ties to be removed as soon as the tree is self supporting.

MULCHING

All planting area to be mulched with 50mm depth of river pebbles unless otherwise specified. Keep mulch 100mm away from plant stem & form a well to stop excessive water runoff. Finish flush with adjacent surfaces. $\ensuremath{\mathbf{TURFING}}$

As specified.

Excavate / grade all areas to be turfed to 120mm below finished levels. Ensure that all surface runoff is directed away from buildings. Ensure that no pooling or ponding will occur. Further rip the subgrade to 150mm. Install 100mm of imported turf underlay. Rolls to be closely butted and laid in

a brickwork pattern. Fill any small gaps with topsoil and water thoroughly.

PROJECT

Water in immediately after plant installation & allow for soil settlement. For the first 2 to 4 weeks after planting, the root zone & immediate surrounds must be kept moist. Continue watering until plants have established.

All services and infrastructure locations are indicative only. Contractor to confirm location of all services and infrastructure prior to initiating

CONSULTANT CONTACT DETAILS CLIENT

AFFILIATED CONSULTANTS

18 Alexander Street Collaroy xland Group Ptv I td

DRAWING	SCALE	
LANDSCAPE DETAILS - SHEET 4		VARIES
PROJECT NO DRA 21-319 LS50	WING No. 13.1	ISSUE G