











# TREE SURVEY Existing Trees based on Visual recognition by Conzept Landscape Architects Existing Trees based or No.# Species 1 Frangipani 2 Frangipani 3 Hibiscus hedges 1 3x Cordyline Kentia palm Banksia integrifation Size (Ht x Sp) Condition 3x3 Good 3x3 Good 3x2 Good 3x2 Good 5x1.5 Good 5x7 Good Remove Retain Remove Remove Remove Retain Retain Retain Retain Remove Retain Remove Retain Retain Remove Banksia integrifolia Kentia palm Banksia integrifolia 9x Kentia Banksia integrifolia Kentia palm Viburnum hedges 5x4 3-6x1-2 3x2 5x1.5 1-1.5 Good Good Good Good

## **EXISTING SITE IMAGES**

General Notes:
Figured dimensions take preference to scale readings. Verify all dimensions on site. PDFd plans may vary slightly in Scale for that Indicated on plans. Report any discrepancies to the Landscape Architect before proceeding with the work.

© Copyright Sulphurcreast Enterprises Pty Ltd Trading as CONZEPT (ABN: 75 623 405 630)

This dealing is protected by copyright. All rights are reserved. Unless permitted under the Copyright Act 1968, no part of this drawing



_	_

Bar Sc	ale			1:150 @ A3
1	2	3	4	 5m

REV	DATE	NOTATION/AMENDMENT	COUNCIL
Α	11.8.2023	Preliminary plan prepared for review	NORTHERN BEACHES
В	18.9.2023	Coordinated with architectural updates	CLIENT
С	22.9.2023	Final submission for DA	KALLOGHLIAN INVESTMENTS PTY LTD
D	22.3.2024	Co-ordinated with amended architectural plan	ARCHITECT
Е	25.3.2024	Co-ordinated with architect's comments	BJB ARCHITECTS
			STATUS / ISSUE
			DA - ISSUE E
			DA - 1550E E



Suit 101, 506 Miller Street, CAMMERAY NSW 2062


Phone: 9922 5312 Fax: 8209 4982 Mob: 0413 861 351

PROPOSED RESIDENTIAL DEVELOPMENT 15 OCEAN ROAD **PALM BEACH** 

SITE CONDITIONS

LPDA 24 - 029 / 1 MARCH 2024

R.F L.Z/K.Z

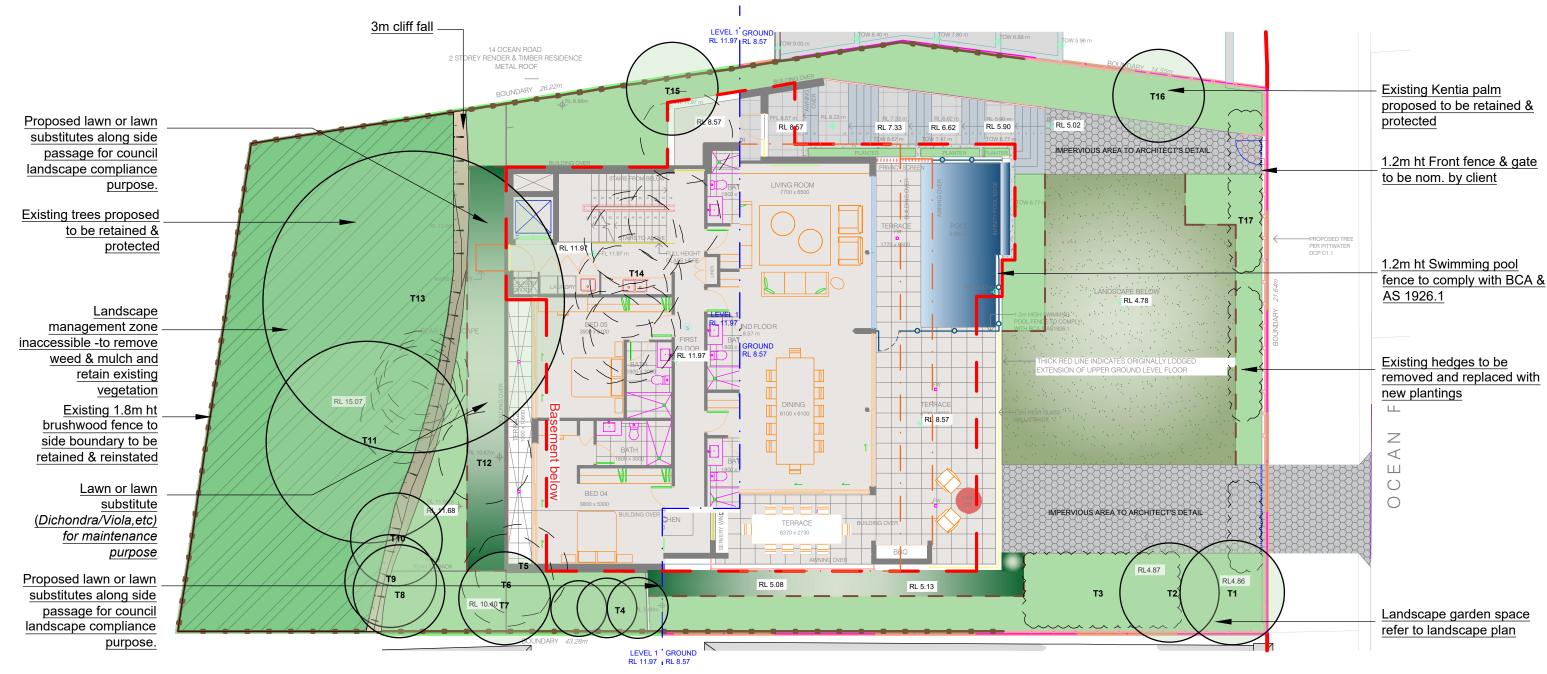

# **LOCATION PLAN**





# HARDSCAPE ITEMS



Turf area- refer to typical detail

Steel garden edging- refer to typical detail 1.2m Front fence & gate- to be nom. by



1.2m Pool Gate and fence to comply with BCA & AS1926.1- to be nom. by client

Existing 1.8m Boundary gate and fence -Brushwood fence to be retained



Lawn or lawn substitute(Dichondra/Viola,etc) for maintenance purpose

Existing trees proposed to be retained and

Existing trees proposed to be removed

## LANDSCAPE CALCULATIONS

- CALCULATION REFLECTED FROM ARCHITECTURAL DRAWING A1401- LANDSCAPE CALCULATIONS

SITE AREA:

911.9m<sup>2</sup>

234.5m<sup>2</sup>

180m² (77%)

PROPOSED LANDSCAPE AREA: 549.8m<sup>2</sup> (60.2%) (SOIL DEPTH REQUIRED TO BE COUNTED AS LANDSCAPING:

300MM FOR LAWN 600MM FOR SHRUBS


1M FOR TREES) REFER TO COUNCIL'S DCP

PROPOSED FRONT SETBACK AREA:

REQUIRED LANDSCAPE AREA TO FRONT: 140.7m<sup>2</sup> (60% OF FRONT SETBACK AREA)

PROPOSED LANDSCAPE AREA TO FRONT:

LANDSCAPE AREA INCLUDED IN CALCULATION:

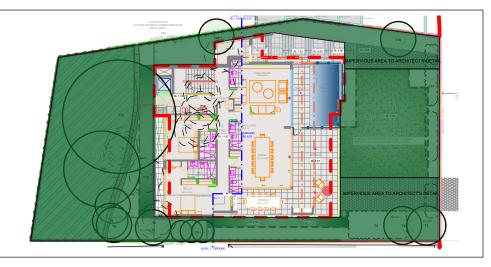

# General Notes:

Figured dimensions take preference to scale readings, Verify all dimensions on site. POP4 plans Scale for that indicated on plans. Report any discrepancies to the Landscape Architect before pro © Copyright Sulphurcrest Enterprises Pty Ltd Tradling as CONZEPT (ABN: 75 623 405 630)



E:	
Bar Scale	1:150

REV	DATE	NOTATION/AMENDMENT	COUNCIL
Α	11.8.2023	Preliminary plan prepared for review	NORTHERN BEACHES
В	18.9.2023	Coordinated with architectural updates	CLIENT
С	22.9.2023	Final submission for DA	KALLOGHLIAN INVESTMENTS PTY LTI
D	22.3.2024	Co-ordinated with amended architectural plan	ARCHITECT
Е	25.3.2024	Co-ordinated with architect's comments	BJB ARCHITECTS
			STATUS / ISSUE
			DA - ISSUE E
			DA - 1330E E




Landscape Architects enquiries@conzept.ne

Suit 101, 506 Miller Street, CAMMERAY HARDSCAPE PLAN

Phone: 9922 5312 Fax: 8209 4982 Mob: 0413 861 351 PROPOSED RESIDENTIAL DEVELOPMENT **15 OCEAN ROAD PALM BEACH** 

LPDA 24 - 029 / 2 MARCH 2024

L.Z/K.Z

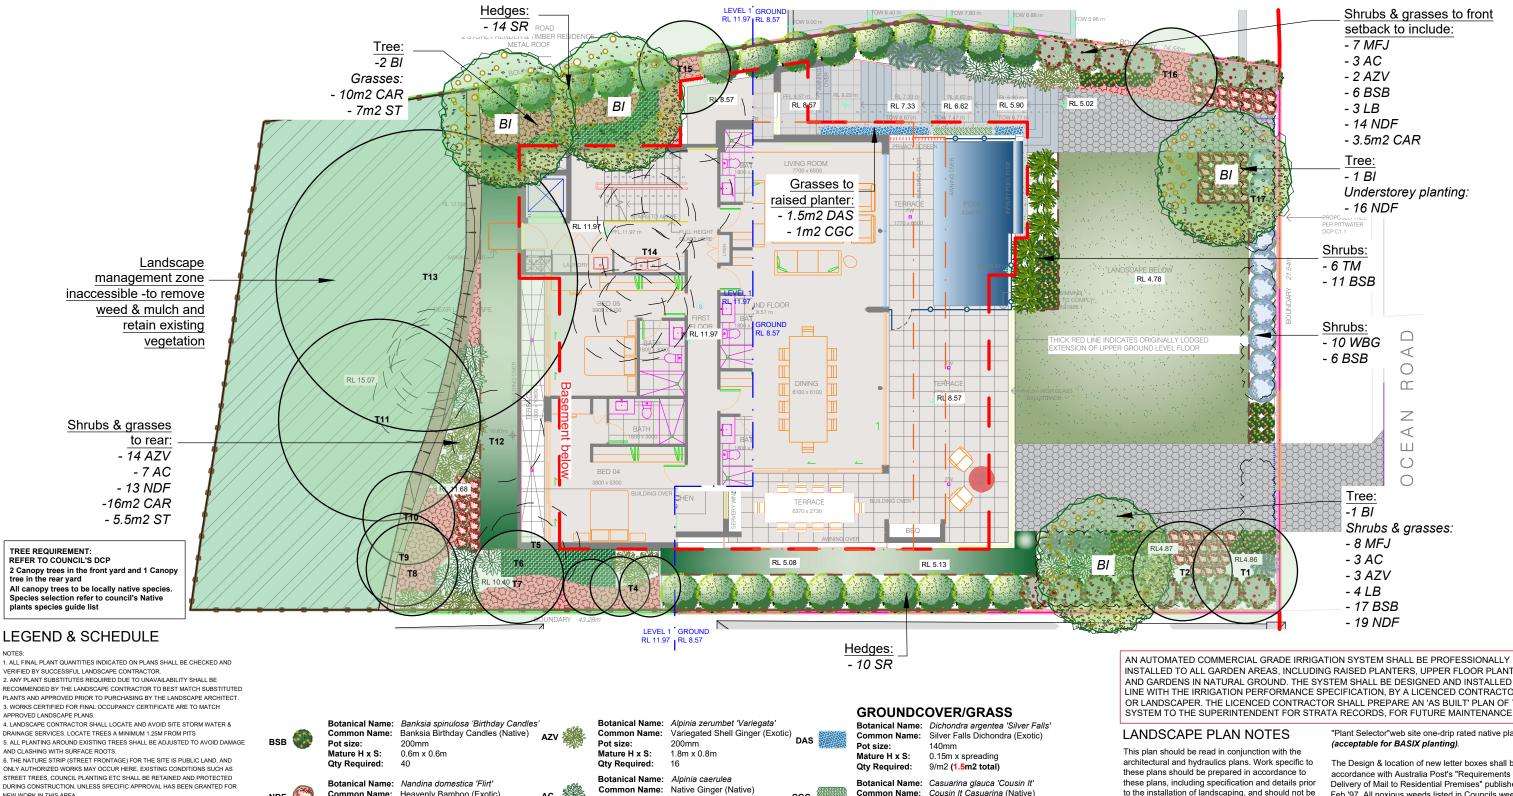

6. THE NATURE STRIP (STREET FRONTAGE) FOR THE SITE IS PUBLIC LAND, AND ONLY AUTHORIZED WORKS MAY OCCUR HERE. EXISTING CONDITIONS SUCH AS STREET TREES, COUNCIL PLANTING ETC SHALL BE RETAINED AND PROTECTED DURING CONSTRUCTION, UNLESS SPECIFIC APPROVAL HAS BEEN GRANTED FOR NEW WORK IN THIS AREA.

## **TREES**



Botanical Name: Banksia integrifolia Common Name: Coastal Banksia (Native) Mature H x S: 6-8m x 4-5m

Qty Required:

## **SHRUBS AND HEDGES**



Botanical Name: Westringia 'Blue Gem' Common Name: B. Gem Coastal Rosemary (Native)

Pot size: 200mm Mature H x S: 1.5m x 1.3m Qty Required:

Qty Required:

Mature H x S: **Qty Required:** 

Pot size:

Mature H x S:

Qty Required:

Mature H x S:

200mm

Common Name: Heavenly Bamboo (Exotic)

200mm

62

Common Name: Cushion Bush (Native)

1.2m x 1.2m

Botanical Name: Leucophyta brownii

0.3-0.6m x 0.5m

3m x 2m

Botanical Name: Syzygium 'Resilience'
Common Name: Resilience Lilly Pilly (Native)

Bar Scale

1 2 3 4

Pot size: Mature H x S: Qty Required:

Pot size:

Pot size:

Mature H x S:

**Qty Required:** 

Mature H x S:

Qty Required:

Botanical Name: Metrosideros 'Fiji Fire' Common Name: NZ Christmas Bush (Exotic) 200mm

Tiger Grass (Exotic)

1.8m x 0.8m

13

Botanical Name: Tthysanolaena maxima

300mm

2m x 2m

2m x 1.8m 15

Common Name: Cousin It Casuarina (Native)

Mature H x S: 0.1m x 1.5m 5/m2 (1m2 total) Qty Required:

Pot size:

Botanical Name: Carpobrotus 'Aussie Rambler Common Name: Aussie Rambler Pigface (Native) 140mm 0.25m x spreading

Mature H x S: 7/m2 (29.5m2 total) Qty Required: Botanical Name: Sanseveria trifasciata

Common Name: Snake Plant (Exotic) Pot size: 0.8m x 0.5m 5/m2 (12.5m2 total) Mature H x S: Qtv Required:

INSTALLED TO ALL GARDEN AREAS, INCLUDING RAISED PLANTERS, UPPER FLOOR PLANTERS AND GARDENS IN NATURAL GROUND. THE SYSTEM SHALL BE DESIGNED AND INSTALLED IN LINE WITH THE IRRIGATION PERFORMANCE SPECIFICATION, BY A LICENCED CONTRACTOR OR LANDSCAPER. THE LICENCED CONTRACTOR SHALL PREPARE AN 'AS BUILT' PLAN OF THE SYSTEM TO THE SUPERINTENDENT FOR STRATA RECORDS, FOR FUTURE MAINTENANCE.

to the installation of landscaping, and should not be altered or compromised during landscape construction. Elements such as drainage swales may be incorporated in garden bed areas (using non-floatable mulch) without compromising the capacity or form.

This plan has been prepared for DA approval only, not for construction

This plan has been prepared with reference to Northern Beaches Council's Landscaping Guidelines & requirements. Planting proposed using mainly indigenous, commercially available plant species selected from local planting lists and the BASIX local plant list and from Sydney Waters

"Plant Selector"web site one-drip rated native plants

The Design & location of new letter boxes shall be in accordance with Australia Post's "Requirements for Delivery of Mail to Residential Premises" published Feb '97. All noxious weeds listed in Councils weed lists & located on the site shall be continually removed & suppressed. Reinstate all boundary fencing in poor condition with Council approved 1.8m fencing to rear of building line, rake to 1m forward of BL. Pollution, sediment & erosion control devices as specified shall be in place, and maintained for the duration of the construction period. Proposed excavation near existing established trees to be supervised by arborist

DA approved landscape plan's are required to be constructed as approved to obtain occupancy certificate. Permeable areas may be indicated to achieve site coverage restrictions & should be constructed as drawn on this plan.

## General Notes:

scale readings. Verify all dimensions on site. PDF'd plans may vary slightly Figured dimensions take preference to scale readings, Verify all dimensions on site. PDFd plans in Scale for that indicated on plans. Report any disrepsacies to the Landscape Architect before proc 
© Copyright Sulphurcrest Enterprises Pty Ltd Trading as CONZEPT 
(ABN: 75 623 405 630)





REV	DATE	NOTATION/AMENDMENT	COUNCIL
Α	11.8.2023	Preliminary plan prepared for review	NORTHERN BEACHES
В	18.9.2023	Coordinated with architectural updates	CLIENT
С	22.9.2023	Final submission for DA	KALLOGHLIAN INVESTMENTS PTY LTD
D	22.3.2024	Co-ordinated with amended architectural plan	ARCHITECT
Е	25.3.2024	Co-ordinated with architect's comments	BJB ARCHITECTS
			STATUS / ISSUE
			DA - ISSUE E

conzept www.conzept.net.au

Landscape Architects enquiries@conzept.ne

CAMMERAY NSW 2062

Phone: 9922 5312 Fax: 8209 4982 Mob: 0413 861 351

- GF & LEVEL 1 PROPOSED RESIDENTIAL DEVELOPMENT 15 OCEAN ROAD **PALM BEACH** 

LANDSCAPE PLAN

LPDA 24 - 029 / 3 MARCH 2024 CHECKED: L.Z/K.Z R.F

# **LEGEND & SCHEDULE**

ALL FINAL PLANT QUANTITIES INDICATED ON PLANS SHALL BE CHECKED AND VERIFIED BY SUCCESSFUL LANDSCAPE CONTRACTOR.

2. ANY PLANT SUBSTITUTES REQUIRED DUE TO UNAVAILABILITY SHALL BE RECOMMENDED BY THE LANDSCAPE CONTRACTOR TO BEST MATCH SUBSTITUTED PLANTS AND APPROVED PRIOR TO PURCHASING BY THE LANDSCAPE ARCHITECT. 3. WORKS CERTIFIED FOR FINAL OCCUPANCY CERTIFICATE ARE TO MATCH APPROVED LANDSCAPE PLANS.

4. LANDSCAPE CONTRACTOR SHALL LOCATE AND AVOID SITE STORM WATER & DRAINAGE SERVICES. LOCATE TREES A MINIMUM 1.25M FROM PITS
5. ALL PLANTING AROUND EXISTING TREES SHALL BE ADJUSTED TO AVOID DAMAGE AND CLASHING WITH SURFACE ROOTS

6. THE NATURE STRIP (STREET FRONTAGE) FOR THE SITE IS PUBLIC LAND, AND ONLY AUTHORIZED WORKS MAY OCCUR HERE. EXISTING CONDITIONS SUCH AS STREET TREES, COUNCIL PLANTING ETC SHALL BE RETAINED AND PROTECTED DURING CONSTRUCTION, UNLESS SPECIFIC APPROVAL HAS BEEN GRANTED FOR NEW WORK IN THIS AREA.

# **SUCCULENTS & GRASSES**

Botanical Name: Aloe 'Pink Brush' Common Name: Pink Brush Aloe (Exotic) 200mm Pot size: Mature H x S: 0.3m x 0.3m Qty Required: Botanical Name: Agave 'Blue Glow'

Common Name: Blue Glow Agave (Exotic) 45Lt Pot size: Mature H x S: 0.6m x 0.75m

Qty Required:

**Botanical Name:** Echinocactus spp Common Name: Golden barrel cactus (Exotic)

Pot size: 200mm Mature H x S: 0.3m x 0.3m Qty Required: 27

Botanical Name: Lomandra.f glauca Common Name: Blue fescue (Exotic) 100mm Pot size: Mature H x S: 0.25m x 0.3m

Qty Required:

Botanical Name: Dichondra argentea 'Silver Falls'
Common Name: Silver Falls Dichondra (Exotic) 140mm Pot size:

Mature H x S: 0.15m x spreading Qty Required: 9/m2 (9.0m2 total)

Botanical Name: Carpobrotus 'Aussie Rambler' Common Name: Aussie Rambler Pigface (Native)

Mature H x S: 0.25m x spreading

Qty Required: 7/m2 (8.0m2 total) Botanical Name: Senecio serpens Common Name: Blue Chalk sticks (Exotic)

Pot size: 140mm Mature H x S: 0.2m x 0.4m 5/m2 (5.0m2 total) Qtv Required:

Botanical Name: Rosmarinus prostratus Common Name: Creeping Rosemary (Native)


Tube stock Mature H x S:


0.15m x spreading 9/m2 (8.0m2 total)

> SAFETY OVERFLOW DESIGNED FOR APPROPRIATE RAINFALL INTENSITY WITH SCREW CAP FOR CLEARING ACCESS TO MANUFACTURER'S SPECIFICATION

GEO-FILTER FABRIC TURNED UP AND SECURED TO RISER ABOVE DRAINAGE **OPENING** 

\*THE IRRIGATION SYSTEM WILL BE SUB-SURFACE DRIP LINE CONNECTED WITH A SPECIALISED CONTROLLER, REQUIRING A SECURE POWER POINT AND WATER SUPPLY AT THE SAME LOCATION WITH A 20MM SUPPLY LINE FROM THE LOCATION OF THE CONTROLLER TO EACH OF THE ROOF GARDEN TERMINATING APPROX 100MM BELOW THE FINISHED GARDEN LEVEL

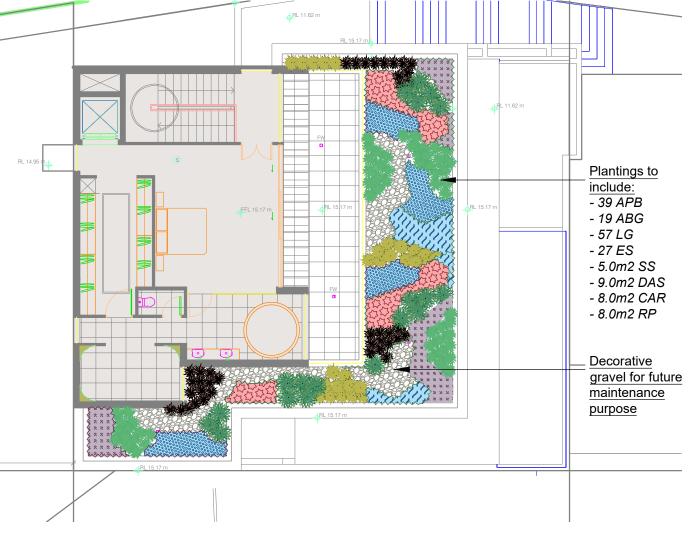

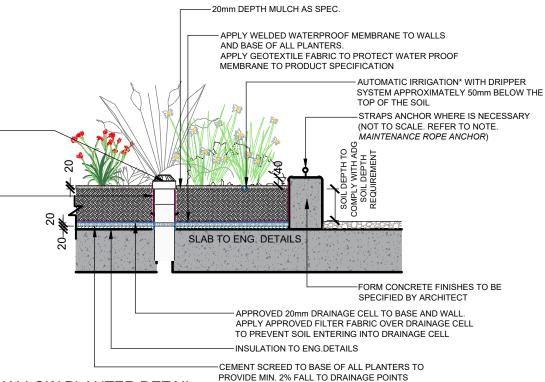

**IMAGE: FYTOGREEN** 

DETAILS TO BE REVIEWED BY ENGINEER. PROPRIETARY ITEM TO SUPPLIER'S DETAILS. SHOP DRAWINGS TO BE PROVIDED BY SUCCESSFUL CONTRACTOR/SUPPLIER





Banksia integrifolia



Metrosideros 'Fiji Fire'





Banksia spinulosa 'Birthday Candles



Alpinia zerumbet 'Variegata'



Tthysanolaena maxima



Alpinia caerulea





Dichondra argentea 'Silver Falls'



Leucophyta brownii

# TYPICAL SHALLOW PLANTER DETAIL

General Notes: adinns. Verify all dimensions on site. PDF'd plans may vary s

© Copyright Sulphurcrest Enterprises Pty Ltd Trading as CONZEPT (ABN: 75 623 405 630)



ar Scale	1:150

1 2 3 4

	REV	DATE	NOTATION/AMENDMENT	COUNCIL
	Α	11.8.2023	Preliminary plan prepared for review	NORTHERN BEACHES
	В	18.9.2023	Coordinated with architectural updates	CLIENT
	С	22.9.2023	Final submission for DA	KALLOGHLIAN INVESTMENTS PTY LT
,	D	22.3.2024	Co-ordinated with amended architectural plan	ARCHITECT
3	E	25.3.2024	Co-ordinated with architect's comments	BJB ARCHITECTS
				STATUS / ISSUE
				DA - ISSUE E



506 Miller Street, CAMMERAY LANDSCAPE PLAN - LEVEL 2 NSW 2062

Phone: 9922 5312 Fax: 8209 4982 Mob: 0413 861 351

PROPOSED RESIDENTIAL DEVELOPMENT 15 OCEAN ROAD **PALM BEACH** 

DWG.No:
LPDA 24 - 029 /
DATE:
MARCH 202

MAR	CH 2024
DRAWN:	CHECKED:
L.Z/K.Z	R.F



- 1. CHAIN WIRE MESH PANELS WITH SHADE CLOTH (IF REQUIRED) ATTACHED, HELD IN PLACE WITH CONCRETE FEET
- 2. ALTERNATIVE PLYWOOD OR WOODEN PALING FENCE PANELS. THE FENCING MATERIAL ALSO PREVENTS BUILDING MATERIALS OR SOIL ENTERING THE TPZ
- 3. MULCH INSTALLATION ACROSS SURFACE OF TPZ (AT THE DISCRETION OF THE PROJECT ARBORIST). NO EXCAVATION CONSTRUCTION ACTIVITY, GRADE CHANGES, SURFACE TREATMENT OR STORAGE OF MATERIALS OF ANY KIND IS PERMITTED WITHIN THE TPZ
- 4. BRACING IS PERMISSIBLE WITHIN THE TPZ. INSTALLATION OF SUPPORTS TO AVOID DAMAGING ROOTS

PROVIDE FENCING AS DETAILED TO ALL TREES PROPOSED TO BE RETAINED ON THE SUBJECT SITE. FENCING TO BE LOCATED TO THE DRIP LINE OF TREES OR AS INDICATED ON PLANS OR DIRECTED ON-SITE BY ARBORIST. NO STOCKPILING WITHIN FENCE PERIMETERS.

# TREE PROTECTION ZONE

LAWN/GARDEN EDGE **SPECIFIED** PLANTING & POT SIZE 300mm DERTH SOIL MIX BLEND SUBSOIL CULTIVATED TO 100mm

TYPICAL SETBACK FROM

THIS DETAIL IS ONLY APPLICABLE FOR PLANTING AREA OUTSIDE TREE PROTECTION ZONE OF TREES TO BE RETAINED. NO CHANGES ARE TO OCCUR TO EXISTING LEVELS, INCLUDING RIPPING/CULTIVATING OF THE SOIL WITHIN THE TPZ OF TREES TO BE RETAINED ON SITE

75mm DEPTH "FOREST FINE" MULCH OR EQUIVALENT


## SOIL MIX:

50% OF STOCKPILED SITE TOPSOIL FREE FROM ALL BUILDER'S **RUBBISH AND DELETERIOUS** MATERIALS. TOPSOIL TO BE MIXED WITH MINIMUM 50% IMPORTED GARDEN MIX OR SOIL CONDITIONER/ COMPOSTED ORGANIC MATTER - SEE SPEC. LISE 100% IMPORTED SOIL MIX WHEN SITE TOPSOIL RUNS OUT.

# AT JUNCTIONS FIX 150 LENGTH PLATE ACROSS JOIN, FIX WITH BOLTS PLAN SCALE: 1:10 100 X 5 MM PLATE 75 LENGTH PIPE WELDED TO PLATE

DETAIL SCALE: 1:10

NOTE: TURF AREAS TO FINISH FLUSH WITH SURROUNDING SURFACE FINISHES (EXCEPT GARDEN BEDS) ROLL AND WATER IMMEDIATELY AFTER LAYING.

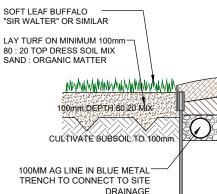

SECTION


# STEEL EDGE & TURF DETAIL

REFER GARDEN PREP DETAIL

450 LENGTH R10 BAR

DRIVEN INTO GROUND

NOTE: TYPICAL DETAIL ONLY. ALL WALLS WHICH FORM PART OF DRAINAGE WORKS MUST BE BUILT AS DETAILED BY THE HYDRAULIC ENGINEER. ALL WALLS EXCEEDING 1m HEIGHT SHALL BE DETAILED BY A QUALIFIED ENGINEER. INSTALL WALL TO SUIT SITE LEVELS AND TO MANUFACTURE'S SPECIFICATION.

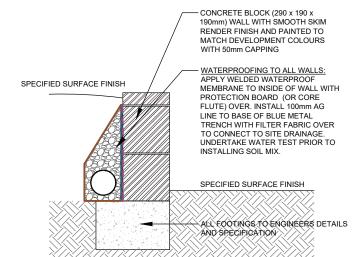

# TYPICAL RETAINING WALL DETAIL

# TREE PLANTING DETAIL

SPECIFIED

(ONLY APPLICABLE FOR PLANTING AREA OUTSIDE TREE PROTECTION ZONE OF TREES TO BE RETAINED. NO CHANGES ARE TO OCCUR TO EXISTING LEVELS, INCLUDING RIPPING/CULTIVATING OF THE SOIL WITHIN THE TPZ OF TREES TO BE RETAINED ON SITE)

# TYPICAL GARDEN PREPARATION DETAIL

**SCALE 1:10** 

# General Notes:

# Figured dimensions take preference to scale readings. Verify all dimensions on site. PDF0 plans Scale for that indicated on plans. Report any discrepancies to the Landscape Architect before pro Copyright Sulphurcrest Enterprises Pty Ltd Trading as CONZEPT (ABN: 75 623 405 630)





REV	DATE	NOTATION/AMENDMENT	COUNCIL
Α	11.8.2023	Preliminary plan prepared for review	NORTHERN BEACHES
В	18.9.2023	Coordinated with architectural updates	CLIENT
С	22.9.2023	Final submission for DA	KALLOGHLIAN INVESTMENTS PTY LTD
D	22.3.2024	Co-ordinated with amended architectural plan	ARCHITECT
Е	25.3.2024	Co-ordinated with architect's comments	BJB ARCHITECTS
			STATUS / ISSUE
			DA - ISSUE E



Suit 101, 506 Miller Street, CAMMERAY NSW 2062

Phone: 9922 5312

Fax: 8209 4982 Mob: 0413 861 351

PROPOSED RESIDENTIAL DEVELOPMENT 15 OCEAN ROAD **PALM BEACH** 

**DETAILS 1** 

LPDA 24 - 029 / 5

NOTE: DRIP IRRIGATION MAY BE

& DESIGNED BY LICENCED

CONTRACTOR.

LANDSCAPE USE'.

AFTER PLANTING.

REQUIRED AS NOMINATED BY CLIENT

PLANT STOCK SHALL BE SOURCED

FROM GROWERS CONFORMING TO

THOROUGHLY WATER IN ALL NEWLY

AS2303:2019. 'TREE STOCK FOR

PLANTED STOCK IMMEDIATELY

QUALITY OF PLANT TO BE APPROVED BY PROJECT MANAGER

OR LANDSCAPE ARCHITECT

PROVIDE 3 HARDWOOD STAKES

PROVIDE SLIGHT DEPRESSION TO ALLOW FOR EFFECTIVE WATERING

75mm 'FOREST FINE' MULCH OR

BACKFILL HOLE WITH CLEAN,

LANDSCAPE ARCHITECT

- CULTIVATE/ RIP SUBGRADE

TESTED SITE TOP-SOIL BLEND OR

IMPORTED SOIL MIX APPROVED BY

**EQUAL** 

1.8m X 50mm X 50mm FOR ALL TREES. USE 50mm HESSIAN TIES TO SECURE LOWER TRUNK TO STAKES

> MARCH 2024 RF L.Z/K.Z

### **PRELIMINARIES**

### 1.01 GENERAL

The following general conditions should be considered prior to the commencement of landscape works:

- cape plans should be read in conjunction with the architectural plans, hydraulic plans, service plans and survey prepared for the proposed development.
- All services including existing drainage should be accurately located prior to the commencement of landscape installation. Any proposed tree planting which falls close to services will be relocated on site under the instruction of the landscape architect.
- Installation of conduit for required irrigation, electrical and other services shall be completed prior to the commencement of hardscape
- All outdoor lighting specified by architect or client to be installed by qualified electrician
- Anomalies that occur in these plans should be brought to our immediate attention.

  Where an Australian Standard applies for any landscape material testing or installation technique, that standard shall be followed

### 1.02 PROTECTION OF ADJACENT FINISHES

The Contractor shall take all precautions to prevent damage to all or any adjacent finishes by providing adequate protection to these areas / surfaces prior to the commencement of the Works

### 1.03 PROTECTION OF EXISTING TREES

Existing trees identified to be retained shall be done so in accordance with AS 4970-2009 Protection of trees on development sites as well as in accordance with the tree protection measures prepared by project arborist.

Where general works are occurring around such trees, or pruning is required, a qualified Arborist shall be engaged to oversee such works and

Existing trees designated on the drawing for retention shall be protected at all times during the construction period. Any soil within the drip-line of existing trees shall be excavated and removed by hand only. No stockpiling shall occur within the root zone of existing trees to be retained.

Any roots larger in diameter than 50mm shall only be severed under instruction by a qualified arborist. Roots smaller than 50mm diamete shall be cut cleanly with a saw

Temporary fencing shall be installed around the base of all trees to be retained prior to the commencement of landscape works. Where possible this fencing will be located around the drip line of these trees, or a minimum of 3m from the trunk. The fencing shall be maintained for the full construction period

### 1.04 EROSION & POLLUTION CONTROL

The Contractor shall take all proper precautions to prevent the erosion of soil from the subject site. The contractor shall install erosion & sediment control barriers and as required by council, and maintain these barriers throughout the construction period. Note that the sediment control measures adopted should reflect the soil type and erosion characteristics of the site.

Erosion & pollution control measures shall incorporate the following

- Construction of a sediment trap at the vehicle access point to the subject site
- Sediment fencing using a geotextile filter fabric in the location indicated on the erosion control plan or as instructed on site by the
- Earth banks to prevent scour of stockpiles
- Sandbag kerb sediment traps
  Straw bale & geotextile sediment filter.
- Exposed banks shall be pegged with an approved Jute matting in preparation for mass planting

Refer to 'Guidelines for Erosion and Sediment Control on Building Sites' by DLWC (2000) for construction techniques

## SOIL WORKS 2.01 MATERIALS

Specified Soil Conditioner (Generally to improve site soil) The specified soil conditioner for site top-soil improvement shall be an organic mix complies with AS 4454-2012 Composts, soil conditioners

and mulches. Note that for sites where soil testing indicates toxins or extremes in pH, or soils that are extremely poor, allow to excavate and supply 300mm of imported soil mix.

### New gardens & proposed Planting

New garden and planting areas shall consist of a 50/50 mix of clean site soil (refer d) below) and imported soil. All mixes are to comply with AS4419-2003 Soils for Landscaping and garden use, & AS 4454 Composts, Soil conditioners & mulches.

### Specified Soil Mix - Turf

The specified soil mix for all turf areas shall be a min 75mm layer of imported soil mix consisting of 80% washed river sand (reasonably coarse), and 20% composted organic matter equivalent to mushroom compost or soil conditioner, or other approved lawn top dress.

Site topsoil is to be clean and free of unwanted matter such as gravel, clay lumps, grass, weeds, tree roots, sticks, rubbish and plastics, and any deleterious materials and materials toxic to plants. The topsoil must have a pH of between 5.5 and 7. Use 100% imported soil mix when site when site topsoil runs out.

## 2.02 INSTALLATION

Note: No level changes (Cut or Fill), soil ripping within the Tree Protection Zones of trees to be retained

# a) Testing

All testing is to be conducted in accordance with AS4419-2003 Soils for Landscaping and garden use Methods for testing soils for engineering purposes. Site soil shall be given a pH test prior to modifying to ensure conditions are appropriate for planting as stated above. Tests shall be taken in several areas where planting is proposed, and the pH shall be adjusted accordingly with sulphur or lime to suit.

Note that a soil test conducted by the Sydney Environmental & Soil Laboratory or approved equal shall be prepared for all commercial. industrial and multi-unit residential sites. The successful landscape contractor shall implement the recomme

### Set Out of Individual Trees & Mass Planting Areas

All individual tree planting positions and areas designated for mass planting shall be set out with stakes or another form of marking, ready for inspection and approval. Locate all services.

### Establishing Subgrade Levels

Subgrade levels are defined as the finished base levels prior to the placement of the specified material (i.e. soil conditioner). The following subgrade levels shall apply:

Mass Planting Beds - 300mm below existing levels with specified imported soil mix.

Note that all subgrades shall consist of a relatively free draining natural material, consisting of site topsoil placed previously by the Civil

### d) Subgrade Cultivation

Cultivate all subgrades to a minimum depth of 100mm in all planting beds and all turf areas, ensuring a thorough breakup of the subgrade into a reasonably coarse tilth. Grade subgrades to provide falls to surface and subsurface drains, prior to the placement of the final specified soil

### e) Drainage Works

Install surface and subsurface drainage where required and as detailed on the drawing. Drain subsurface drains to outlets provided, with a minimum fall of 1:100 to outlets and / or service pits.

### Placement and Preparation of Specified Soil Conditioner & Mixes.

Trees in turf & beds - Holes shall be twice as wide as root ball and minimum 100mm deeper - backfill hole with 50/50 mix of clean site

# soil and imported "Organic Garden Mix" as supplied by ANL or approved equa

Turf Areas - Install specified soil mix to a minimum compacted depth of 75mm

Mass Planting Beds - Install specified soil conditioner to a compacted depth of 100mm Place the specified soil conditioner to the required compacted depth and use a rotary hoe to thoroughly mix the conditioner into the top 300mm of garden bed soil. Ensure thorough mixing and the preparation of a reasonably fine tilth and good growing medium in preparation for planting.

Place the specified soil mix to the required compacted depth and grade to required finished soil levels, in preparation for planting and turfing.

### PI ANTING

### 3.01 MATERIALS

### a) Quality and Size of Plant Material

All trees supplied above a 25L container size must be grown and planted in accordance with AS 2303:2019

Tree stock for landscape use. Certification that trees have been grown to AS2303:2018 guidelines is to be provided upon request of Council's Tree Management

### Above - Ground Assessment.

lowing plant quality assessment criteria should be followed:

Plant true to type, Good vigour and health, free from pest & disease, free from injury, self-supporting, good stem taper, has been pruned correctly, is apically dominant, has even crown symmetry, free from included bark & stem junctions, even trunk position in pot, good stem structure

# Below - Ground Assessment:

Good root division & direction, rootball occupancy, rootball depth, height of crown, non-suckering For further explanation and description of these assessment criteria, refer to AS2303:2019.

All Plant material shall be to the type and size specified. No substitutions of plant material shall be permitted without written prior approval by the Landscape Architect. No plant shall be accepted which does not conform to the standards listed above.

Provide min 3 No. Stakes and ties to all plants identified as trees in the plant schedule. Stakes shall be sound, unpainted, straight hardwood. free of knots and pointed at one end. They shall be 2200mm x 50mm x 50mm Hardwood, or approved alternative. Ties shall be 50mm wide hessian webbing material.

Fertilisers shall be approved slow release fertilisers suitable for the proposed planting types. Note that for native plants, specifically Proteaceae family plants including Grevillea species, low phosphorus fertilizers shall be used.

Mulch shall be an approved equal to "FOREST FINE" as supplied by ANL. Mulch shall be completely free from any soil, weeds, rubbish or other

Turf shall be soft leaf Buffalo or equivalent (unless stated otherwise), free from any weeds and other grasses, and be in a healthy growing

### 3.02 INSTALLATION

All planting set out shall be in strict accordance with the drawings, or as directed. Note that proposed tree planting located near services should be adjusted at this stage. Notify Landscape Architect for inspection for approval prior to planting.

b) Planting
All plant material shall be planted as soon after delivery as possible. Planting holes for trees shall be excavated as detailed and specified. Plant containers shall be removed and discarded, and the outer roots gently teased from the soil mass. Immediately set plant in hole and backfill with specified soil mix, incorporating the approved quantity of fertiliser for each plant type. Ensure that plants are set plumb vertically and root balls set to the consolidated finished grades detailed on the drawings. Compact the backfilled soil and saturate by hand watering to expel any remaining air pockets immediately after planting.

c) Staking and Tying
Staking and tying shall be in strict accordance with the drawings and shall occur immediately following plant placement and soil backfilling. All plants identified as "Trees" on the planting schedule shall be staked with a min. 3 stakes.

Wilch for general planter bed shall be an approved equal to "FOREST FINE" as supplied by ANL. Mulch shall be completely free from any soil, weeds, rubbish or other debris. Mulch for bio-retention/rain garden area where is required shall be non-floatable materials that could include crushed rock, gravel, coarse river sand, scoria or river pebbles. 4-7mm screenings or similar.

Moisten soil prior to the turf being laid. Turf shall be neatly butt jointed and true to grade to finish flush with adjacent surfaces. Incorporate a lawn fertilizer and thoroughly water in. Keep turf moist until roots have taken and sods/rolls cannot be lifted. Keep all traffic off turf until this has occurred. Allow for top dressing of all turf areas. All turf shall be rolled immediately following installation

### Steel edging

Where is required, the Contractor shall install steel edging as detailed on the drawings, to all mass planting beds adjoining turf or gravel mulched areas, and where required. The resultant edge shall be true to line and flush with adjacent surfaces. However, no edging shall be used within the Structural Root Zone (SRZ) of trees to be retained

## Nature Strip and public domain works

The nature strip (street frontage) for the site is public land, and only authorized works may occur here. Existing Conditions such as street trees, council planting etc shall be retained and protected during construction, unless specific approval has been granted for new work in this area. Where council policy specifies a particular unit paver, material finish, pattern or treatment, it shall be the

contractors responsibility to check and verify that this material & treatment is correct and current prior to undertaking construction works

Drainage pits and drainage lines should be located within garden areas to allow for site drainage while minimising impact on the proposed planting scheme, where possible, pits and linework should be located at the edge of landscape strips to avoid precluding planting centrally in garden areas. where pits and linework occur within garden beds, the landscape contractor shall take all precautions to avoid damaging storm water when planting shrubs and trees. landscape contractors shall not alter the form of swales designed to direct overland flow.

### HARDSCAPE WORKS

### 4 01 GENERAL

The Contractor shall undertake the installation of all hardscape works as detailed on the drawing, or where not detailed, by manufacturers

Paving - refer to typical details provided, and applicable Australian Standards. Permeable paving may be used as a suitable means of satisfying Council permeable surface requirements, while providing a useable, hardwearing, practical surface. In most instances, the client

shall nominate the appropriate paving material to be used.

Australian Standards shall be adhered to in relation to all concrete, masonry & metal work. Some details are typical and may vary on site. All hardscape works shall be setout as per the drawings, and inspected and approved by the Landscape Architect prior to installation. All workmanship shall be of the highest standard. Any queries or problems that arise from hardscape variations should be bought to the attention of


### IRRIGATION WORKS

the Landscape Architect.

### 5.01 GENERAL (PERFORMANCE SPECIFICATION)

This is a general Irrigation Performance Specification only, as a guide for projects requiring irrigation systems as part of consent requirements or building contractual arrangements.

An automated irrigation system is recommended for the effective establishment of new gardens, and to assist with the success of planting areas on terraces, over slabs and in Communal Open Spaces.

The inclusion of this general specification is no guarantee that an irrigation system forms part of the landscape scope of works, which will be

New irrigation systems to planting areas shall be a Commercial Grade Irrigation System conforming to all relevant Australian standards, including AS 3500 & the Gas and Electricity (Consumer Safety) Act 2017, Workplace Health & Safety Act 2011, & the latest Sydney Water Code

An automated drip-irrigation system is to be installed to all gardens, planters and lawn areas in accordance with the approved Irrigation Design. This system shall be designed and installed by a qualified and licensed irrigation specialist, to the highest industry standards and to maximise the

<u>Drawings:</u>
- The Landscape Contractor nominated Licensed Irrigation Specialist shall provide irrigation drawings for approval upon engagement.

### Design Requirements:

- The irrigation system shall be installed prior to all planting works. It shall incorporate a commercially available irrigation system, with sub-surface dripper lines to irrigate all gardens, planters and lawn areas.
- It shall incorporate a suitable back flow prevention device for the scale of works, an in-line filter, check valves, and suitable high and low ity poly hose fittings and PVC piping to achieve flow rates suitable for specified planting.

  The irrigation application rate shall not exceed the infiltration rate of the soil or creates run-off.
- The landscape contractor shall check the existing pressure available from the ring mains and size irrigation piping to suit. Supply shall be from local hose cock where availab
- All piping and fittings shall be buried 50mm below the finished soil levels in garden and lawn areas, and secured in position at 500mm centres with galv wire pins
- Size of pipes shall be selected to ensure the working pressure at the end of the line does not decrease by more than 5%

Co-ordination required by Landscape Contractor or Project Manager to provide required conduit, pipe work and penetration through slabs and planter walls for water and power provisions

The Landscape Contractor shall be engaged with the Irrigation Specialist to co-ordinate with the Project Manager to identify the preferred

Project Manager and Landscape Contractor to establish area suitable for irrigation control system with required area, power provision and

### Testing & Defects:

Upon completion of installation, the system shall be tested, including:

- Main Line Pressure Test: The main line is pressurised to test for leaks. All valves are shut and the pressure is taken over a determined

Dripper Pressure Test: Measurement at flushing valves are taken and the pressure gauged to make sure it conforms to the manufacture recommendations. The inlet pressure is then tested under the same conditions to check it does not exceed 300Kpa.

- All components are to be satisfactorily functional and operational prior to approval. Should any defect develop, or the capacity or efficiency of the system decline during the agreed maintenance system, then these faults shall be immediately rectified.

Warranty:
- A full 12 month warranty shall be included to cover labour and all parts.

Further Documentation:
- On request, a detailed irrigation performance specification report can be issued

### CONSOLIDATION AND MAINTENANCE

### 6.01 GENERAL

The consolidation and maintenance period shall be either

6 months beginning from the approved completion of the specified construction work (Practical Completion)

as agreed to in the landscape contractors contractual obligations

or as specified by Council in the Determination.

A qualified landscape maintenance contractor shall undertake the required landscape maintenance works. Consolidation and maintenance shall mean the care and maintenance of Contracted works by accepted landscaping or horticultural practices, ensuring that all plants are in optimum growing conditions and appearance at all times, as well as rectifying any defects that become apparent in the contracted works

This shall include, but not be limited to, the following items where and as required:

- Watering all planting and lawn areas / irrigation maintenanc Clearing litter and other debris from landscaped areas.
- Removing weeds, pruning and general plant maintenance
- Replacement of damaged, stolen or unhealthy plants Make good areas of soil subsidence or erosion
- Topping up of mulched areas.
- Spray / treatment for Insect and disease control. Fertilizing with approved fertilizers at correct rates
- Mowing lawns & trimming edges each 14 days in summer or 18 days in winter
- Maintenance of all paving, retaining and hardscape elements

On the completion of the maintenance period, the landscape works shall be inspected and at the satisfaction of the superintendent or landscape architect, the responsibility will be signed over to the client.

## General Notes:

# Copyright Sulphurcrest Enterprises Pty Ltd Trading as CONZEPT (ABN: 75 623 405 630)







SCALE:

REV DATE NOTATION/AMENDMENT NORTHERN BEACHES A 11.8.2023 Preliminary plan prepared for review B 18.9.2023 Coordinated with architectural updates C 22.9.2023 Final submission for DA KALLOGHLIAN INVESTMENTS PTY LTD D | 22.3.2024 | Co-ordinated with amended architectural plan E 25.3.2024 Co-ordinated with architect's comments **BJB ARCHITECTS** DA - ISSUE E



CAMMERAY NSW 2062 Phone: 9922 5312 Fax: 8209 4982 Mob: 0413 861 351

DEVELOPMENT 15 OCEAN ROAD

**SPECIFICATION** PROPOSED RESIDENTIAL PALM BEACH

LPDA 24 - 029 / 6 MARCH 2024 L.Z/K.Z RF