





How to read this plan	Acronyms 14 Acconyms 14 Author: coulir Subject: Sticky Note Date: 16/01/2020 1/43/38 PM Add acronyms: - ALIA: Australian Library Information Association - DCP: Development Control Plan - DPI Fisheries: Department of Primary Industries - Fisheries - PA: NSW Environment Protection Authority - IEP: Local Environment Protection Authority - IEP: Local Environment Protection Authority - IEP: Local Environment Protection Authority - SUB-ID: Northerm Sydney Local Health District - NSW RFS: NSW Rural Fire Service - SLSC: Surf Life Saving Clubs - Subject: Highlight Date: 11/02/2020 11:27:13 AM Delete text - Delete text - Delete text - Delete text


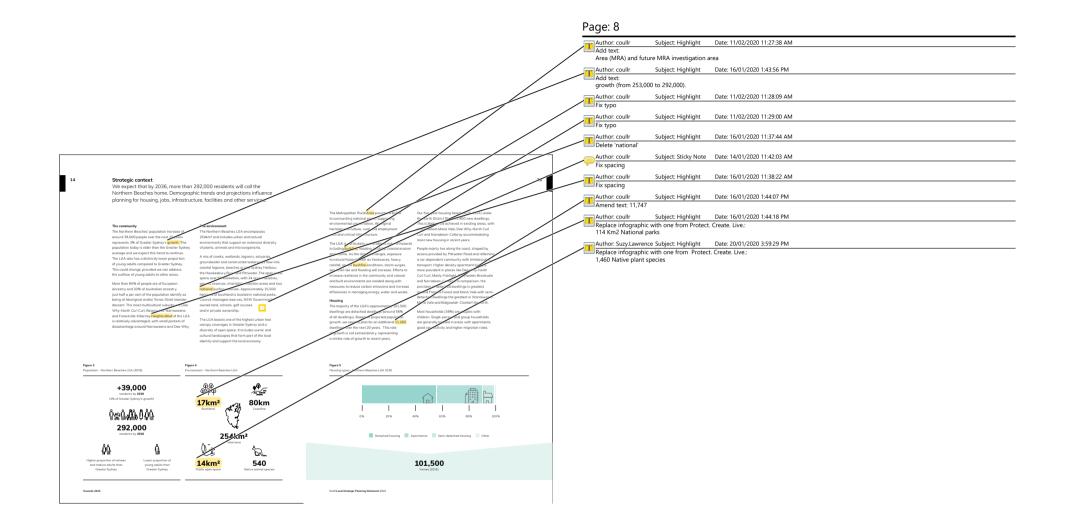


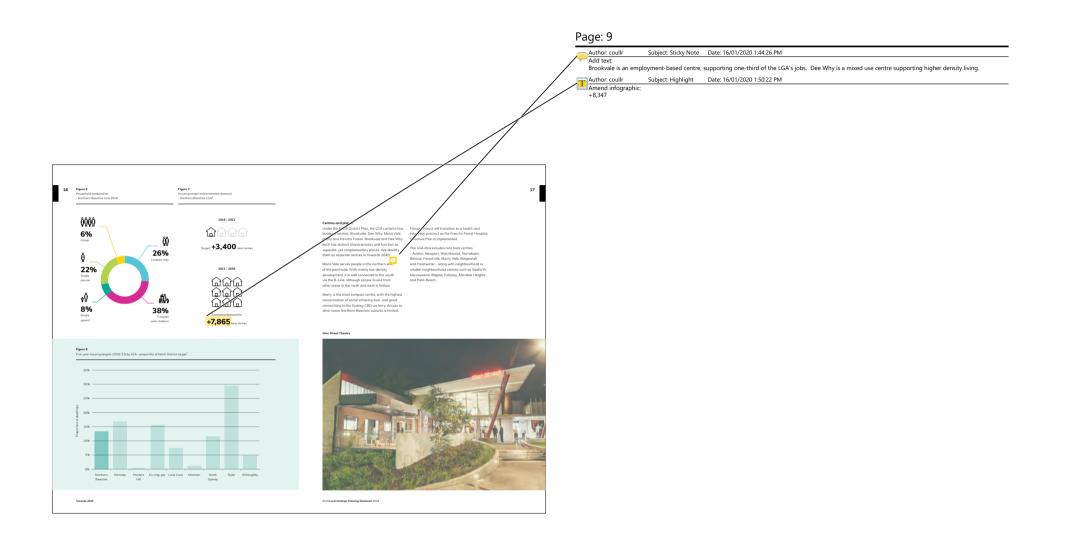


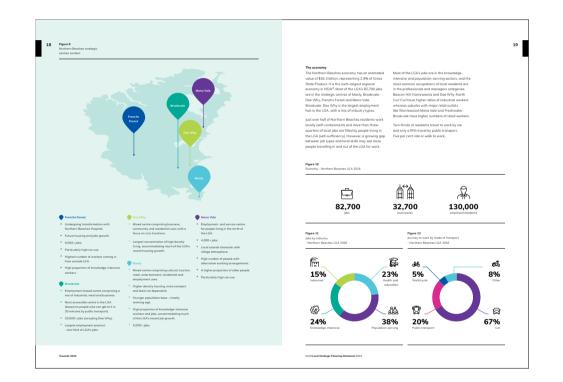





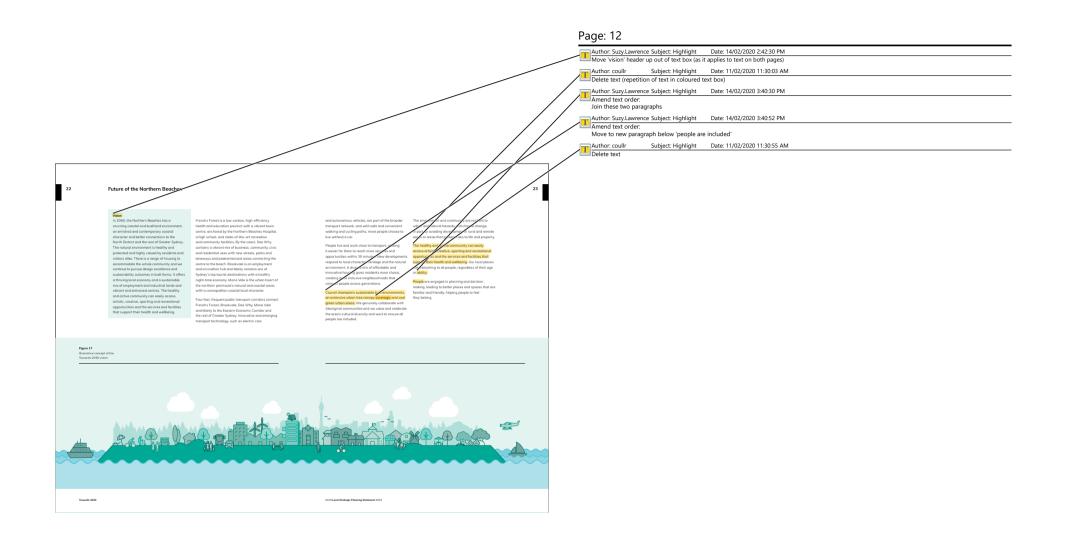


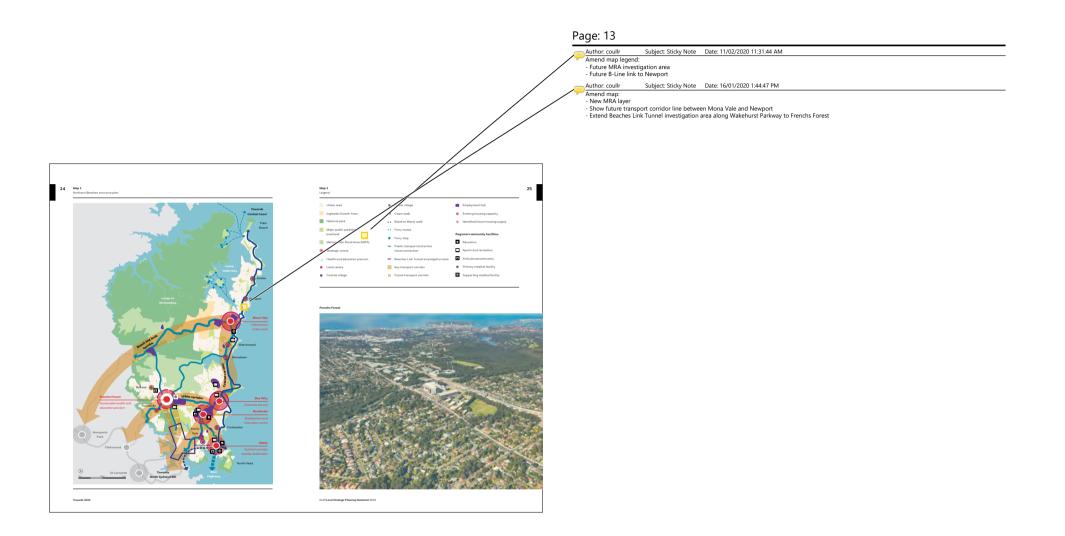

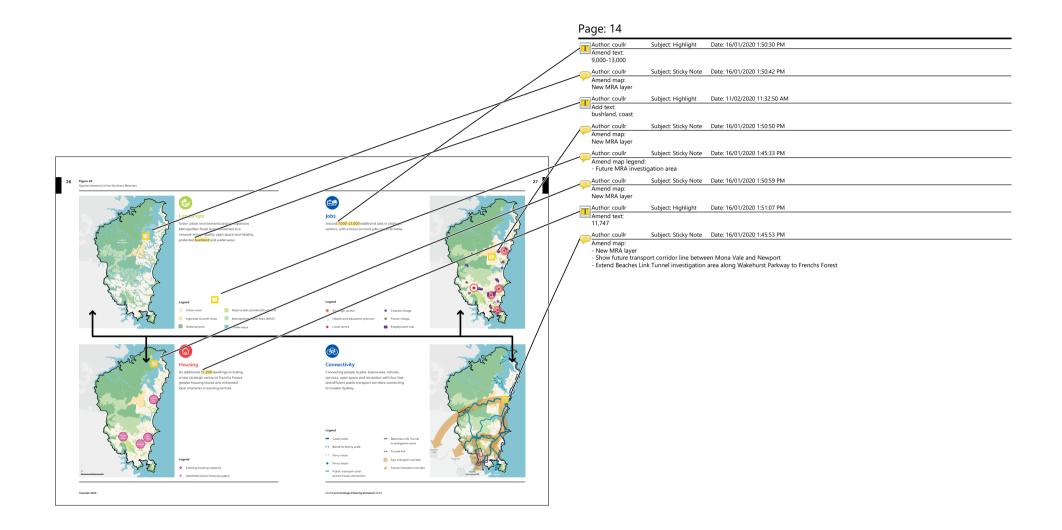

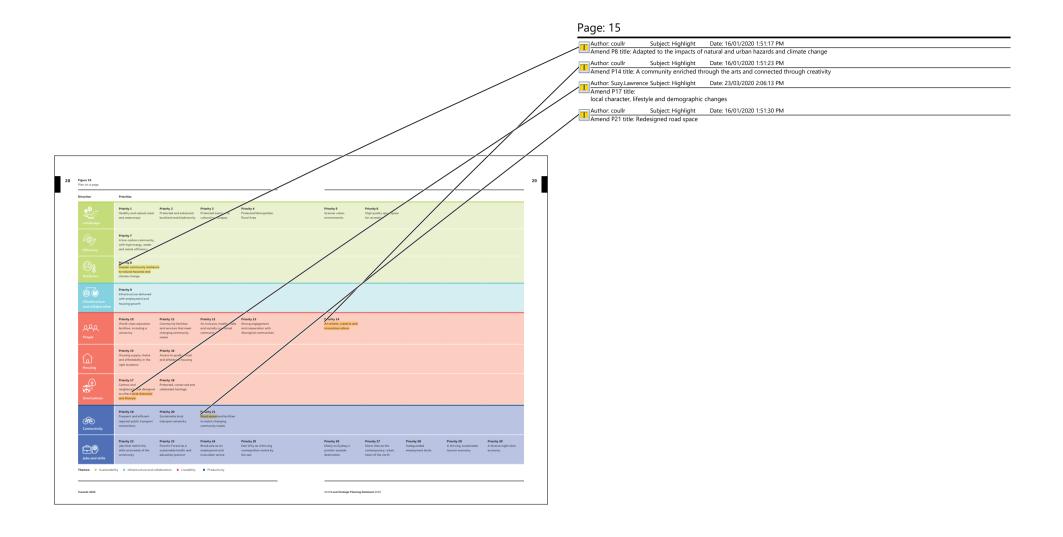


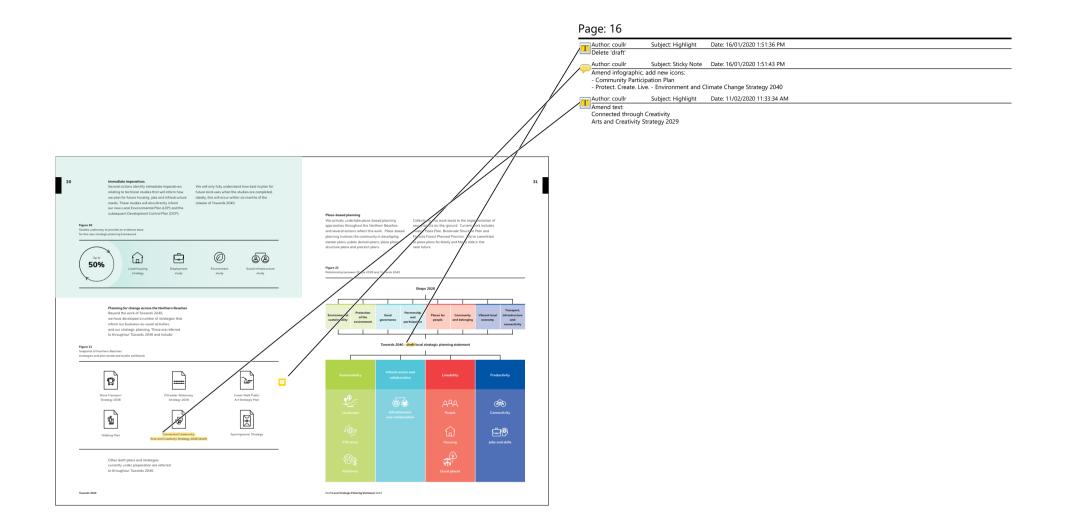

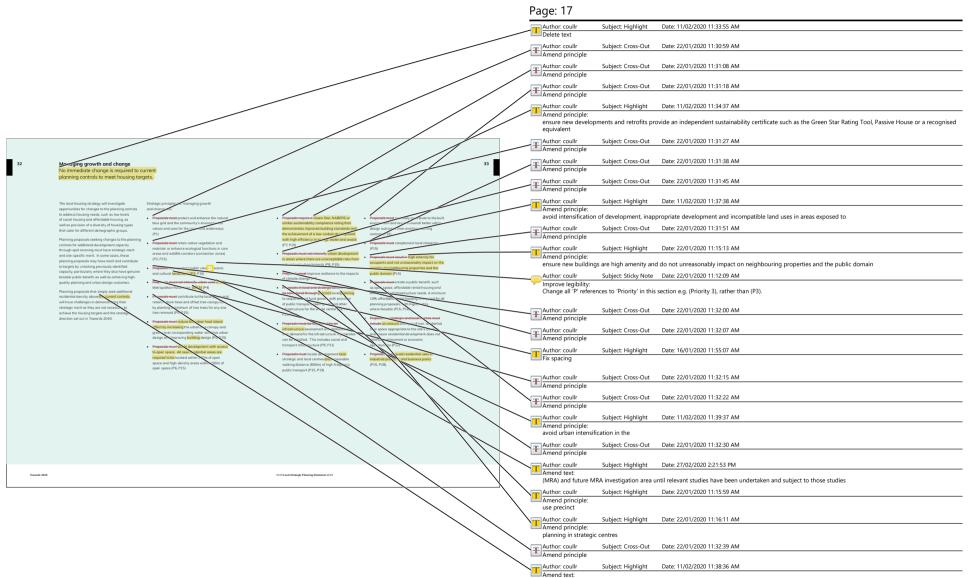



that identified in the local housing strategy


Comments from page 17 continued on next page

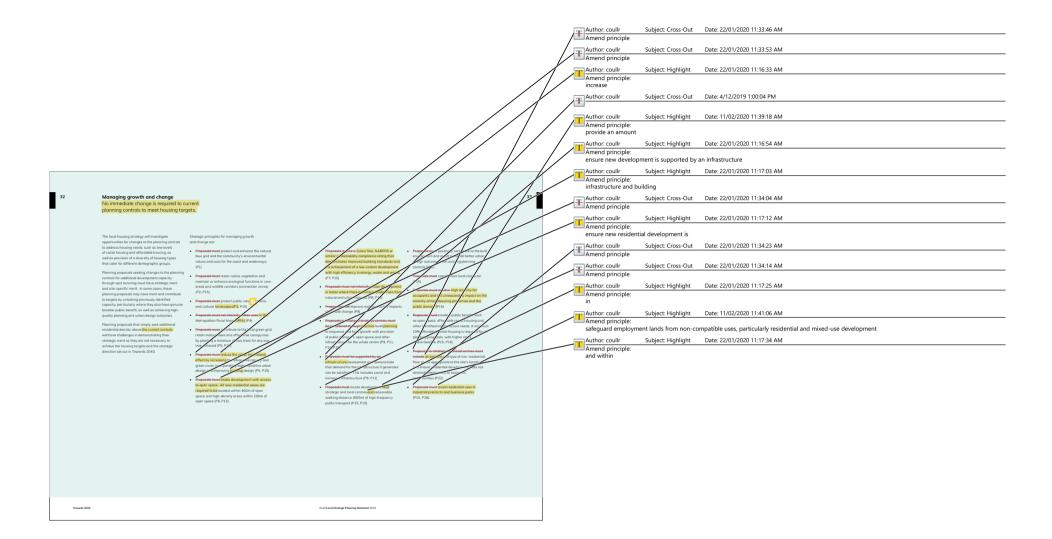





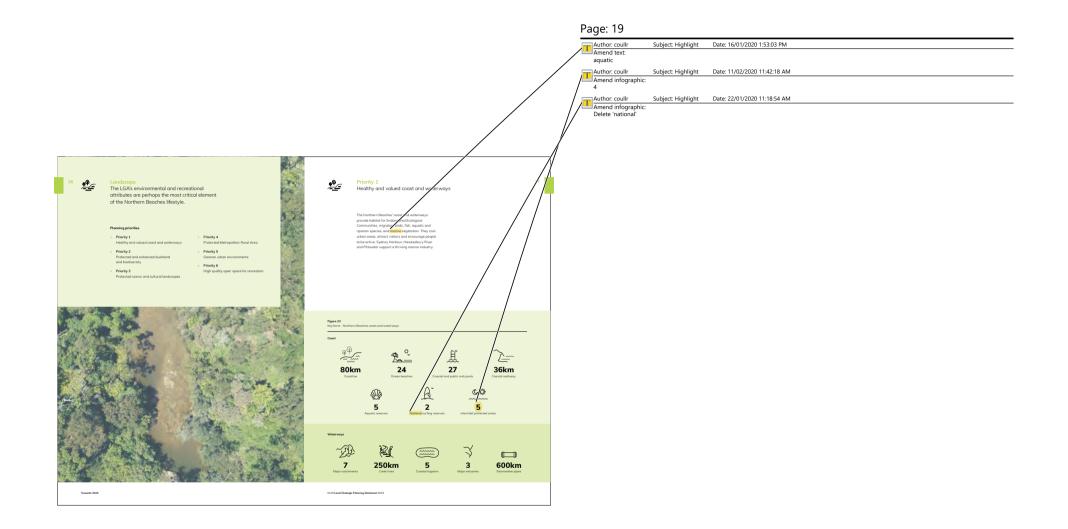

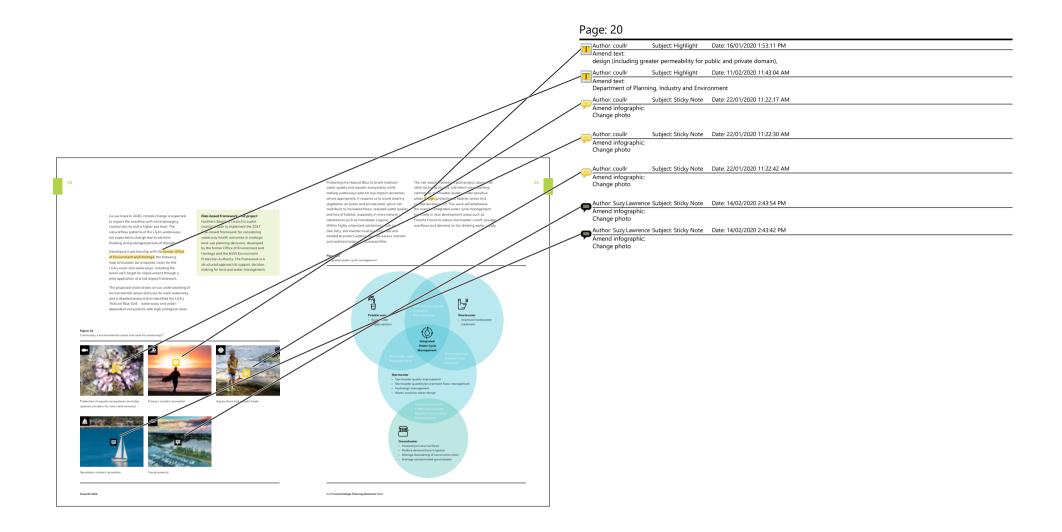

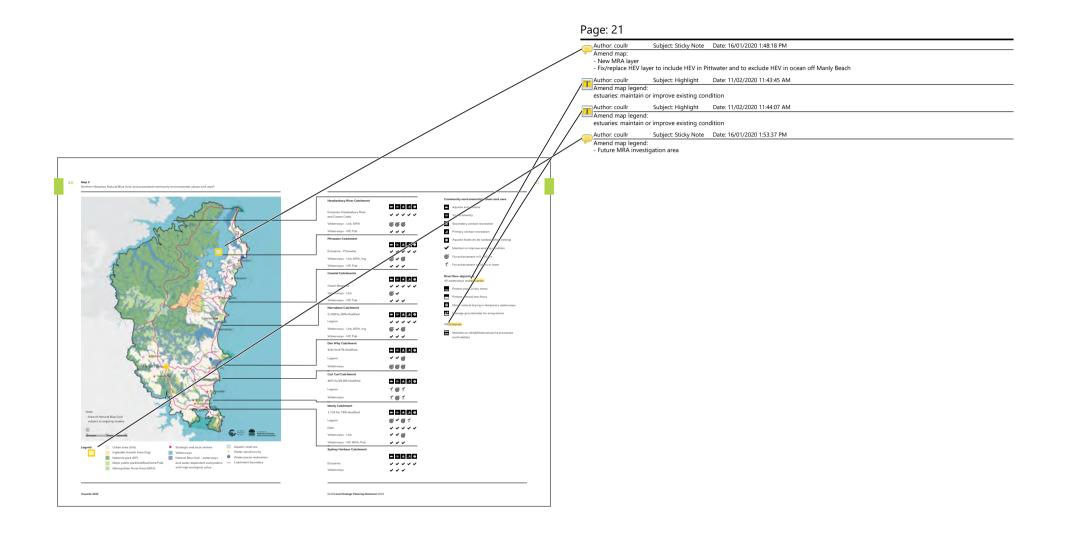

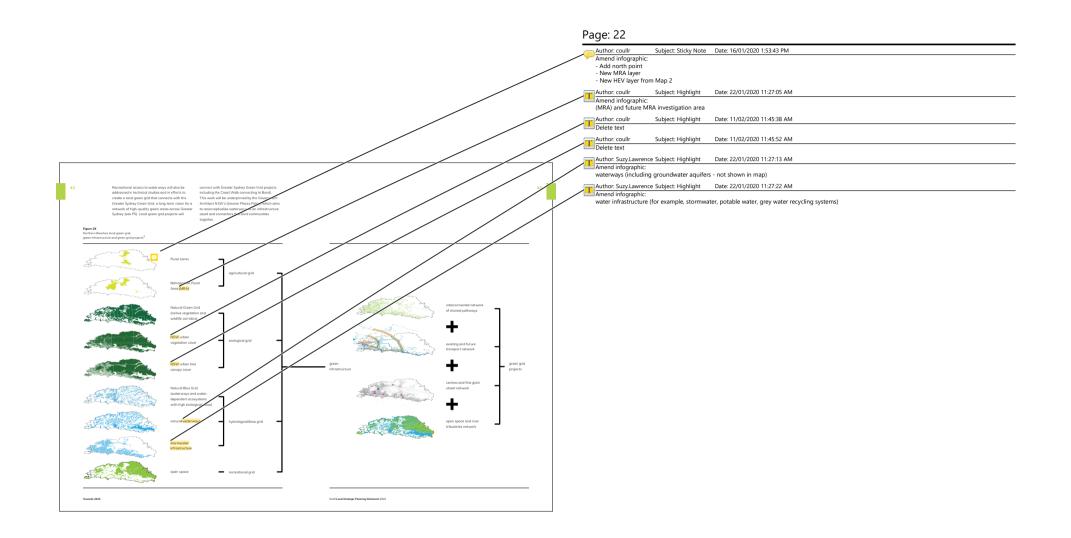


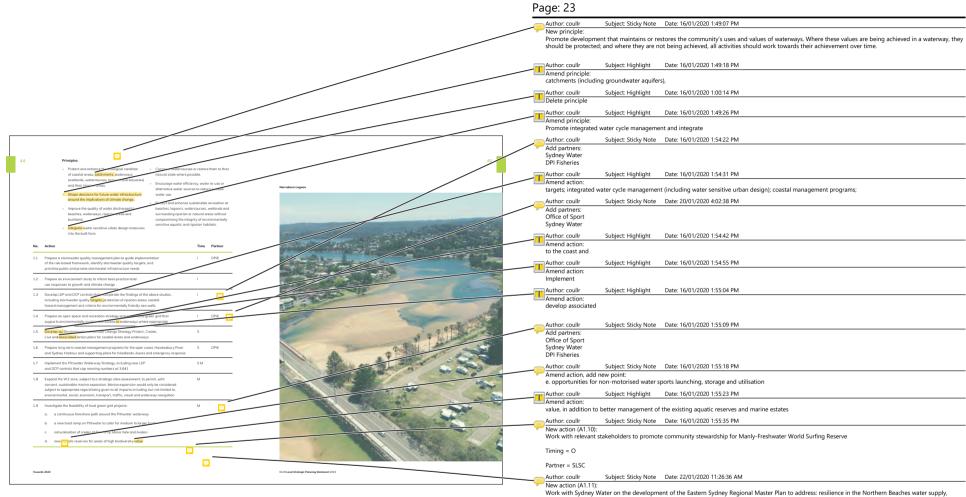



Work with Sydney Water on the development of the Eastern Sydney Regional Master Plan to address: resilience in the Northern Beaches water supply, requirements for new and upgraded infrastructure, wet weather overflows in priority catchments, outflows from Warriewood and North Head Wastewater Treatment Plants, opportunities for recycled water, and environmental assessment processes and outcomes


Time = S


Partners = Sydney Water

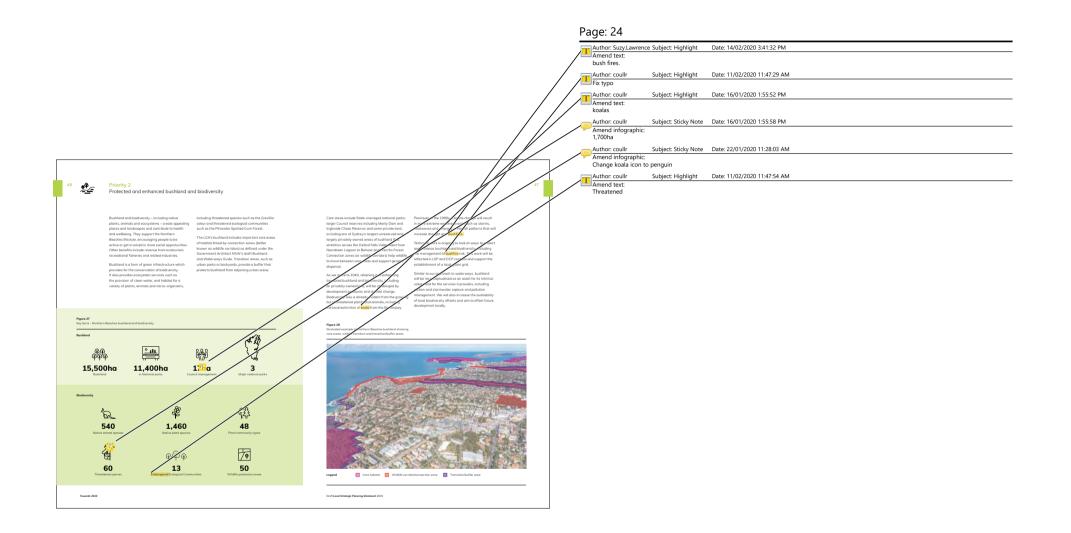


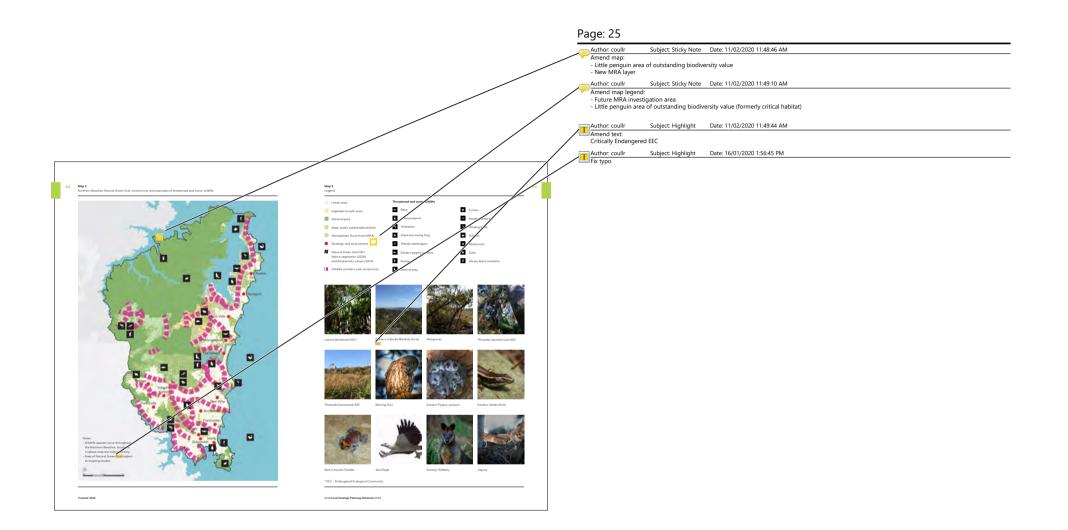


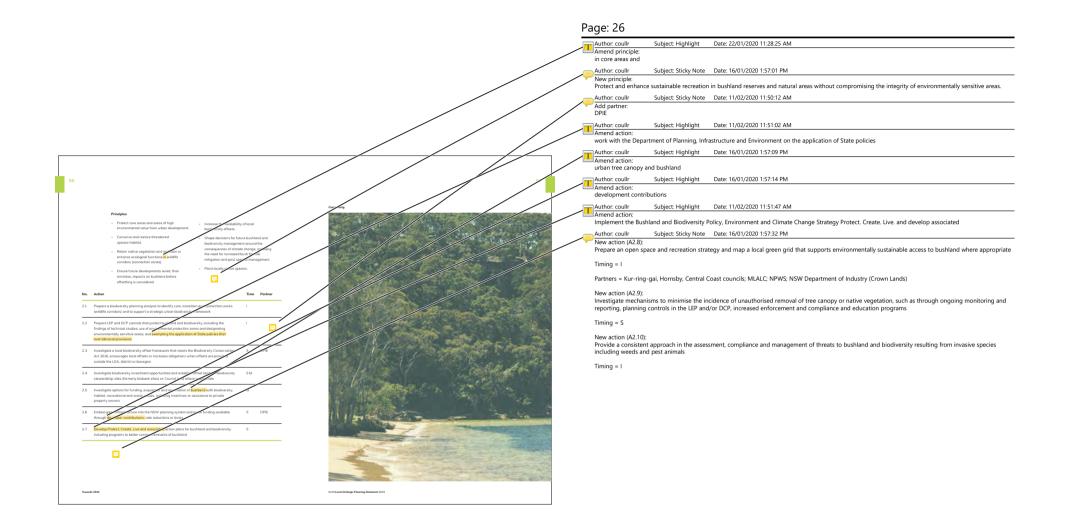

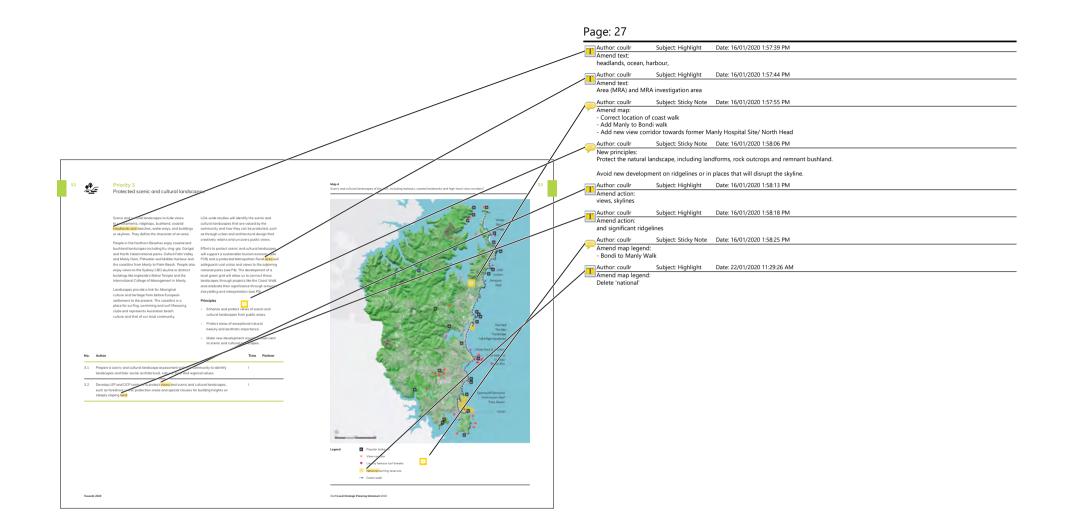

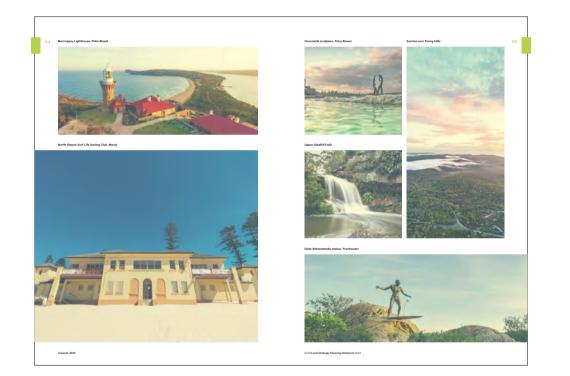

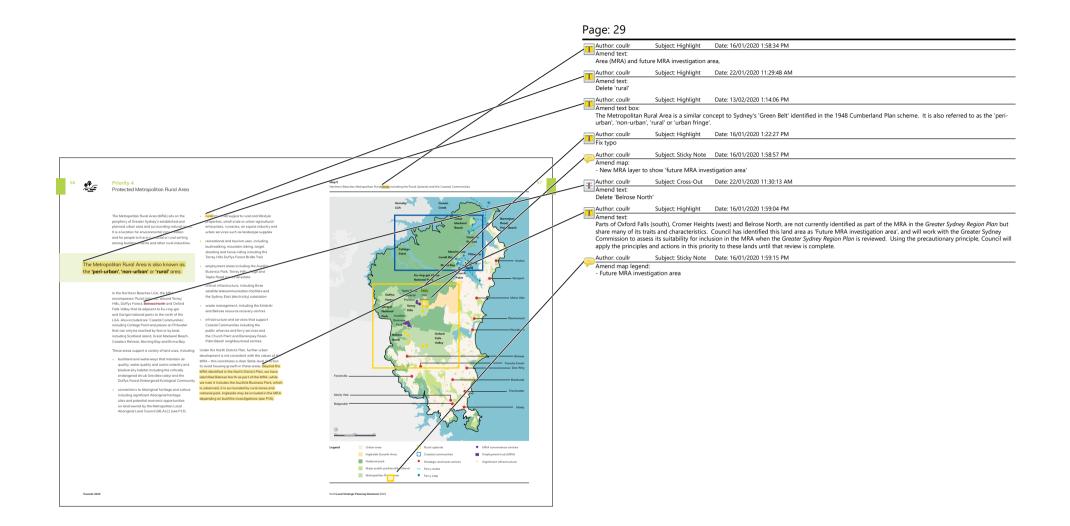

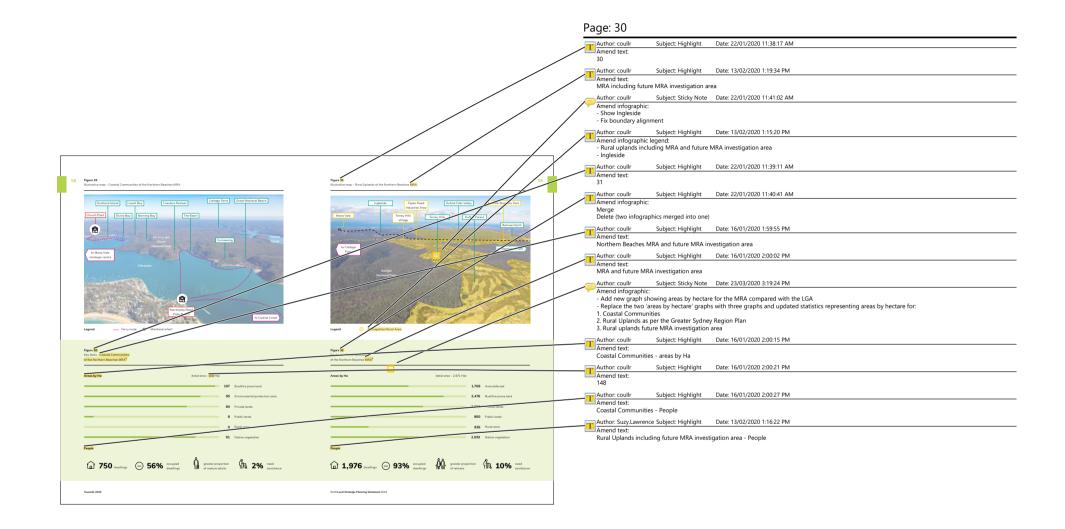

		Page: 31
		Author: coullr Subject: Sticky Note Date: 22/01/2020 10:10:09 AM
		Add text
		The majority of land within the MRA and future MRA investigation area is either bush fire prone or surrounded by bush fire prone land. Protection of human life and property from bush fire is a major planning concern for the area.
		man Author: coullr Subject: Highlight Date: 11/02/2020 11:57:42 AM
		Add text: other sustainable
		Author. coullr Subject: Highlight Date: 16/01/2020 2:00:43 PM Amend principle:
		MRA and future MRA investigation area.
		Author: coullr Subject: Sticky Note Date: 16/01/2020 2:00:49 PM
		Encourage the spread of indigenous vegetation and tree canopy.
		Author: coullr Subject: Highlight Date: 16/01/2020 2:00:56 PM
60	61	MRA and future MRA investigation area.
		Author: coullr Subject: Highlight Date: 16/01/2020 2:01:06 PM Amend principle: Subject: Subject: S
		Support establishment of local biodiversity offset sites and stewardship agreements.
Not all properties within the Analysis of the land owned by the MLALC, we will be to reticulated water of sewage; improvements guided by the principles established in the	Principles Principles Protect biodiversity values for riparian corridors Limit developmen a scale find density	Author: coullr Subject: Sticky Note Date: 22/01/2020 11:51:42 AM
to setter this, connections to water or sever Aboriginal Lond Rights Act 1983 to wark with an additional setter and the MLALC, surrounding landowstas and the environmental impacts. Coasta communities	and areas that support threatened species, consistent with sub-strg charge er and use.	Ensure development is not intensified in areas where there is unacceptable risk to human life and property from hazards such as bush fire.
rely on areas outside their communities for goods, community and retail services and waste use of the land by Aboriginal people (see P13).	identified for biodiversity connectivity.	Author: coullr Subject: Highlight Date: 16/01/2020 2:10:39 PM
removal. While these issues are managed now, sustainable solutions are required, especially	Support sutainable primary (nd. r) particularly load producting and prevent incompatible-rid uses tourism active rest on the tests	Amend text box: (WLEP 2000) deferred from inclusion in the Warringah Local Environmental Plan 2011 Standard Instrument LEP.
Environmental attributes an public lands Oxford Falis Valley and Beirose North are are mostly protected from development, yet subject to diversite and/or as they are still subject to diversite and/or to they are	Support <u>Instance</u> - provide adequate public open spectrum Provide adequate public open spectrum recovering and activities to gradie unsutandele pressure on national p pressure on national p	The future zoning of this land will be determined following the completion of a range of studies currently underway and following consultation with the community as part of the Northern Beaches LEP.
conservation on private land remains a challenge. Opportunities to prefect and enhance the Winterpart MRA's environmental attributes include: Baticate Anthon Strategy and Baticate Anthon Strategy and Anthon Strategy and Anthon Strategy Anthony Manual attributes include:	No. Action Time Partner	Author: coullr Subject: Highlight Date: 11/02/2020 11:58:23 AM
 preventing further lot fragmentation which may constrain long-term opportunities the majority of this area be zoned for 	4.1 Use the employment study, social infrastructure and open space study, environment study. S biodiversity planning analysis, stormwater quality strategy, open space and recreation	Amend action: Delete text
for conservation (with smaller lats environmental protection, with smaller creating barriers to consolidation) areas dedicated to either rural or residential	strategy and destination management plan to inform place-based planning in the MRA	real Author: coullr Subject: Highlight Date: 16/01/2020 2:10:45 PM
using biodiversity offsets, other funding incertives and stewardship agreements	4.2 Develop LEP and DCP controls, <u>constructing constructions from the draft planning</u> 1 proposit for the deterned lands of Oxford Falls Valley and Behave: <u>set of constructions for the deterned</u> for the land use conflicts that components the rurgle and environmentary basis and having	Amend action: MRA and future MRA investigation area
for environmental projects	regard for the outcomes of the housing.	-
 revegetating streams, planting trees and improving habitat, biodiversity and emently 	4.3 Int-state commercially and environmentally flociable proposed — anergy, M	Author: coullr Subject: Highlight Date: 22/01/2020 11:51:55 AM Amend action:
 drawing on privately-initiated actions or targeted incentives such as Landcare grants, voluntarieng or other environmental funds 	Landowners	
 setting appropriate land use rules and 	4.4 Photothe inoppropriate applicant of State policies that allow urban intensification 5 of the Min. such as site compatibility certain tees for seniors housing	Author: coullr Subject: Highlight Date: 16/01/2020 2:10:52 PM
regulations to manage development.	4.5 identify opportunities for its extent as outlined in P6 S NPE	values of the MRA and future MRA investigation area
		Author: coullr Subject: Highlight Date: 16/01/2020 2:10:59 PM
		Amend action: employment, local character
		Author: coullr Subject: Highlight Date: 16/01/2020 2:11:04 PM Amend action:
		studies, and identified environmental hazards and constraints
		Author: coullr Subject: Highlight Date: 16/01/2020 2:11:12 PM Amend action:
		Investigate sustainable solutions for energy, water and sewerage infrastructure improvements for unconnected areas
	$\langle \langle \rangle \rangle$	Author: coullr Subject: Highlight Date: 11/02/2020 11:59:02 AM
Tourish 2000	Duti Laad Boongel Planong Bannand 2023	Amend action: Work with the Department of Planning, Infrastructure and Environment on the application of relevant State policies that allow urban intensification of the MRA and future MRA investigation area, by developing a local approach to the provision of seniors housing, boarding houses and medium density housing based on evidence in the local housing strategy
		Author: coullr Subject: Highlight Date: 16/01/2020 2:11:29 PM
		Amend action: recreation, for example, with Outdoor NSW and the Office of Sport and as
		Author: coullr Subject: Highlight Date: 16/01/2020 2:11:36 PM
		Add partner. Office of Sport
		Author: coullr Subject: Sticky Note Date: 14/02/2020 2:45:26 PM

Comments from page 31 continued on next page

Time = S


Partner = GSC, DPIE

New action (A4.7):

Work with the MLACC to better understand constraints as well as feasible and appropriate land use opportunities on land owned by the MLALC Time = S M

Partner = DPIE, MLALC, NSWALC

60 61 -Comparison of the second secon Principles Protect blodiversity values for riparian corridors and areas that support threatened species, communities and populations and an lands identifiad to biodiversity connectivity. Avoid urban intensification and subdivision in the MRA. Support sustainable primary industry, particularly food production, and prevent incompatible land uses. Conserve a hhance the scenic amenity, tourism and recreation values of the MRA. Environmental attributes on public lands are mostly protected from development, yet conservation on private land remains a challenge. Opportunities to protect and enhance the MRA's environmental attributes include: No. Action Time Partner preventing further lot fragmentation which may constrain long-term opportunities for conservation (with smaller lots 4.1 Use the employment study, social infrastructure and open space study, environment study. S biodiversity planning analysis, stormwoster quality strategy open space and recreation strategy and destination management plan to inform place-based planning in the MRA areas dedicated to either rural or residential creating barriers to consolidation) 4.2 Develop LEP and DCP controls, <u>considering recommendations from the draft planning proposal for the determal lanks of Doked Falls Valley and Belose Narth, oddressing land use conflicts that compremise the rural and environment avguing, and having regard for the outcomes of the housing, <u>amployment</u> and environment <u>studies</u>.</u> zones (large lot or low density housing). using biodiversity offsets, other funding incentives and stewardship agreements for environmental projects revegetating streams, planting trees and improving habitat, biodiversity and amenity 4.3 Investigate commercially and environmentally feasible proposals for energy, water and severage infrastructure improvements for unconnected areas M Ausgrid, Sydney Water, Landowners · drawing on privately initiated actions or targeted incentives such as Landcare grants, volunteering or other environmental funds Prevent the inoppropriate application of State policies that allow whon intensification S DPIE
of the MRA, such as site compatibility certificates for seniors housing setting appropriate land use rules and regulations to manage development. 4.5 Identify opportunities for recreation as outlined in P6 S DPIE -Towards 2040 Droft Local Strategic Planning Statement 2019

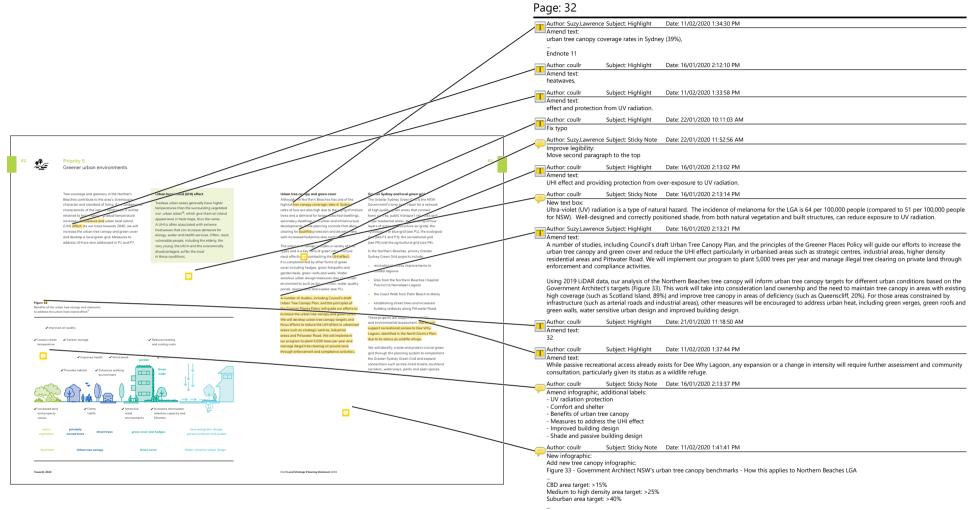

Endnote 12

- Based on international and national best practice precedents

- Urban residential (medium to high density) and light commercial areas

Notes:


- Council will consider higher targets to maintain areas of existing high tree canopy coverage including some residential areas as well as rural and environmental living zones


- Meeting the above targets will contribute to the 40% urban tree canopy target for metropolitan Sydney (currently 21%).

... Endnote 11


Comments from page 32 continued on next page


Status coullr None16/01/2020 9:28:48 AM

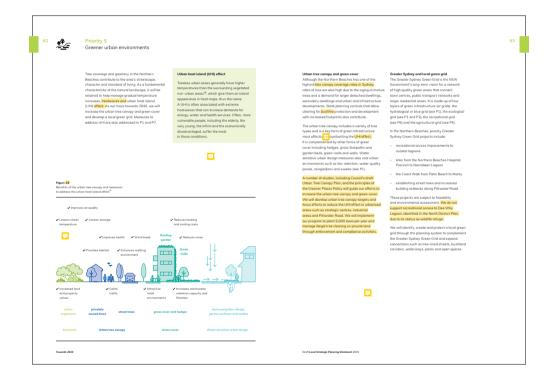


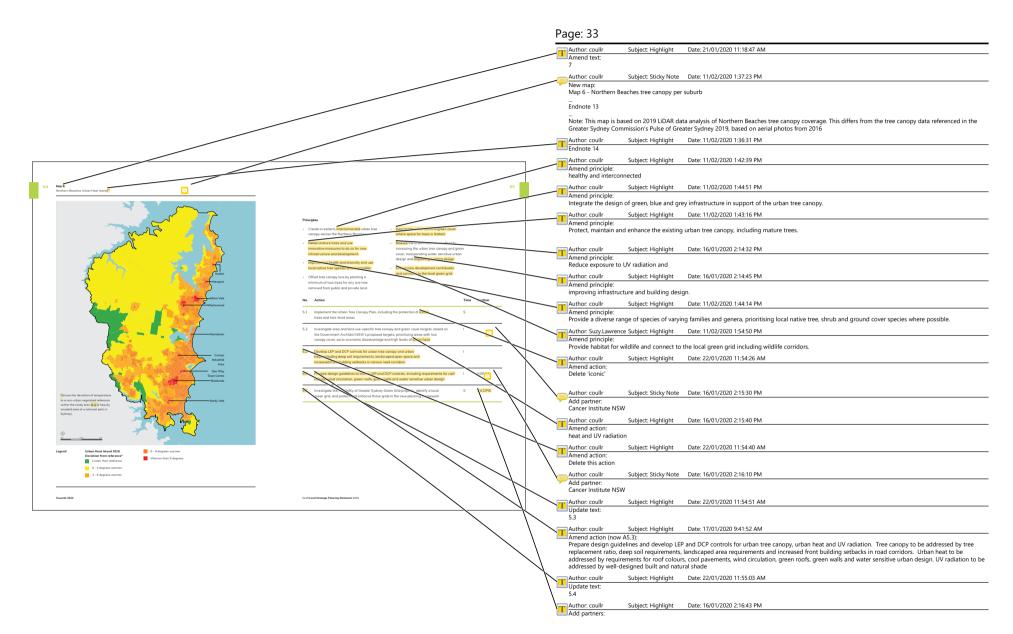


Comments from page 33 continued on next page

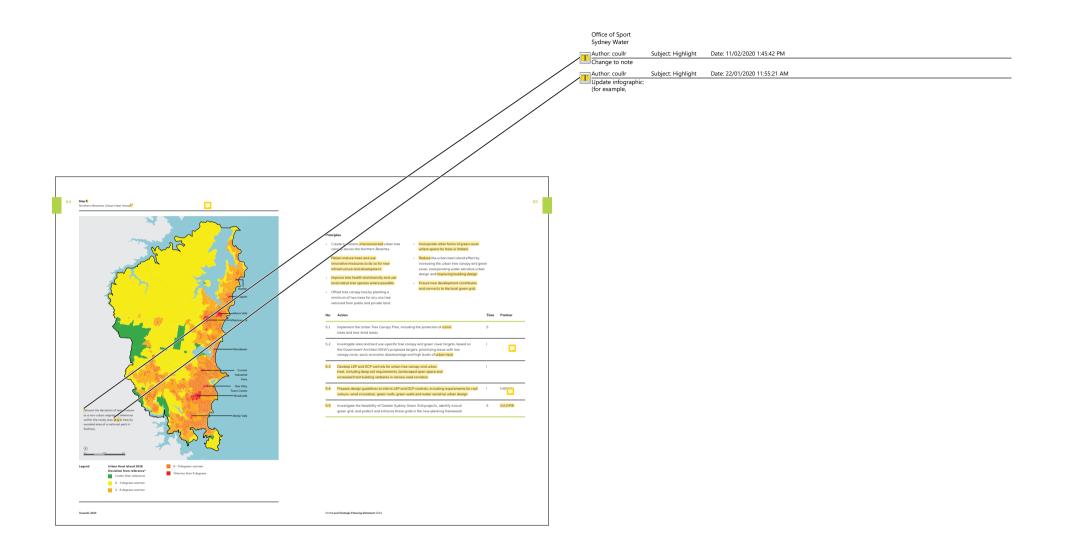

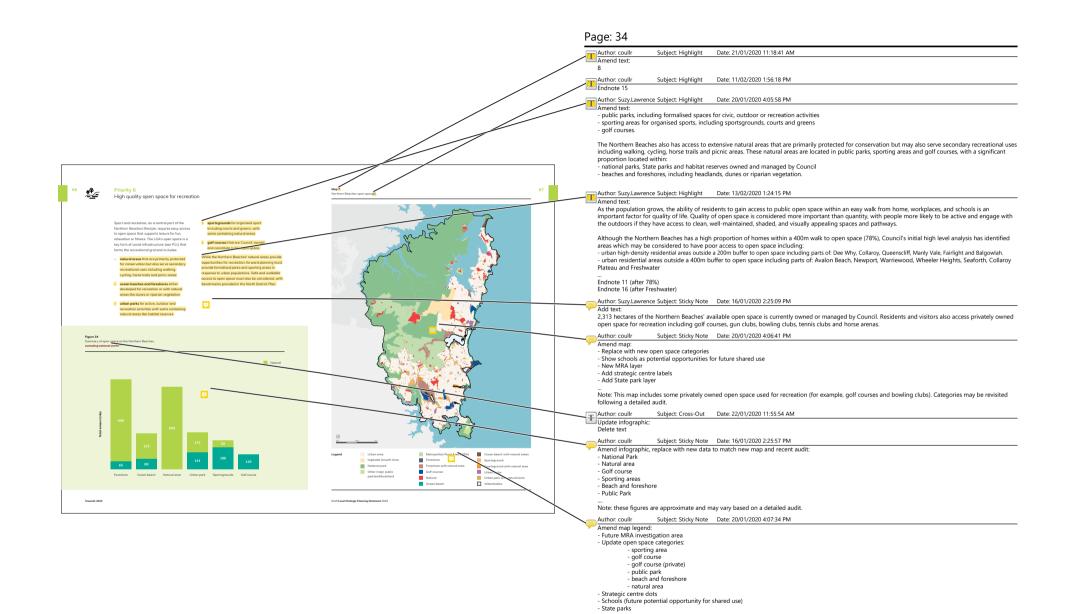

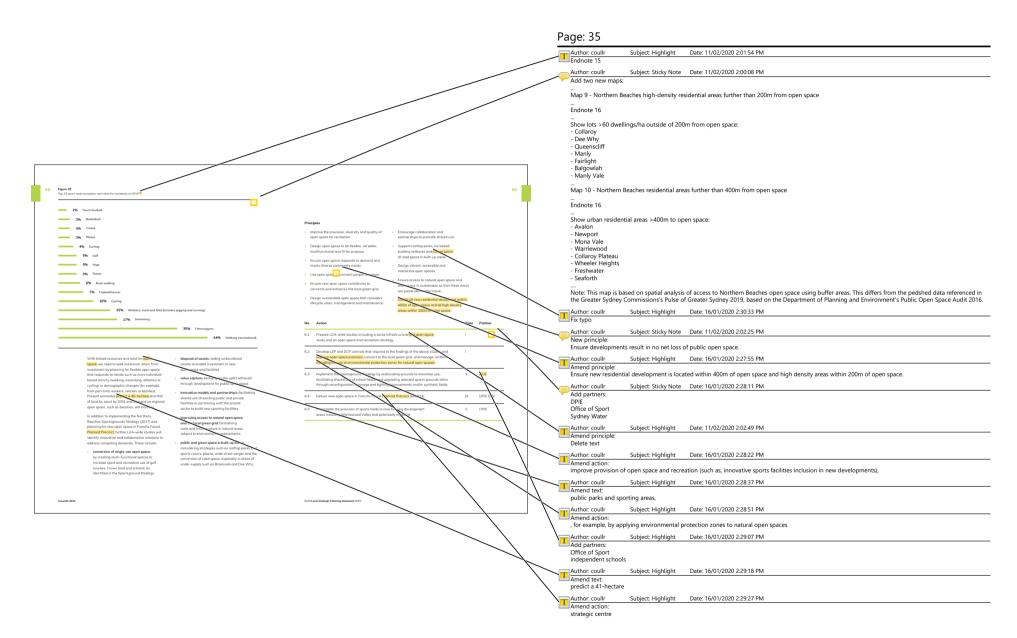

Comments from page 35 continued on next page

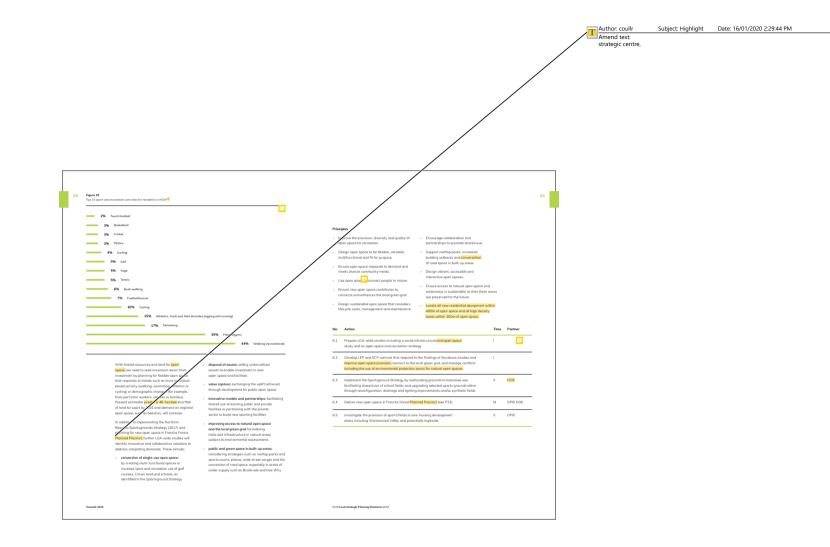



Page: 36

Subject: Highlight Date: 11/02/2020 2:03:23 PM Author: coullr

Endnote 17

Author: coullr Endnote 17

> Author: coullr Subject: Sticky Note Date: 22/01/2020 10:11:45 AM

Add new infographic: Figure 36 - Northern Beaches Council resource use aspirations and commitments

Subject: Highlight Date: 11/02/2020 2:03:44 PM

2021

Sustainability certification for new developments in strategic centres, employment hubs and areas subject to urban intensification (for example, Green Star Rating Tool, Passive House or recognised equivalent) (T)

2030


All suitable sites powered by renewable energy (C) New zero carbon emissions (A) All new buildings being net zero emissions (A) 50% of suitable premises with solar panels installed (C)


.... 2040 60% reduction carbon emissions (C) 10% reduction in drinking water use (C) 85% diversion of waste from landfill (C) 90% recycling of construction waste (C) >50% reduction of carbon emissions (C)
 85% diversion of waste from landfill (C) Maintaining or reducing overall drinking water use in our community (C) Reducing the rate of waste generation per person (C) Reduction single use plastics (C)


... 2045 Net zero emissions (C)

2050 Net zero emissions (C)

.... Legend: Council operations Community A = Protect. Create. Live aspiration C = Protect. Create. Live. commitment T = Towards 2040 LEP and DCP action

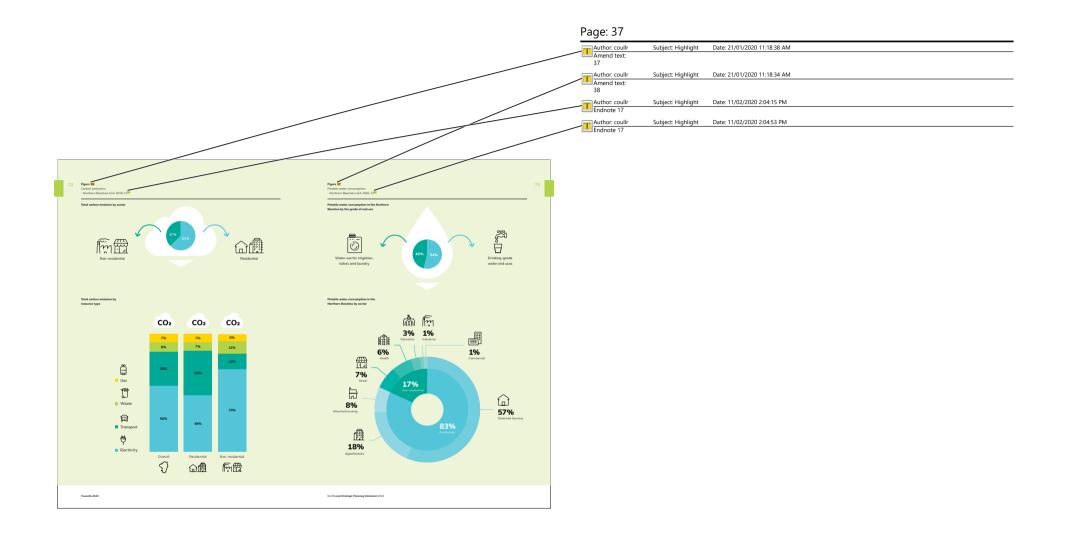

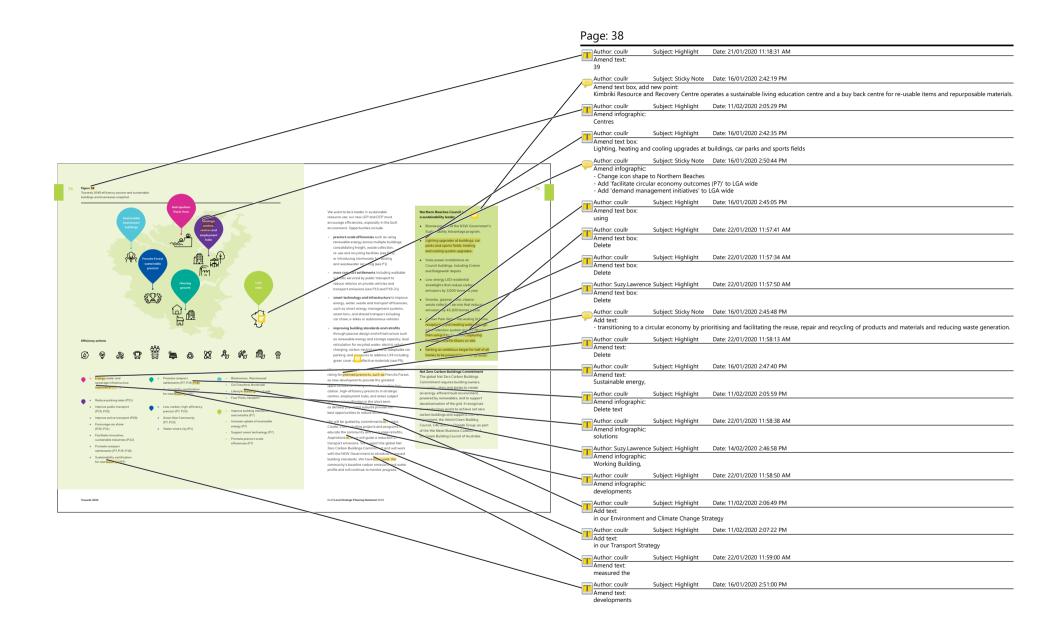

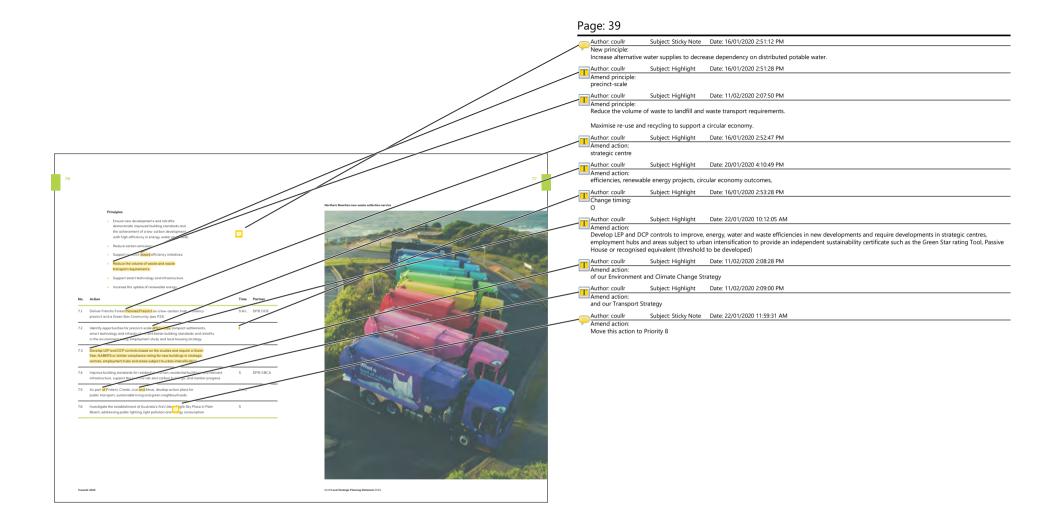


	Page: 40
	Author: coullr Subject: Highlight Date: 16/01/2020 2:55:21 PM
	Amend text: Adaptation to natural and urban hazards is becoming increasingly important as the climate changes and the population grows.
	men Author: coullr Subject: Highlight Date: 16/01/2020 2:55:34 PM
	Amend P8 title:
	Adapted to the impacts of natural and urban hazards and climate change
	Author: coullr Subject: Highlight Date: 11/02/2020 2:13:23 PM
	Author: coullr Subject: Highlight Date: 16/01/2020 2:55:44 PM
	Amend text: natural and urban
	Author: coullr Subject: Highlight Date: 16/01/2020 2:55:56 PM
	Amend text:
	on compliance and enforcement,
	Author: coullr Subject: Highlight Date: 22/01/2020 10:12:50 AM
78 We Becoming increasingly important	Author: coullr Subject: Highlight Date: 16/01/2020 2:56:07 PM
is declining indexingly inportant.	Amend P8 title:
	Adapted to the impacts of natural and urban hazards and climate change

and the advocation of residence importance. A many structure large structure l	Author: coullr Subject: Sticky Note Date: 14/02/2020 3:42:14 PM
haads with provementation on the approximation of t	Adulto: couli Subject Sucky Note Date: 14/02/2020 S42: 14 PM
more frequent and more intervity. Type users as a low and the second sec	A growing population will increasingly be exposed to urban hazards that result from past and present urban development activities, such as water, noise and air pollution as well as soil and groundwater contamination. These hazards are heavily influenced by land use, with major road corridors linked to air and
priprine see antinuo se	noise pollution, industrial areas posing risk of stormwater contamination and residential areas contributing to smoke pollution, especially in winter. In the
built suitance on Rev and return days of the suitance of Rev and return days of the suitance of Rev and Article States of Rev and States	Metropolitan Rural Area, on-site wastewater systems are located in close proximity to natural waterways.
and assesses.	Declaration of Climate Emergency Northern Beaches Council resolved on 27 August 2019 to join over 900 jurisdictions worldwide, including 35 Australian councils, and declare a state of
The revi LP and CP will know the know the second seco	Climate Emergency that requires immediate action by all levels of government.
environment to fastar consected on dustativate environment to fastar consected on dustativate environment to fastar consected on dustativate Environment environment environment environment Bergen environ	Author: coullr Subject: Highlight Date: 11/02/2020 2:10:57 PM
Be for an use of the second part	Add text: Our Environment and Climate Change Strategy, Protect
attaka and and any attacka	Author: coullr Subject: Sticky Note Date: 16/01/2020 2:56:37 PM
with the programmer of Promotion	Add text: We undertake proactive inspections, education programs and environmental auditing to ensure all reasonable and practicable measures are taken to
Antraid a meny projects sociates	We intertake proceeding appendix a bucklishing of the another than a second processing to ensure the proceeding in the another to minimise the generation of air and noise pollution and solid and groundwater contamination and its discharge into the environment.
	Author: coullr Subject: Highlight Date: 22/01/2020 12:00:38 PM
	Delete
	Author: coullr Subject: Highlight Date: 22/01/2020 12:00:48 PM
Best Month	Amend text box: Delete
	Author: coullr Subject: Highlight Date: 16/01/2020 2:57:00 PM
	Amend text:
haven 2001 Dutilized Dating Planing Namase 2021	and urban hazards
	Author: SuzyLawrence Subject: Highlight Date: 16/01/2020 2:57:11 PM
	chronic stresses and acute shocks
	Author: SuzyLawrence Subject: Sticky Note Date: 14/02/2020 2:49:00 PM Update image
$\langle \cdot \rangle$	Author: coullr Subject: Highlight Date: 16/01/2020 2:57:31 PM
	Amend text box:
	DPIE and NSW Office of Emergency Management.
	Author: coullr Subject: Highlight Date: 11/02/2020 2:14:04 PM
	Building coastal resilience through

Comments from page 40 continued on next page


Subject: Highlight Date: 11/02/2020 2:14:32 PM

Author: coullr

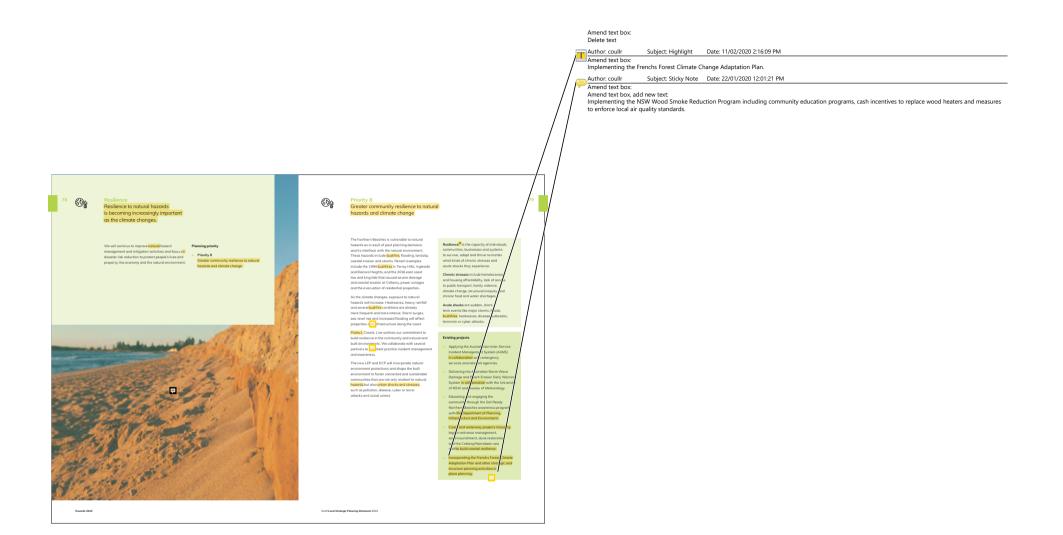


		Page: 41
		Author: coullr Subject: Highlight Date: 21/01/2020 11:18:27 AM Amend text:
		Amena text
		Muthor: coullr Subject: Highlight Date: 11/02/2020 2:13:01 PM
		Amend text:
		snapshot of natural and urban hazards including impacts from climate change
		Author: coullr Subject: Sticky Note Date: 16/01/2020 3:03:59 PM
		Amend map: New MRA layer
		- Updated flood layer
		- Updated bushfire layer - Onsite wastewater in close proximity to water
		- Employment lands in close to main stormwater
		Author: coullr Subject: Highlight Date: 16/01/2020 2:59:40 PM
		Amend principle:
		Mitigate exposure to UV radiation, the UHI
80 Map B Northern Beachers/resilience to natural hazardix and climate change	81	Author: coullr Subject: Sticky Note Date: 16/01/2020 3:00:29 PM New principles:
		Manage risks associated with sea-level rise for coastlines and beach landscapes.
		Minimise water, air and noise pollution, soil and groundwater contamination and its discharge into the environment.
Principles		winninse water, ar and horse policitori, son and groundwater contamination and its discharge into the environment.
	to public health and safety • Mitigate the UHI effect and extreme heat. Indiratural hazards. Improve resilience to riemate channe	Minimise adverse impacts from development in environmentally sensitive areas.
	bille and property. in both natural and built assets.	Within high risk areas, avoid developments that rely on performance-based solutions, are difficult to evacuate or would be occupied by at-risk members of
Support init to climate d	tives that respond Balance urban tree corpy programs and ange. bushland restor on with natural hazard risk.	the community (including schools, hospitals and nursing homes).
- Avoid interro	lication of development	Author: coullr Subject: Highlight Date: 16/01/2020 3:00:11 PM
and incomp tweet theet	tible land uses in areas tural and urban hazards.	Amend principle: , inappropriate development
No. Action	Time Partner	
81 Identity	grinne area records in response to S	Author: coullr Subject: Sticky Note Date: 16/01/2020 3:00:41 PM Add partner:
	nal Fire Danger Rating System	NSW RFS
8.2 Identity	here to limit the intensification of development in areas exposed	Author: coullr Subject: Highlight Date: 11/02/2020 2:17:02 PM
Nandari Bala	sin one with the second study and local noticing strategy.	Amend action:
Calaray/ Calaray/ Naraben	Serand DCP controls to implement these studies, including the Zenerite mapping, I	Finalise the new Northern Beaches Bush Fire Prone Land Map and undertake an appropriate strategic bush fire assessment to guide future development in accordance with State government guidelines including Planning for Bush Fire Protection (PBP)
Beah 8.4 📉	te a natural hazards and resilience framework to the second s	men Author: coullr Subject: Highlight Date: 11/02/2020 2:17:15 PM
Tyrices Tyrices Council hazard c	Chieven seo-level rise and address long-term natural ad climate-level risk across the Northern Beaches	Amend action:
85 💦	Protect, Create, Live and as inted action plans for adaptation and resilience SML	including bush fire prone areas for both risk minimisation and environmental protection
8.6 Preserve		Author: coullr Subject: Highlight Date: 16/01/2020 3:01:10 PM
	n plan or French crest Planned Precinc	Amend action: Undertake studies including constraints, coastal hazards and flood mapping and develop LEP and DCP controls to restrict development in high-risk hazard
8.7 Resolve	he future of lings ide so that any setopment is I DPIE le and resilient to no real hozards	areas
La martine		Author: coullr Subject: Sticky Note Date: 16/01/2020 3:01:20 PM
		Add partners: NSW RFS
		NSW KrS DPIE
Legend Urban area Strategic and local centres Partner with research		Author: coullr Subject: Highlight Date: 16/01/2020 3:01:31 PM
Inglinuide Growth Area Populations vulnerable to urban climate charge impacts	$\langle \rangle \rangle \langle \rangle$	Amend action:
National park Placed promote and maintain public Placed promote and maintain public Occess and build realisence Occess and build realisence	$\langle \rangle$	Investigate a natural hazards and resilience framework to address chronic stresses and acute shocks including but not limited to sea-level rise, natural hazards and climate-related risks across the Northern Beaches
Wolfy park of parket and parket and the parket		
		Author: coullr Subject: Highlight Date: 11/02/2020 2:17:46 PM Amend action:
Tewardt 2040 DruthLood Strutegie	Saniag Statement 2019	Implement our Environment and Climate Change Strategy Protect. Create. Live. and develop associated
		Author: coullr Subject: Sticky Note Date: 11/02/2020 2:18:25 PM
		Add partners:
		DPIE Resilient Sydney
		Office of Emergency Management
	\sim	Cancer Institute NSW
		Author: coullr Subject: Highlight Date: 16/01/2020 3:02:00 PM Amend action:
		The Author: coullr Subject: Highlight Date: 16/01/2020 3:02:09 PM
		Amend action:
		climate change


Comments from page 41 continued on next page

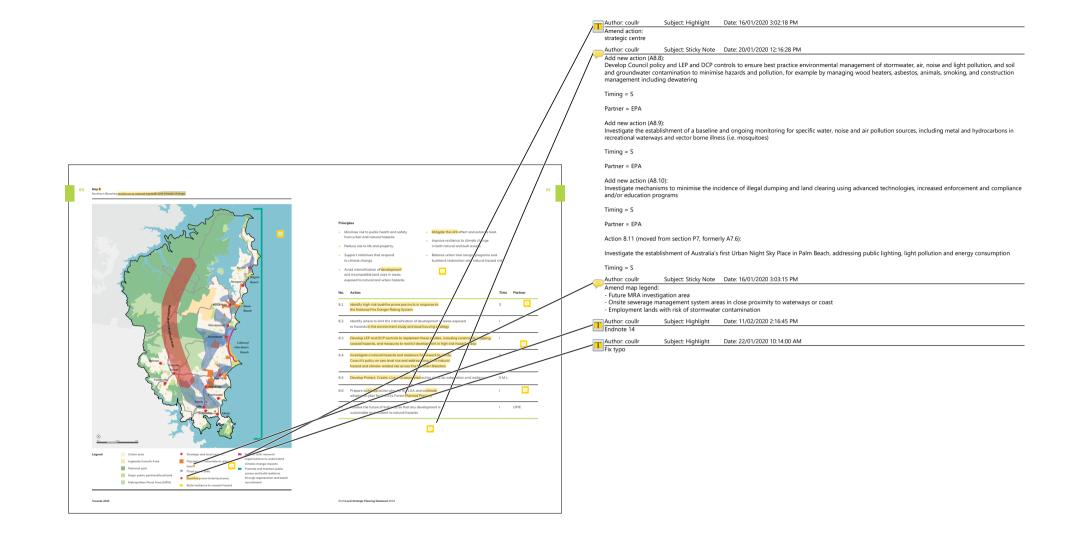


This page contains no comments



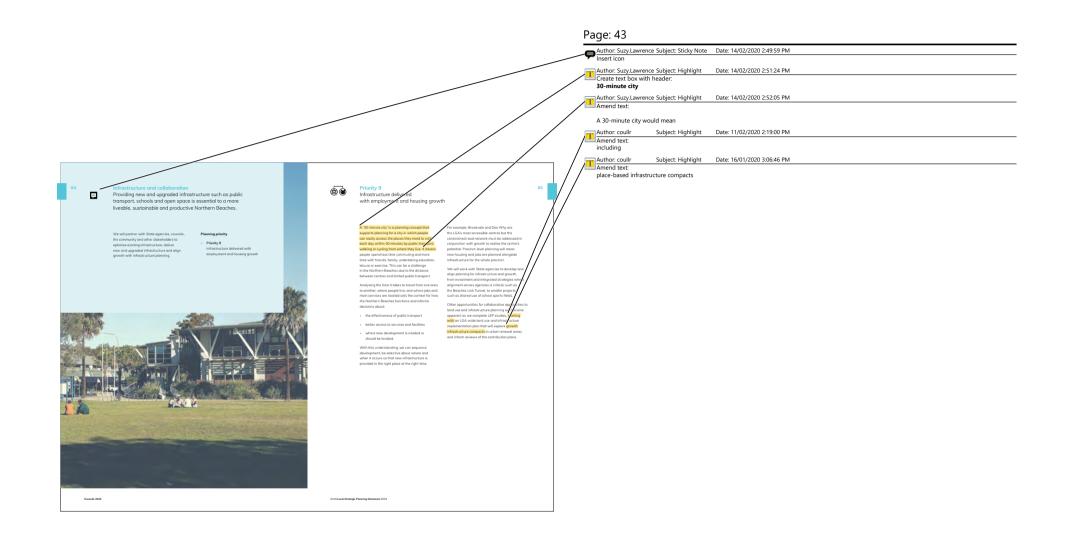

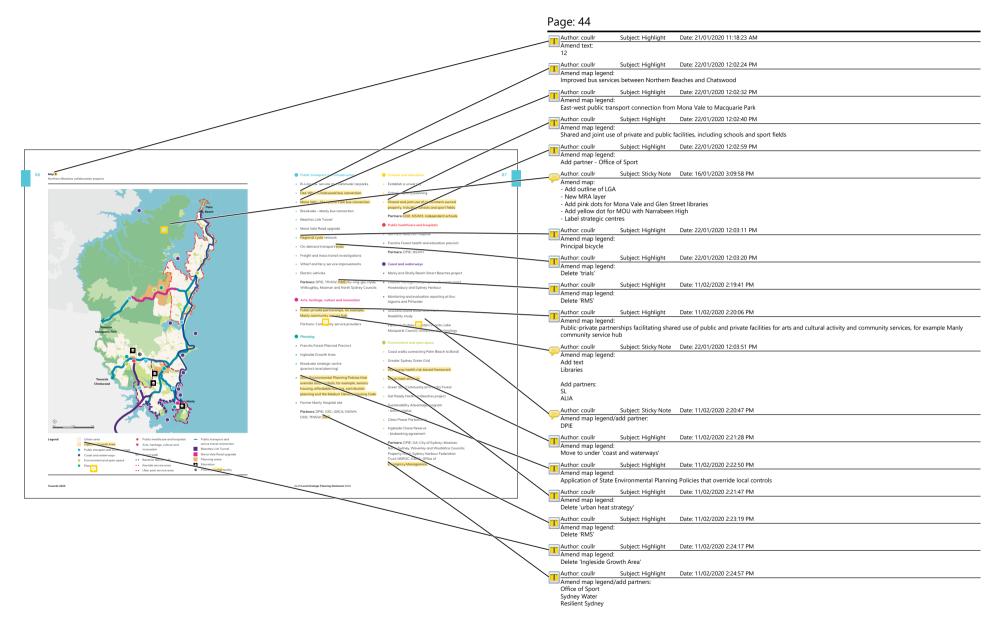



Comments from page 44 continued on next page

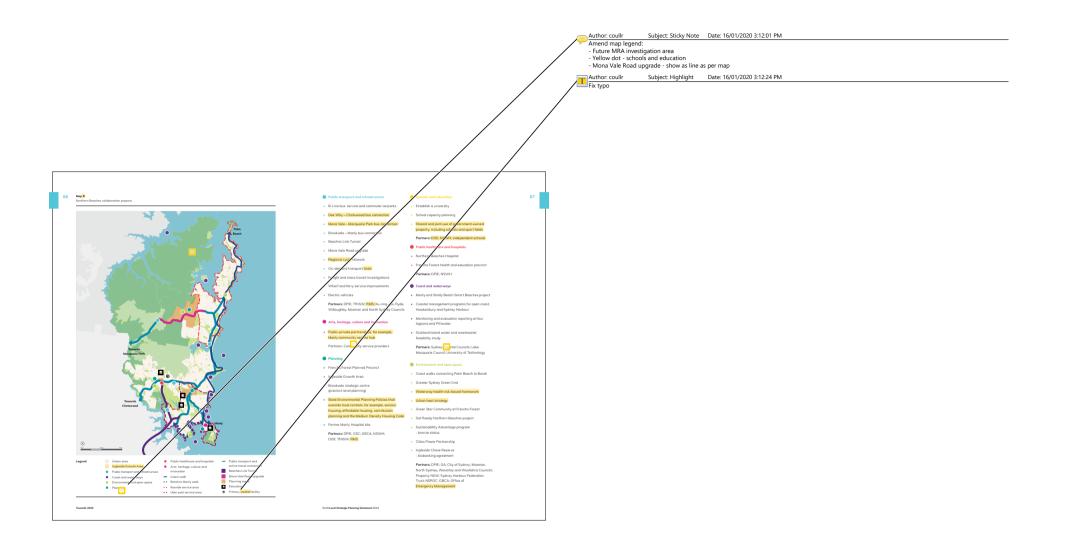



	Page: 45
	Subject: Highlight Date: 21/01/2020 11:18:20 AM
	Amend text:
	Author: coullr Subject: Highlight Date: 11/02/2020 2:26:48 PM Amend principle:
	infrastructure contributes to the circular economy, considers whole of life cycle costs,
	Author: coullr Subject: Highlight Date: 16/01/2020 3:13:59 PM Amend principle:
	ultiertu principie. public-private partnerships and shared use of private and public facilities.
	Author: coullr Subject: Highlight Date: 22/01/2020 12:04:49 PM
	Amend principle: satisfied. This includes social and transport infrastructure.
	Author. coullr Subject. Sticky Note Date: 16/01/2020 3:14:38 PM
	Amend infographic: - Fix up the green infrastructure map for consistency with other maps
98 Ngur 29	Author: coullr Subject: Sticky Note Date: 11/02/2020 2:25:24 PM
Contraction of the second infrastructure planning	New principles:
	Protect existing waste infrastructure land and activities including waste transfer stations and resource recovery facilities.
vina ana ana ana ana ana ana ana ana ana	Principles Ensure upgrades to infrastructure address impacts from climate change, including urban heat, UV radiation exposure, sea-level rise and increased incidence of bush fire, flooding and storm surges.
E. C. Softer a state of the second se	to strenge i more off denotes a detone of floates by the busy beaution of the busy the
ş e ş	growth orst instructure in statestige centres. Intersectional formation and instructure in statestige centres.
	Foster padde genetar lager Foster padde genetar lager Foster padde genetar lager Foster padde genetar lager TfNSW
	addta camanity advin. Author: coullr Subject: Sticky Note Date: 16/01/2020 3:15:45 PM
	No. Action Time Partner.
and the second sec	91 Devide and Lisk-wide land use infrastructure implementation plan
and the second second	informet by LEP studies to align patienting and funding for housing, employment, social infrastructure and trensport transport, waste and other
the the the the	12 Develop LEP and DCP controls that subspace tool propert and interactivities S
marker of the second se	neos, noung energies is the 2-th bandward due Andre An
	NSWH THOSE
	9.4 Facilitata a whate-d-governmet precise/Level opproach to planning for growth SM GSC DPE and GSC DPE in the state of th
	NSIGH Author: coullr Subject: Highlight Date: 21/01/2020 11:18:16 AM
	Work with the WSW Government
	Sectore and action:
Elements of coordinated land use planning	an explosion poor
	Author: coullr Subject: Highlight Date: 21/01/2020 11:18:13 AM Amend text:
"also includes buildand, urban tree canoor cover, and natural and man-made waterways (see P1 and P5).	9.6
	Author: coullr Subject: Highlight Date: 16/01/2020 3:16:52 PM
Tewantic 2040	Data Lead Stranging Planning Stranging Planning Stranging Planning Stranging Planning Stranging Planning Stranging Planning Stranging St
	Author: coullr Subject: Highlight Date: 21/01/2020 11:18:08 AM
	Amend text. 9.7
	9.7 men Author: coullr Subject: Highlight Date: 21/01/2020 11:18:05 AM
	Amend text:
	9.8


This page contains no comments

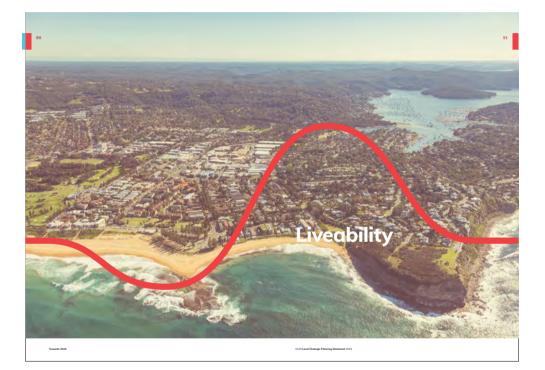


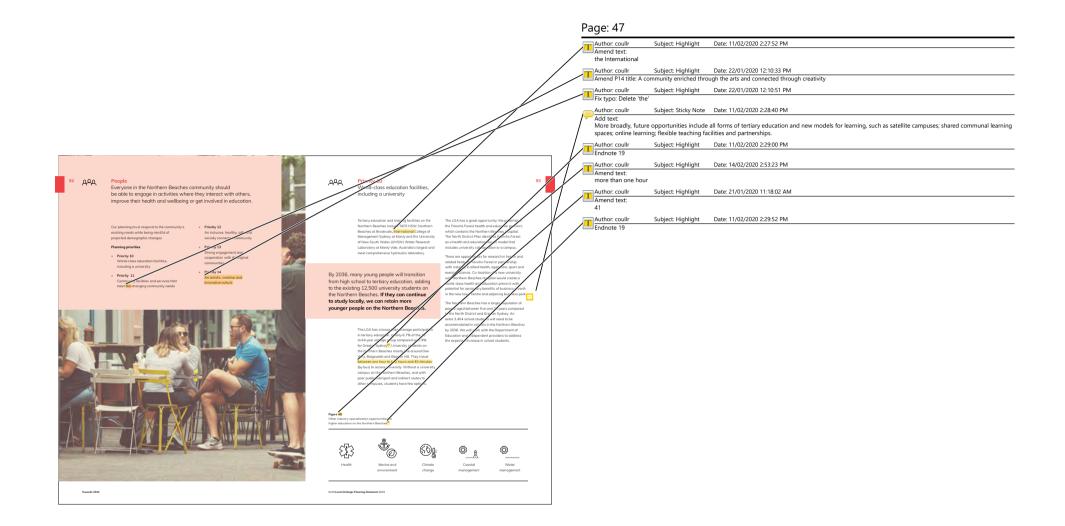


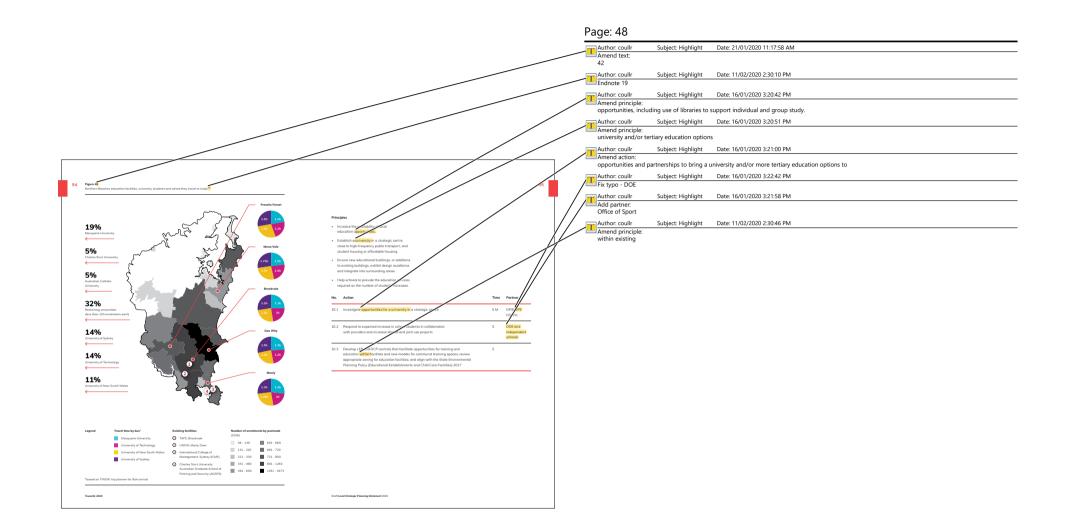


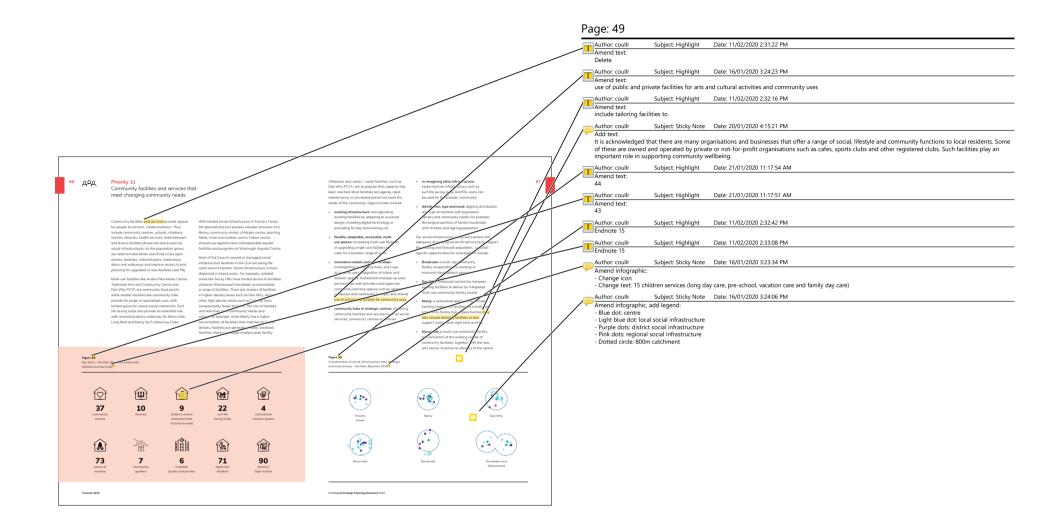

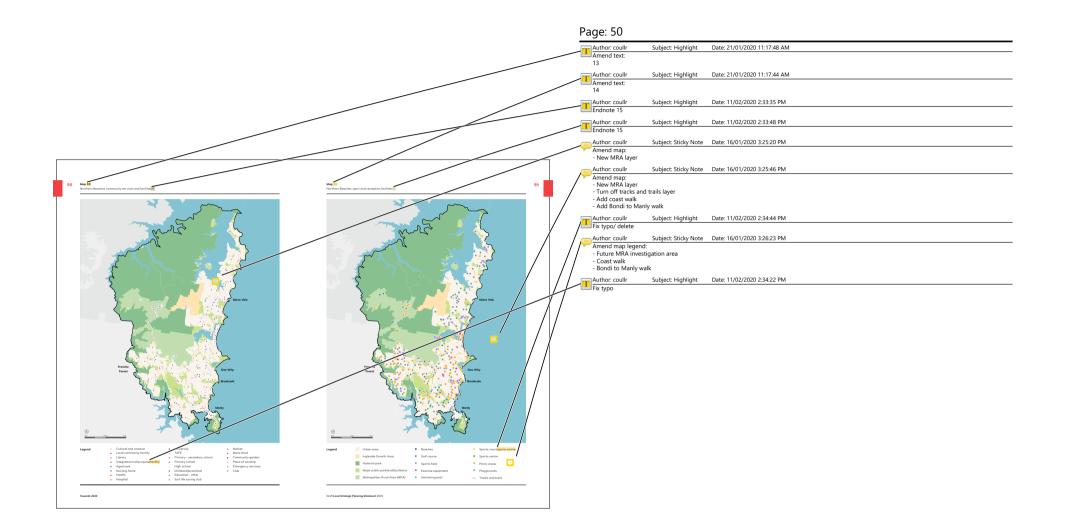

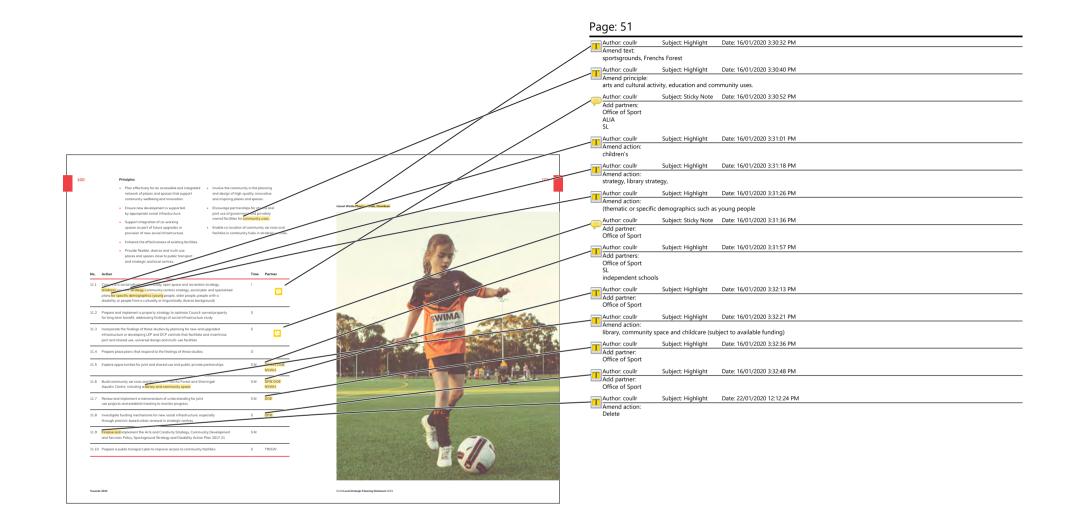

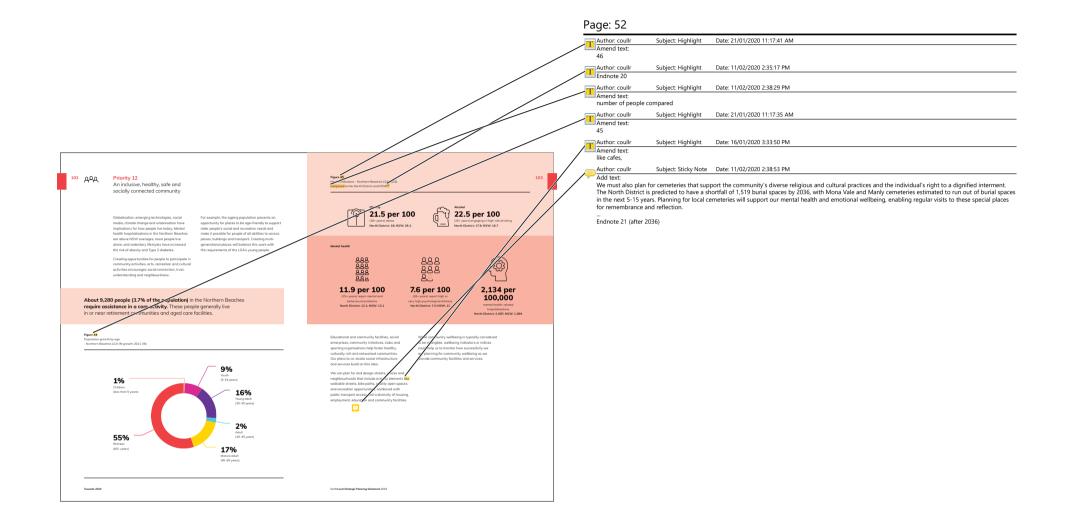

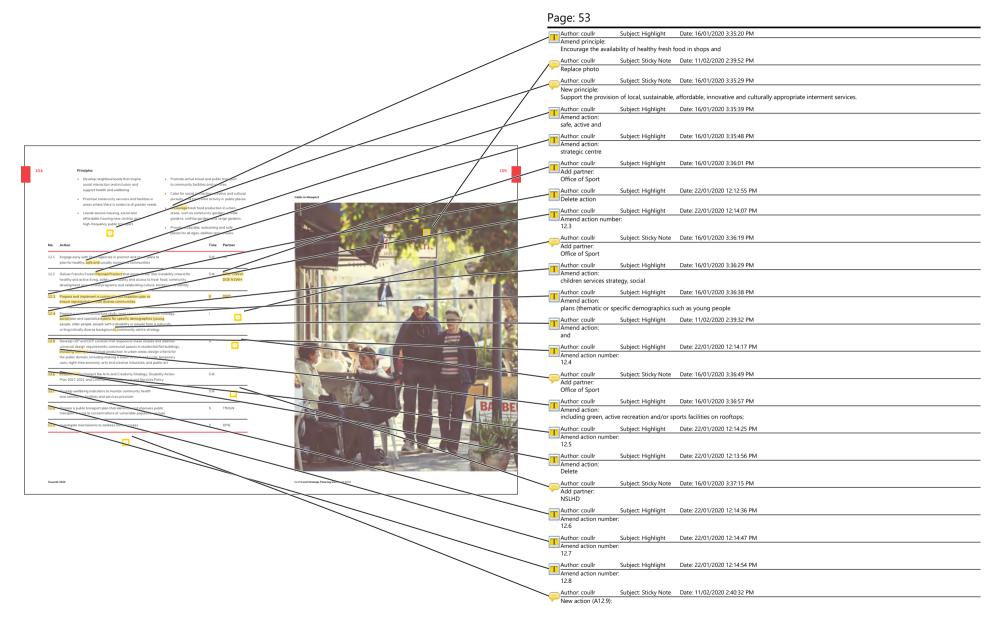

Comments from page 53 continued on next page

Develop and implement a library strategy to improve community literacy and access to information

Timing = I

Partners = ALIA, SL


New action (A12.10):

Investigate mechanisms to address the identified shortfall in local cemeteries, including innovative solutions, earmarking appropriate land for new and expanded cemeteries and investigating options for Council to acquire further land to expand existing interment services

Timing = O


Partners = Cemeteries and Crematoria NSW




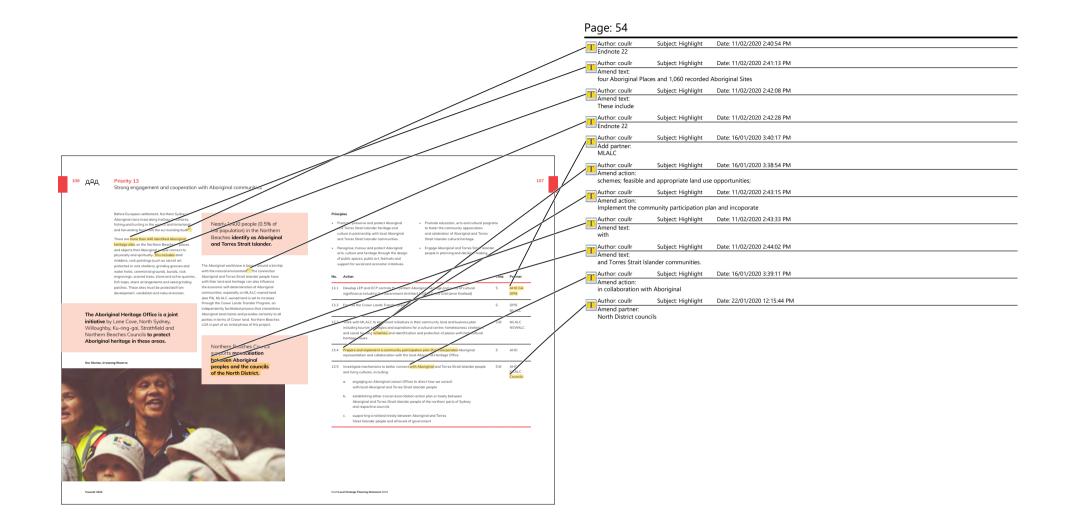


	Page: 55
	we Author: coullr Subject: Highlight Date: 21/01/2020 11:17:08 AM
	Annon totil Subject Highinght Date 21/01/2020 11:17:00 AW
	Author: coullr Subject: Highlight Date: 11/02/2020 2:44:22 PM
	Amend text: creative spaces and places snapshot
	Endnote 23
	Author: coullr Subject: Highlight Date: 23/03/2020 3:17:40 PM
	Amend P14 title: A community enriched through the arts and connected through creativity
	Author: coullr Subject: Highlight Date: 16/01/2020 3:41:00 PM
	Amend text: From the photographic studios in Warriewood to the surfboard shapers in Brookvale, the artist-run initiatives in Seaforth, jewellers, ceramics groups, painters, sculptors, writers, film-makers, screen printers and musicians, the Northern Beaches is a powerhouse of creative industries.
	Author: coullr Subject: Highlight Date: 22/01/2020 12:16:27 PM
	Author: coullr Subject: Highlight Date: 11/02/2020 2:44:41 PM
	Endnote 23
8% of the workforce employed in cultural Creatures Electron Entratic venues.	Amend map:
or creative exceptions and manual This includes The Boold Arts and Creative Strategy Highlights Arts and Creative Strategy Highlights	- Replace map with map from Council's Arts and Creativity Strategy (page 22)
a support mana, unagi, a constanti a di a support	Author: coullr Subject: Highlight Date: 16/01/2020 3:41:23 PM
Recent council initiatives include Browset	Amend text: making room for the creative sector and this includes reviewing planning controls and processes that enable and support creative businesses to establish and
the sense op	making room for the creative sector and this includes reviewing planning controls and processes that enable and support creative businesses to establish and thrive.
Pelyc, Calestons Management Pelocy, Palest Art Pelocy, Anal and Canada Statesy Palest Art Pelocy, Anal and Canada Statesy Palest	Author: coullr Subject: Highlight Date: 16/01/2020 3:41:39 PM
associated action plan. Mona Vale Arts Centre spaces for the value and activations.	Amend text:
with a community galaxy, teaching space:	visual and performing arts, literature, film, fashion,
	Author: coullr Subject: Highlight Date: 11/02/2020 2:45:06 PM
Create NSW indicates that for culture to truly flourish it needs a home - places	Amend text: festivals
where it can be created, shared and enjoyed (Cultural Infrastructure Plan 2025)	Author: coullr Subject: Highlight Date: 16/01/2020 3:41:48 PM
	Amend text:
Arts, cubure and creativity is failingted through	Our
public cultural infrastructure (a) public cultural	Author: coullr Subject: Highlight Date: 16/01/2020 3:41:57 PM
Viele Mony, Auder, Bookvale and Sadorth:	the adoption of a 10-year Arts and Creativity Strategy to guide the development of a sustainable and thriving local culture of arts and creativity, and
	Author: coullr Subject: Highlight Date: 16/01/2020 3:42:04 PM
Norters Backs (page Leferst Andrew L	Council will deliver new creative spaces at Mona Vale that will include studios, workshop and exhibition spaces and, at Avalon that will include workshop and affordable studio spaces.
	Author: coullr Subject: Highlight Date: 16/01/2020 3:42:12 PM
	Amend text: artists in urban design and planning processes to deliver integrated and innovative outcomes for the local community that are authentic to the Northern
	artists in urban design and planning processes to deriver integrated and innovative outcomes for the local community that are authentic to the Northern Beaches.
Neth An Find Very las Find Pairs of the Annual Annua	Author: coullr Subject: Sticky Note Date: 14/02/2020 2:55:59 PM
	Adductor. Arts and creativity skillsets are also increasingly recognised for their importance in supporting problem solving and creative solutions with the updated
Tweek 2009 Distinged Provide Demonstration	acronym STEAM (Science, Technology, Engineering, Arts and Mathematics). Developing future-focused skills in our community is an important way of supporting innovation and creative problem-solving to tackle our big challenges.
	Author: coullr Subject: Highlight Date: 16/01/2020 3:42:18 PM
	Amend text: as well as
	we Author: coullr Subject: Highlight Date: 21/01/2020 11:17:05 AM
	Author: coulir Subject: Highlight Date: 21/01/2020 11:17/05 AM Amend text: 47
	Author: coullr Subject: Sticky Note Date: 11/02/2020 2:45:55 PM Amend infographic:
	 Antenior annographic Replace infographic with figure from Council's Arts and Creativity Strategy 'How we got creative over the last 12 months'

.... Endnote 23

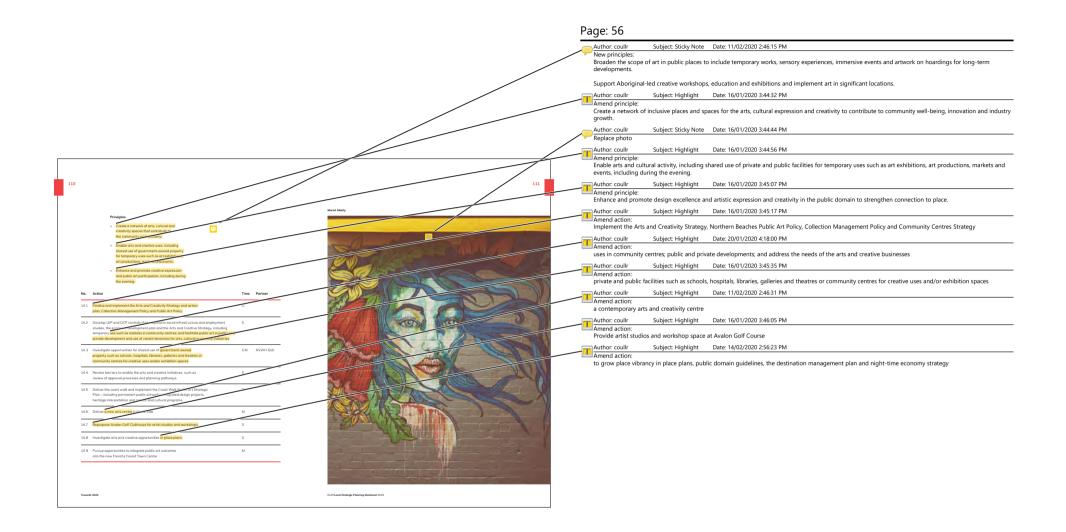

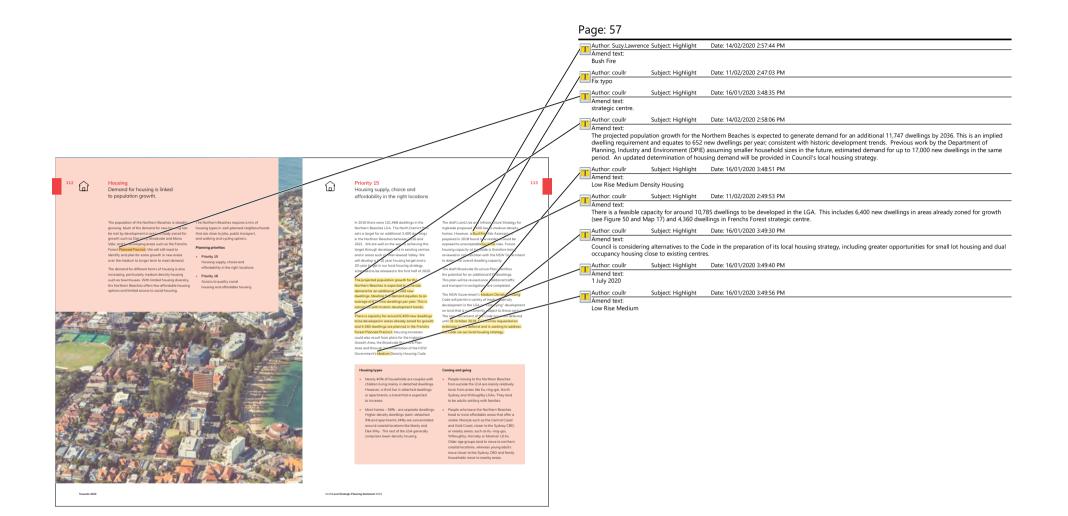

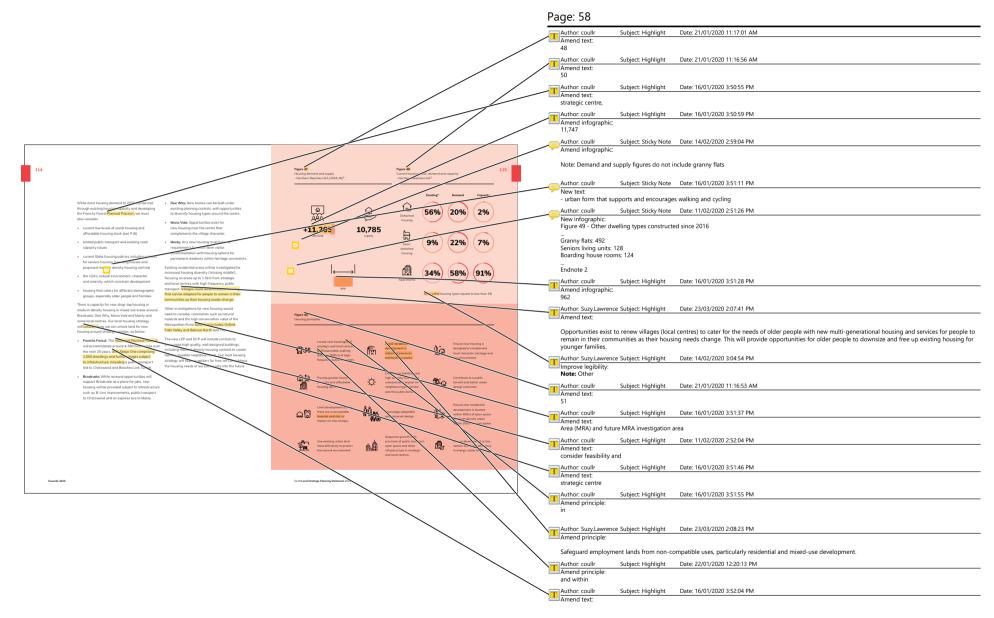



Comments from page 58 continued on next page


with the State-led planned precinct - Phase One comprising 2,000 dwellings. Further stages in the strategic centre are subject to longer-term infrastructure options such as


Author: coullr Subject: Highlight Date: 22/01/2020 12:20:26 PM


Amend principle: risks from natural and urban hazards, or

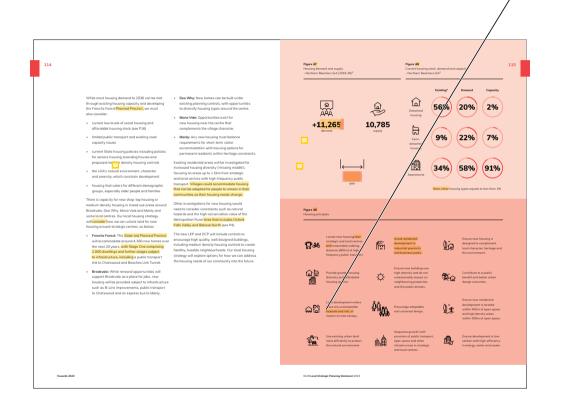


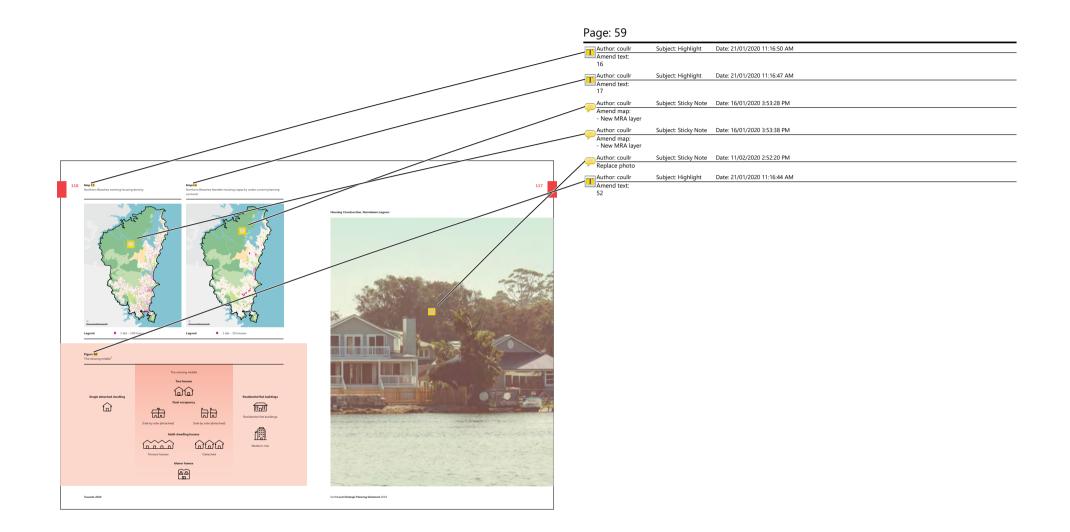

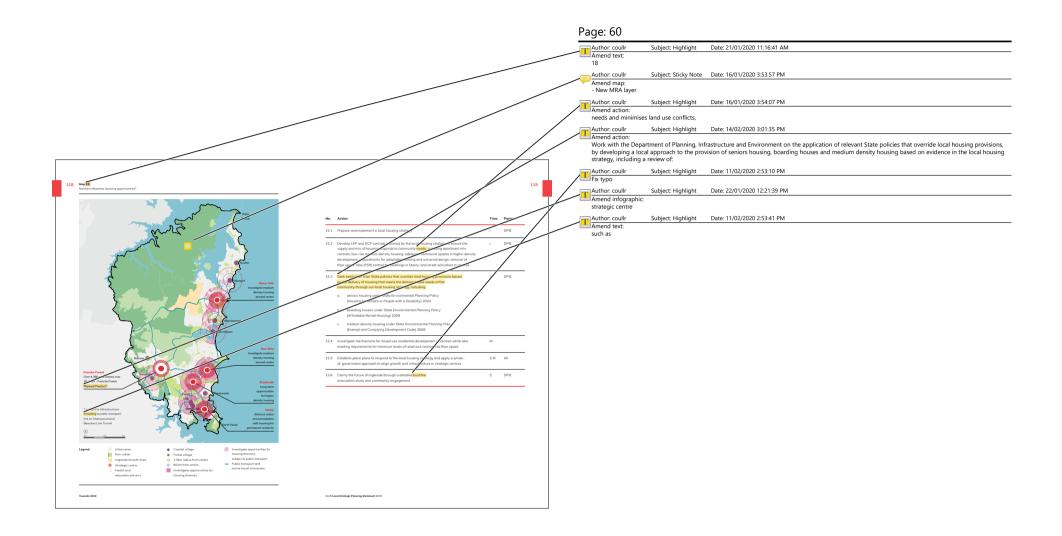

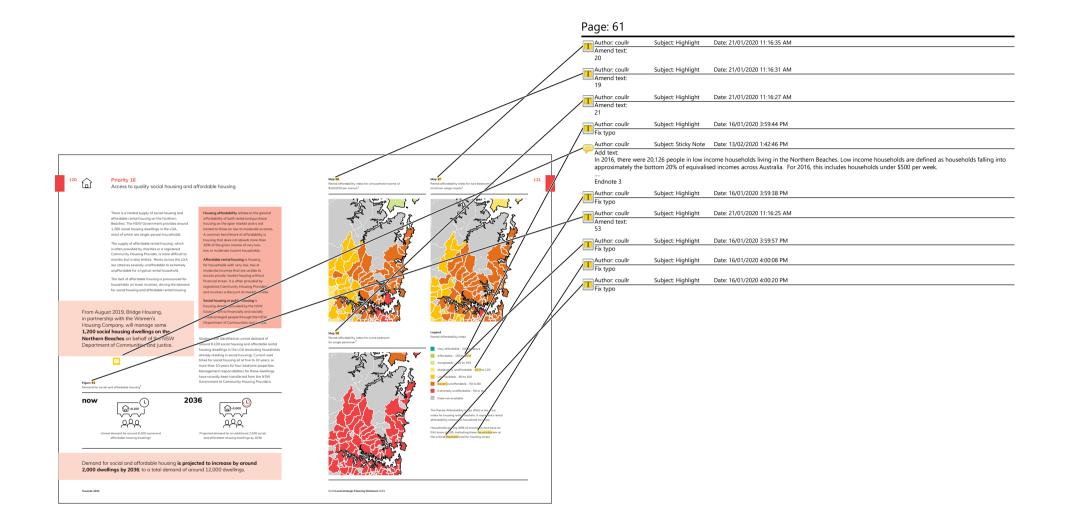

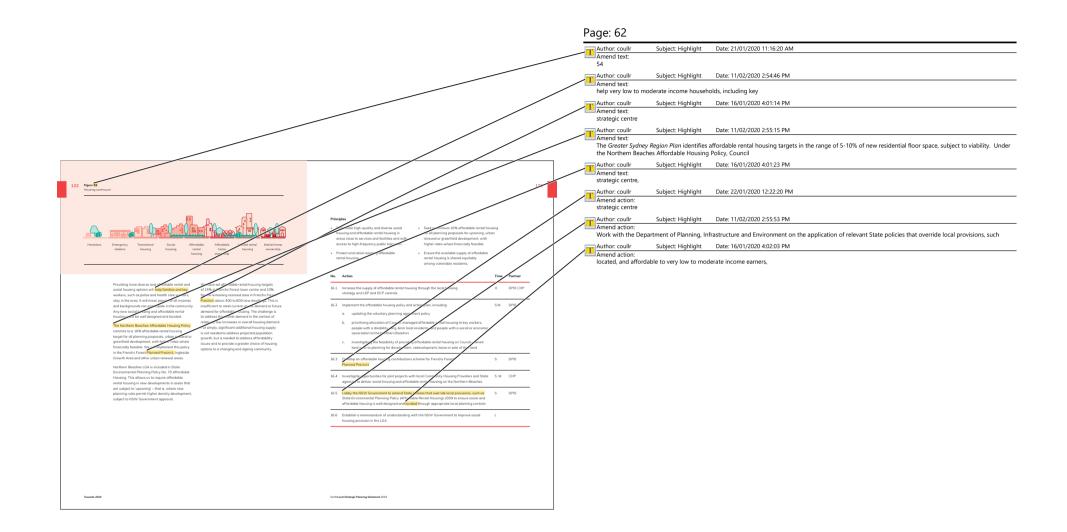


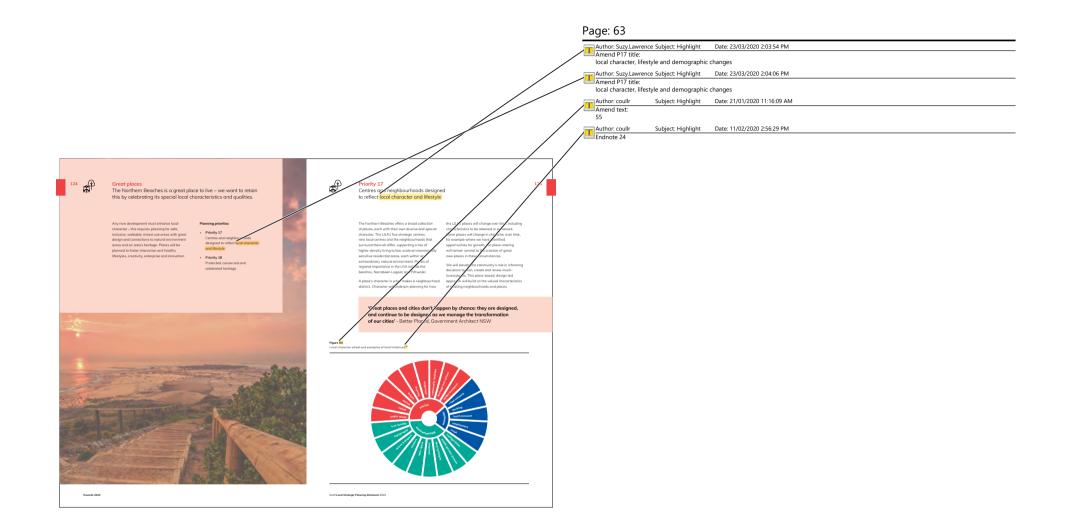



		Page: 64
		Author: coullr Subject: Highlight Date: 22/01/2020 12:22:43 PM
		Amend action:
		55 (continued)
		Author: coullr Subject: Highlight Date: 11/02/2020 2:56:52 PM Endnote 24
		mel Author: coulir Subject: Highlight Date: 11/02/2020 2:57:23 PM
		Amend principle:
		through design excellence and innovative
		Author: Suzy.Lawrence Subject: Sticky Note Date: 23/03/2020 2:02:36 PM
		As we undertake place planning, we will respond to demographic changes and plan for centres that respond to local needs. This includes planning for age-
		friendly centres that cater for the needs of older people such as improved walkability to support independence later in life.
		Author: coullr Subject: Sticky Note Date: 16/01/2020 4:02:48 PM
126 Figure 53 Local character wheel and examples of local initiatives		127 Recognise heritage and culture as a fundamental aspect of the identity of place, including identification of places and items which contribute to the significant character of a place.
		Author: coullr Subject: Highlight Date: 11/02/2020 2:58:34 PM
	Place planning is a multidisciplinary approach to the	Amend action:
	planning and management of public spaces centred on the community's connection to slove. We wish Benew great places through innovative design	urban design framework and guidelines for public spaces;
	opply place planning in strategic and loc-centres, starting with Avalan. Reviews of loc character Enhance the visual and environmental	Author: coullr Subject: Highlight Date: 16/01/2020 4:03:06 PM
	planning controls will conside special area controls. local character statemes, additional controls for	studies; review built form and landscape controls to ensure good design;
	exclusions from State-wide policies.	
	Priorities P23-27 include precinct-specific principles for French Forest, Brookvale, Dee Why, Mank and Mana Vale and Should be considered activity every of temporary and interim uses.	
	in conjunction with the following principles.	
	No. Action Time Partner	
	17.1 Prepare In local unacter study, local housing strategy, scenic and cultural landscapes IS study subscite domain guidelines; develop LEP and DCP controls that respond to	-
Public domain improvements Community hubs and arts and cultural facilities	these studies, implement design excellence provisions; improve design criteria for the public domairc and incorporate local character statements for key areas	
	17.2 Implement place planning, starting with Avalon, Manly and Mana Vale, that applies a S M	-
	place-based approach to planning for local character and responds to the findings of the LEP studies; and develop a rolling program of place plans for areas undergoing change	
	17.3 Prepare and implement activation plans to establish partnerships with businesses O Local and the community, starting with Seatorth, Newport and Forest-Ville businesses	-
	17.4 Establish a design excellence review panel	-
	27.4 Exidatish o design excellence review points 5	-
Tree canopy and streetscope programs Public art programs		
Events of different scale Partnerships with businesses		
Tawards 2040	Drint Local Strategic Planning Statement 2019	





This page contains no comments

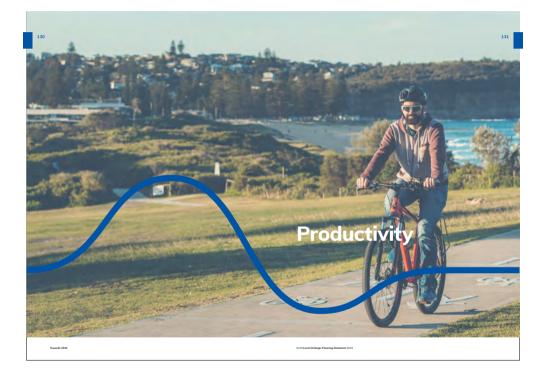


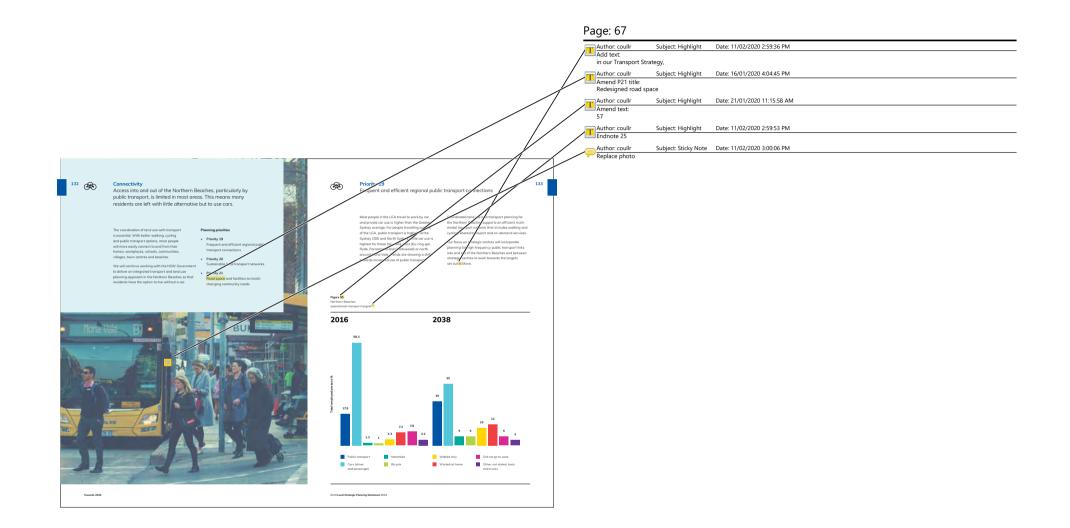


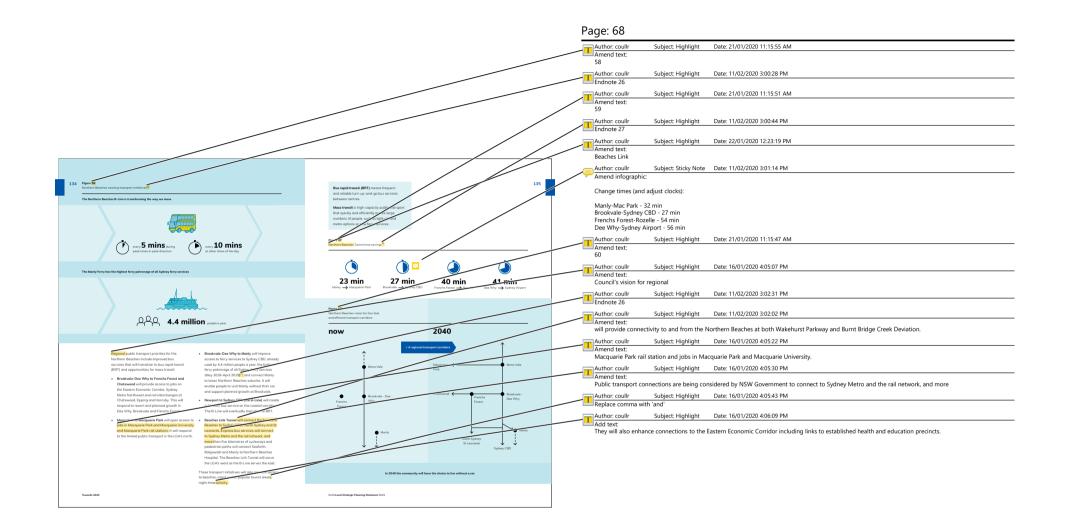


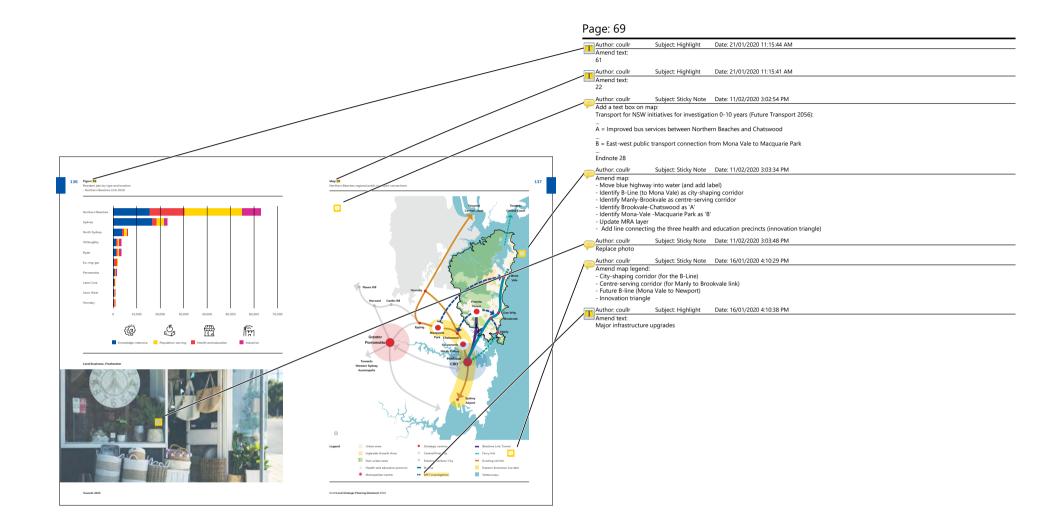


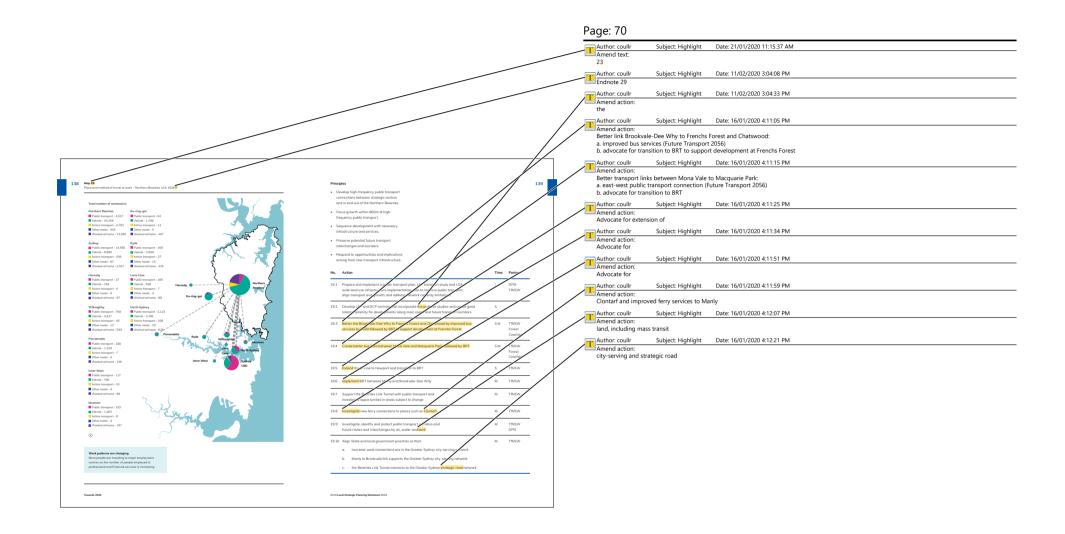


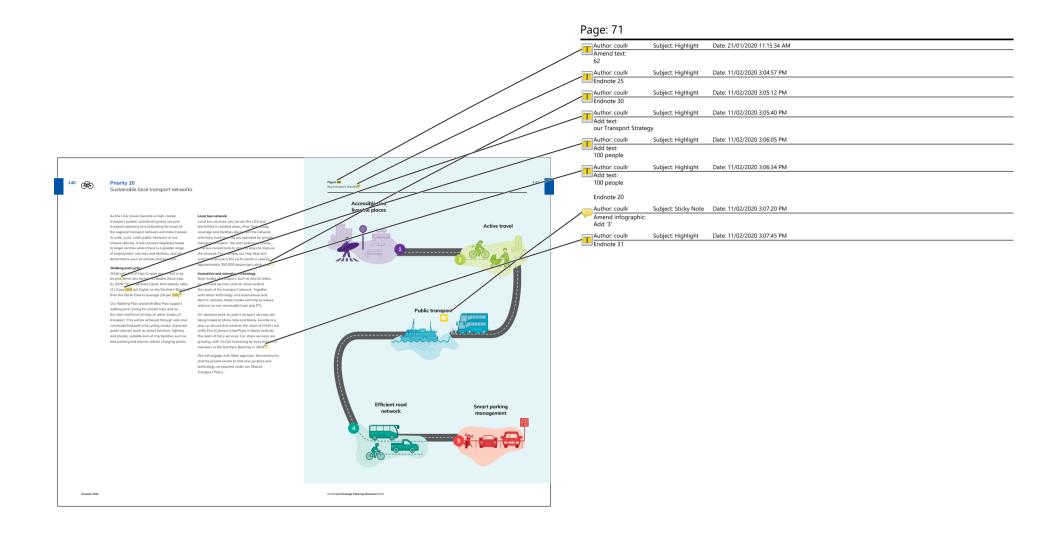


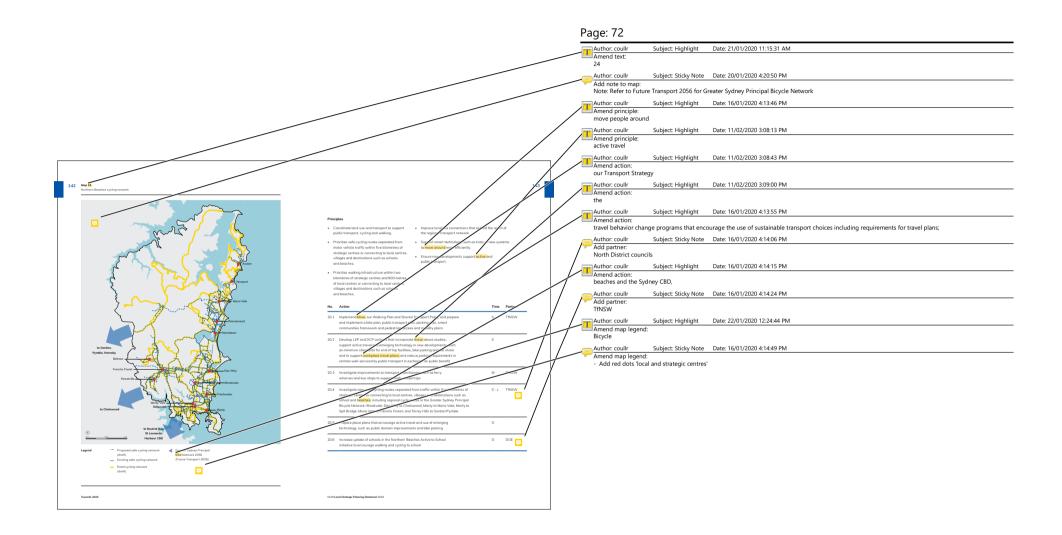

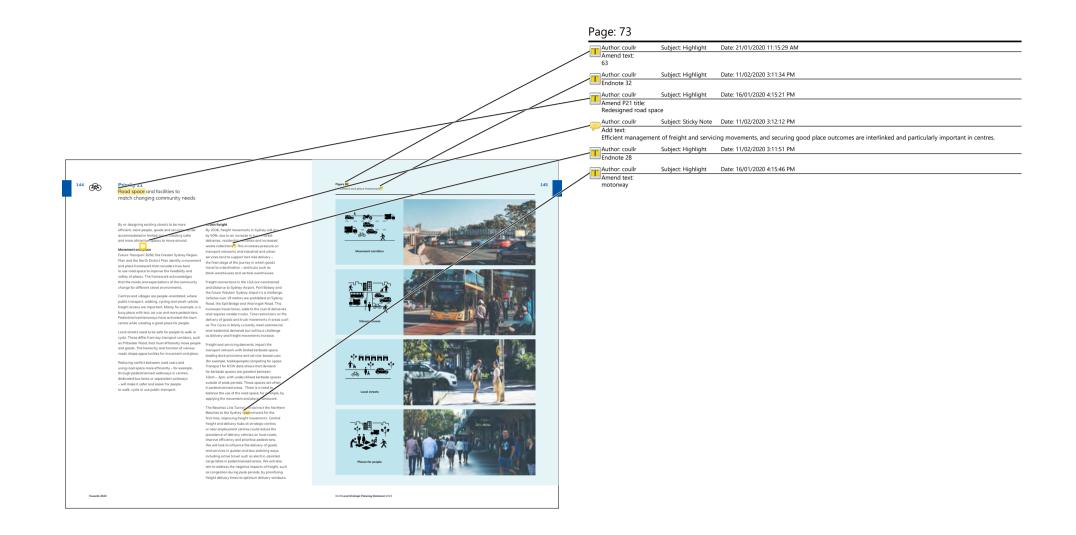


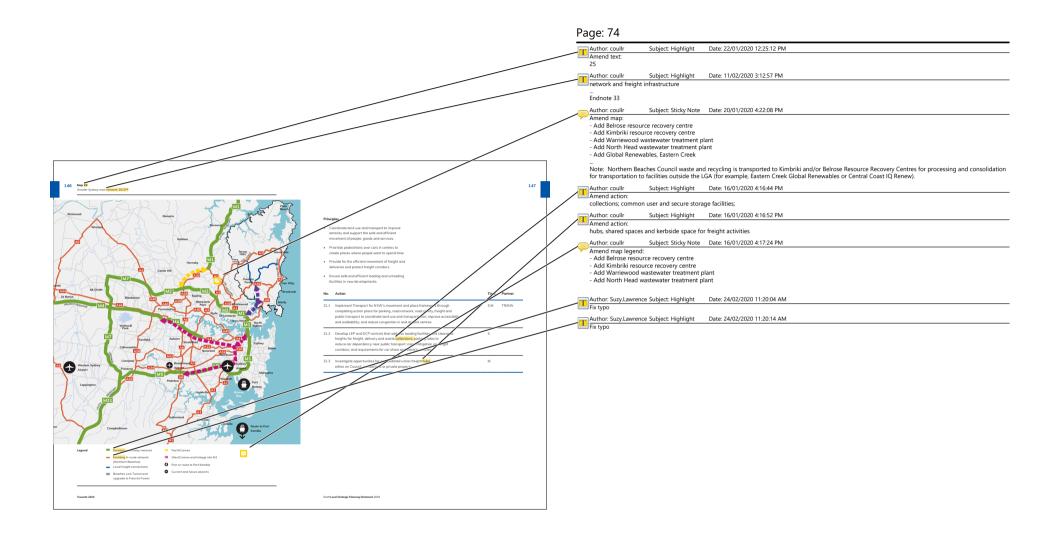


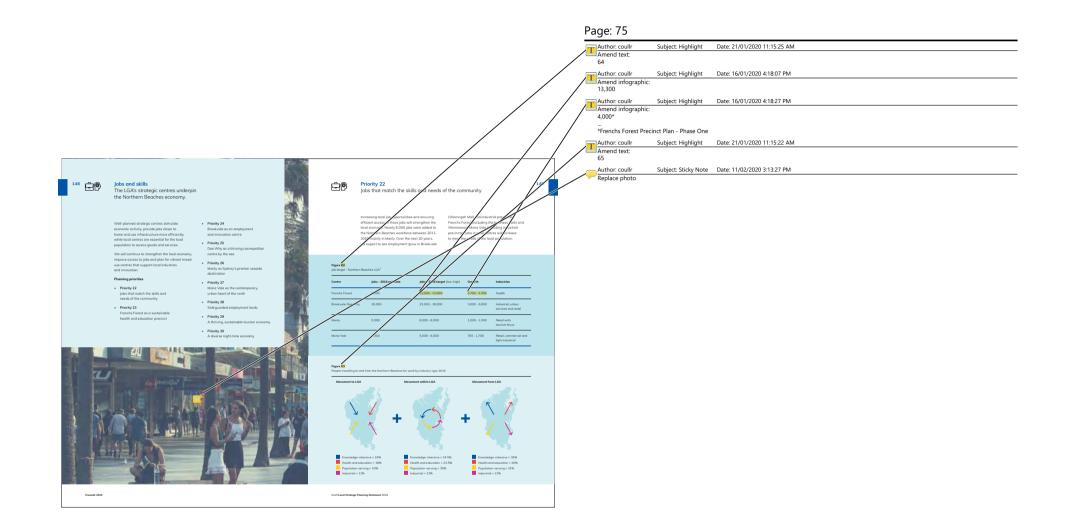


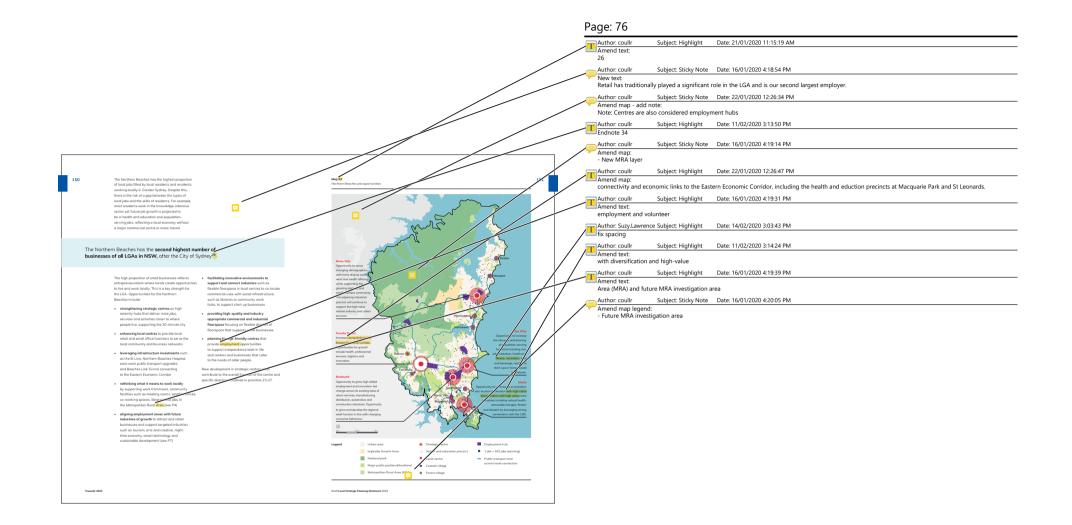




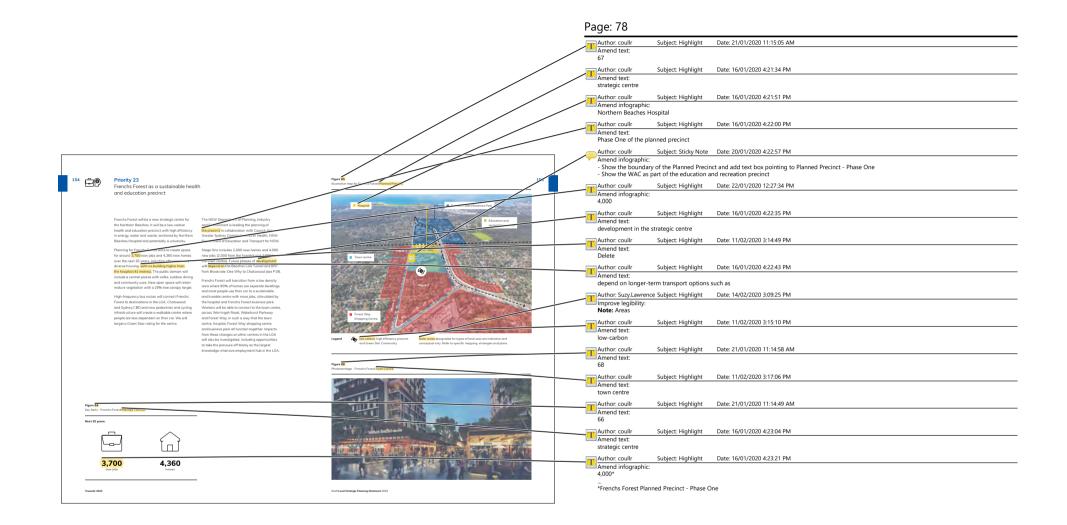

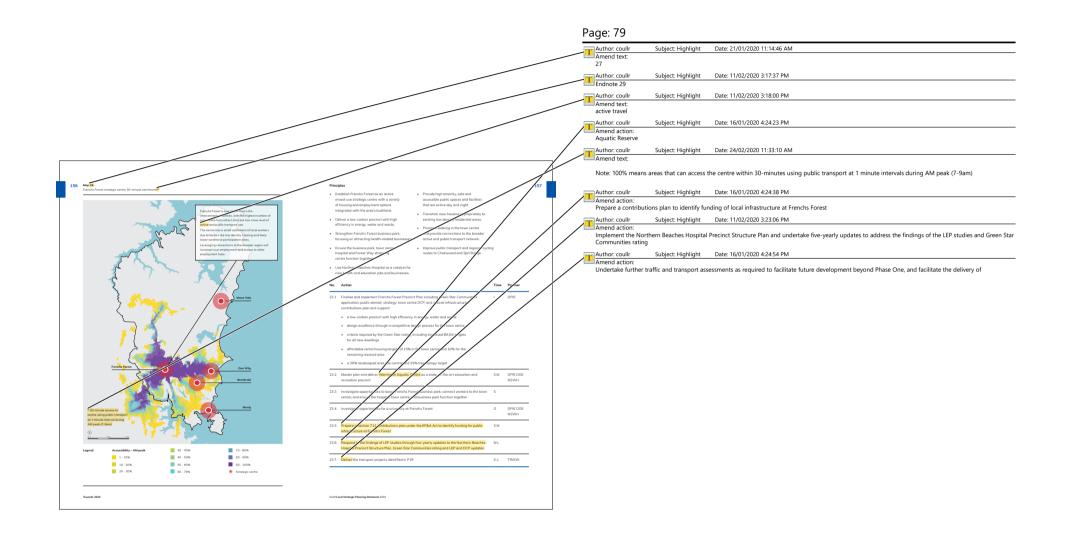


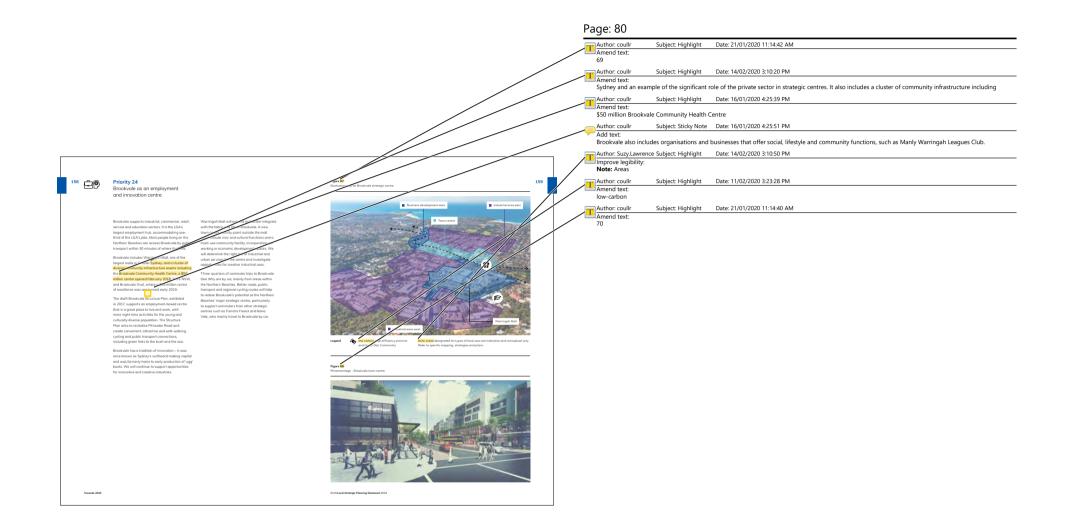


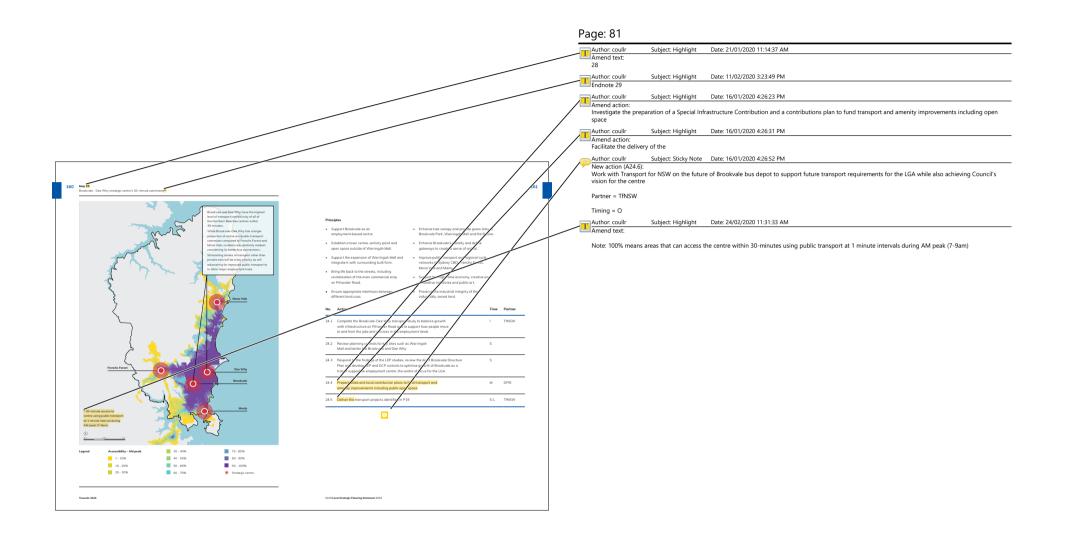



				F	Page: 82				
					Author: coullr Amend text:	Subject: Highlight	Date: 21/01/2020 11:14:32 AM		
					71				
					Author: coullr	Subject: Sticky Note	Date: 11/02/2020 3:24:16 PM		
				/	Amend infographic:		Date: 11/02/2020 3.24.101101		
					 Add Triangle Park 				
					- Add arrow heads t	o roads			
					Author: Suzy.Lawrence	ce Subject: Highlight	Date: 14/02/2020 3:11:44 PM		
					Improve legibility:				
					Note: Areas				
					Author: coullr	Subject: Sticky Note	Date: 11/02/2020 3:24:31 PM		
					Replace photo				
			/	_/ /					
				Λ					
				/ /					
162 🛱 🕲	Priority 25		Figure 62 Busineting men for Data Why transmenter						
	Dee Why as a thriving cosmopolitan o	centre by the sea	massaare may nit Liele Vity town Centre	4					
			Dee Why Lagoon Dee Why Brach						
	use centre that offers housing, retail, civic,	 redevelopment of private lands, facilitated by development bonuses in exchange for public 	Walter Gars Park						
	service and commercial functions. It has one of the most densely populated, multicultural	open space at the ground level, including:	Civic Site Givic Site Givic Site						
	communities on the Northern Beaches offering a	 Key Site B, now known as the Meritan site, including a town plaza and open arcade 							
	cosmopolitan lifestyle and night-time activity.	 Key Site C, a roadway between Oaks 							
	Residents and workers benefit from Dee Why's proximity to Dee Why Beach. Dee Why Lagoon	Avenue and Pacific Parade through							
	Wildlife Refuge and Stony Range Flora Reserve. It	the former Woolworths site	Pere						
	contains buildings of heritage significance including	e. Key Site D, a heavy vehicle turning lane for							
	the Civic Precinct with Dee Why Library, Civic Centre and the surrounding landscape recognised	vehicles turning left from Pittwater Road onto Pacific Parade	Town centre						
	for their State heritage significance (see P18).	f. Key Site E. a rear lane, landscaped	Future community hub						
	Recent housing growth in the town centre is	 Key Site E, a rear lane, landscaped open space and better connections 	Protect Dear Dear Dear						
	based on planning controls that have been in place since 2000. Although an increase	for sites west of Pittwater Road.	Heaman Hood Praza						
	in capacity was allowed on two key sites	Changes to planning controls require resolution of	1 Story Range						
		a planning proposal with the NSW Department of Planning, Industry and Environment. New	Stoney Range						
		LEP and DCP controls will improve provisions							
	The current vision for Dee Why Town Centre is articulated in Warringah LEP 2011 and	for design excellence, sustainability, retail activation, public domain and housing mix. New							
	Dee Why Town Centre Master Plan 2013.	development will integrate with the new B-Line	Legend Wew connections A-E Key Sites Note: areas designated for types of land uses are indicative and						
	These are being implemented through public domain upgrades and updates to planning	service and fund improvements to stormwater infrastructure, traffic and streetscapes.	Natural processes conceptual only. Refer to specific mapping, strategies and plans.						
	controls to stimulate development that will								
		Although no significant increase in density is proposed, there is estimated capacity for an							
	 street and public open space upgrades 	additional 1,400 dwellings, based on current and							
	Plaza, streetscape improvements and	proposed planning controls. This growth, along with the recent increase in population, calls for							
	proposed upgrades to Triangle Park	place planning to guide how the area will change.							
	 redevelopment of Council-owned land, 								
	subject to current investigations, including:								
	 Key Site A, a new mixed use development and roadway between Howard and Oaks 								
	Avenue through the Council-owned car park								
	b. Civic Site to provide community facilities		THE REAL PROPERTY AND ADDRESS OF THE PARTY O						
	and services including performing arts and entertainment, cuisine and retail								
	und entertainment, cuisine and retail		· DIST IN COMPANY OF A COMPANY						
			Dee Why						
			man every						
Tewards 2040			Druft Local Strategic Planning Statement 2019						
				_					



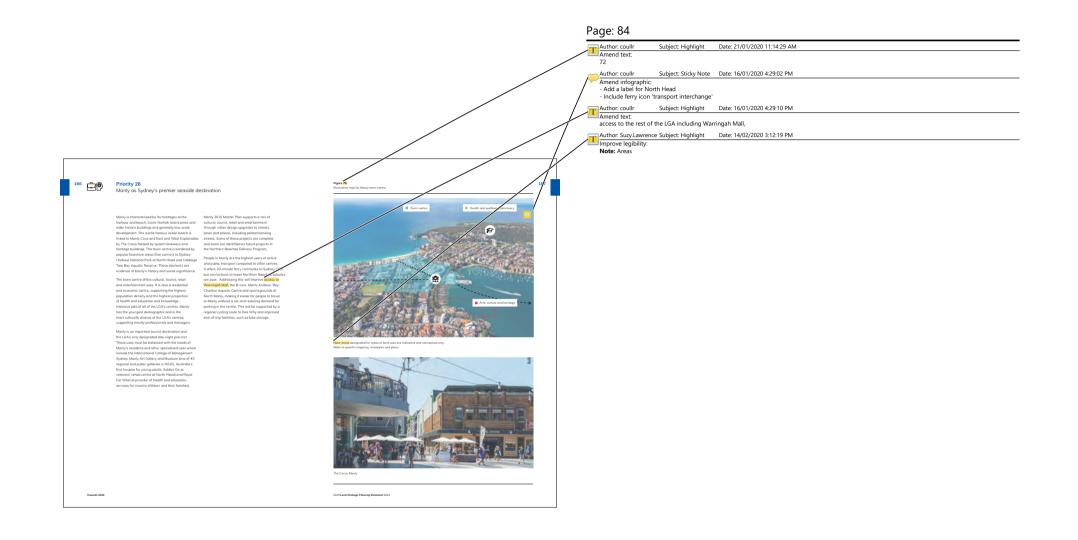

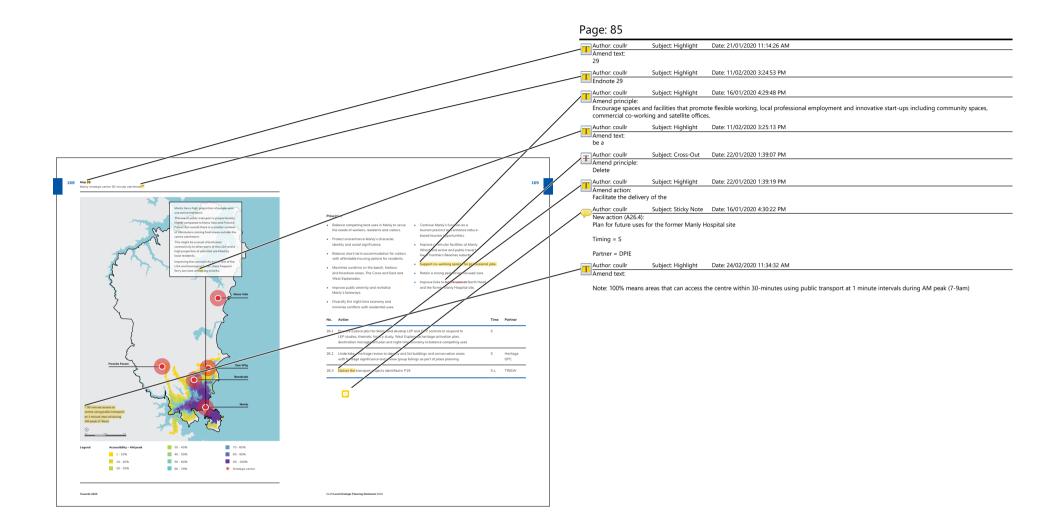


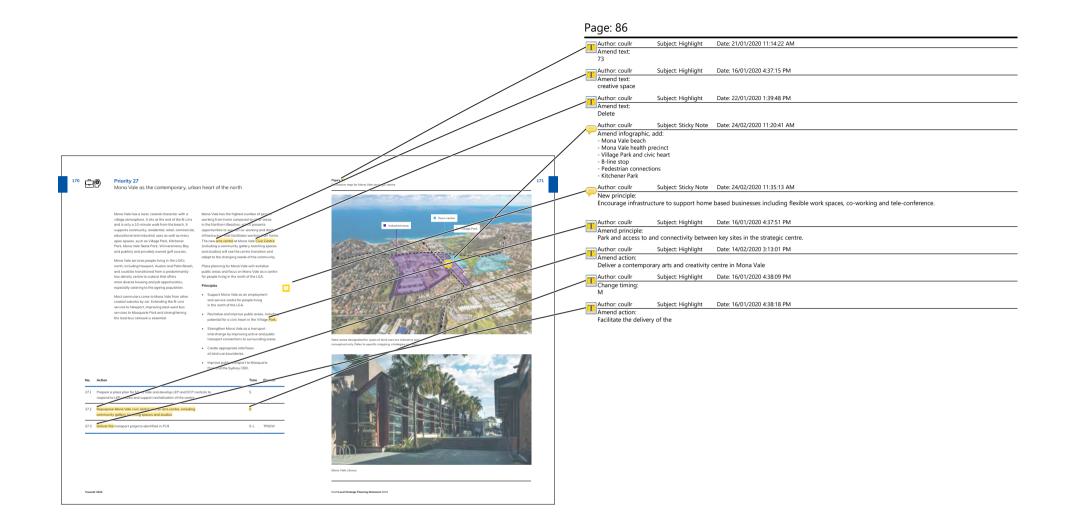


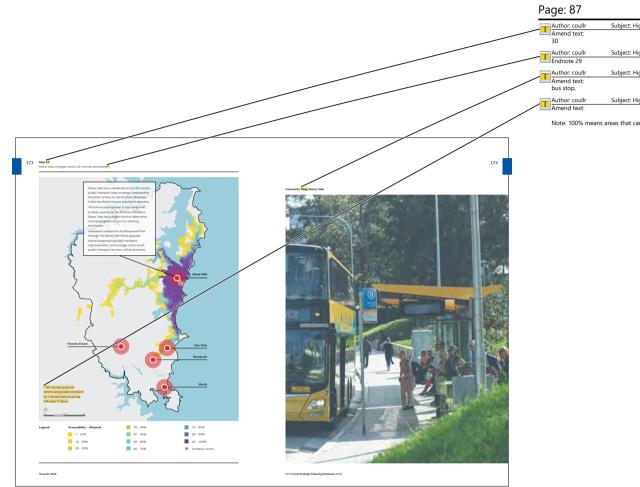



Page: 87		
Author: coullr Amend text: 30	Subject: Highlight	Date: 21/01/2020 11:14:17 AM
Author: coullr Endnote 29	Subject: Highlight	Date: 11/02/2020 3:25:48 PM
Author: coullr Amend text: bus stop,	Subject: Highlight	Date: 16/01/2020 4:38:51 PM
Author: coullr	Subject: Highlight	Date: 24/02/2020 11:35:37 AM


Note: 100% means areas that can access the centre within 30-minutes using public transport at 1 minute intervals during AM peak (7-9am)

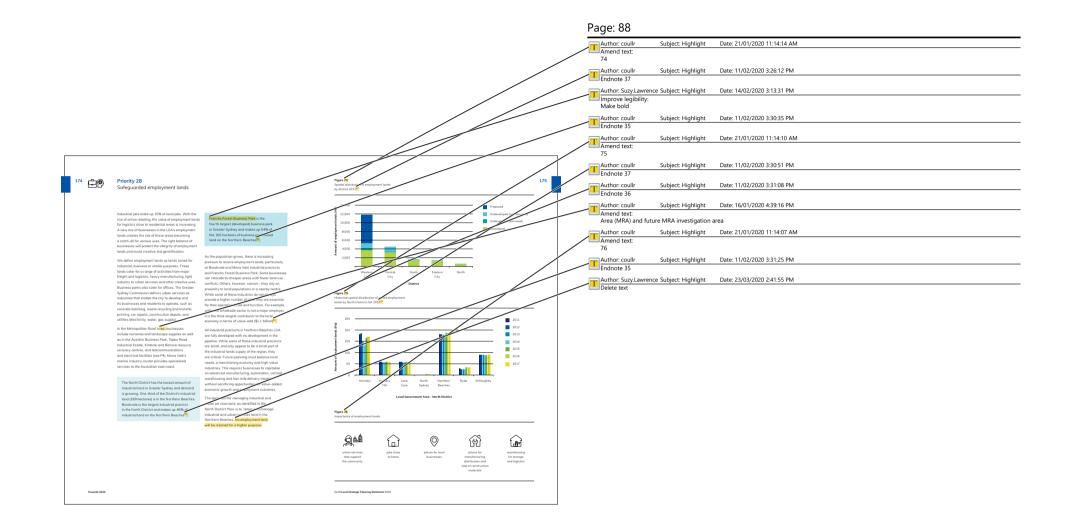


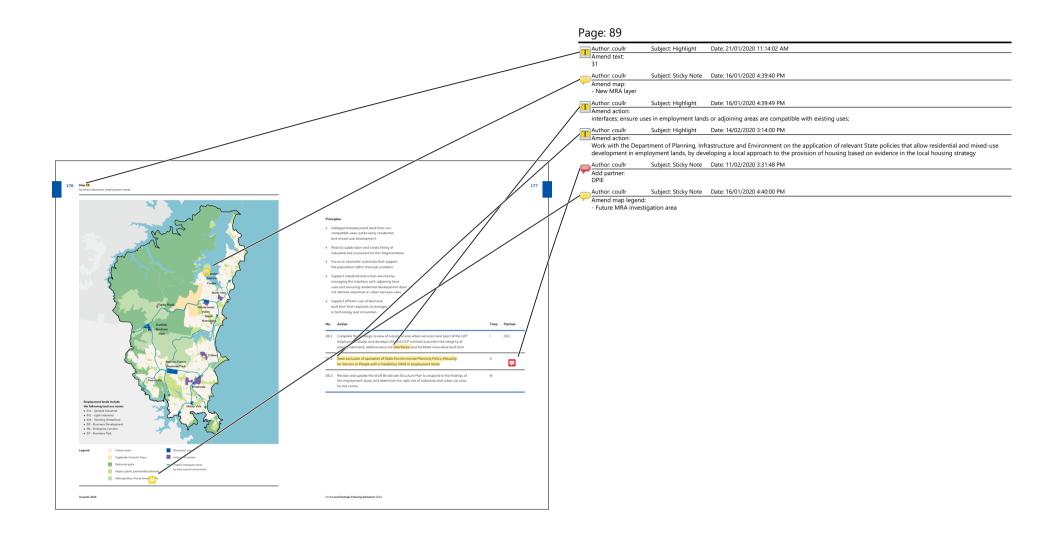


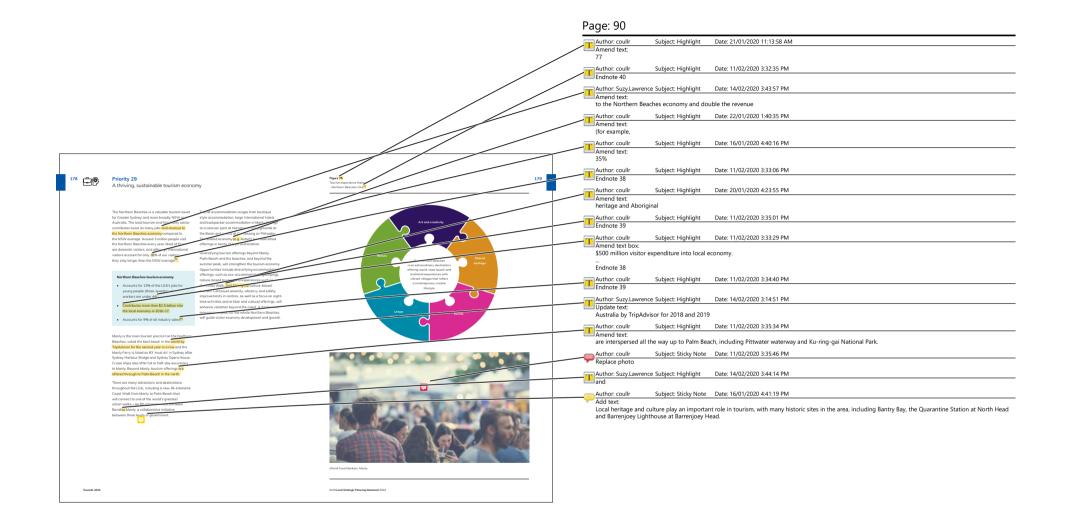


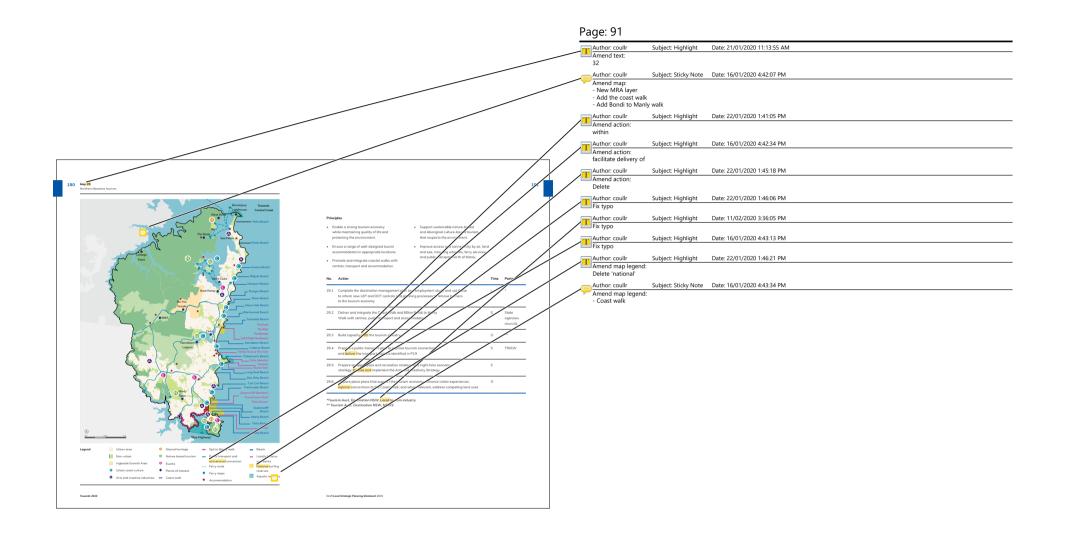

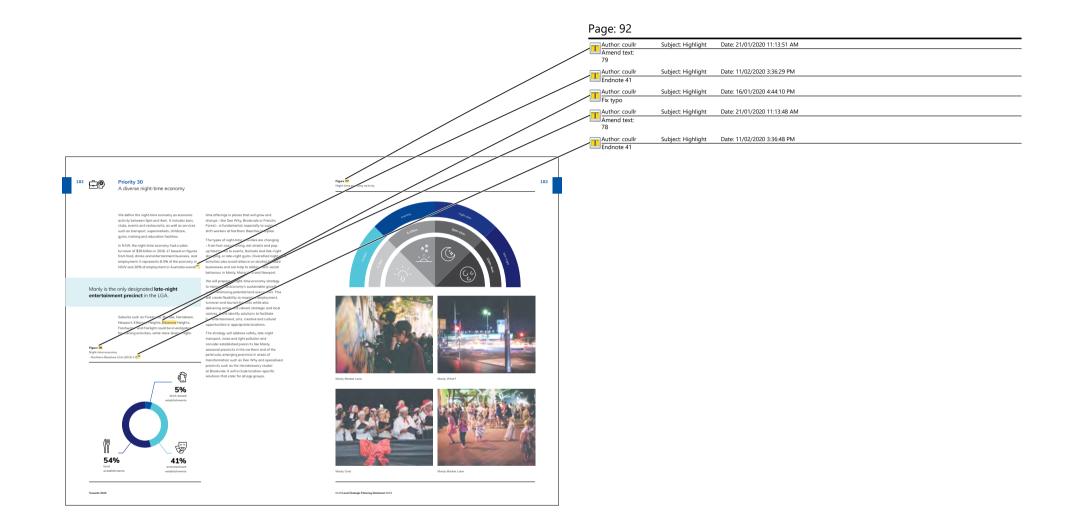

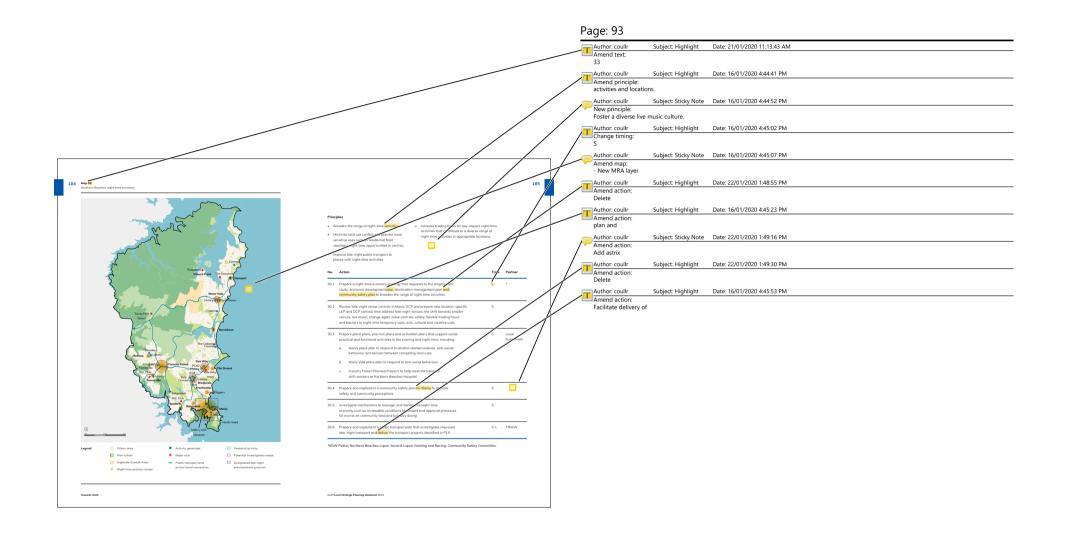

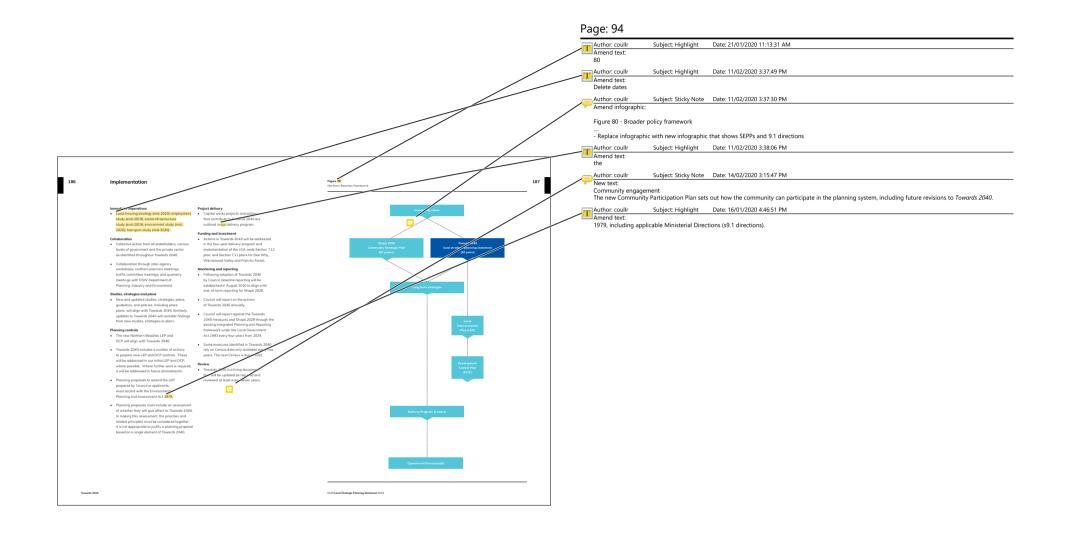

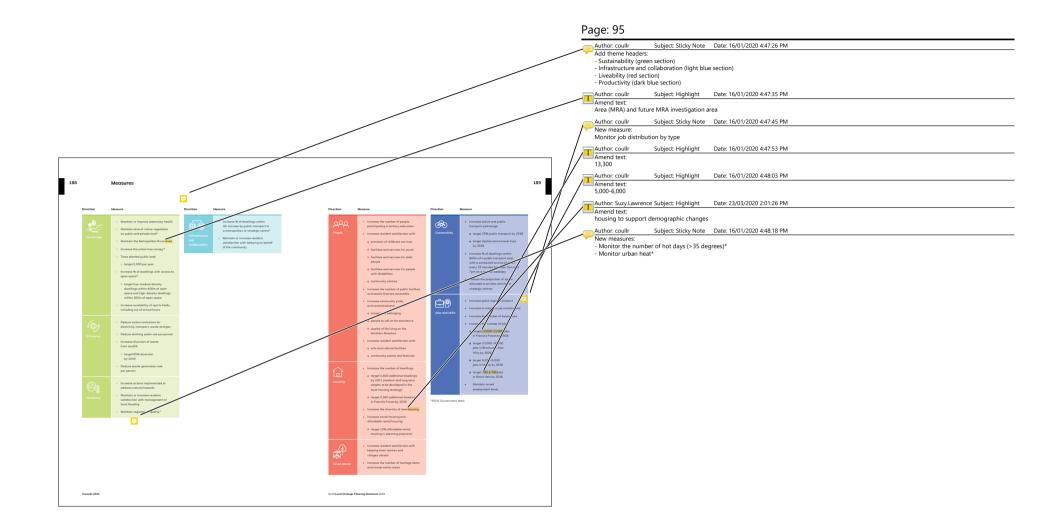


					F	Page: 96		
					-	-	Cubicato Chieles Nata	Date: 13/02/2020 1:53:06 PM
					<u>/</u>	Author: coullr	Subject: Slicky Note	Date: 15/02/2020 1.55.06 PM
						New terms: Demand manager influencing custom	nent is systems, process ers' choices about when	es and activities that are aimed at efficiently allocating available capacity to meet demand including by , where and how they travel.
						 Endnote 28		
						Smart city is a con utilities and improv		porates information and communication technologies (ICT) to enhance services such as energy, transport and
					·	Standard Instrum content for all LEPs		the Standard Instrument (Local Environmental Plan) Order 2006, which aims to achieve a common format and
								ditional linear economy (make, use, dispose) in which we keep resources in use for as long as possible, extract the
				/				en recover and regenerate products and materials at the end of each service life.
						Ped shed is short f straight line distand		thod used to determine the walkability of neighbourhoods by measuring the actual distance walked, not the
190	Glossary				191	Place-based infras is a strategic planni	structure compact ing model that looks ho	istically at a place to better align growth the provision of infrastructure and services.
				/				remains in the earth or in a mausoleum, crypt, vault, columbarium, niche wall or other structure designed for the
	30-minute city is a planning concept for a city in which people can easily access the	Employment lands are lands zoned for industrial,	Local government area (LGA) is the Northern Beaches Council administrative boundary.	Section 7.12 Plan allows ouncil to levy a contribution on new dovelopment under the EP&A				ment' applies to both cremated and uncremated remains.
	city in which people can easily access the places they need to visit on a daily basis	business or similar purposes in planning instruments. For the Northern Beaches, they		Act based on the apposed cast of works.		placement of such	remains. me term inter	ment applies to both cremated and uncremated remains.
	within 30 minutes travel (by public transport,	include the following land use zones: IN1	Low-corbon, high efficiency precinct focuses					
	walking or cycling) from where they live.	General Industrial, IN2 Light Industrial, IN4	on reducing the carbon footprint through	Social infrastructure includes hospitals, higher				aerial surveying method that measures distance to a target by illuminating the target with laser light and
		Working Waterfront, B5 Business Development,	integrating energy, water, waste, transport and	education institutions, open space, schools,		measuring the refle	ected light with a sensor	
	Active travel (transport) means trips by physical active means, like walking and	B6 Enterprise Corridor, B7 Business Park.	building efficiency, drawing on the National Corbon Offset Standard for Precincts	emergency services, cultural facilities, GPs and medical centres, multinumose facilities, libraries		5	5	
	cycling and other non-motorised vehicles.	Environmental Planning and Assessment	Carbon onset standard for Precincts.	local community facilities, childcare centres		Implied dwelling	requirement is a measu	re of likely housing demand based on projected population growth and household information. This differs from
		Act 1979 (EP&A Act) institutes the system of	Low Rise Medium Density Housing Code	and preschools, arts and creative facilities.				
	Biodiversity offsets compensate for how	environmental planning and assessment for NSW.	allows dual occupancies, manor houses and			market housing de	mand which relates to w	illingness/ability to buy or rent in the housing market.
	development impacts biodiversity through		terraces to be carried out under a complying	State Environmental Planning Policies	_			
	the Biodiversity Offset Scheme.	Freight hub is where deliveries can be consolidated	development approval if the proposal complies	(SEPPs) are legal planning instruments that		Author: coullr	Subject: Cross-Out	Date: 22/01/2020 1:50:44 PM
	Biodiversity stewardship sites (formerly known	for subsequent delivery into a centre either by	with all the relevant requirements in the State	set out controls for how land is to be used,		Amend text:		
	as biobanking) enable biodiversity credits to be	foot or appropriate smaller vehicle to reduce the number of vehicles travelling into centres.	Environmental Planning Policy (Exempt and Complying Development Codes) 2008.	they deal with matters of State or regiment		Delete		
	traded and used as an offset against the impact	number of vehicles traveling into centres.	Complying Development Codes) 2008.	enucle second pratining significance.		Delete		
	of proposed development on biodiversity values.	Freight includes goods or cargo transported by	Metronol Council	State Environmental Planning Policy No.70		Author: coullr	Subject: Highlight	Date: 22/01/2020 1:51:04 PM
	Building Sustainability Index (BASIX) is a NSW	truck, light commercial vehicles (eg. vans and	(MLALC) was established to support the	- Affordable Housing (Revised Schemes)			j	
	Government scheme to regulate the energy and	utes), cycle couriers, rail. <u>olerentra ange</u>	Aboriginal Land Rights Act 1983 to improve, rentert and faster the best interests of all	facilitates the development and maintenance		Amend text:		
	water efficiency of residential buildings.	Growth infrastructure compact is a new approach	Aboriginal people within the MLALC area and	of affordable housing in NSW.		neighbourhood cer	ntre	
		to an infrastructure delivery plan that is co-	other people who are members of the MLALC.	Strategic centres vary in size 1- coor and mix	_			
	Broad centre catchments are aggregations of ABS Statistical Areas Level 2 and have been used	designed and co-delivered by State and local		of activities. They knowle access to a range of		Author: coullr	Subject: Highlight	Date: 22/01/2020 1:51:16 PM
	ABS Statistical Areas Level 2 and have been used for reporting data in the demographic analysis.	governments-together-with industry-to-better	Neighbourhood centres are small clusters of	awas, services and inhe Alarthans Parada		Amend text:		
		align growth with infrastructure delivery.	of shops larger than a small neighbourhood	contains five strategic centres - Frenchs Forest,		(for example,		
	Community hubs support co-location of a range of	Company of an internationally recognised	of shops larger than a small neighbourhood and smaller than a local centre.	Brookvale, Dee Why, Manly and Mona Vale.		(ioi example;		
	community for its in a single to cation	sustainability rating system, which provides		Tertiary education is university, technical and		Author: coullr	Subject: Highlight	Date: 16/01/2020 4:49:58 PM
	e.g. social services, community centres, libraries, recreational opportunities, customer service).	independent verification of sustainable outcomes	Planned precincts are a collaborative planning	other vocational education and training, or TAFE.		Amend text:		
	recreasional opportunities, customer service).	throughout the life cycle of the built environment.	process between the NSW Government and	Heb I may be reput from past and present	- I			
	Community participation plan will make	Health and education precincts can form	councils to coordinate jobs, housing and infrastructure. Frenchs Forest is a	urban activities such as noise, air pollution		Phase One is a plan	ineu precinct.	
	it clearer and easier for members of the	parts of centres and include major hospitals,	planned precinct.	and soil contamination.	-	Author: coullr	Subject: Highlight	Date: 16/01/2020 4:51:03 PM
	community to understand how they can participate in planning decisions and addresses	universities and medical research institutions, and		Urban intensification means increasing urban			Subject: Highlight	Date: 10/01/2020 4.51.05 FM
	participate in planning decisions and addresses requirements for community participation	connect the community to health and education	Planning proposals are a request or	Urban intensitication means increasing urban activity in an area, for example through		Amend text:		
	that are set out in the EP&A Act.	services. Northern Beaches contains a health	intended effect of a proposed LEP or an	housing or job growth, increasing density and		Employment precin	icts (or hubs)	
		and education precinct at Frenchs Forest.	amendment to an existing LEP.	increasing the amount of these sevelopment.				
	Co-working spaces are shared workplaces	Hop Skip and Jump Bus service is a free	Public domain includes places accessible					
	that are used by professionals working in different knowledge related industries, often	community bus service that operates in Manly.	to the public, either on public or private	Urban renewal area is an area identified for				
	different knowledge related industries, often freelance and self-employed workers.	Local centres (also referred to as coastal and	land, and inclusive spain space, pedestrian	development opportunities and revitalisation.				
		Local centres (also referred to as coastal and forest villages) provide day-to-day access	access ways and features including building	Value-add represents the value that is added				
	Development Control Plan (DCP) contains detailed	to goods and services. Northern Beaches	frontages and awnings over footpaths.	of each industry sector to a defined region.				
	planning and design controls that support the	contains nine local centres	Section 7.11 Plan allows Council to levy	Voluntary Planning Agreement (VPA) is a				
	planning controls in a local environmental plan.	Warriewska, warrabeen, Beirose, Forestville,	a contribution for development under the	voluntary planning agreement between Council				
	Economic corridor includes multi-LGA services with	Manly Vale, Balgowlah and Freshwater.	EP&A Act that increases demand for public	and a developer to deliver public benefits.				
	a high concentration - joos, anking multiple centres.	Local environmental plan (LEP) guides planning	amenities and services to fund the provision					
		decisions at the local level through zoning	of new or augmented public infrastructure.					
	Employment precincts are areas where jobs are located, including centres, industrial	and development controls, which provide a						
	are located, including centres, industrial precincts and business parks.	framework for the way land can be used.						
	procession and transmission particular							
Towards 2040			Droft Local Strategic Planning Statement 2019					
L								

					Page: 97		
					Faye. 97		
					Author: coullr	Subject: Highlight	Date: 21/01/2020 11:13:26 AM
					Amend text:		
					2018h		
					Author: coullr	Subject: Sticky Note	Date: 28/02/2020 12:56:27 PM
					Add references:	ematoria NSW (2015) S	strategic Plan 2015-2020.
					/		-
					Cemeteries and Cr	ematoria NSW (2017) N	Aetropolitan Sydney Cemetery Capacity Report.
					Greater Sydney Co	mmission (2019) The P	ulse of Greater Sydney.
					Tourism Possarch	Australia (2010) Intern	ational Visitor Survey (IVS) and National Visitor Survey (NVS).
			/		Tourisin Research	Rustialia (2015) Interna	ational visitor survey (ivs) and ivational visitor survey (ivvs).
					Author: coullr	Subject: Highlight	Date: 11/02/2020 3:40:30 PM
					Amend text:	,	
					2018a		
192	References			193		nce Subject: Highlight	Date: 14/02/2020 3:16:15 PM
					Bush Fire		
					Author: coullr	Subject: Highlight	Date: 22/01/2020 1:51:36 PM
	Aboriginal Heritage Office (2019) Website.	Go Get (2015) – Surshare Report – Northern Benzie (Ianuary – October).	Metropolitan Local Aboriginal Land Council (2016) Community Land and Business Plan 2016-2021.	Vett-r and Belrose North - Cour I Meeting 27 March 2018, Agenda Item 3 1	Amend text: (2019g)		
	Australian Bureau of Statistics (2016) Census.	Government Architect NSW (2017a) Better Placed.	Northern Beaches Council (2013)	Northern Benzie Council (2018)	1		
	Australian Government (2017) National Carbon Offset Standard for Principal	Government Architect NSW (2017b)	Why Town Centre Most nan.	11000 Tree Canopy Plan (draft).	Author: coullr Amend text:	Subject: Highlight	Date: 16/01/2020 4:52:05 PM
	Australian Sustanable Built Environment Council	Greener Places (draft).	Norther-Seaches Council (2016) Attordable Housing Needs-Saysis	Northern Beaches Council (2019a) Clontarf Beach Landscape Master Plan (draft).	Connected through	Creativity 2029.	
	(2016) Carbon, High Performance Report.	Government Architect NSW (2017c) Sydney Green Grid North District Spatial	Northers Fisiaches Council (2017a)	Northern Beaches Council (2019b) Coast	Author: coullr	Subject: Highlight	Date: 21/01/2020 11:13:22 AM
	(2016-17) Night Time Economy Research.	Framework and Project Opportunities.	Artordable Housing Policy.	Walk Public Art Scoping Study.	Amend text:	,	
	Create NSW (2018) Cultural Infrastructure Plan 2025.	Government Architect NSW (2017d) Sciency Green Grid Spatial Framework and Dispect Opportunities	Northern Beaches Council (2017b) Brookvale Structure Plan (draft).	Northern Beaches Council (2011-1 Coast Walk Public Art 52: stegy.	2018a		
	Department of Planning and Environment (2016)	Government	Northern Beaches Council (2017c) Disability Inclusion Action Plan 2017-2021.	Northern Beost & Council (2014) Destination Menoperation ((north)	Author: coullr	Subject: Highlight	Date: 11/02/2020 3:41:00 PM
	Ingleside Draft Land Use and Infrastructure Strategy	Sourcement Architect NSW (2018b) Open	Northern Beaches Council (2017d) Frenchs	sorthern Bustnes Council (2019e) Protect	Amend text: 2018b		
	Department of Planning and Environment (2017) Low Rise Medium Departmy Design	Space for Recreation Guide (draft).	Forest Hospital Precinct Structure Plan.	Courter, Live: Northern Record and anominent			
	Guide for Complying Development.	Government Architect NSW (2018c) Urban Tree Canopy Guide (draft).	Northern Beaches Council (2017e) Sportsgrounds Strategy	Northern Britishe Council (2019) Walking Plan.	Author: coullr Amend text:	Subject: Highlight	Date: 21/01/2020 11:13:18 AM
	Department - Hanning and Environment [2018] Bushfire Risk Assessment for	Greater Sydney Commission (2017)	Northern Beaches Council	NSW Aboriginal Land Council (2018)	2018b		
	the Ingleside Planned Precinct.	Values of the Metropolitan Rural Area of the Greater Sydney Transition	and Creativity Strategy, Connected Community 2028 (draft).	Strategic Plan 2018-2022.	Author: coullr	Subject: Highlight	Date: 21/01/2020 11:13:14 AM
	Department of Planning and Environment (2019) Local Character and Place Guideling	Greater Sydney Commission (2018a) Greater	Northern Beaches Council (2018b) Asset	NSW Government Charl Biodiversity Commutation Act 2016.	Amend text:	220ject rightight	
	Deportment	Sydney Region Plan 'A Metropolis of Three Cities'.	Management Strategy 2018–2028. Northern Beaches Council (2018c) Shape 2028	NSW Office of Environment and Heritory Televil	2018c		
	[2018] Employment Lands Development Monitor.	Greater Sydney Commission (2018b) North District Plan.	Northern Beaches Council (2018c) Shape 2028 - Community Strategic Plan 2018–2028.	NSW Urban Heart and Modified Mesh Block.	Author: coullr	Subject: Highlight	Date: 21/01/2020 11:13:10 AM
	Cabinet (2016) Smart Cities Plan.	Green Building Council of Australia (2018) Carbon Positive Roadman.	Northern Beaches Council (2018d) Delivery Program 2018-2021 - Operational Plan and Budget 2018-19.	Environment Protection Authority (2017) Rick Descri	Amend text:		
	Economy JD (2019a) National Economic Indicators Series 2017-18.	(2018) Carbon Positive Roadmap. Kinesis (2018) Northern Beaches Council	2018-2021 - Operational Plan and Budget 2018-19. Northern Beaches Council (2018e) Freshwater	Framework - Bernholl mig Waterway Health Outcomes in Strategic Land-use Planning Decisions.	2018d		
	Economy JD (2019b) Northern	Carbon Emissions and Water Analysis.	Constal Onen Sonce Mostemion - Council	NSW Rurol Fire Service (2018) Planning for Ruch	T Author: coullr	Subject: Cross-Out	Date: 22/01/2020 1:51:52 PM
	Beaches Economic Profile.	KJA (2019) Northern Beaches Local Strategic Planning Statement – Engagement Summary Report.	Meeting 28 May 2019, Agenda Item 9.3. Northern Beaches Council (2018) Move –	Fire Protection, A Guide for Councils, Planners, Fire Authorities and Developers Pre-Release Issue.	Amend text: Delete		
	Economy .ID (2019c) Northern Beaches Tourism and Hospitality Value 2017-18.	Planning Statement – Engagement Summary Report. Maniy Council (2015) Maniy 2015 Master Plan.	Northern Beaches Council (2018t) Möve – Northern Beaches Transport Discussion Paper.	Parliament of Australia (2016) Blocking			
	Ethos Urban and Otium Planning Group (2019)	Meridian Urban (2019) Northern Beaches - Planning	Northern Beaches Council (2016g)	and Moving Out – Inquiry into the Australian Government's Role in the Development of Cities.	Author: coullr Amend text:	Subject: Highlight	Date: 21/01/2020 11:13:04 AM
	Northern Beaches Social Infrastructure Study – Issues and Opportunities Background Paper.	for our Environment – Background Paper.	Northern Beaches Council (2020)	Pendleton, J (2019) Northern Beloch	2018e		
	appendies and appendies of the	Metropolitan Councils of Sydney (2018) Resilient Sydney – A Strategy for City Resilience.	Proposal – Deferred Lands in Oxford Falls	Community Engagement Analysis.	Author: coullr	Subject: Highlight	Date: 21/01/2020 11:13:00 AM
					Amend text:	subject. Ingringht	one. En on colo ministro num
					2018f		
					Author: coullr	Subject: Highlight	Date: 21/01/2020 11:12:55 AM
					Amend text:		
Towards 2040			Droft Local Strategic Planning Statement 2019		2018g		
L					-		

			Page: 98
			Amend endnote:
			Add sentence to endnote - Population projections within this Analysis are based on Transport for NSW's Travel Zone Projections 2016 version 1.51 (TZP2016v1.51), Population in Occupied Private Dwellings (POPD).
			Author: coulir Subject: Highlight Date: 11/02/2020 3:45:44 PM Amend text: 22
			Author: coullr Subject: Highlight Date: 21/01/2020 11:12:45 AM Amend Text:
			2019g Author: coulir Subject: Highlight Date: 11/02/2020 3:46:26 PM Author: coulir Subject: Highlight Date: 11/02/2020 3:46:26 PM
			23 Author: coullr Subject: Highlight Date: 16/01/2020 4:52:38 PM Author: coullr Subject: Highlight Date: 16/01/2020 4:52:38 PM
194	References (continued)	Endnotes All statistics in this report are fm/n SGS Economics and Planning (2019) Northy: Beaches Demographic	Instance Law Note: workforce data based on Australian Immed Author: Suzy-Lawrence Subject: Highlight Date: 28/02/2020 12:55:49 PM
	Phillips KPA (2019) Status Report for University RFP: Placescore (2019) Northern Beaches	Analysis, unless otherwise referenced.	Amend endnote: Add sentence to endnote - Housing growth projections within this document (Local Housing Strategy - Housing Issues and Opportunities Paper) are based on the DPIE population projection 2016. Note the housing demand to 2036 (implied dwelling target) was updated from 11,267 to 11,747 dwellings since publication to account for potential vacancies in private dwellings.
	LSPS insights Report. Resilient Sydney (2018) A Strategy for City Resilience. Rodo and Ministine Services (2028)	Adapted from Greater System Commission (2018) Adapted from SGS 10-cond Commission (2018) Adapted from SGS 10-cond Adapted from SGS 10-cond Cond from KA+1-cond	Author: coullr Subject: Highlight Date: 11/02/2020 3:39:37 PM
	Beaches Link Turnel Project Update. Proofs and Maritime Services (2019) Syndry 1000 Mittime Kanvice.	- Examinity 20 (2013) - Examinity 20 (2013) - Reserve and Environment of Heritage and NSW Environment Protection Authority (2017) and Environment 2019	2019a mail Author: coullr Subject: Highlight Date: 11/02/2020 3:48:02 PM
	SGS Economics and Planning (2018) Greater Sydney Commission - Employment Lands Analysis. SGS Economics and Planning (2019a)	Council Angeleta by Northern Beaches Council and the Environmentation: com	Autor total subject figing to back fight bac
	Northem Beaches Demongraphic Analysis. SGS Economics and Polinaring (2019 BN Northern Beaches Employment Study – Beachground Report.	Marine Estate Management Strategy (2018-2028) water youthy initiative Adopted from Government Architect ISNV (20174) Vorteming County (2018)	Author: coullr Subject: Highlight Date: 11/02/2020 3:39:54 PM Amend text: 2019b
	SG5 Examinis and Planning 2003ct Northern Blechte Local Houring Stantay - Houring Isuae and Opportunities Paper. Sydney North Pinnary Health Network	¹ Jainty prepared with Maridan Lirban (2019) ⁴ Spatial data from Council's Geographical Information System and demographic data from Linderic Biotecies Advanty Transport Tab State (2016)	Author: coullr Subject: Highlight Date: 21/01/2020 11:12:38 AM Amend text: 2018f
	(2018) Northern Beaches Local Government Area Health Profile. Tohe, H (1997) Lihoon Climates and Heat Islands: Alabeé, copotranspiration.	DOISE Cansular de anticipation de la construction de la construct	Author: coulir Subject: Highlight Date: 11/02/2020 3:49:02 PM Amend text: 25
	and Anthropopenic Heat. Transport for New South Walas (2008) Future Tansport 20056. Transport for NSV (2018) Open Data Hula.	Government Architect ISSW (DDBc) and the first of the second seco	Author: coullr Subject: Highlight Date: 11/02/2020 3:49:36 PM Amend text: 26
		Adaptet frem Ethou Union and Otium Phanning Group (2019) Kneeks (2018) Kneeks (2018)	Author: coullr Subject: Highlight Date: 11/02/2020 3:50:29 PM Amend text:
		Realisert Sydrey (DDB) Publics (TSA (2016) Philips (TSA (2016) Sydrey North Primary Health Network (DDB) Sydrey North Primary Health Network (DDB)	27. Roads and Maritime Services (2019a) Author: coullr Subject: Highlight Date: 11/02/2020 3:51:21 PM Amend text:
			29 Author: coullr Subject: Highlight Date: 21/01/2020 11:12:21 AM Amend Text:
Towards 2040		"Incogen within P2 credits: B. Fallowfield, E. Ceffer, K. Korg, J. Taylor, and K. Wattaan DruthLood Restroyic Planning Restroment 2019	2018e Author: coulir Subject: Highlight Date: 11/02/2020 3:52:21 PM Author: coulir Subject: Highlight Date: 11/02/2020 3:52:21 PM
			Author: coullr Subject: Highlight Date: 11/02/2020 3:52:39 PM
			31 Author: coullr Subject: Highlight Date: 11/02/2020 3:59:01 PM Amend text:
			28 Muthor: coullir Subject: Highlight Date: 11/02/2020 3:54:42 PM Author: text:
			32 Author: coullr Subject: Highlight Date: 11/02/2020 3:55:54 PM Amend text:

Comments from page 98 continued on next page

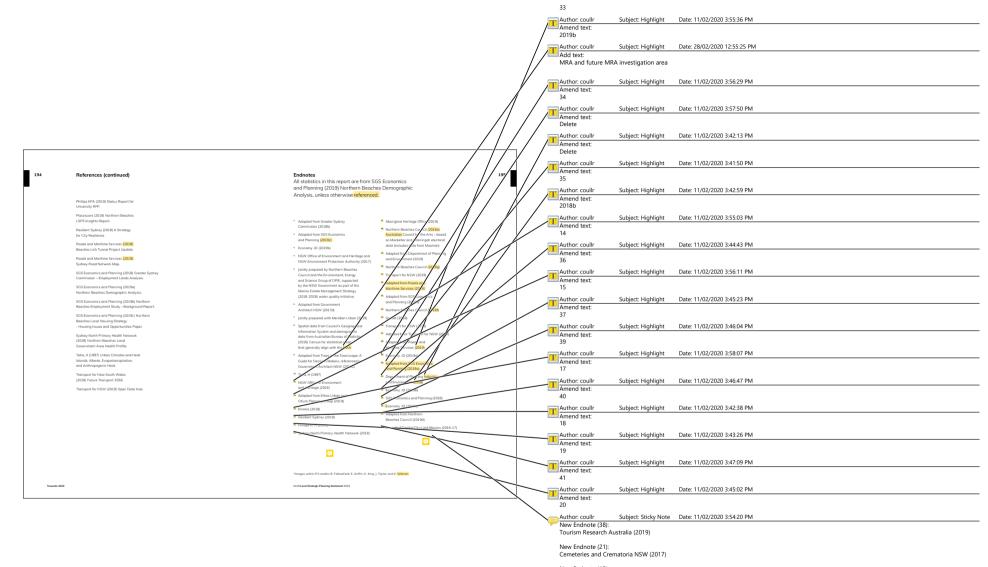

New Endnote (12): Government Architect NSW (2017b)

New Endnote (11)

Greater Sydney Commission (2019)

Comments from page 98 continued on next page

New Endnote (13) 2019 LiDAR data analysis of Northern Beaches tree canopy coverage

New Endnote (16)

2019 spatial analysis of access to Northern Beaches open space using buffer areas

Author: coullr Subject: Sticky Note Date: 11/02/2020 4:00:20 PM Add version control table

195

mics


y Lord Mayors (2016-17)


Author: Suzy.Lawrence Subject: Highlight Date: 14/02/2020 3:44:59 PM

Amend text: Watson and P8: J. Grainger

194 References (continued) Endnotes All statistics in this report are from SGS Economics and Planning (2019) Northern Beaches Demographic Analysis, unless otherwise <mark>referenced.</mark> Phillips KPA (2019) Status Report for University RFP. Placescore (2019) Northern Beaches LSPS Insights Report. Aboriginal Heritage Office (2019) Adapted from Greater Sydney Commission (2018b) Northern Beaches Council (2018a) Australian Council for the Arts – base on Mackellar and Warringsh elector data (includes data from Mosman) Resilient Sydney (2018) A Strategy Adapted from SGS Economics and Planning (2019c) for City Resilience. Roads and Maritime Services (2018) Beaches Link Tunnel Project Update. * Economy .ID (2019b) Adapted from Department of NSW Office of Environment and Heritage and NSW Environment Protection Authority (2017) Roads and Maritime Services (2019) Sydney Road Network Map. and Environment (2019) Northern Beaches Council 4 Jointly prepared by Northern Beaches SGS Economics and Planning (2018) Greater Sydney Commission – Employment Lands Analysis. Transport for NSW (20) Council and the Environment, Energy and Science Group of DPIE, supported by the NSW Government as part of the Adapted from Roads Maritime Services (2) SGS Economics and Planning (2019a) Northern Beaches Demographic Analysis. Marine Estate Management Strategy (2018-2028) water quality initiative * Adapted from SI SGS Economics and Planning (2019b) Northern Beaches Employment Study – Background Report. and Planning (20) Adapted from Government Architect NSW (2017d) Monthern Ber es Council (2018) SGS Economics and Planning (2019c) Northern Beaches Local Housing Strategy - Hausing Issues and Opportunities Paper. ³ Jointly prepared with Meridian Urban (2019) K Go Get (2) Spatial data from Council's Geographical Information System and demographic data from Australian Bureau Statistics (2016) Canus for statistical areas that generally align with the MRA × Transp 107 NSW (2018) × Ado Sydney North Primary Health Network (2018) Northern Beaches Local Government Area Health Profile. um Transnort for NS Adjusted from Roads and Miritime Services (2019) Toha, H (1997) Urban Climates and Heat Islands: Albedo, Evapotranspiration, and Anthropogenic Heat. * Adapted from Trees in the Townscape: A Guide for Decision Makers, referenced in Government Architect NSW (2018c) 10my JD (2019a) Idented from EGE Eco Planning (2019a) Transport for New South Wales (2018) Future Transport 2056. " Taha, H (1997) Department of Planning and Environment (2018) NSW Office of Environment and Heritage (2016) Transport for NSW (2019) Open Data Hub Sconomy .ID (2019b) Adapted from Ethos Urban and Otium Planning Group (2019) SGS Economics and Economy .ID (2019c Kinesis (2018) Adapted from N Beaches Counci Resilient Sydney (2018) Phillips KPA (2019) 🛎 Council of Capit K Sydney North Primary ork (2018) . . *Images within P2 credits: B. Fallowfield, E. Griffin, K. Kina, I. Tavlor, an Towards 2040 Droft Local Strategic Planning Statement 2019

This page contains no comments

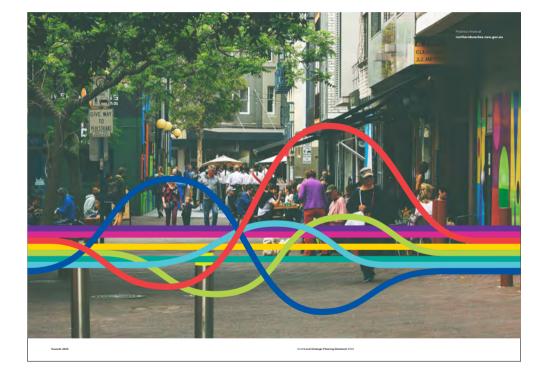

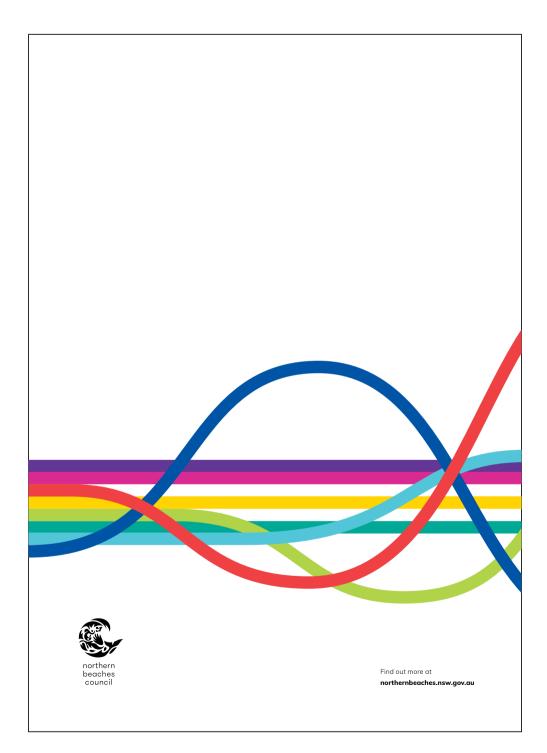

This page contains no comments