
Sent: 17/04/2020 3:16:06 PM

Subject: Submission for DA2020/0302

Attachments: Letter in relation to DA 2020 0302 17042020.pdf; 41Clifford review DA.pdf; uppercliffordsketchideas.pdf; Quadroparker-n4902.pdf;

Dear Sir / Madam,

Attached is a letter and some supporting documents in relation to DA2020/0302, at 41 Upper Clifford Avenue, Fairlight. Can you please add this to the submissions for the DA.

Please feel free to contact me at this email address (graemerplowman@gmail.com).

Graeme

Graeme Plowman and Jo-ann Plowman
46 Upper Clifford Avenue
Fairlight
New South Wales
2094

Northern Beaches Council
By email

17 April 2020

Dear Sir / Madam,

Thank you for the notification in relation to DA2020/0302, at 41 Upper Clifford Avenue, Fairlight, and the opportunity to respond to this application.

We live at 46 Upper Clifford Avenue (UCA). The proposed DA would cause significant view loss from our house of Middle Harbour, Sydney Harbour and South Head. This would significantly reduce both our enjoyment of living in the property and its market value, given these are iconic views. This is our main objection to the DA.

Prior to outlining our objections to the DA, we also highlight a number of omissions within it. These make it impossible for us to determine with any certainty the actual impact it will have on us.

1. Information missing from the DA

We have noted the following missing information and potential non-compliances in the DA (for reference, please see comments on the attached plans):

- Floor Plans: Ground RL's are not shown on any plans.
- Roof Plan DA12: The ridge and parapet heights are not shown. This is a major omission that undermines our ability to establish the finished RL's and their impact on our view.
- Existing Garage / new Unit 1 Garage: there are inaccuracies in the height of the existing garage and inconsistencies in the height of the proposed new garage throughout the plans and view analysis. This is outlined in more detail in section 2 of this letter.
- Elevations and Sections:
 - No RL's or heights are shown at roof ridges, parapets or tops of walls. This makes it impossible to know whether the development complies with existing height restrictions.
 - Very few RL's of the existing ground level are shown. This makes it impossible to confirm whether the height limit is correct.
 - An outline of the existing buildings is not shown – this also makes it difficult to check the ground heights shown and resolve existing versus proposed conditions.
 - Section DA23: the excavation does not comply with the 8.5m height limit by 2.5m, as height limit is attached to existing ground levels and not to excavated new ground levels.
- Demolition Plans: these are not shown for the existing plans.

2. View loss from our house

Notwithstanding the omissions in the DA highlighted in section 1, we outline in this section the implied impact on our ocean views with the information that does exist within the DA.

(a) View loss caused by building heights

We note from the Statement of Environmental Effects (section 4.2.1.3) that the applicant acknowledges the need to protect the ocean views from our house and those at 43 UCA. Based on the View Analysis in the Master Set of Plans, the Statement of Environmental Effects also concludes in section 4.2.1.3 that “the design achieves a view sharing outcome by maintaining existing whole views from these properties towards Middle Harbour and its surrounding land / water interface”. Unfortunately, this is not correct for the following reasons:

- i. The photo on View Analysis Sheet 01 in the Master Set of Plans is taken from the western edge of our property (and, it appears, from a low height on our terrace). This is misleading and significantly understates the view loss from our house.
- ii. The black outline in this photo implies that the roof of the new garage in Unit 1 will go up to the top of the windows in the garage at 39 UCA, with the roof of the living area in Unit 1 just below this. This would devastate the view from our house, taking over 80% of our ocean views across the Harbour to South Head.
- iii. Even if the new garage is only built to the height of the existing garage at 41 UCA, as implied on page 16 of the Master Set of Plans, this would still take over half of our ocean view to South Head (due to the move to a double garage and the living area of Unit 1).

The photos below demonstrate these three points.

- **The current view from the middle of our property (at terrace / living area height)**



- **View Analysis Sheet 01 from the Master Set of Plans – submitted by the applicant**



- **View loss from our house implied by ‘View Analysis Sheet 01’ in the Master Set of Plans**

The photo below shows the actual view loss due to a double garage with a roof up to the top of the windows of the garage at 39 UCA, with the entrance hall behind it, and the western half of the living area set back and slightly below this. This is considerably different to the view analysis submitted by the applicant.

The white dotted line represents the normal height of the trees in the middle of UCA, which have not been trimmed for some time. Anything above this line is therefore temporary view loss that would be turned into permanent view loss by the living area of Unit 1.




- **View loss from our house implied by page 16 in the Master Set of Plans**

This would be the view loss due to a new double garage at the height of the existing garage at 41 UCA, with the entrance hall behind it, and the western half of the living area set back and slightly below this. Even at this lower height, it would still take over half of our ocean view to South Head.



- **Further inconsistency on page 17 of the Master Set of Plans – submitted by the applicant**


We would also like to highlight an additional inconsistency in the implied height of the new garage. On page 17 of the Master Set of Plans, it also suggests that the new garage would be built up to the height of the existing garage at 41 UCA. However, the drawing over states the height of the existing garage by approximately 50 centimetres. This would cause even greater view loss than in the image directly above.

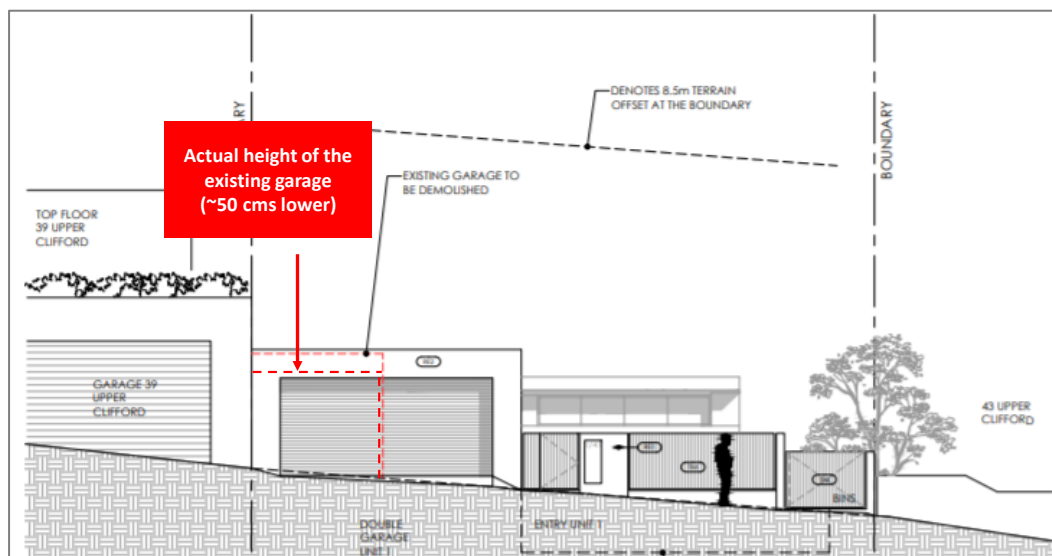

(b) View loss caused by new trees

As part of the development the applicant would remove some existing trees and plant some new ones, principally along the western edge of the property. This has the potential to cause significant additional view loss to us. We also believe this would cause significant view loss to the properties at 48 and 50 UCA, as the trees would be in their direct line of sight across the Harbour.

We estimate that trees just four metres above UCA street level would eliminate our view across to South Head. The trees at 43 UCA show the major impact they can have on view loss.

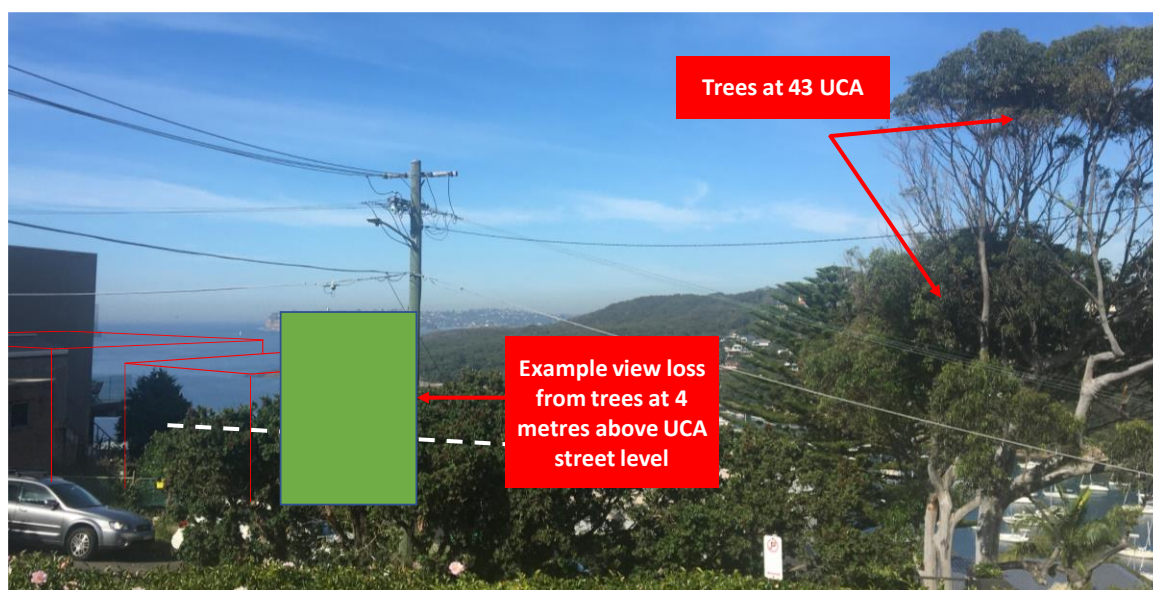

3. Public view loss from Upper Clifford Avenue and Ashley Parade

Upper Clifford Avenue and Ashley Parade receive a significant amount of foot traffic. This is not only local residents, but also members of the general public on their way to Manly or heading westwards to nearby areas like North Harbour Reserve. We would like to highlight that the DA would have a significant impact on iconic Harbour views for the general public. This is not the case at 43 UCA which has a much lower frontage onto UCA.



We also note that the owners of Unit 1 would have to walk outside along the footpath to put rubbish in their bins. We believe this can be amended to provide a friendlier street design.

4. Requests of the Council

We hope we have demonstrated that the proposed DA would cause substantial view loss from our house and is not consistent with the view sharing principles established in *Tenacity Consulting Pty Ltd vs Warringah Council* [2004] NSWLEC140. This would significantly reduce both the enjoyment of living in our home and its market value.

The proposed move from a single garage to a double would be a major cause of view loss for us. The lift core overrun also adds significant site bulk. The extent of our view loss is very sensitive to changes in the height of the garage / living area in Unit 1 – for example, the difference of around one metre in height results in either minimal view loss or devastating view loss. This shows that small changes to the design of the garage and living area of Unit 1 could alleviate our view loss.

Requests of the Council

- (a) We request that the plans be resubmitted to include the missing information that was highlighted in section 1 of this letter. Of particular importance to us are the Unit 1 garage, building and lift overrun heights.
- (b) We request that the applicant be required to provide certainty of the heights above UCA street level for the garage and the living area of Unit 1 (including the lift overrun):
 - i. With respect to the height of the new garage, this should also be made with reference to the garage at 39 UCA as this will not change during the build process.
 - ii. With respect to the living area and lift overrun of Unit 1, this should also be made with reference to the roof height of the new garage.
- (c) We request that the Council does not approve any plans that reduce the ocean views from our house, as only minor changes to the height of the frontage onto UCA would be required to avoid this. This could be done in a number of ways:
 - i. By exploiting the voids below Unit 1 and / or excavating deeper into the land to lower the height of the development so that it has no or minimal frontage onto UCA. This is the case at 43 UCA which also has three units; or
 - ii. By retaining a single-width garage in the same place as the existing garage but moving to a car stacker to provide two spots. This would remove the need for a double-width garage which is what causes a large part of the view loss for us. Movement of the position of the lift with the resulting overrun would also assist. Please see attached sketch designs for some potential design modifications to suit and information on a suitable type of car stacker; or
 - iii. By adopting a similar design to that at 43 UCA, with a driveway on one side of the property and garage within the building structure.
- (d) In respect of the new trees which will be planted, we request that:
 - i. No trees be planted with a maturity height that will exceed the roof height of the unit next to which they are situated; and
 - ii. Given the potential for tree maturity heights to be unpredictable, an obligation be placed on the owners of the units to maintain tree heights as per 4(d)(i).

- (e) We request that a case manager be assigned to this DA, given the significant number of local properties affected by it. Ideally the case manager would meet with affected property owners individually on location to witness their concerns (with appropriate social distancing).
- (f) Before any plans are approved by the Council, we request that the applicant be obligated to erect sight poles of the draft designs so that we can accurately understand the view loss. It is very challenging to be confident of the DA's impact on ocean views without a physical structure in place, given the sloping land and when the view loss is impacted by the height, length and width of the various buildings.




Finally, we would like to make it clear it is not our wish that any DA of this nature be prevented. Not only do we respect the right of the owners to develop the land, but we believe it can (with the right design that minimises any view, light and privacy loss for local properties) improve the neighbourhood and add value to the local area.

In that vein, we are happy to engage with the council and the applicant in the hope of coming to an acceptable outcome for all stakeholders.

Yours faithfully,

Graeme Plowman

Jo-ann Plowman

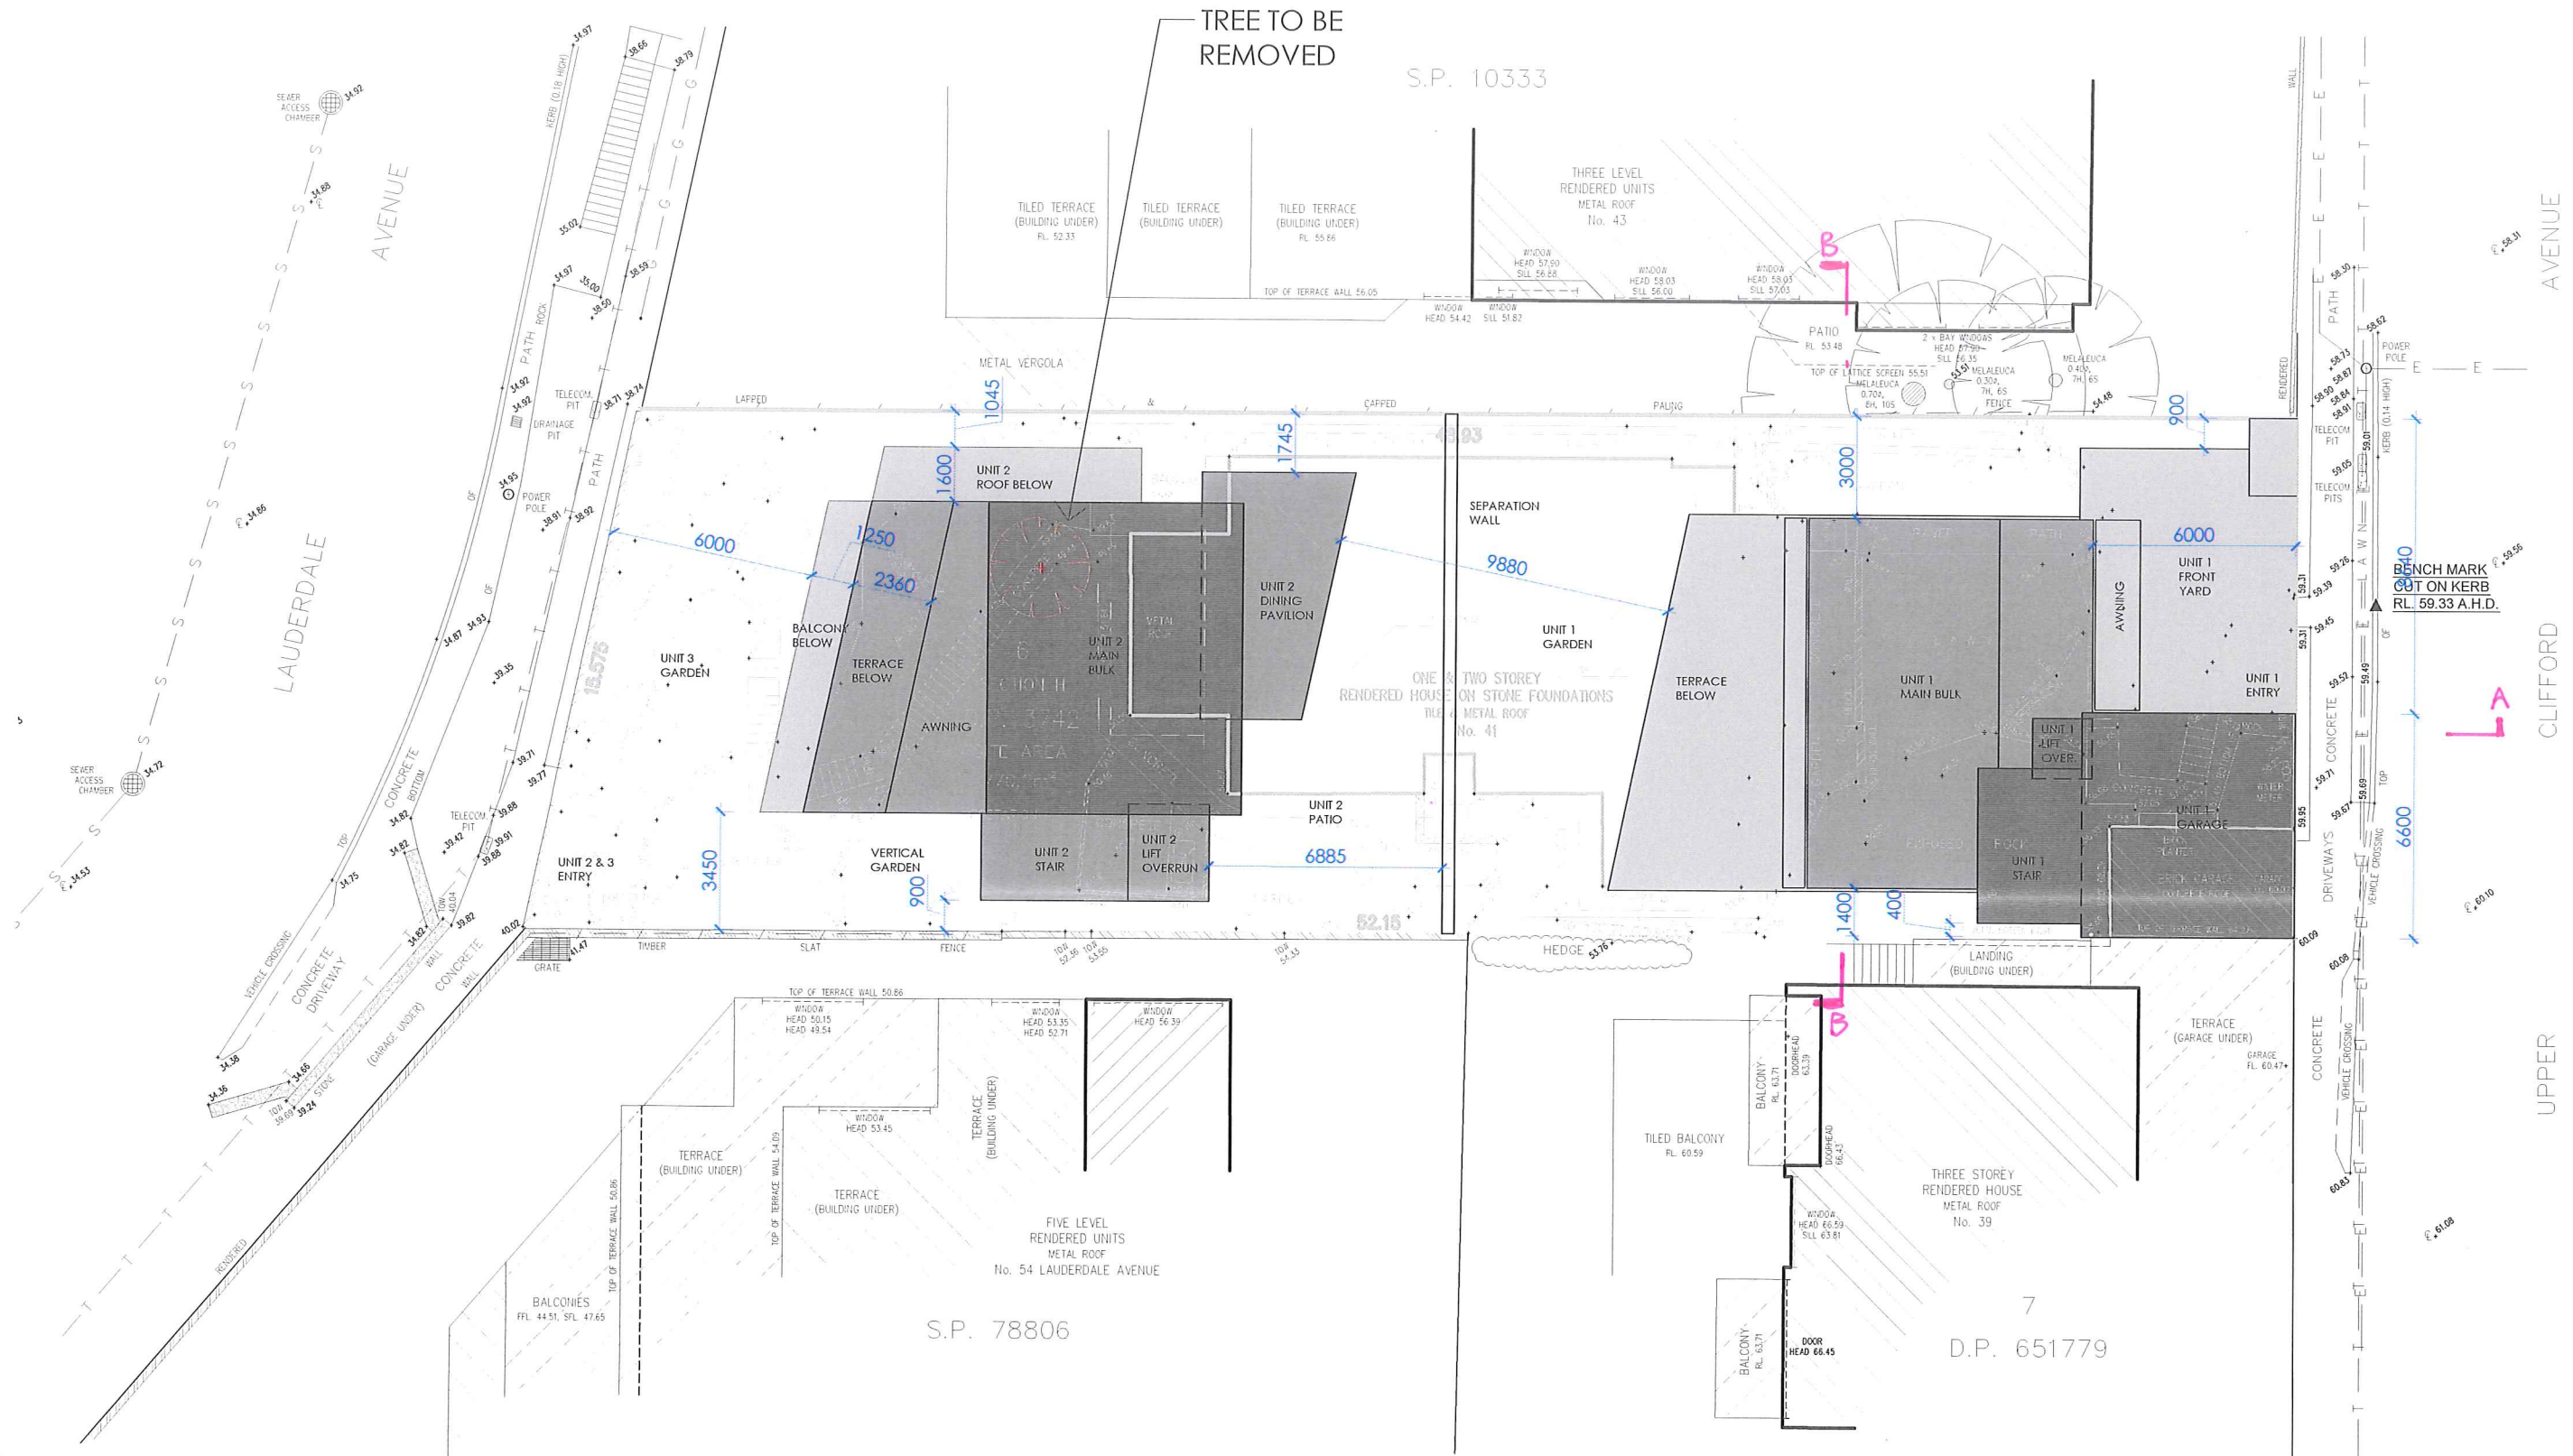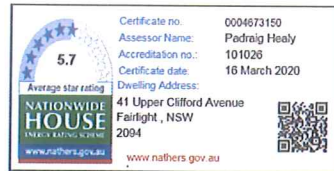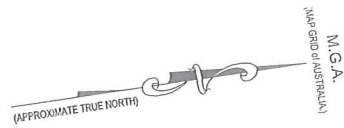

IMPORTANT NOTES:
Do not scale from drawings. Use figured dimensions only. Ensure that the drawings used carry the latest revision no. Read in conjunction with consultant engineers drawings - refer contract drawing list.

- All dimensions to be checked on site before commencement of work.
- All discrepancies to be brought to the attention of the Architect.
- Larger scale drawings and written dimensions take precedence.

This drawing is copyright and the property of the author, and must not be retained, copied or used without the express authority of Platform Architects Pty Ltd.

REV	DATE	DESCRIPTION	BY
B	2019.07.22	PRELIMINARY	OH
C	2019.07.31	PRELIMINARY	OH
C	2019.08.15	PRELIMINARY - LAYOUTS UPDATE	OH
D	2019.09.20	FOR PRELODGEEMENT MEETING	OH
E	Dec '19	CONSULTANT COORDINATION	OH
F	Mar '19	FOR DA LODGMENT	OH


REVISION NOTES
FOR DA LODGMENT
NOT FOR CONSTRUCTION

platform
ARCHITECTS

Suite 503, 37 East Esplanade Manly 2095
p. 02 9976 6555 abn. 74502855157
www.platformarchitects.com.au

PROJECT DETAILS
DUAL OCCUPANCY WITH BASEMENT CARPARKING
AND SINGLE DWELLING AT
41 UPPER CLIFFORD AVE
FAIRLIGHT NSW 2094

CLIENT
CARLOSCAR PETERSON AND HEATHON FAMILY INVESTMENTS PTY LTD,
643 MILITARY ROAD MOSMAN NSW 2088

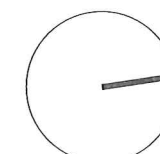

DRAWING TITLE
SITE PLAN


SCALE
1:100
@A3

STATUS
DA

NUMBER
01

PROJECT
UCS

REVISION
F

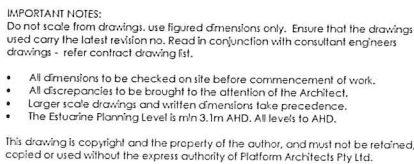


REVISION NOTES

FOR DA LODGEMENT
NOT FOR CONSTRUCTION






CLIENT
CARL OSCAR PETERSON AND HEATON FAMILY INVESTMENTS PTY LTD,
643 MILITARY ROAD MOSMAN NSW 2088

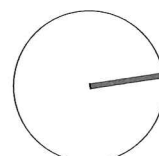

SCALE	STATUS	NUMBER
1:100 @A3	DA	08

REVISION
F

TERRACE
(G UNDER)
TILED TERRACE
(BUILDING UNDER)
RL. 55.86

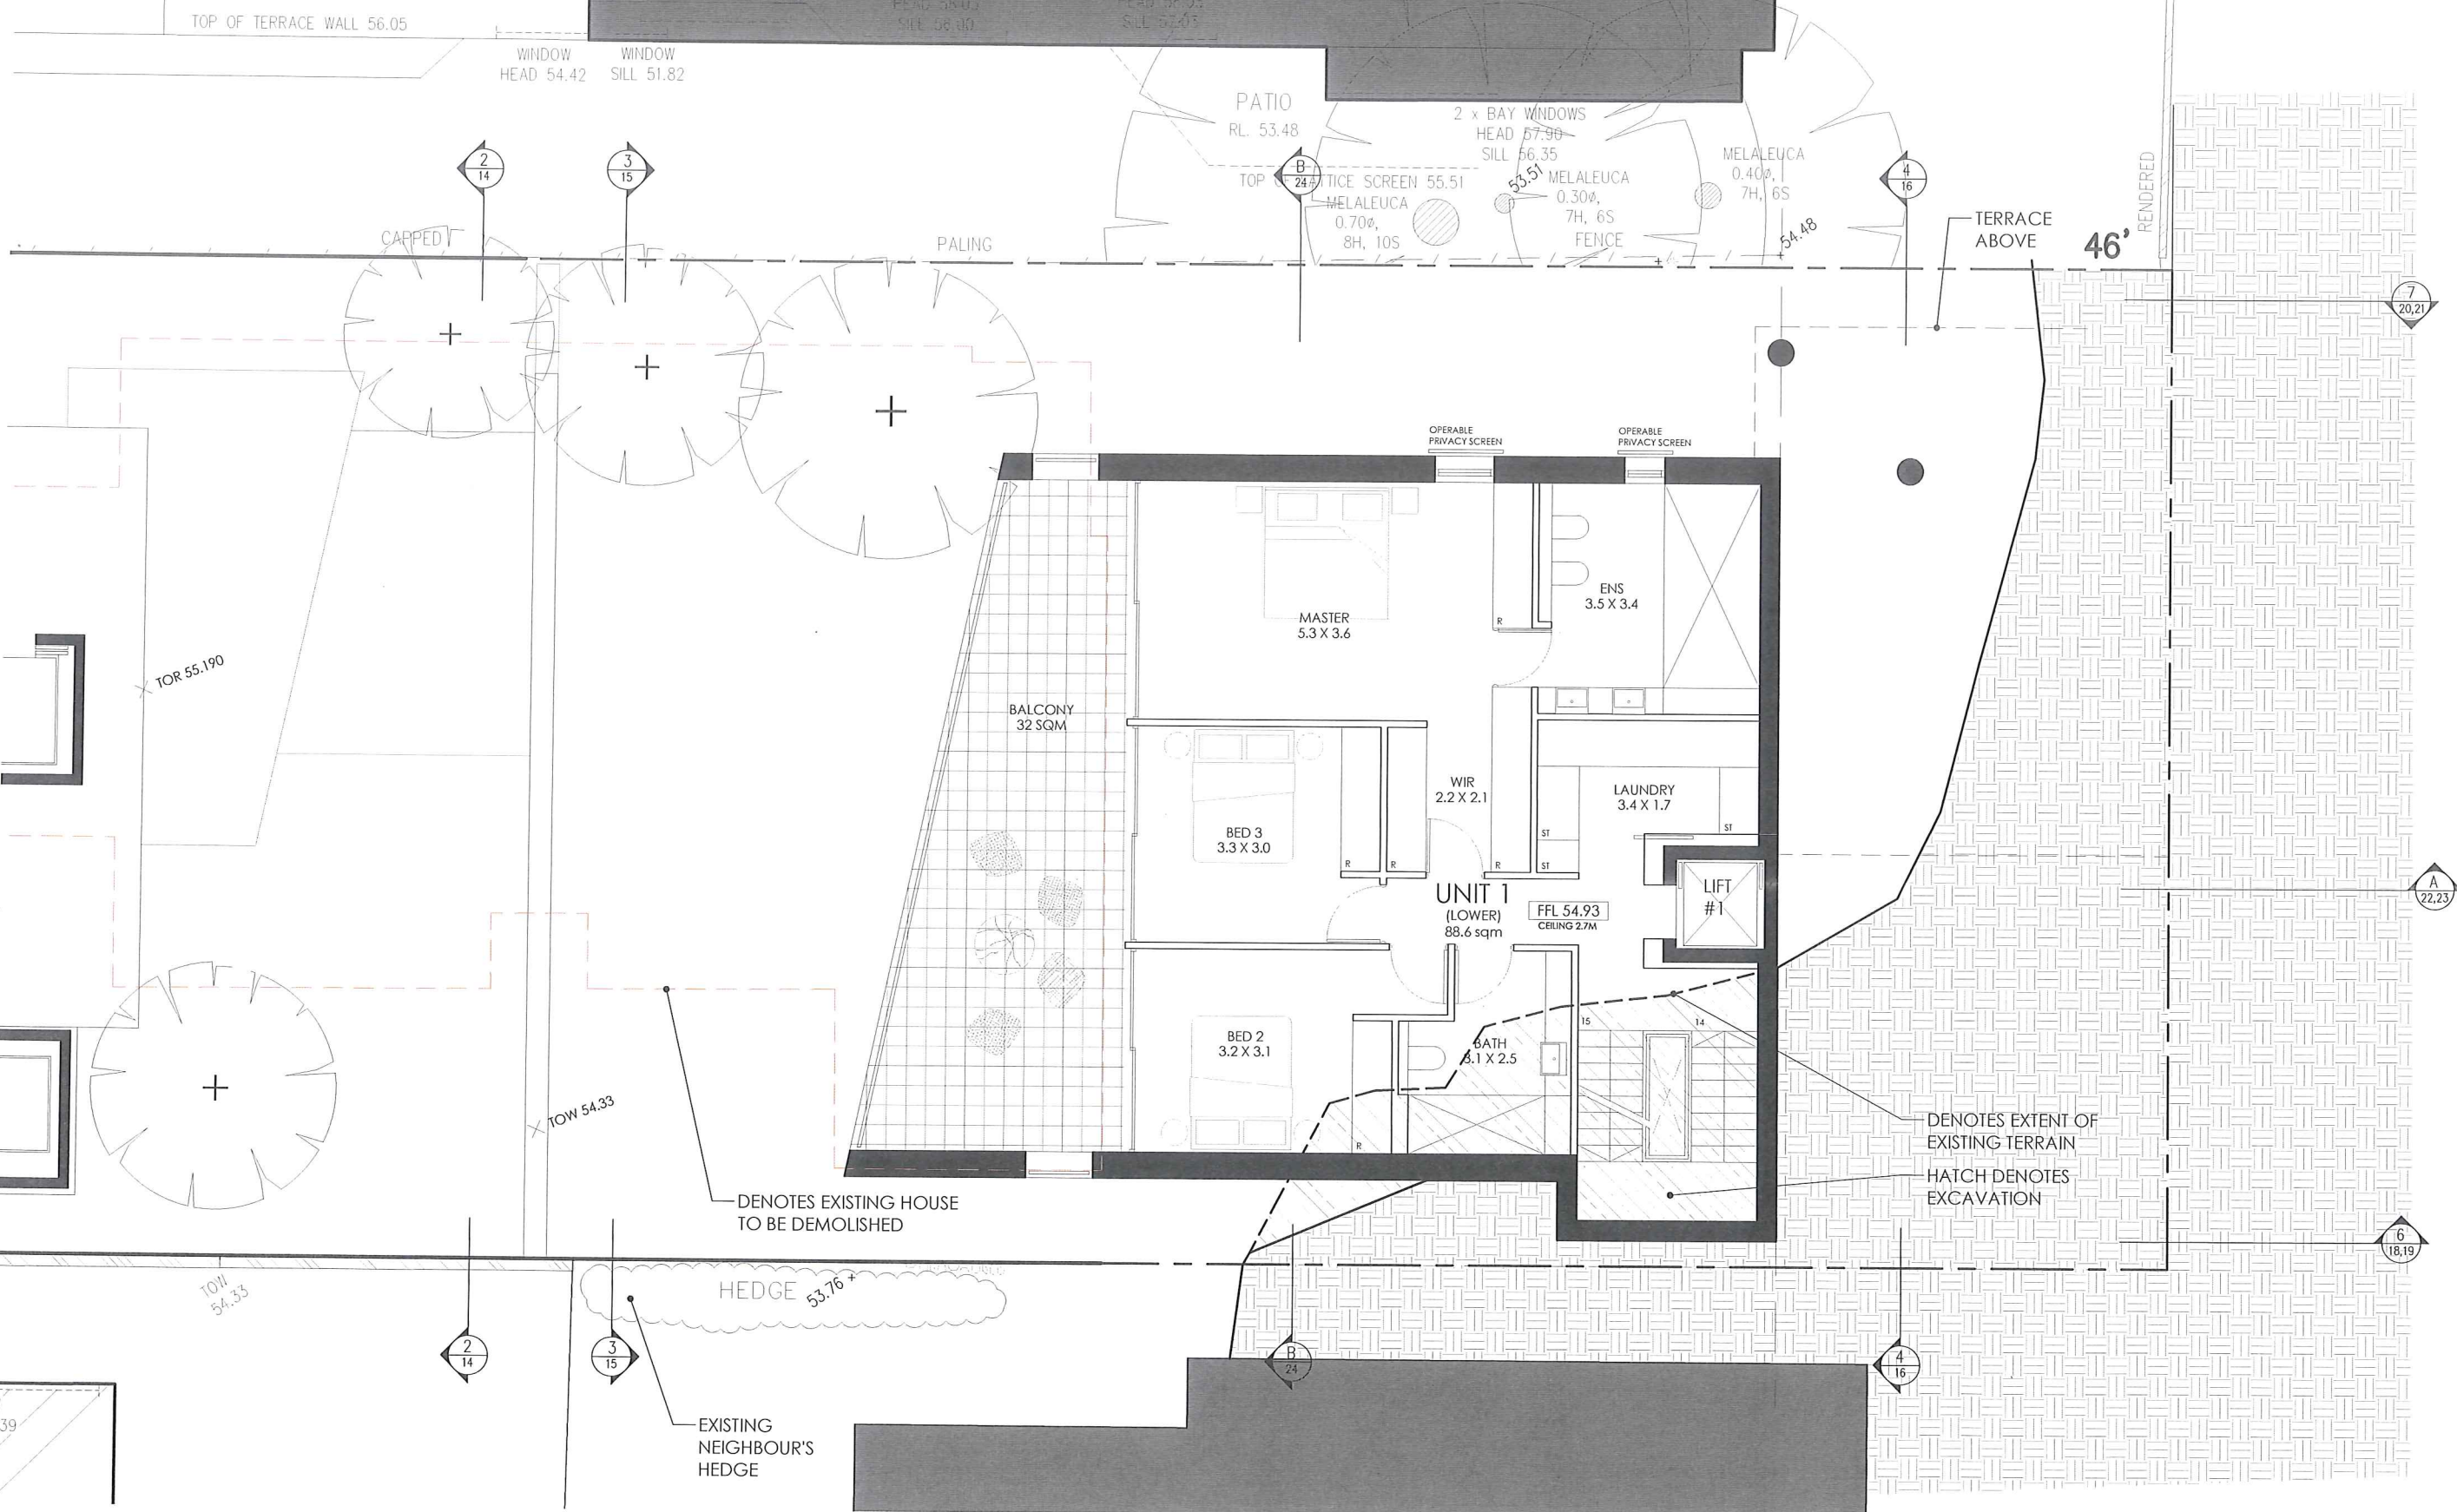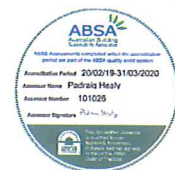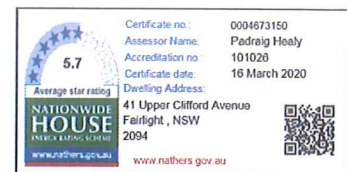

IMPORTANT NOTES:
Do not scale from drawings. Use figured dimensions only. Ensure that the drawings used carry the latest revision no. Read in conjunction with consultant engineers drawings - refer contract drawing list.

- All dimensions to be checked on site before commencement of work.
- All discrepancies to be brought to the attention of the Architect.
- Larger scale drawings and written dimensions take precedence.
- The Elevation Planning Level is min 3.1m AHD. All levels to AHD.

This drawing is copyright and the property of the author, and must not be retained, copied or used without the express authority of Platform Architects Pty Ltd.

REV	DATE	DESCRIPTION	BY
B	2019.07.22	PRELIMINARY	OH
C	2019.07.31	PRELIMINARY	OH
D	2019.08.15	PRELIMINARY - LAYOUTS UPDATE	OH
E	2019.09.20	FOR PRELODGEEMENT MEETING	OH
F	Dec '19	CONSULTANT COORDINATION	OH
G	Mar '19	FOR DA LODGEMENT	OH


REVISION NOTES
FOR DA LODGEMENT
NOT FOR CONSTRUCTION

platform
ARCHITECTS

Suite 503, 39 East Esplanade, Mosman NSW 2088
p. 02 9976 6666 extn. 7460255157
www.platformarchitects.com.au

PROJECT DETAILS
DUAL OCCUPANCY WITH BASEMENT CARPARKING
AND SINGLE DWELLING AT
41 UPPER CLIFFORD AVE
FAIRLIGHT NSW 2094

CLIENT
CARL OSCAR PETERSON AND HEATHON FAMILY INVESTMENTS PTY LTD,
643 MILITARY ROAD MOSMAN NSW 2088

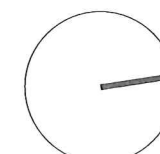

DRAWING TITLE
FIRST FLOOR PLAN
(UNIT 1)


SCALE
1:100
@A3

STATUS
DA

NUMBER
09

PROJECT
UCS

REVISION
F

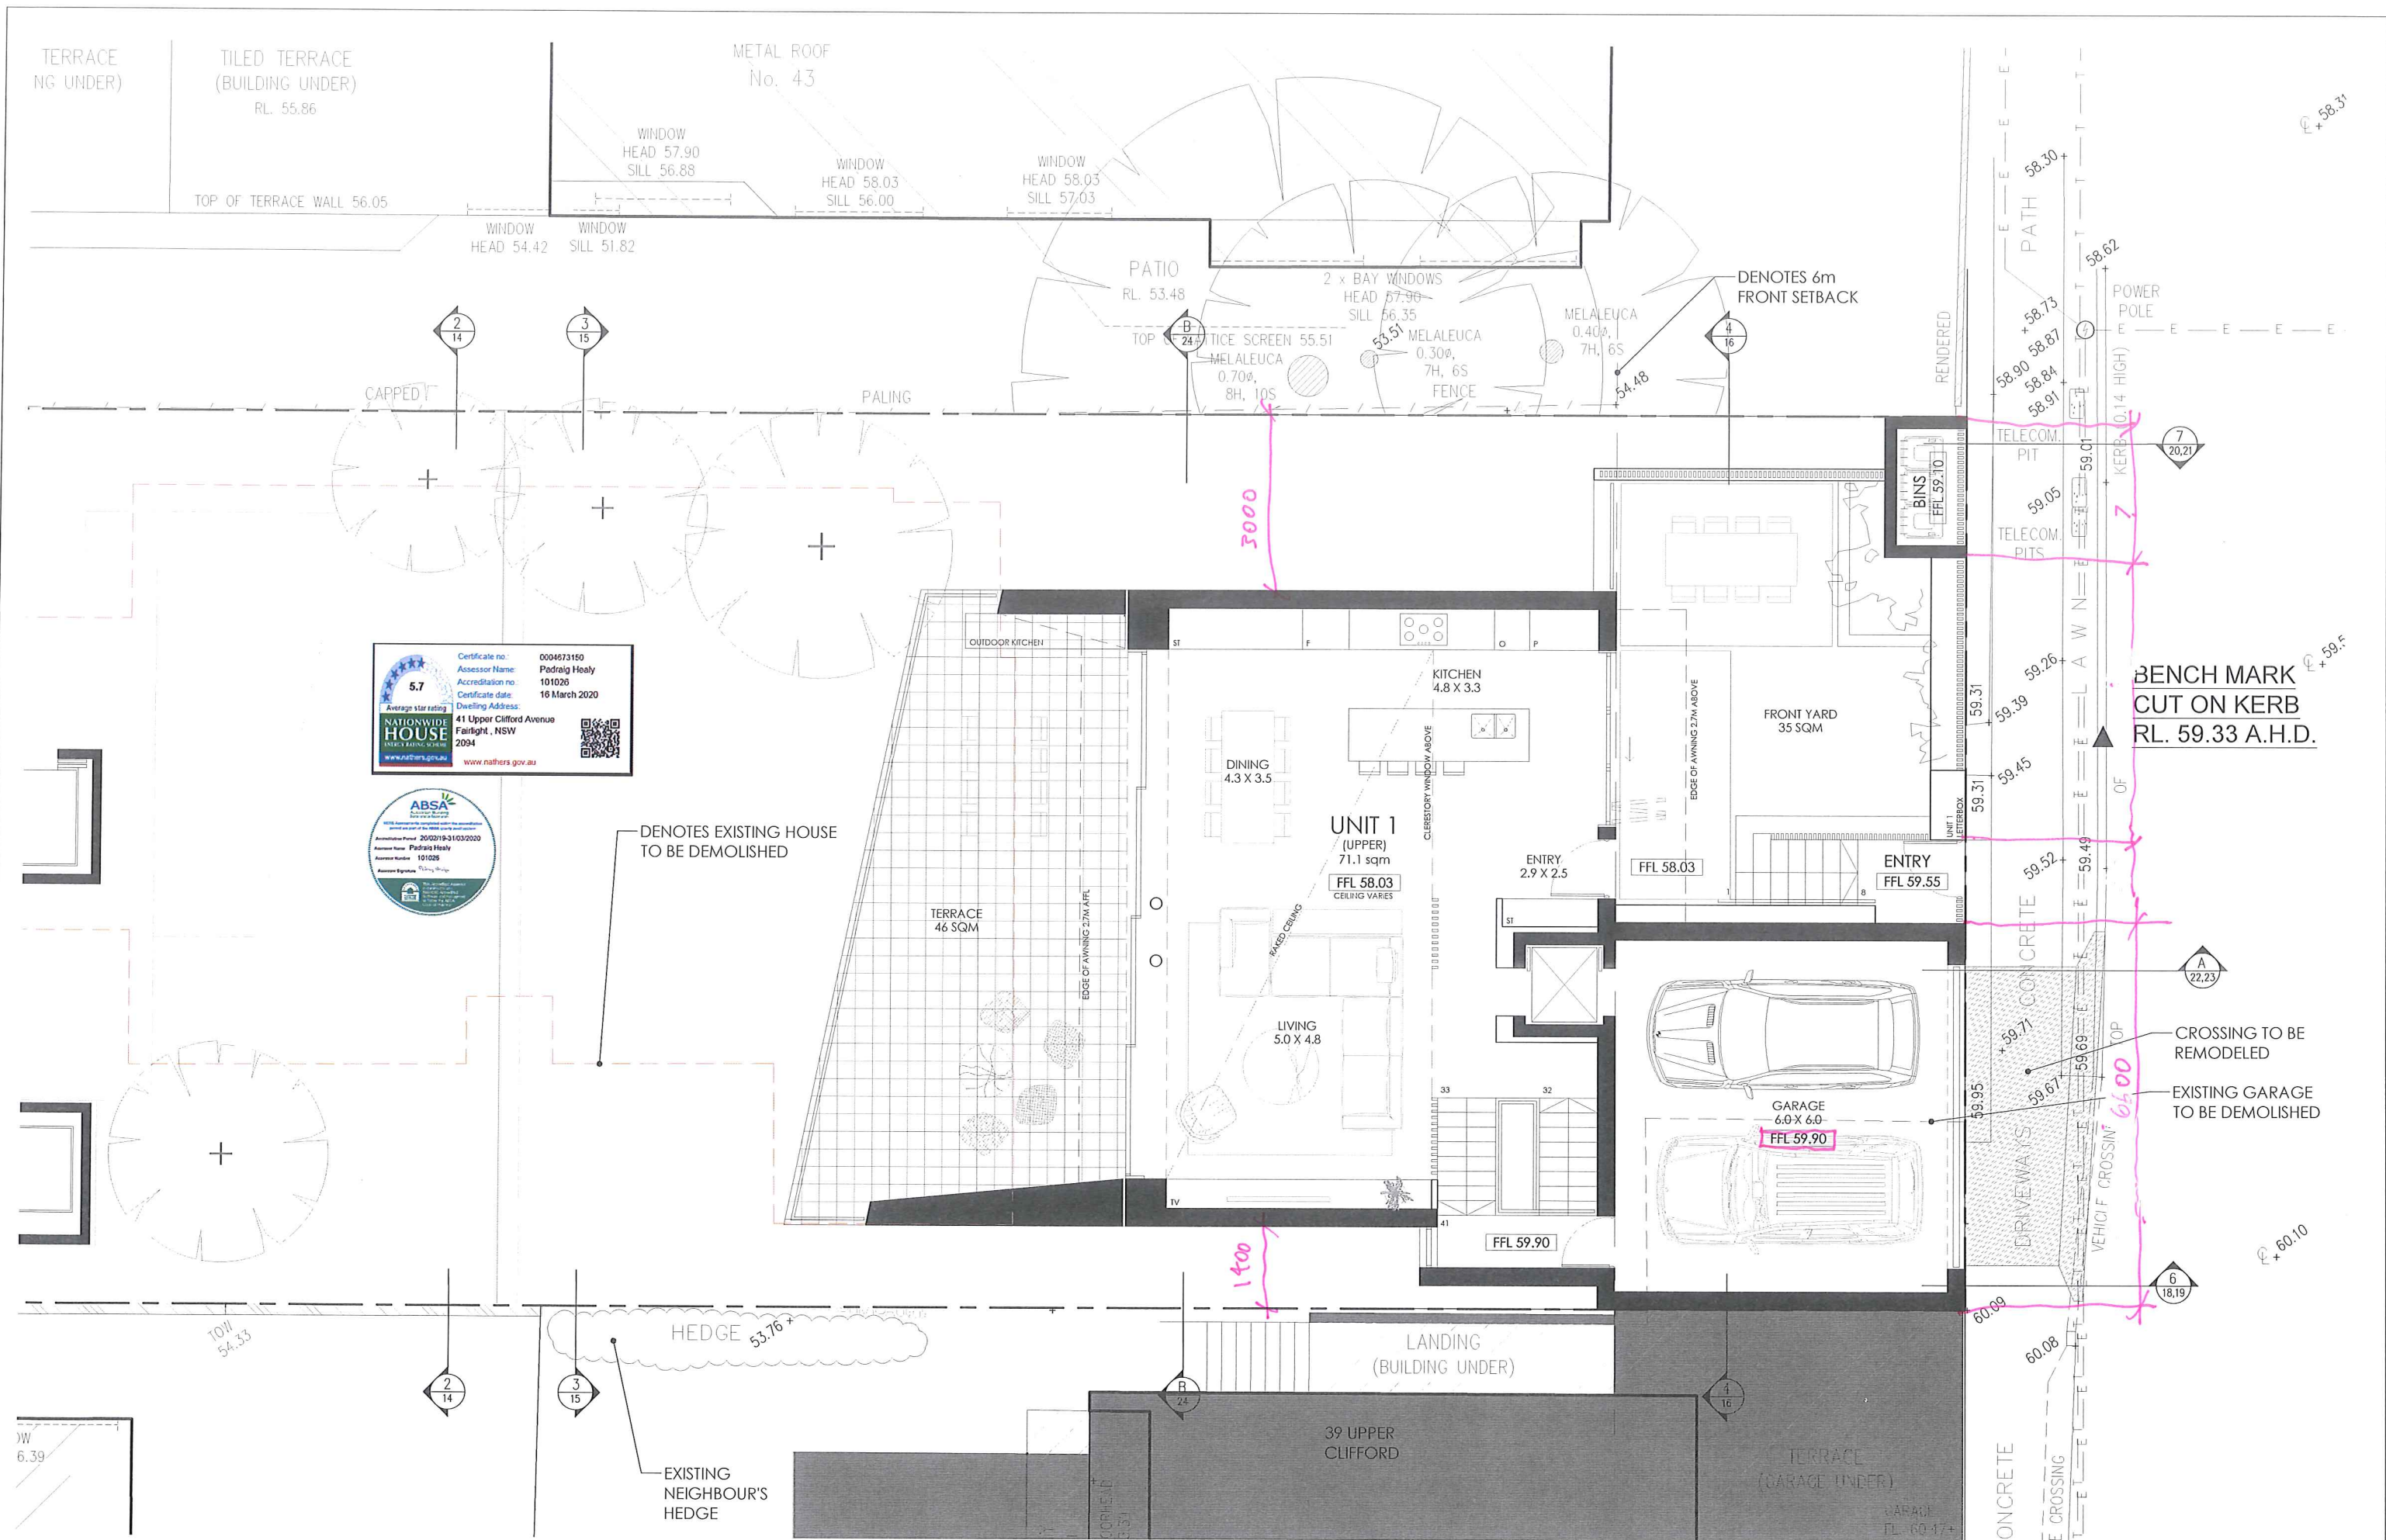

IMPORTANT NOTES:
Do not scale from drawings, use figured dimensions only. Ensure that the drawings used carry the latest revision no. Read in conjunction with consultant engineers drawings - refer contact drawing list.
• All dimensions to be checked on site before commencement of work.
• All discrepancies to be brought to the attention of the Architect.
• Larger scale drawings and written dimensions take precedence.
• The Estuarine Planning Level is m/n 3.1m AHD. All levels to AHD.

REV	DATE	DESCRIPTION	BY
B	2019.07.22	PRELIMINARY	OH
C	2019.07.31	PRELIMINARY	OH
C	2019.08.15	PRELIMINARY - LAYOUTS UPDATE	OH
D	2019.09.20	FOR PRELODGEEMENT MEETING	OH
E	Dec '19	CONSULTANT COORDINATION	OH
F	Mar '19	FOR DA LODGEMENT	OH

REVISION NOTES
FOR DA LODGEMENT
NOT FOR CONSTRUCTION

platform
ARCHITECTS

Suite 503, 39 East Esplanade Manly 2095
p. 02 9976 6666 abn. 7410285157
www.platformarchitects.com.au

PROJECT DETAILS
DUAL OCCUPANCY WITH BASEMENT CARPARKING
AND SINGLE DWELLING AT
41 UPPER CLIFFORD AVE
FAIRLIGHT NSW 2094
CLIENT
CARL OSCAR PETERSON AND HEATH FAMILY INVESTMENTS PTY LTD,
643 MILITARY ROAD MOSMAN NSW 2088




DRAWING TITLE
SECOND FLOOR PLAN
(UNIT 1)

SCALE STATUS NUMBER
1:100 DA 10

PROJECT
UCS
REVISION
F

CONTINUATION ON DWG 11

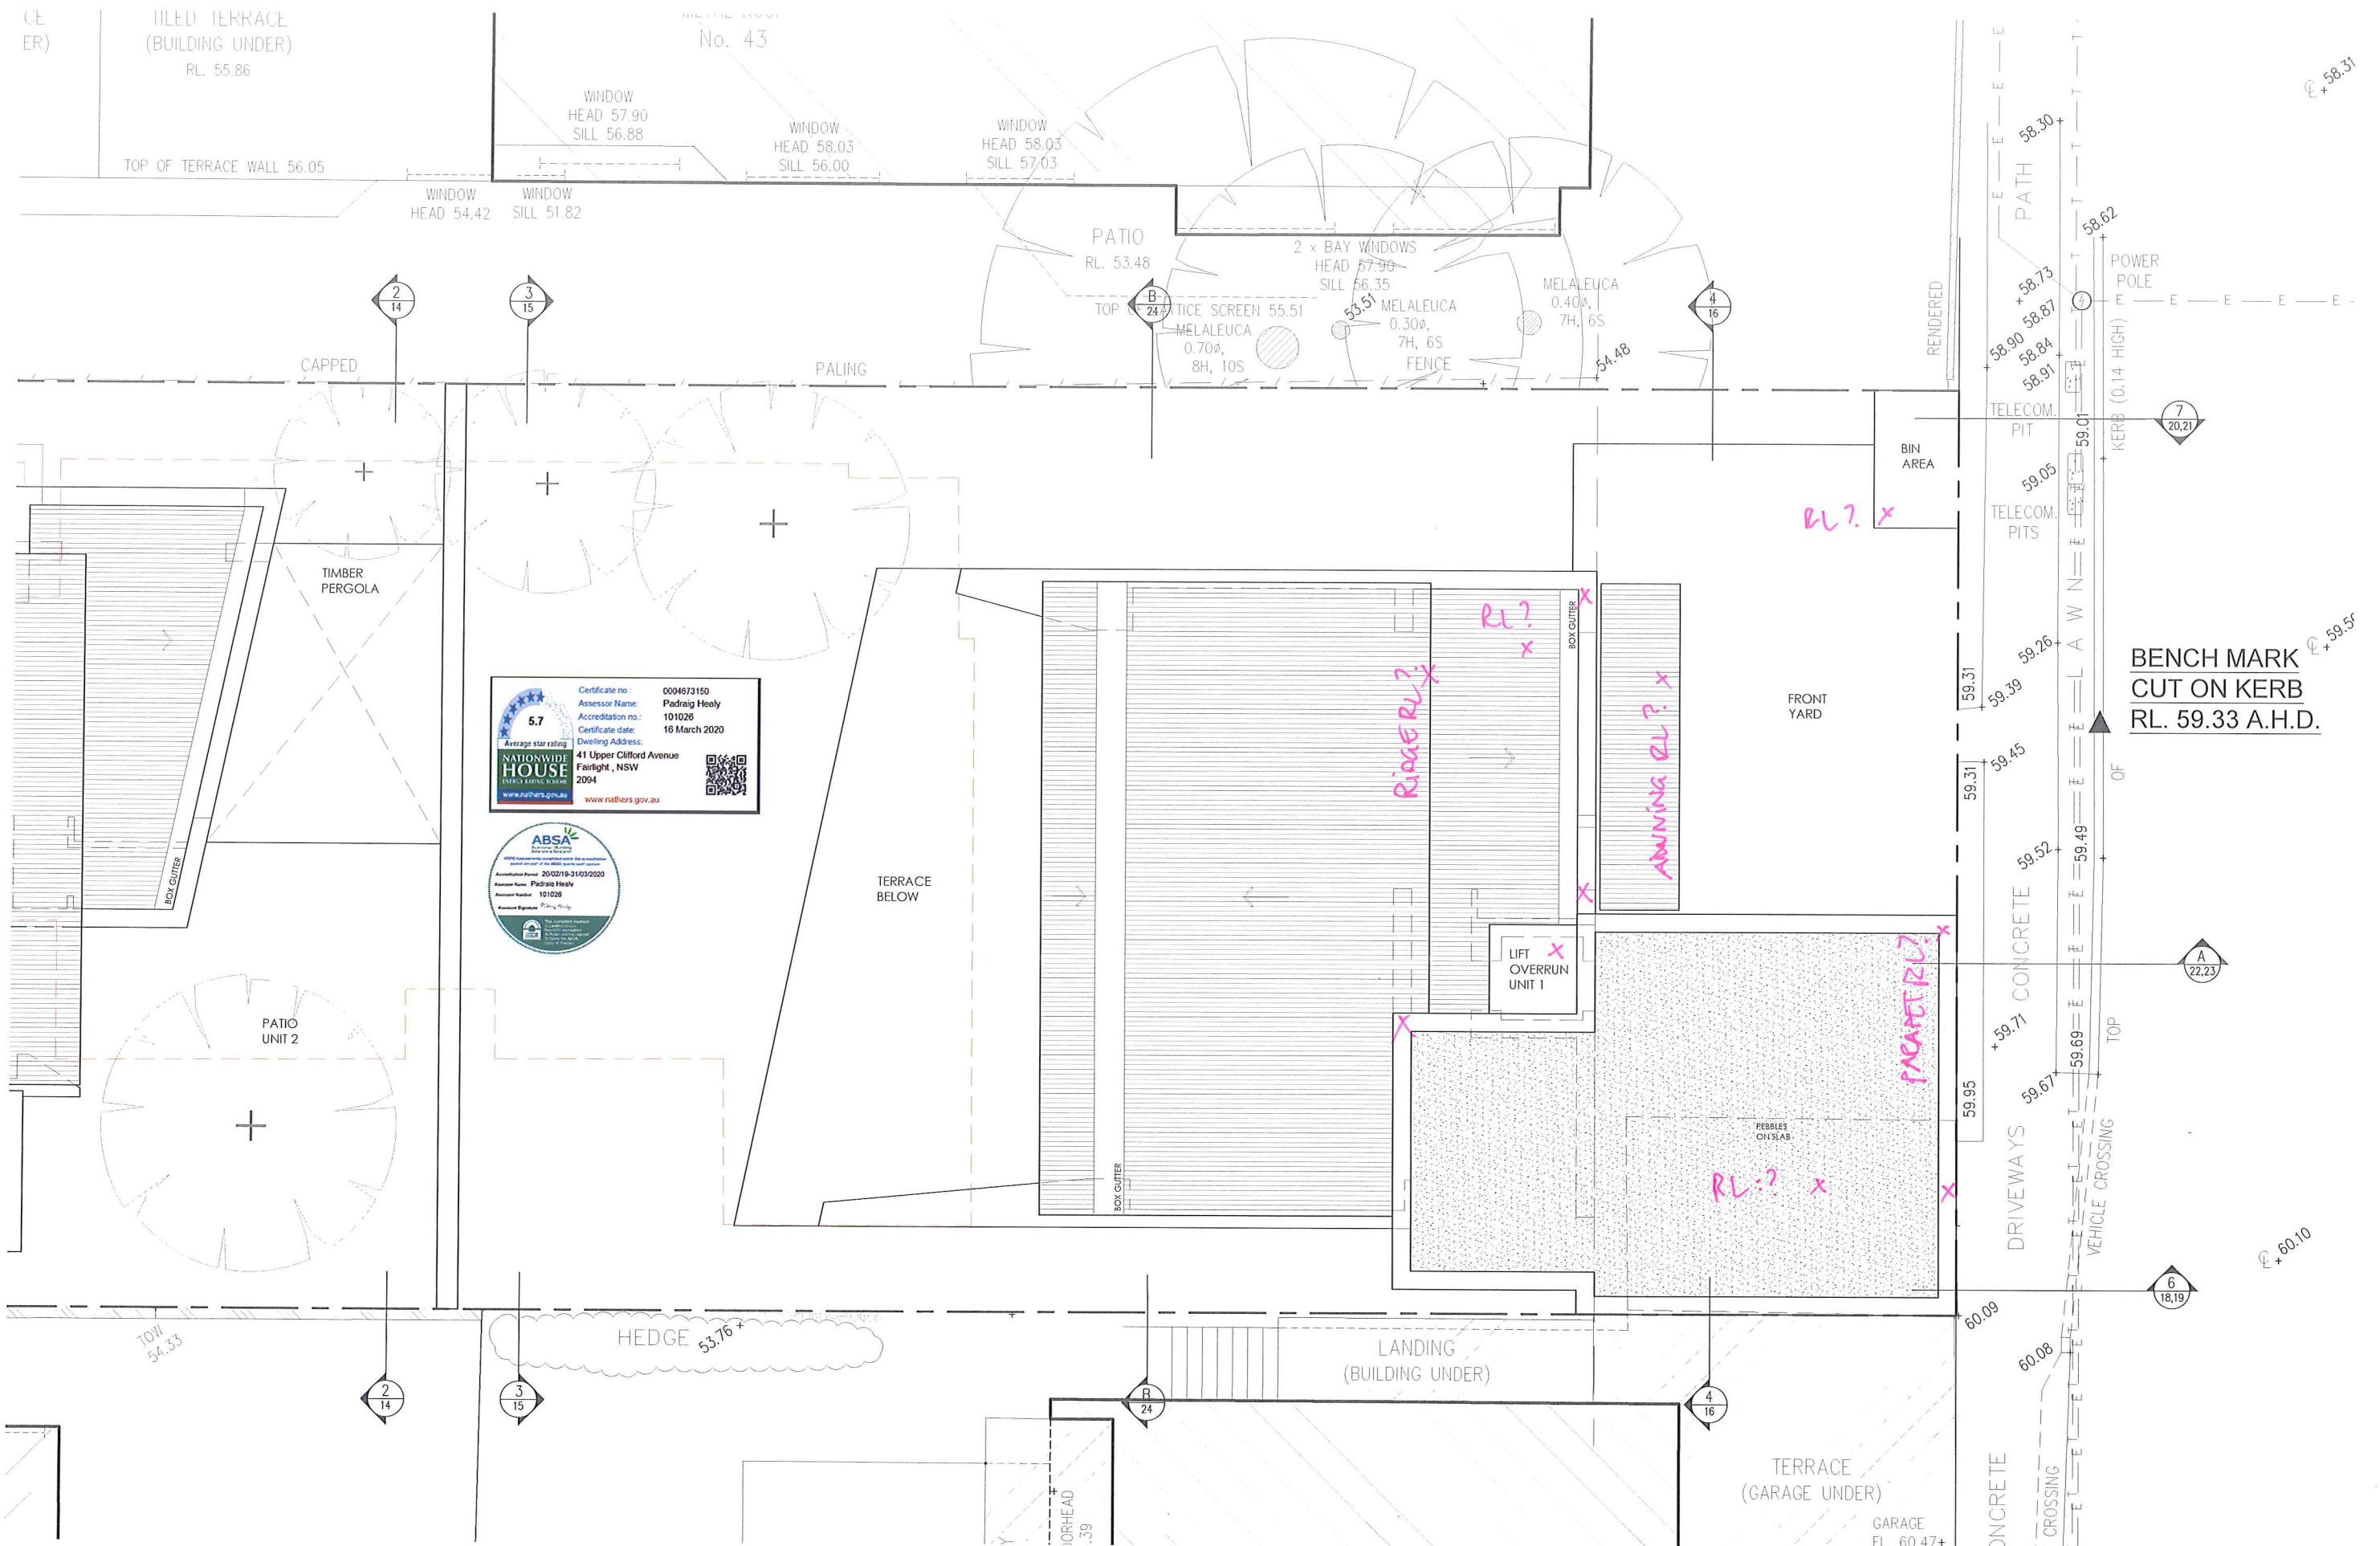


IMPORTANT NOTES:
Do not scale from drawings. Use figured dimensions only. Ensure that the drawings used carry the latest revision no. Read in conjunction with consultant engineers drawings - refer contract drawing list.
• All dimensions to be checked on site before commencement of work.
• All discrepancies to be brought to the attention of the Architect.
• Larger scale drawings and written dimensions take precedence.
• The Estuarine Planning Level is mfn 3.1m AHD. All levels to AHD.
This drawing is copyright and the property of the author, and must not be retained, copied or used without the express authority of Platform Architects Pty Ltd.

REV	DATE	DESCRIPTION	BY
B	2019.07.22	PRELIMINARY	OH
C	2019.07.31	PRELIMINARY - LAYOUTS UPDATE	OH
D	2019.08.15	FOR PRELODGEEMENT MEETING	OH
E	Dec '19	CONSULTANT COORDINATION	OH
F	Mar '19	FOR DA LODGEMENT	OH

REVISION NOTES
FOR DA LODGEMENT
NOT FOR CONSTRUCTION

platform
ARCHITECTS
Suite 503, 39 East Esplanade Manly 2095
p. 02 9976 6166 abn. 7400261517
www.platformarchitects.com.au

PROJECT DETAILS
DUAL OCCUPANCY WITH BASEMENT CARPARKING
AND SINGLE DWELLING AT
41 UPPER CLIFFORD AVE
FAIRLIGHT NSW 2094
CLIENT
CARL OSCAR PETERSON AND HEATON FAMILY INVESTMENTS PTY LTD,
643 MILITARY ROAD MOSMANN NSW 2088

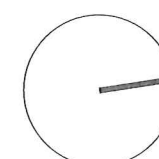

DRAWING TITLE
ROOF PLAN - SHEET 2
(UNIT 1)
SCALE
1:100
#A3
STATUS
DA
NUMBER
12
REVISION
F



PROJECT
UCS
REVISION
F

5.7
Average star rating
NATIONWIDE
HOUSE
ENERGY RATING SCHEME
www.natberr.gov.au

Certificate no.: 0004673150
Assessor Name: Padraig Healy
Accreditation no.: 101020
Certificate date: 16 March 2020
Dwelling Address:
41 Upper Clifford Avenue
Fairlight, NSW
2094

www.natberr.gov.au

ABSA

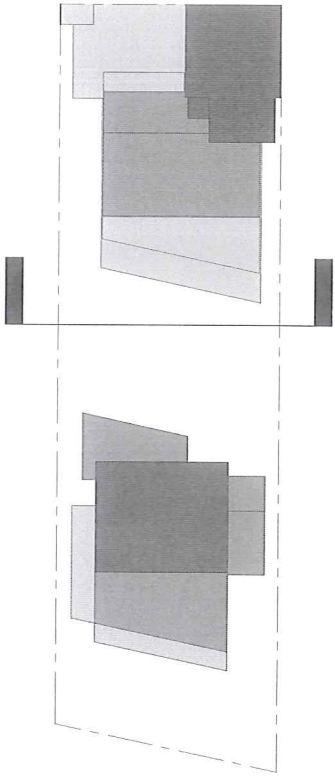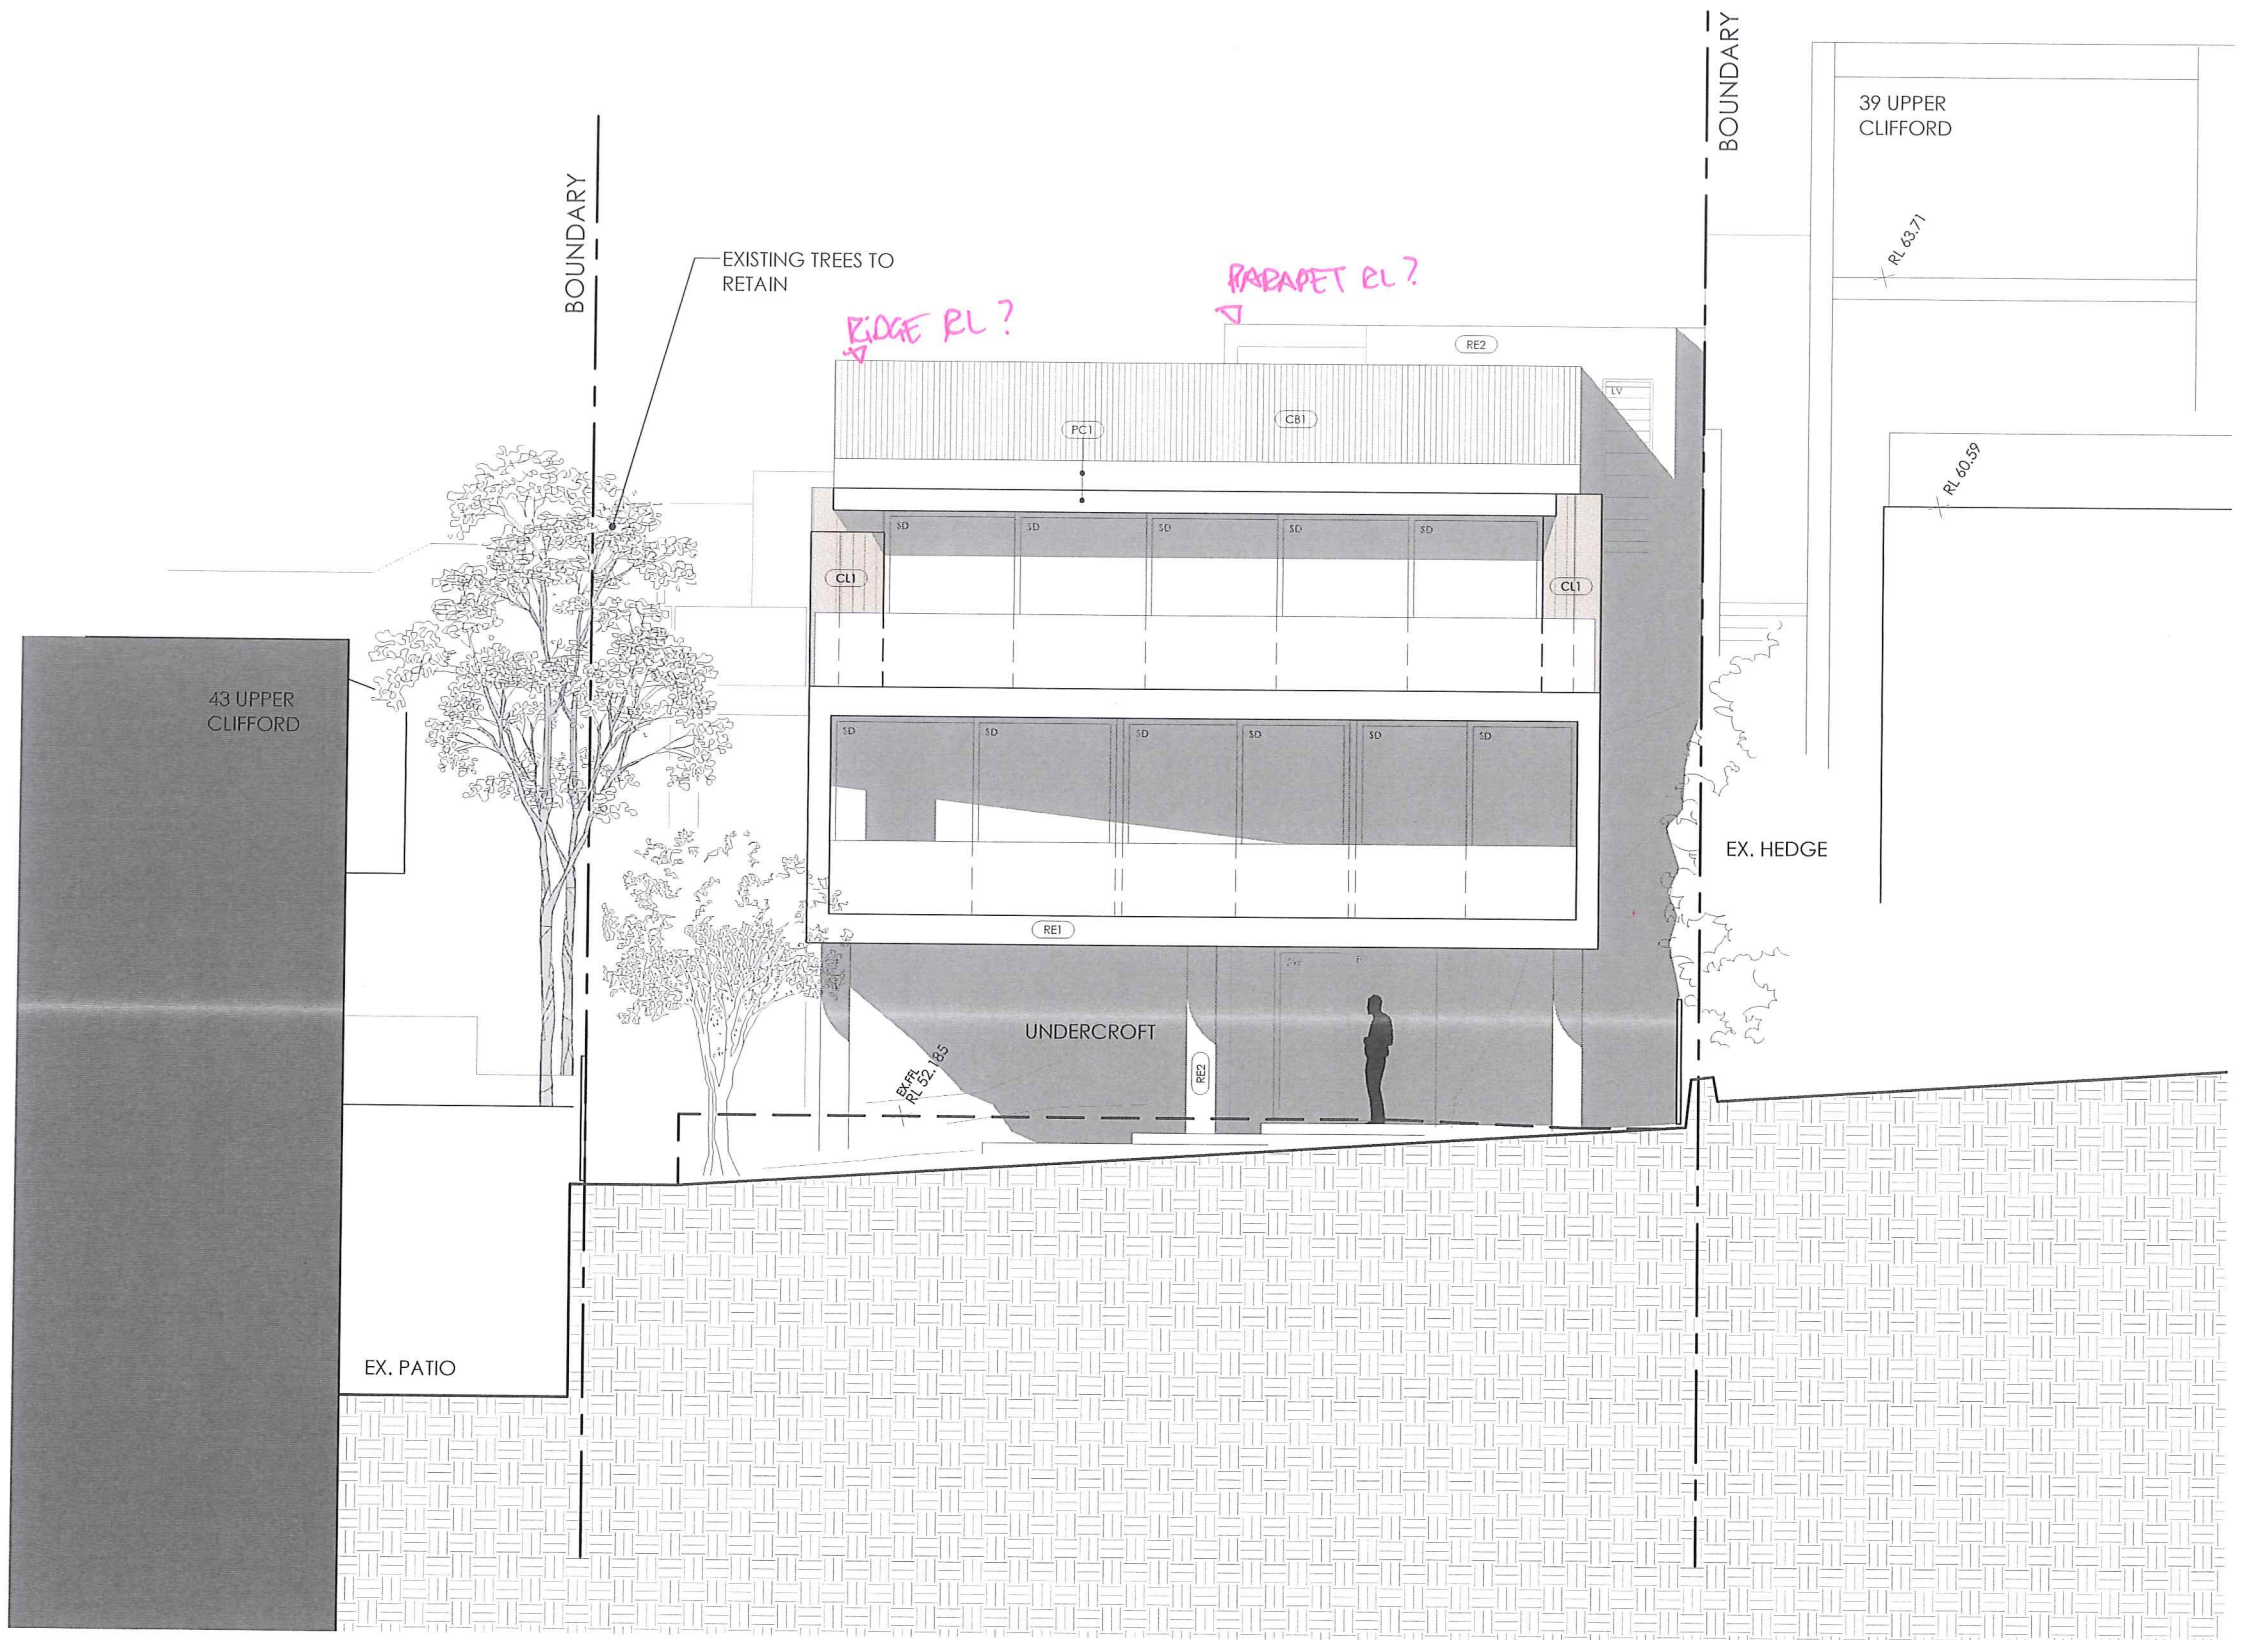

LEGEND

SD	SLIDING DOOR PANEL
LV	GLAZED LOUVRE WINDOW
BF	BIFOLD DOOR
SW	SWING DOOR
AW	AWNING WINDOW
F	FIXED GLAZING
GB	GLASS BALUSTRADE
SK	SKYLIGHT

CL1	CLADDING TYPE 1
CL2	CLADDING TYPE 2
RE1	RENDER TYPE 1
RE2	RENDER TYPE 2
TIM	EXTERNAL TIMBER
PC1	POWDER COATED METAL TYPE 1
CB1	COLORBOND ROOFING TYPE 1

*REFER TO FINISHES SCHEDULE FOR DETAILS

IMPORTANT NOTES:
Do not scale from drawings. Use figured dimensions only. Ensure that the drawings used carry the latest revision no. Read in conjunction with consultant engineers drawings - refer contract drawing list.

- All dimensions to be checked on site before commencement of work.
- All discrepancies to be brought to the attention of the Architect.
- Larger scale drawings and written dimensions take precedence.
- The Elevation Planning Level is min 3.1m AHD. All levels to AHD.

This drawing is copyright and the property of the author, and must not be retained, copied or used without the express authority of Platform Architects Pty Ltd.


REV	DATE	DESCRIPTION	BY
B	2019.07.22	PRELIMINARY	OH
C	2019.07.31	PRELIMINARY	OH
C	2019.08.15	PRELIMINARY - LAYOUTS UPDATE	OH
D	2019.09.20	FOR PRELODGEEMENT MEETING	OH
E	Dec '19	CONSULTANT COORDINATION	OH
F	Mar '19	FOR DA LODGMENT	OH

REVISION NOTES
FOR DA LODGMENT
NOT FOR CONSTRUCTION

platform
ARCHITECTS


Suite 303, 39 East Esplanade Manly, 2095
p. 02 9976 6555 abn. 7430285157
www.platformarchitects.com.au

PROJECT DETAILS
DUAL OCCUPANCY WITH BASEMENT CARPARKING
AND SINGLE DWELLING AT
41 UPPER CLIFFORD AVE
FAIRLIGHT NSW 2094
CLIENT
CARL OSCAR PETERSON AND HEATH FAMILY INVESTMENTS PTY LTD,
643 MILITARY ROAD MOSMANN NSW 2088

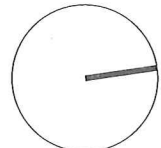

DRAWING TITLE			PROJECT
ELEVATION 3 - SOUTH UNIT 1			UCS
SCALE	STATUS	NUMBER	REVISION
1:100 @A3	DA	15	F

Certificate no. 0004973150
Assessor Name: Padraig Healy
Accreditation no. 101026
Certificate date: 16 March 2020
Dwelling Address: 41 Upper Clifford Avenue
Fairlight, NSW 2094
www.nathers.gov.au

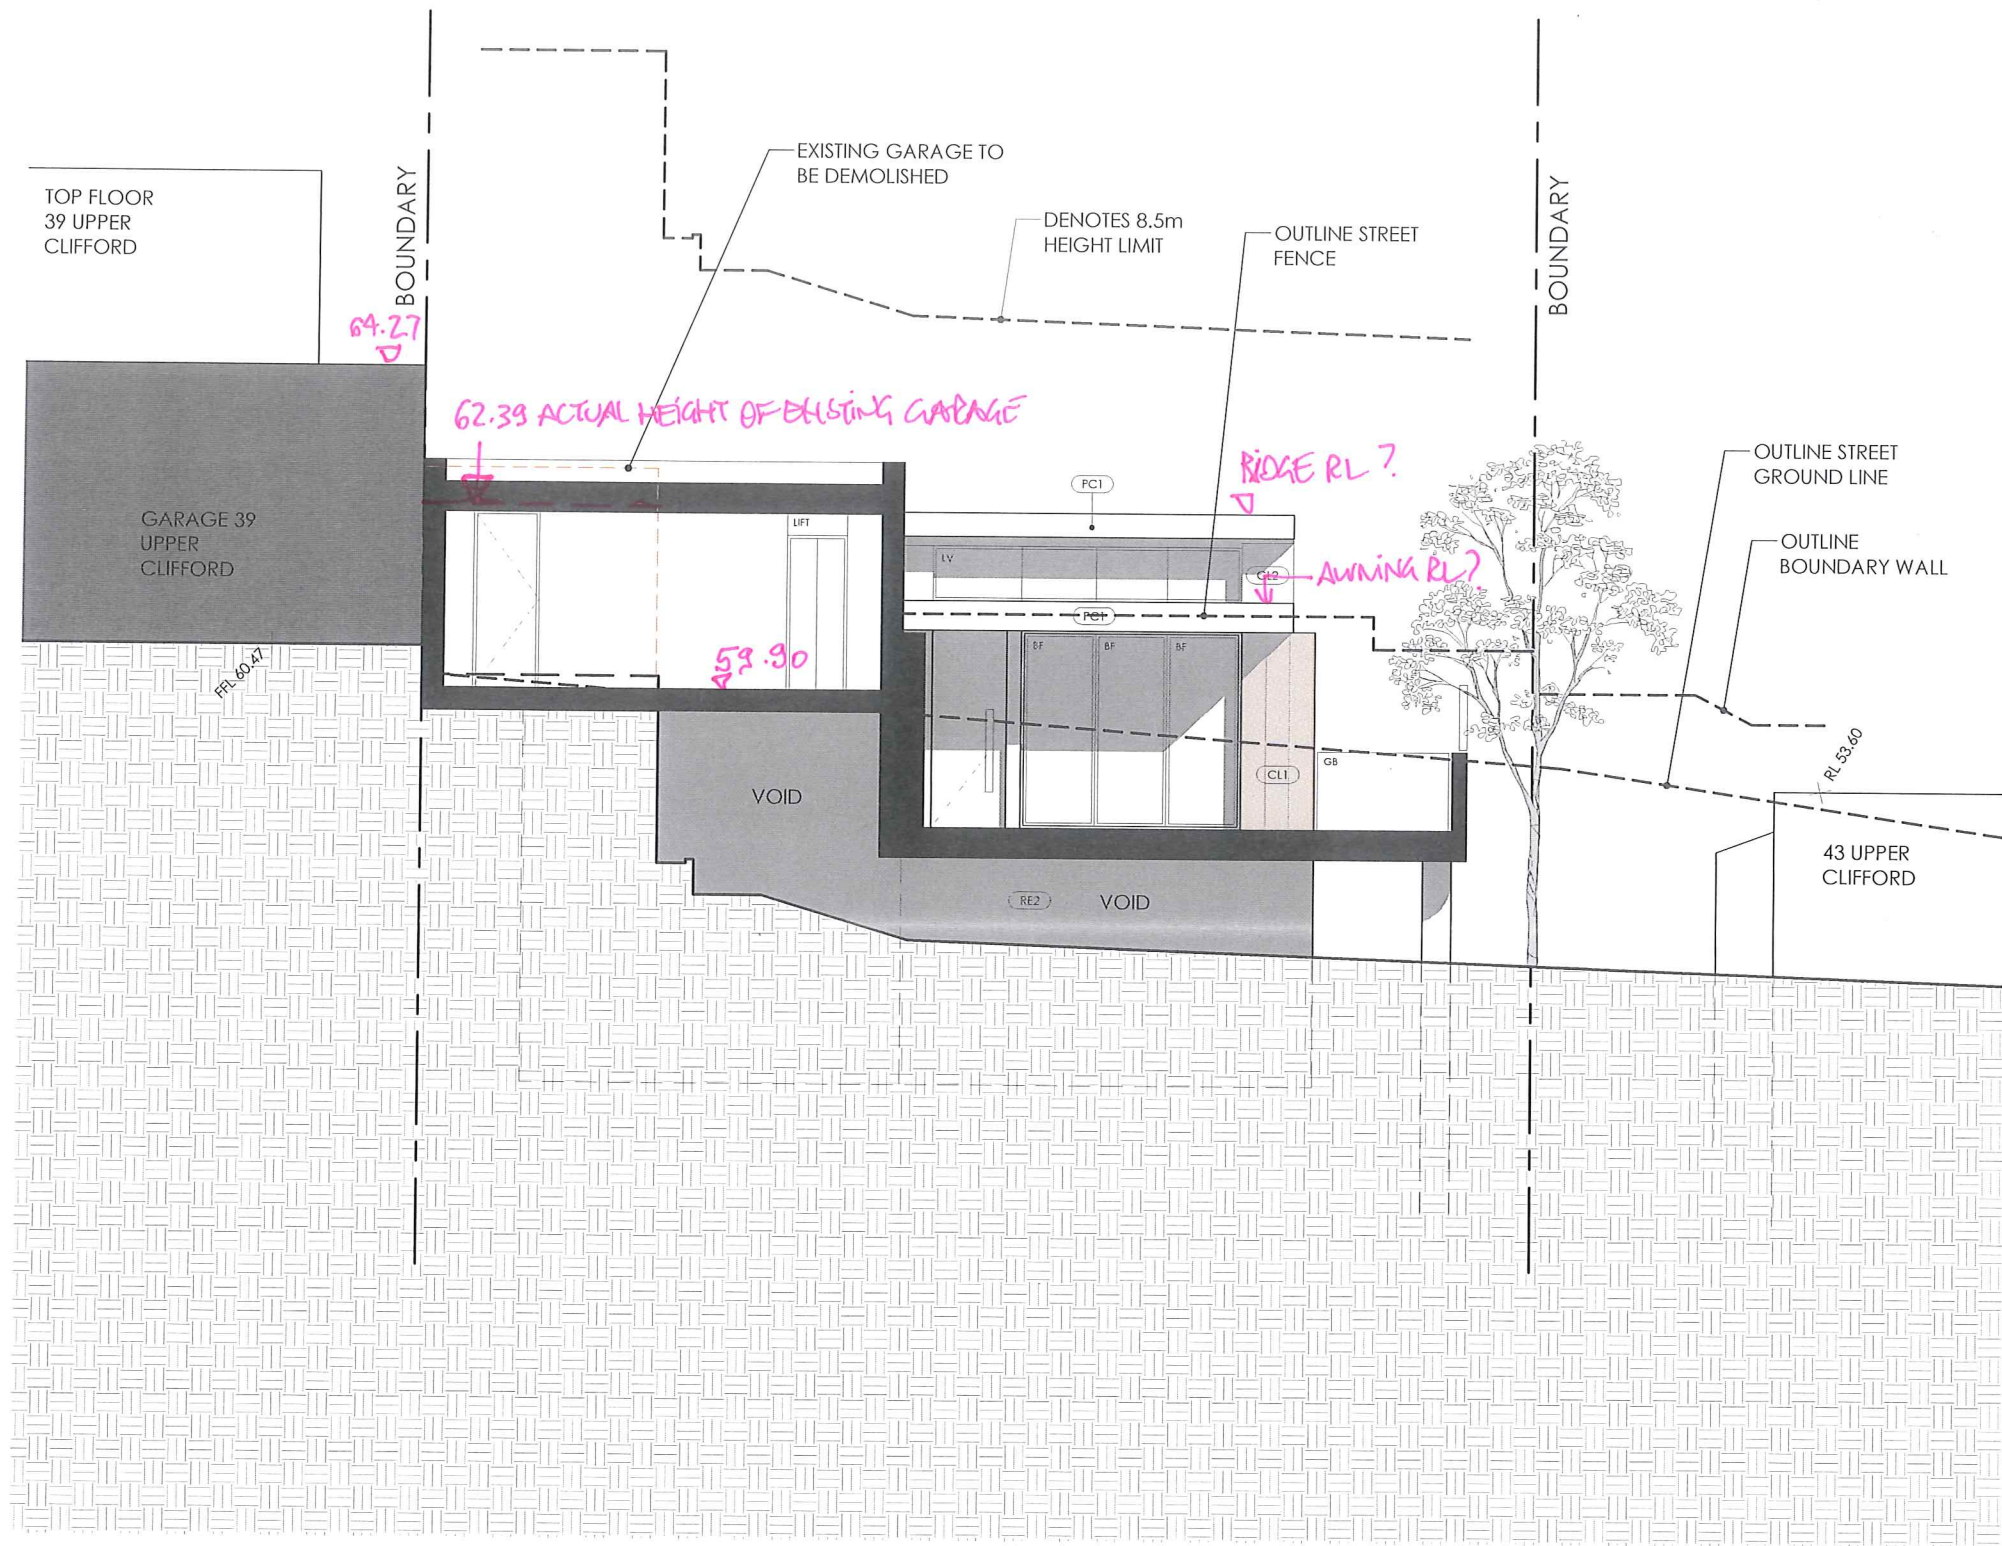

LEGEND

SD	SLIDING DOOR PANEL
LV	GLAZED LOUVRE WINDOW
BF	BIFOLD DOOR
SW	SWING DOOR
AW	AWNING WINDOW
F	FIXED GLAZING
GB	GLASS BALUSTRADE
SK	SKYLIGHT

CL1	CLADDING TYPE 1
CL2	CLADDING TYPE 2
RE1	RENDER TYPE 1
RE2	RENDER TYPE 2
TIM	EXTERNAL TIMBER
PC1	POWDER COATED METAL TYPE 1
CB1	COLORBOND ROOFING TYPE 1

*REFER TO FINISHES SCHEDULE FOR DETAILS

IMPORTANT NOTES:
Do not scale from drawings; use figured dimensions only. Ensure that the drawings used carry the latest revision no. Read in conjunction with consultant engineers drawings - refer contract drawing list.

- All dimensions to be checked on site before commencement of work.
- All discrepancies to be brought to the attention of the Architect.
- Larger scale drawings and written dimensions take precedence.
- The Estate Planning Level is min 3.1m AHD. All levels to AHD.

This drawing is copyright and the property of the author, and must not be retained, copied or used without the express authority of Platform Architects Pty Ltd.

REV	DATE	DESCRIPTION	BY
B	2019.07.22	PRELIMINARY	OH
C	2019.07.31	PRELIMINARY	OH
C	2019.08.15	PRELIMINARY - LAYOUTS UPDATE	OH
D	2019.09.20	FOR PRELODGEEMENT MEETING	OH
E	Dec '19	CONSULTANT COORDINATION	OH
F	Mar '19	FOR DA LODGMENT	OH


REVISION NOTES
FOR DA LODGEMENT
NOT FOR CONSTRUCTION



PROJECT DETAILS
DUAL OCCUPANCY WITH BASEMENT CARPARKING
AND SINGLE DWELLING AT
41 UPPER CLIFFORD AVE
FAIRLIGHT NSW 2094
CLIENT
CARL OSCAR PETERSON AND HEATON FAMILY INVESTMENTS PTY LTD.
643 MILITARY ROAD MOSMANN NSW 2088




DRAWING TITLE	STATUS	NUMBER	REVISION
ELEVATION 4 - NORTH UNIT 1	DA	16	F

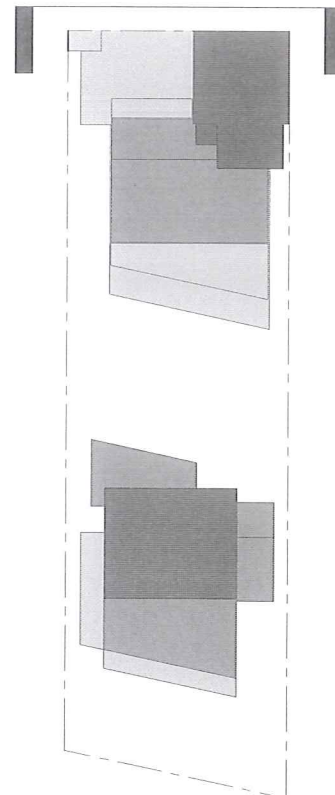

SD	SLIDING DOOR PANEL
LV	GLAZED LOUVRE WINDOW
BF	BIFOLD DOOR
SW	SWING DOOR
AW	AWNING WINDOW
F	FIXED GLAZING
GB	GLASS BALUSTRADE
SK	SKYLIGHT

- *REFER TO FINISHES SCHEDULE FOR DETAILS



PROJECT
UCS
REVISION
F

OUTLINES 39 UPPER
CLIFFORD BUILDING

OUTLINES 39 UPPER
CLIFFORD GARAGE

DENOTES EXISTING GROUND
AT UNIT 1 EAST FACADE + 8.5M

RL 52.15
+ 8.5M

RL 52.19
+ 8.5M

RL 52.21
+ 8.5M

PC1

CL2

RE2

GARAGE

60.07 existing
FFL 59.90

RL PROPOSED?
62.39 existing

BOUNDARY AT SECTION

UPPER CLIFFORD AVE

CONTINUATION ON DWG 18

ES 43 UPPER
RD BEYOND

OUTLINES EXISTING
WALL AT EAST BDY

GB

CL1

RE1

GB

UNDERCROFT

EXISTING GROUND AT
EAST BOUNDARY

UNIT 2
PATIO

UNIT 1
GARDEN

LEGEND

SD	SLIDING DOOR PANEL
LV	GLAZED LOUVRE WINDOW
BF	BIFOLD DOOR
SW	SWING DOOR
AW	AWNING WINDOW
F	FIXED GLAZING
GB	GLASS BALUSTRADE
SK	SKYLIGHT

CL1	CLADDING TYPE 1
CL2	CLADDING TYPE 2
RE1	RENDER TYPE 1
RE2	RENDER TYPE 2
TIM	EXTERNAL TIMBER
PC1	POWDER COATED METAL TYPE 1
CB1	COLORBOND ROOFING TYPE 1

*REFER TO FINISHES SCHEDULE FOR DETAILS

IMPORTANT NOTES:
Do not scale from drawings. Use figured dimensions only. Ensure that the drawings
used carry the latest revision no. Read in conjunction with consultant engineers
drawings - refer contact drawing list.

- All dimensions to be checked on site before commencement of work.
- All discrepancies to be brought to the attention of the Architect.
- Larger scale drawings and written dimensions take precedence.
- The Statutory Planning Level is min 3.1m AHD. All levels to AHD.

This drawing is copyright and the property of the author, and must not be retained,
copied or used without the express authority of Platform Architects Pty Ltd.

REV	DATE	DESCRIPTION	BY
B	2019.07.22	PRELIMINARY	OH
C	2019.07.31	PRELIMINARY	OH
C	2019.08.15	PRELIMINARY - LAYOUTS UPDATE	OH
D	2019.09.20	FOR PRELIMINARY MEETING	OH
E	Dec '19	CONSULTANT COORDINATION	OH
F	Mar '19	FOR DA LODGMENT	OH

REVISION NOTES

FOR DA LODGMENT
NOT FOR CONSTRUCTION

platform
ARCHITECTS

Suite 303, 39 East Esplanade Albany 2095
p. 02 9976 6565 abn. 7405255157
www.platformarchitects.com.au

PROJECT DETAILS

DUAL OCCUPANCY WITH BASEMENT CARPARKING
AND SINGLE DWELLING AT

41 UPPER CLIFFORD AVE

FAIRLIGHT NSW 2094

CLIENT

CARL OSCAR PETERSON AND HEATON FAMILY INVESTMENTS PTY LTD,
643 MILITARY ROAD MOSMANN NSW 2088

DRAWING TITLE

SECTIONAL ELEVATION 6 - EAST

SHEET 2

SCALE

1:100
@A3

STATUS

DA

NUMBER


19

PROJECT

UCS

REVISION

F

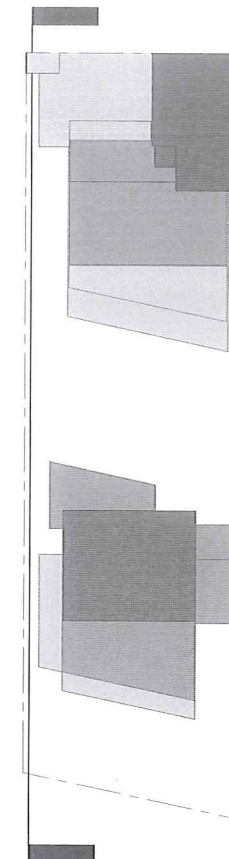

CONTINUATION ON DWG 21

LEGEND

SD	SLIDING DOOR PANEL
LV	GLAZED LOUVRE WINDOW
BF	BIFOLD DOOR
SW	SWING DOOR
AW	AWNING WINDOW
F	FIXED GLAZING
GB	GLASS BALUSTRADE
SK	SKYLIGHT

CL1	CLADDING TYPE 1
CL2	CLADDING TYPE 2
RE1	RENDER TYPE 1
RE2	RENDER TYPE 2
TIM	EXTERNAL TIMBER
PC1	POWDER COATED METAL TYPE 1
CB1	COLORBOND ROOFING TYPE 1

*REFER TO FINISHES SCHEDULE FOR DETAILS

IMPORTANT NOTES:
Do not scale from drawings. Use figured dimensions only. Ensure that the drawings used carry the latest revision no. Read in conjunction with consultant engineers drawings - refer contract drawing list.
• All dimensions to be checked on site before commencement of work.
• All discrepancies to be brought to the attention of the Architect.
• Larger scale drawings and written dimensions take precedence.
• The Estate Planning Level is min 3.1m AHD. All levels to AHD.
This drawing is copyright and the property of the author, and must not be retained, copied or used without the express authority of Platform Architects Pty Ltd.


REV	DATE	DESCRIPTION	BY
B	2019.07.22	PRELIMINARY	OH
C	2019.07.31	PRELIMINARY	OH
C	2019.08.15	PRELIMINARY - LAYOUTS UPDATE	OH
D	2019.09.20	FOR PRELODGEEMENT MEETING	OH
E	Dec '19	CONSULTANT COORDINATION	OH
F	Mar '19	FOR DA LODGMENT	OH

REVISION NOTES
FOR DA LODGMENT
NOT FOR CONSTRUCTION



PROJECT DETAILS
DUAL OCCUPANCY WITH BASEMENT CARPARKING
AND SINGLE DWELLING AT
41 UPPER CLIFFORD AVE
FAIRLIGHT NSW 2094

CLIENT
CARL OSCAR PETERSON AND HEATHON FAMILY INVESTMENTS PTY LTD,
643 MILITARY ROAD MOSMANN NSW 2088

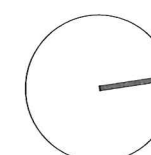


DRAWING TITLE
SECTIONAL ELEVATION 7 - WEST
SHEET 1

SCALE	STATUS	NUMBER
1:100 @A3	DA	20

PROJECT	REVISION
UCS	F

CONTINUATION ON DWG 22

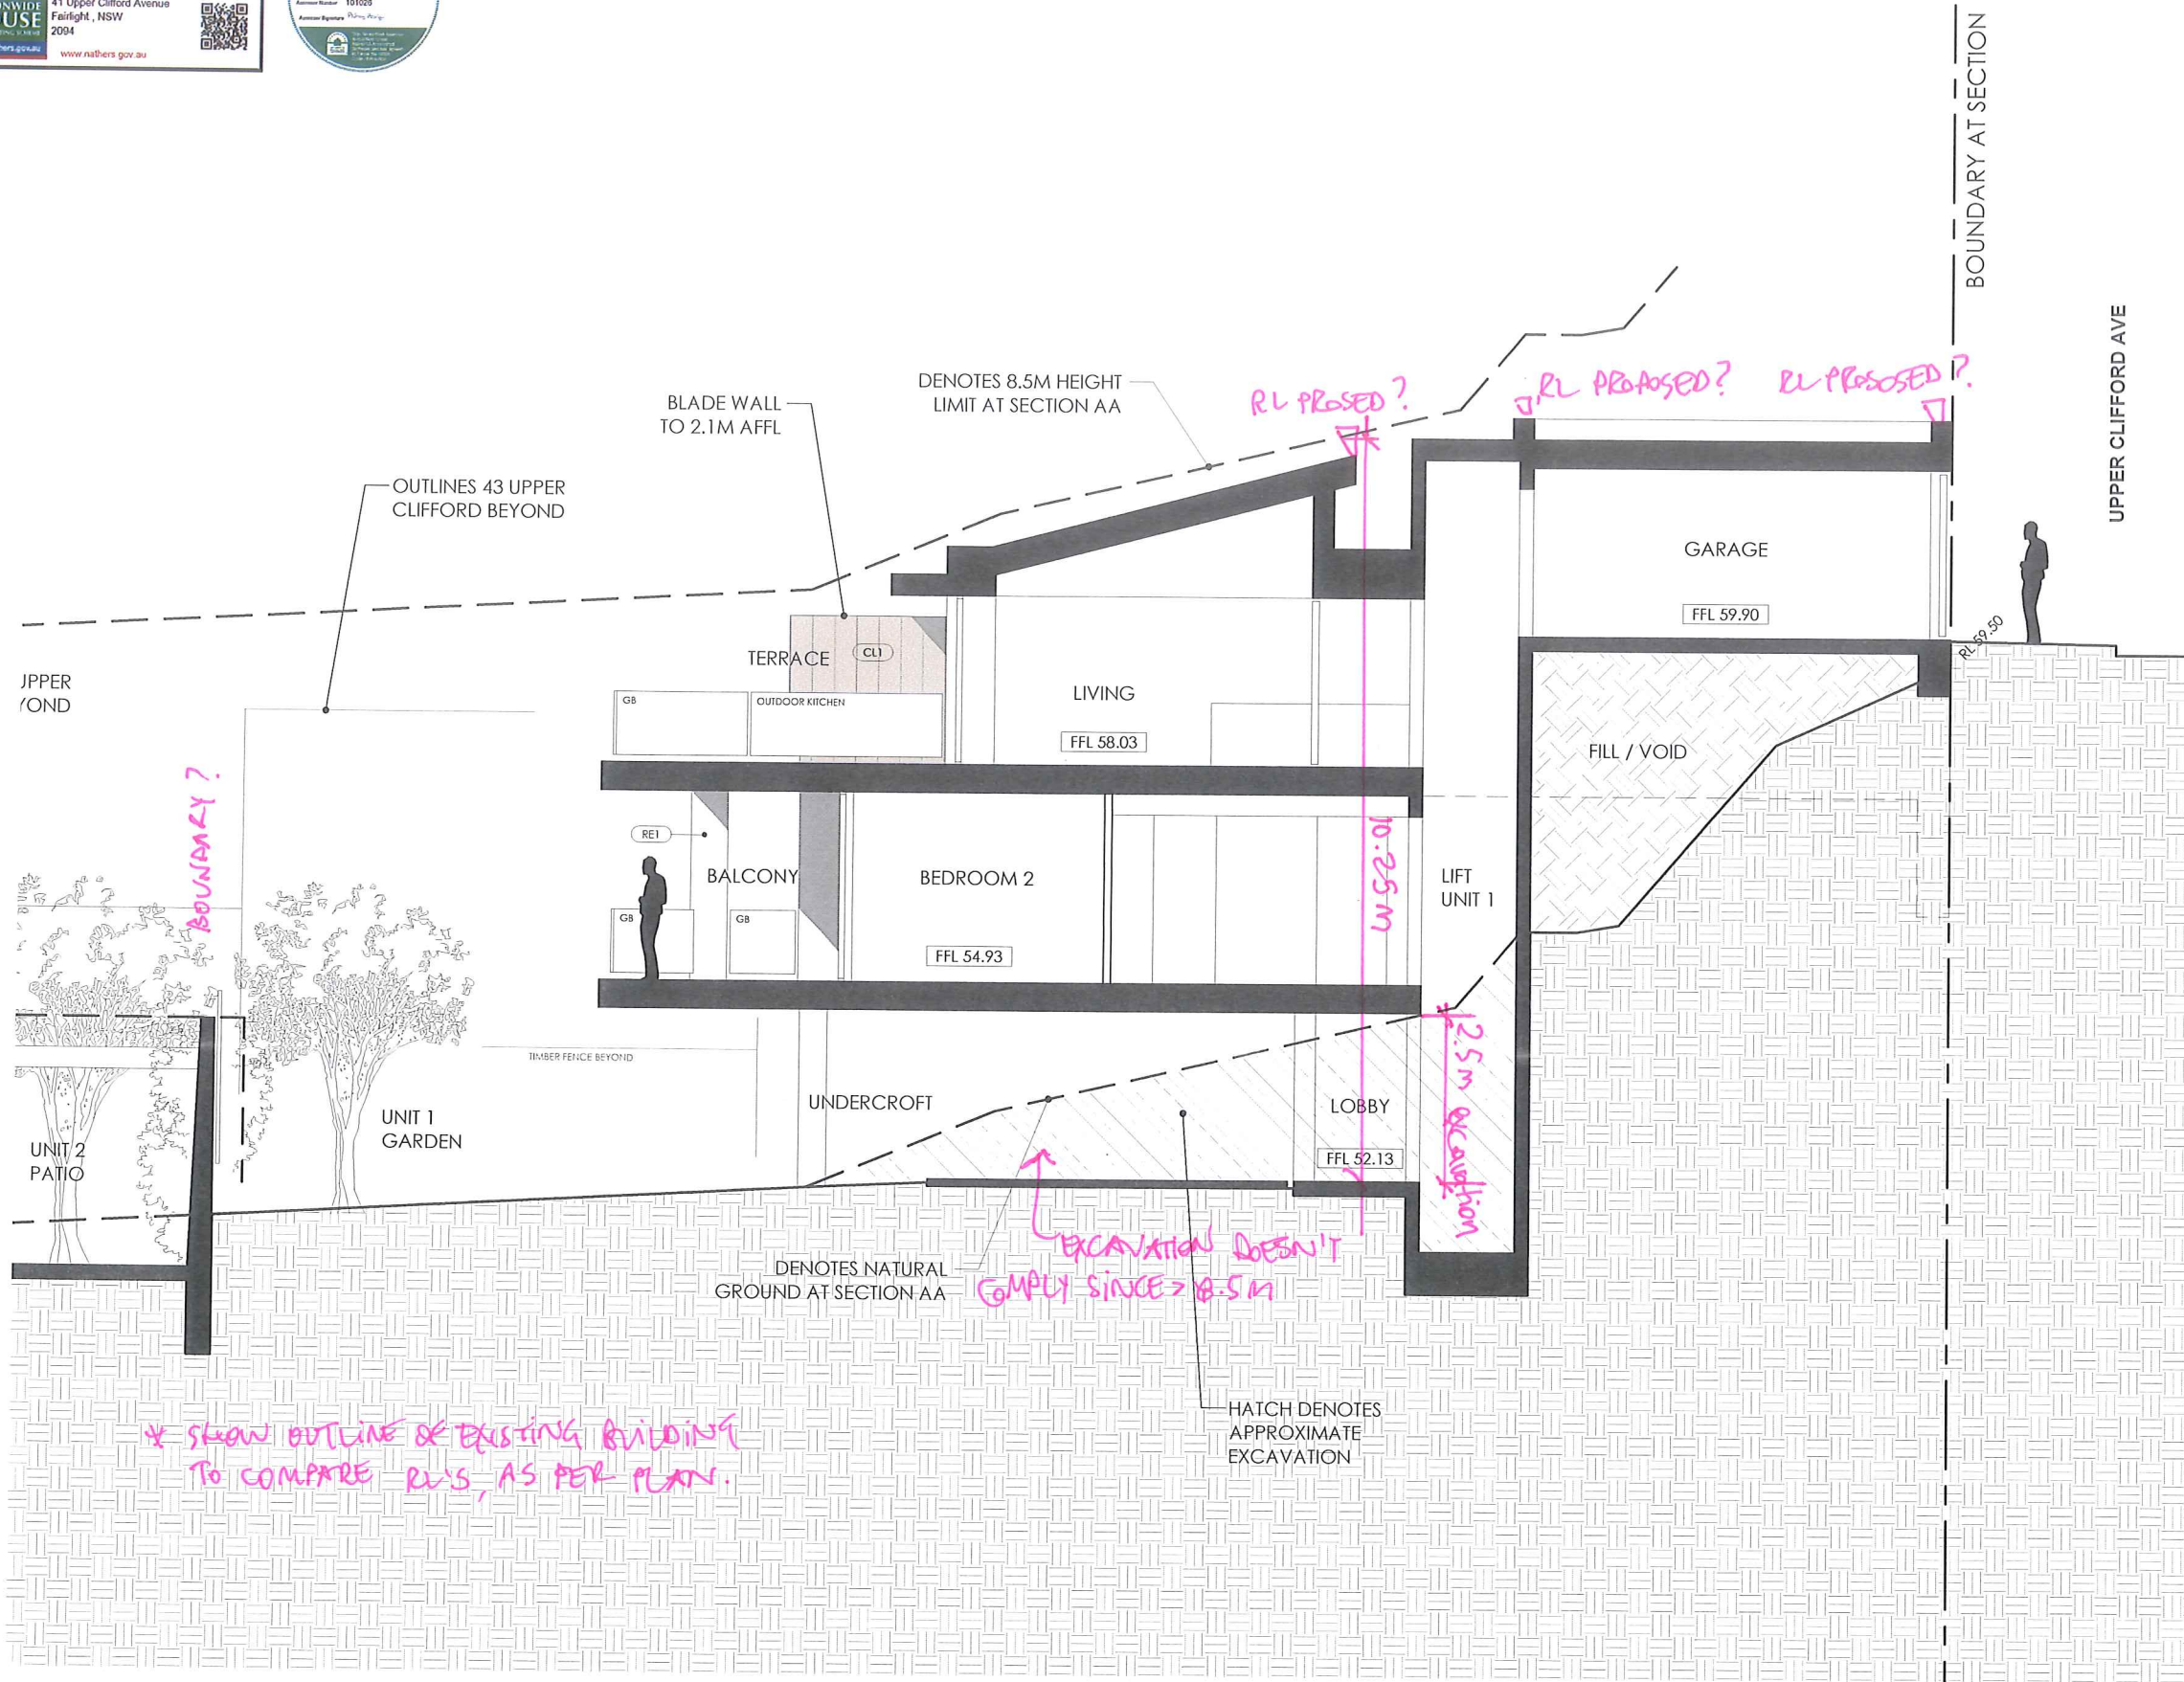

LEGEND

SD	SLIDING DOOR PANEL
LV	GLAZED LOUVRE WINDOW
BF	BIFOLD DOOR
SW	SWING DOOR
AW	AWNING WINDOW
F	FIXED GLAZING
GB	GLASS BALUSTRADE
SK	SKYLIGHT

CL1	CLADDING TYPE 1
CL2	CLADDING TYPE 2
RE1	RENDER TYPE 1
RE2	RENDER TYPE 2
TIM	EXTERNAL TIMBER
PC1	POWDER COATED METAL TYPE 1
CB1	COLORBOND ROOFING TYPE 1

*REFER TO FINISHES SCHEDULE FOR DETAILS

IMPORTANT NOTES:
Do not scale from drawings; use figured dimensions only. Ensure that the drawings used carry the latest revision no. Read in conjunction with consultant engineers drawings - refer contract drawing list.

- All dimensions to be checked on site before commencement of work.
- All discrepancies to be brought to the attention of the Architect.
- Larger scale drawings and written dimensions take precedence.
- The Estuarine Planning Level is min 3.1m AHD. All levels to AHD.

This drawing is copyright and the property of the author, and must not be retained, copied or used without the express authority of Platform Architects Pty Ltd.

REV	DATE	DESCRIPTION	BY
B	2019.07.22	PRELIMINARY	OH
C	2019.07.31	PRELIMINARY	OH
D	2019.08.15	PRELIMINARY - LAYOUTS UPDATE	OH
E	2019.09.20	FOR PRELODGEEMENT MEETING	OH
F	Dec '19	CONSULTANT COORDINATION	OH
G	Mar '19	FOR DA LODGMENT	OH

REVISION NOTES

FOR DA LODGMENT
NOT FOR CONSTRUCTION

platform
ARCHITECTS

Suite 503, 37 East Esplanade Manly NSW 2095
p. 02 9976 6655 abn. 7402056157
www.platformarchitects.com.au

PROJECT DETAILS

DUAL OCCUPANCY WITH BASEMENT CARPARKING
AND SINGLE DWELLING AT

41 UPPER CLIFFORD AVE

FAIRLIGHT NSW 2094

CLIENT

CARL OSCAR PETERSON AND HEATHON FAMILY INVESTMENTS PTY LTD,
643 MILITARY ROAD MOSMAN NSW 2088

DRAWING TITLE

SECTION AA

SHEET 2

SCALE

1:100

@A3

STATUS

DA

NUMBER

23

PROJECT

UCS

REVISION

F


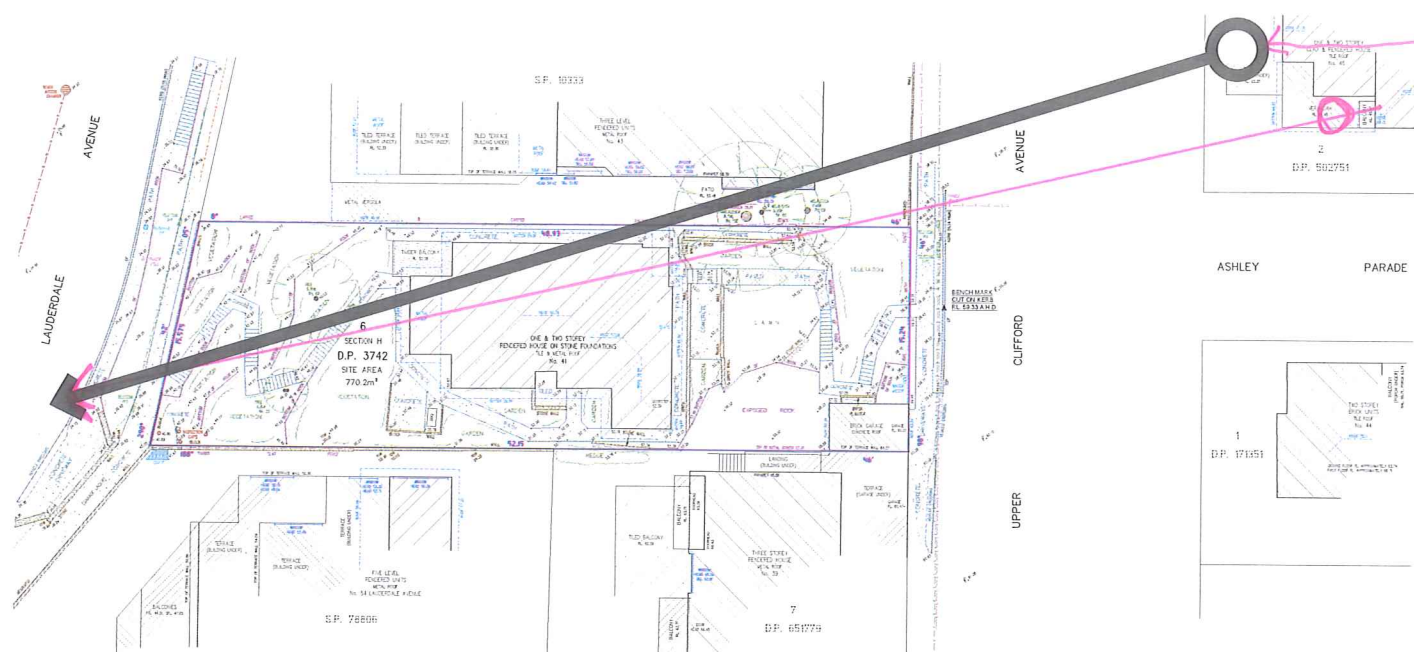


PHOTO TAKEN FROM WESTERN EDGE,
AT BALUSTRADE, OF TERRACE.
THIS UNDERSTATES VIEW LOSS FROM
LIVING ROOM/BALCONY AT SITTING/STANDING HEIGHT

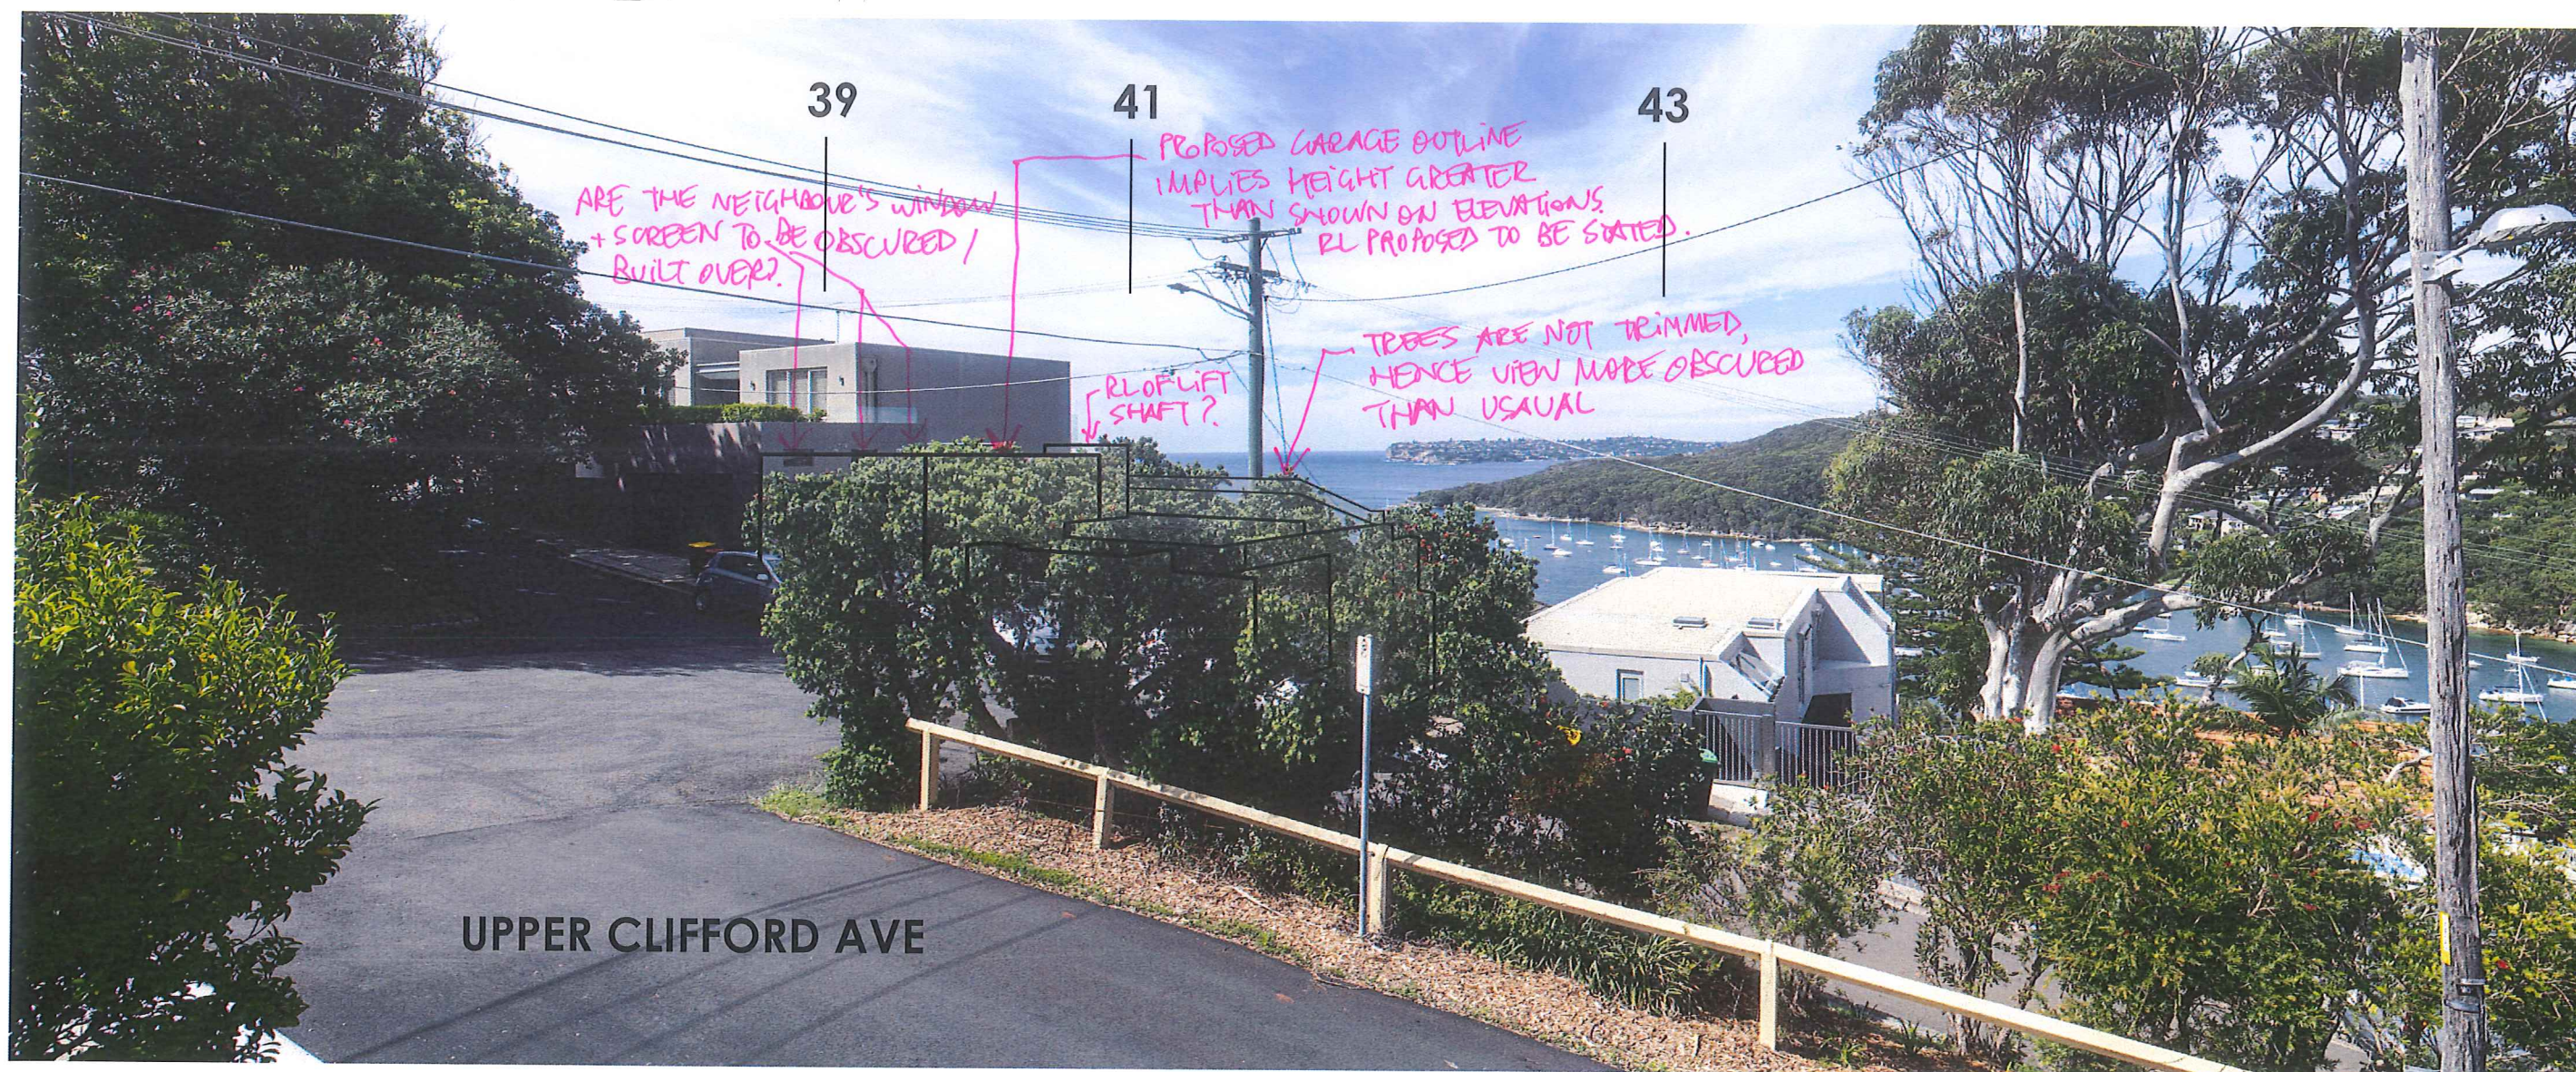

01

VIEW FROM 46 UPPER CLIFFORD AVE
SOUTH TERRACE ON TOP OF THE GARAGE


platform
ARCHITECTS

Suite 303, 39 East Esplanade North 2015
p. 02 9976 6666 abn. 7460286107
nominated architect Bida Group Reg No. 826


PROJECT DETAILS
DUAL OCCUPANCY WITH BASEMENT CARPARKING
AND SINGLE DWELLING AT
41 UPPER CLIFFORD AVE
FAIRLIGHT NSW 2094
CLIENT
CARL OSCAR PETERSON AND HEATON FAMILY INVESTMENTS PTY LTD,
643 MILITARY ROAD MOSMAN NSW 2088

DRAWING TITLE
VIEW ANALYSIS
SHEET 01
SCALE STATUS
NTS DA


PROJECT
UCS
REVISION
A

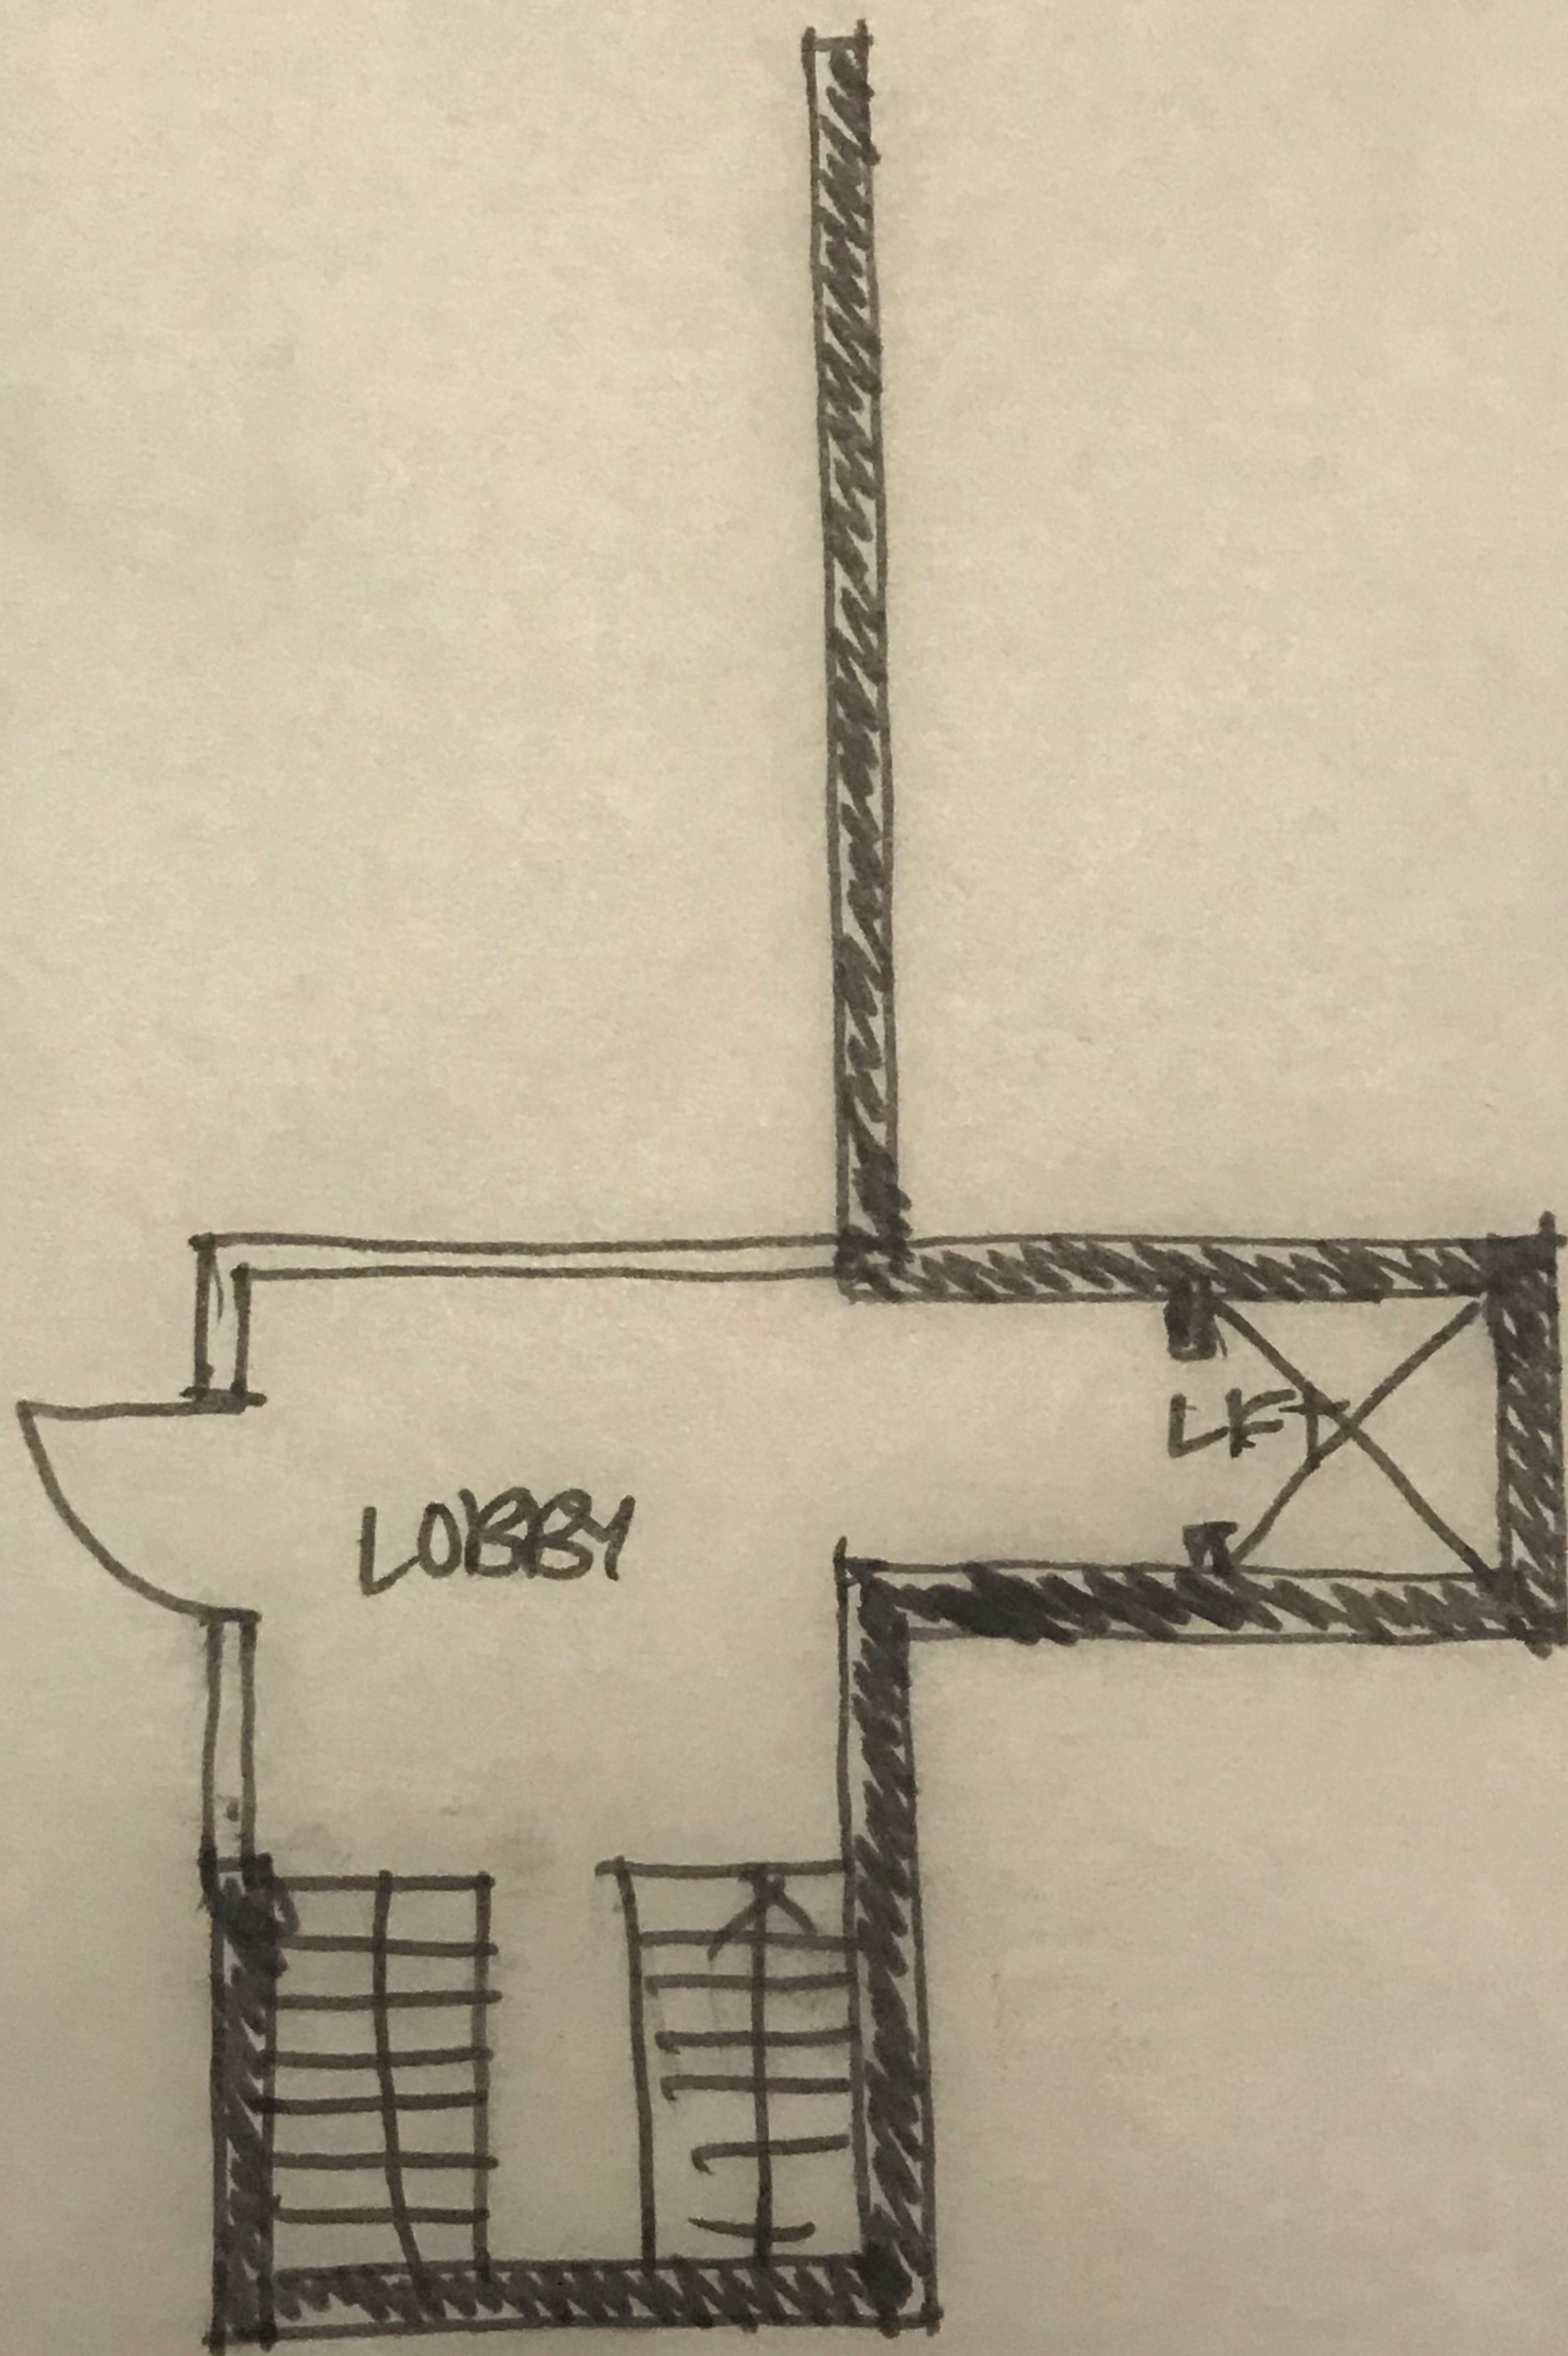


GROUND FLOOR
PLAN

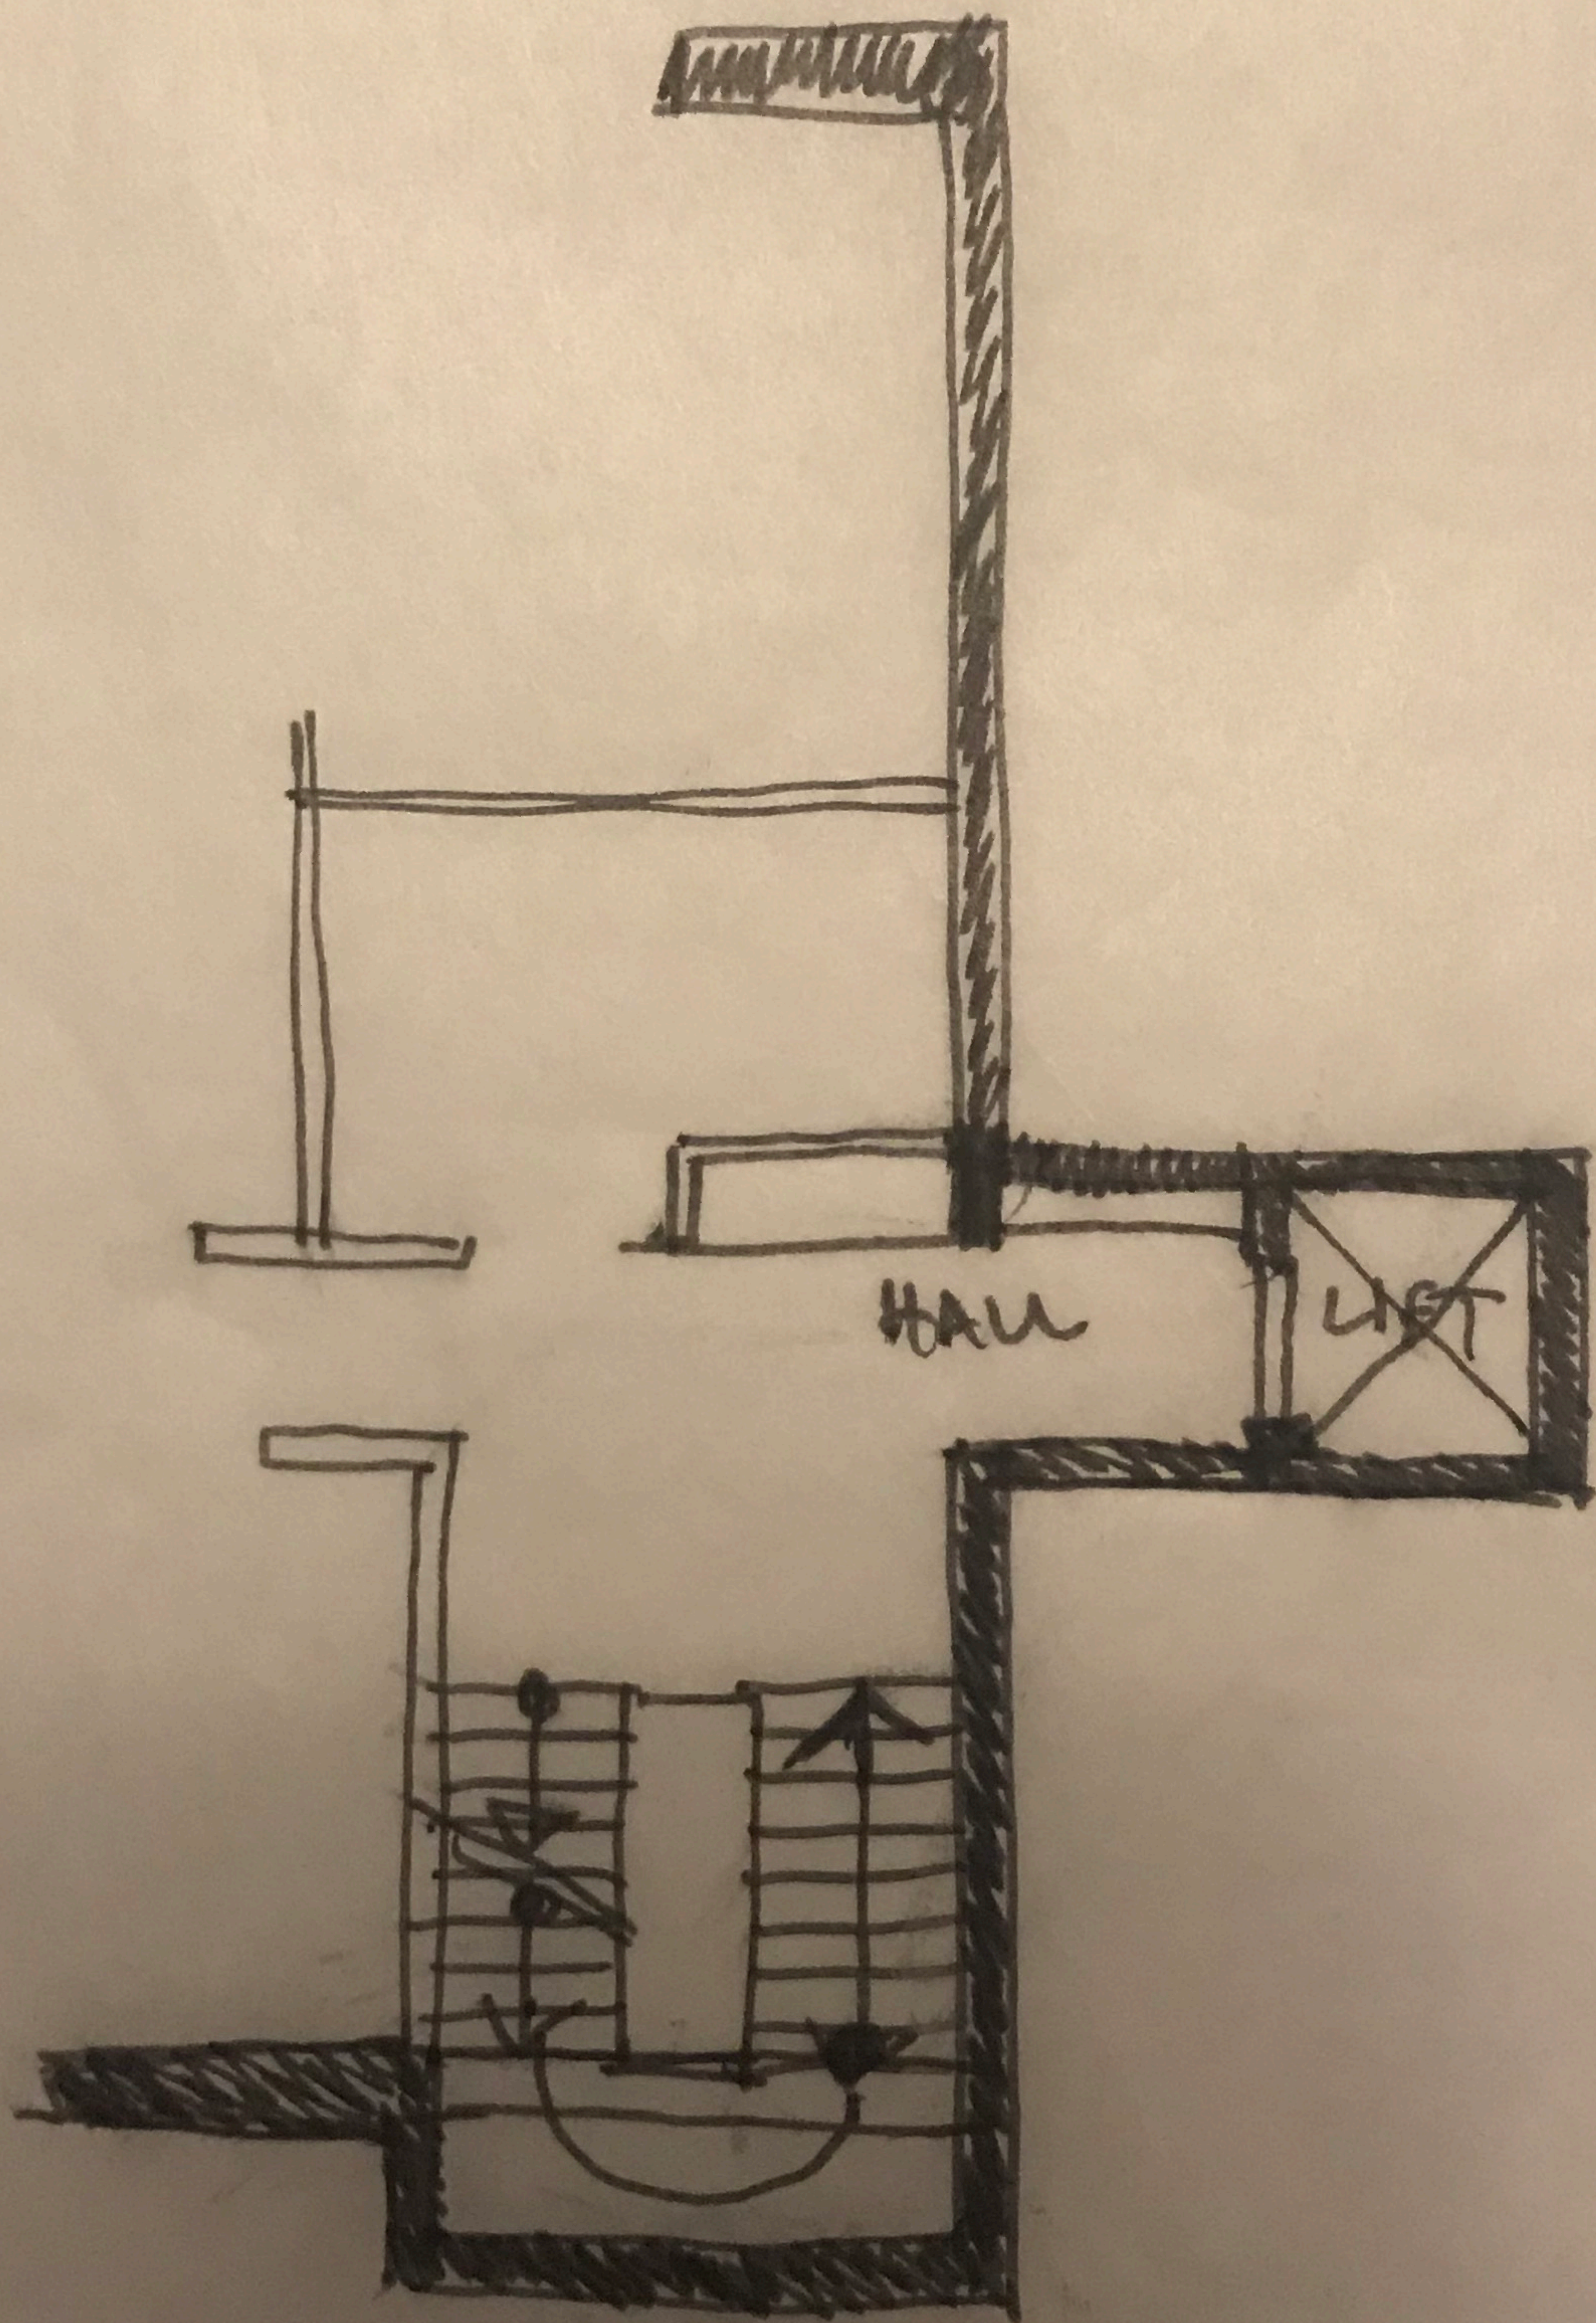

FIRST FLOOR PLAN.

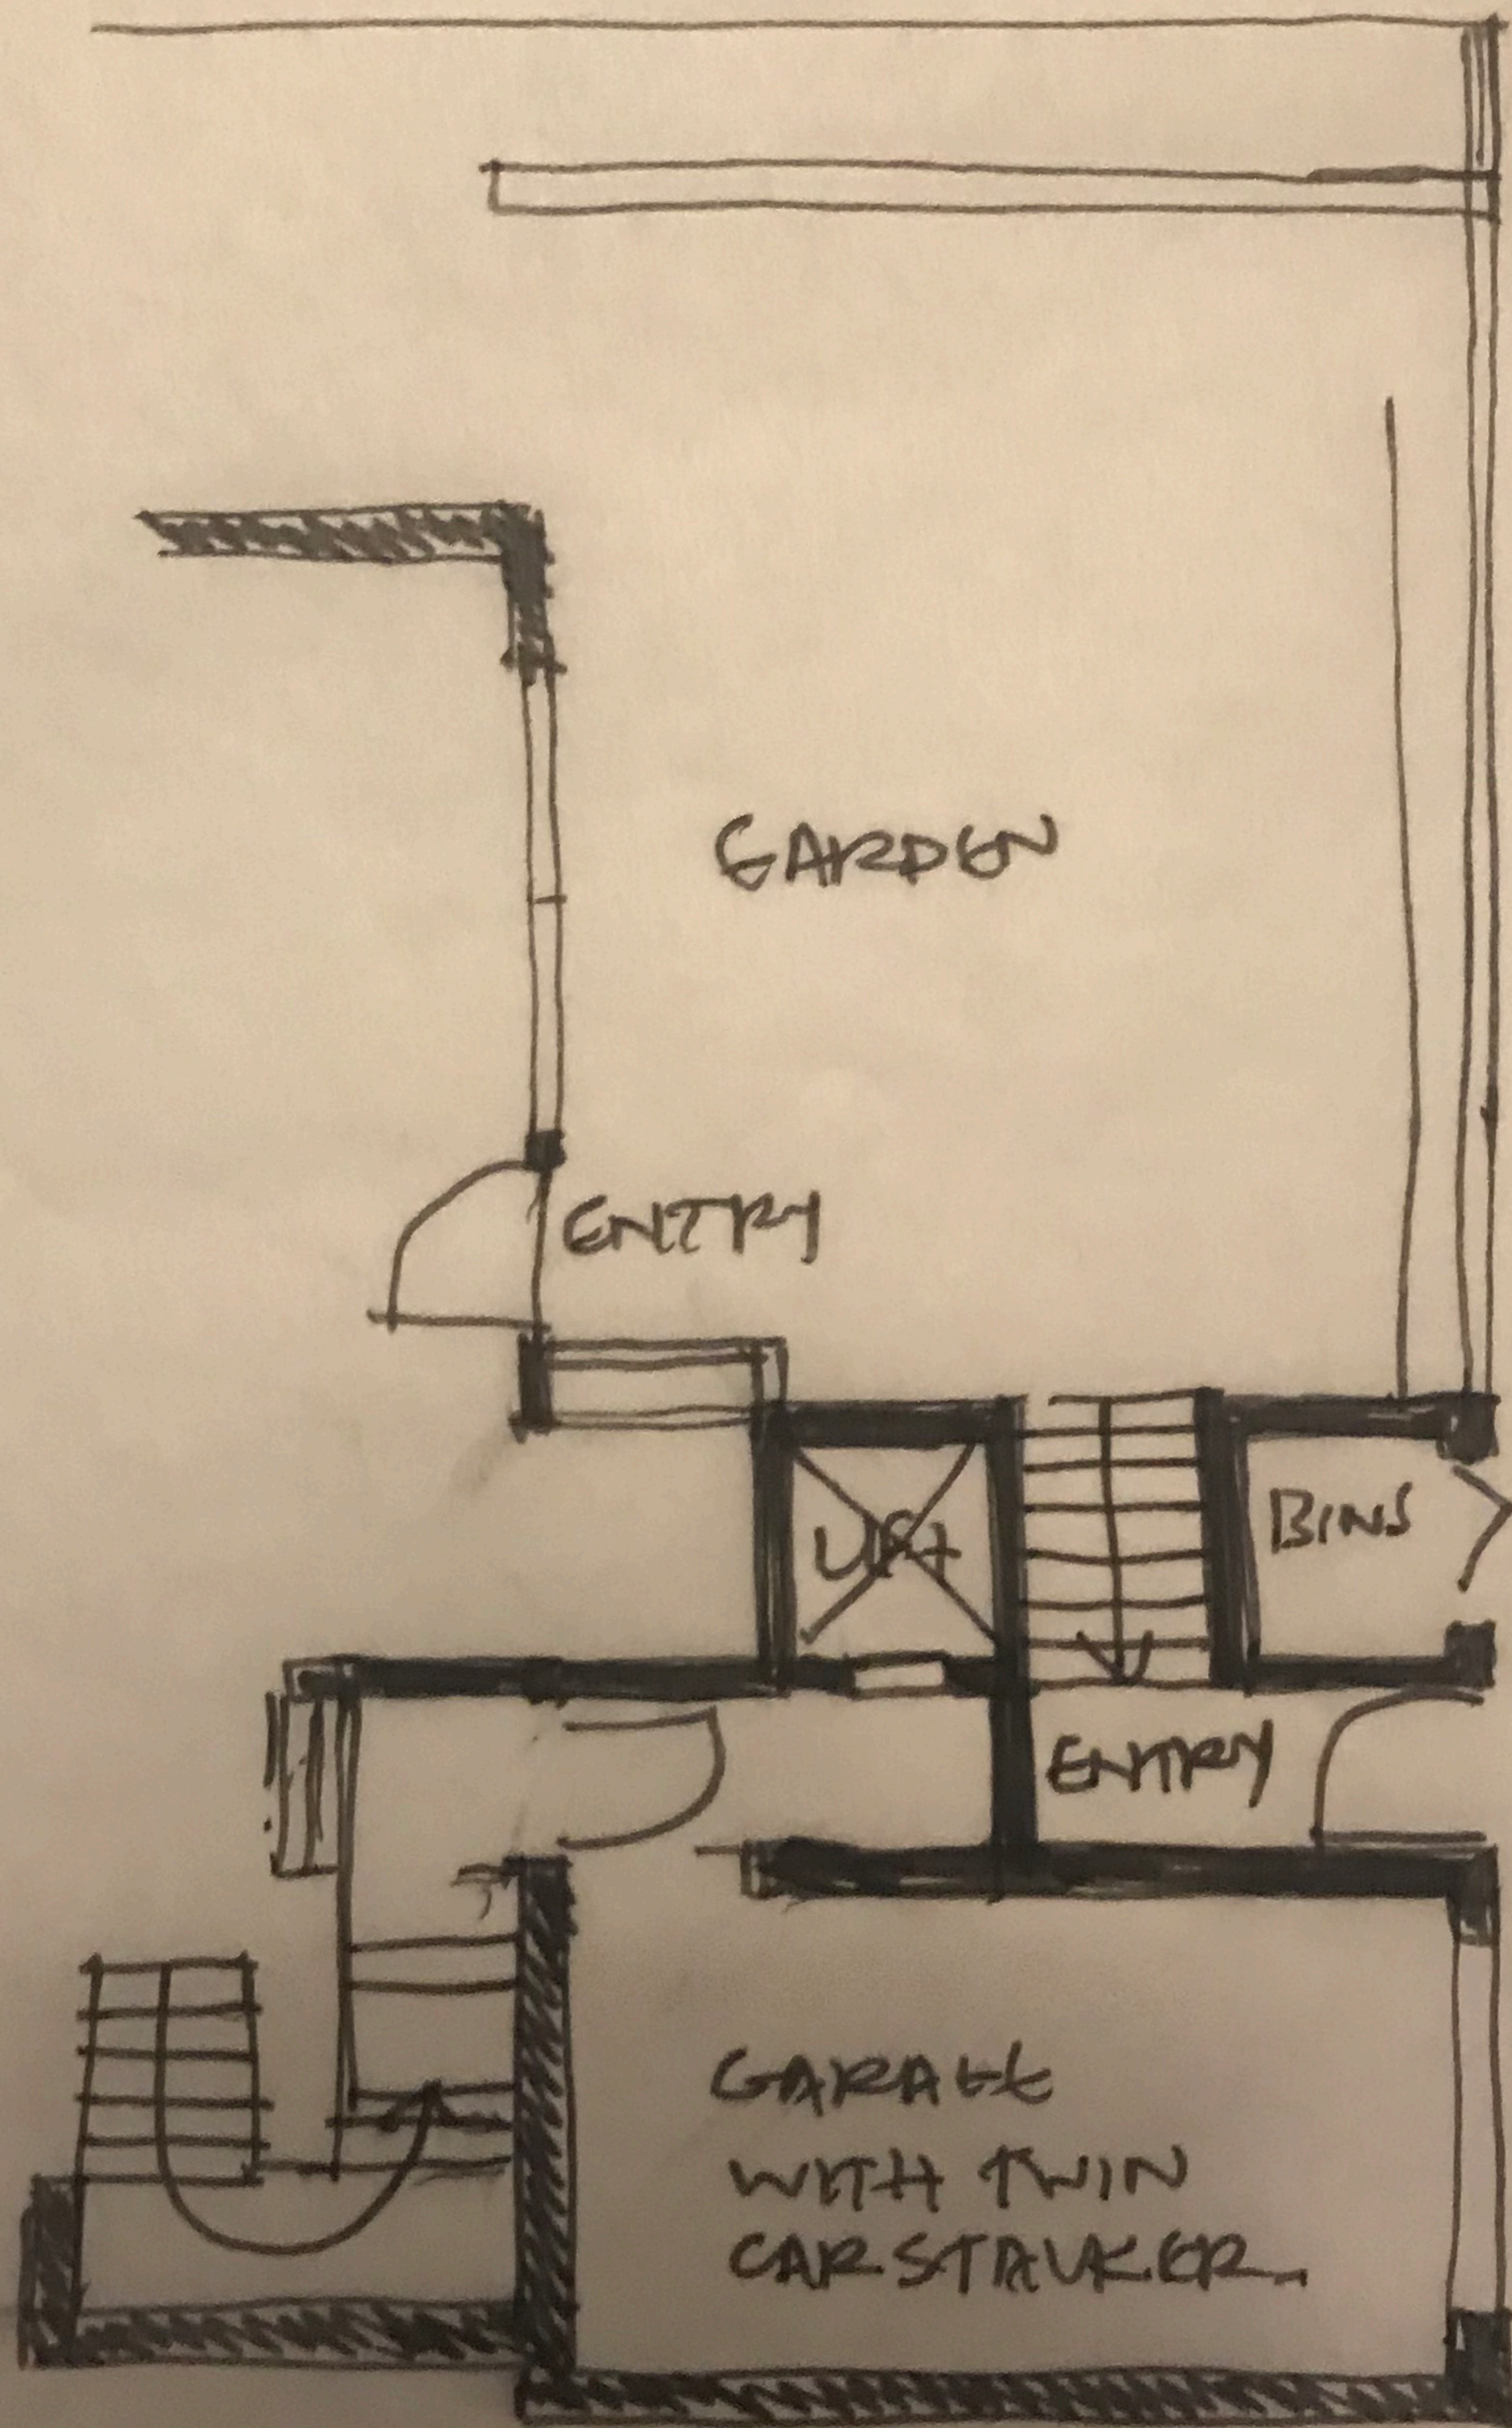

SECOND FLOOR PLAN

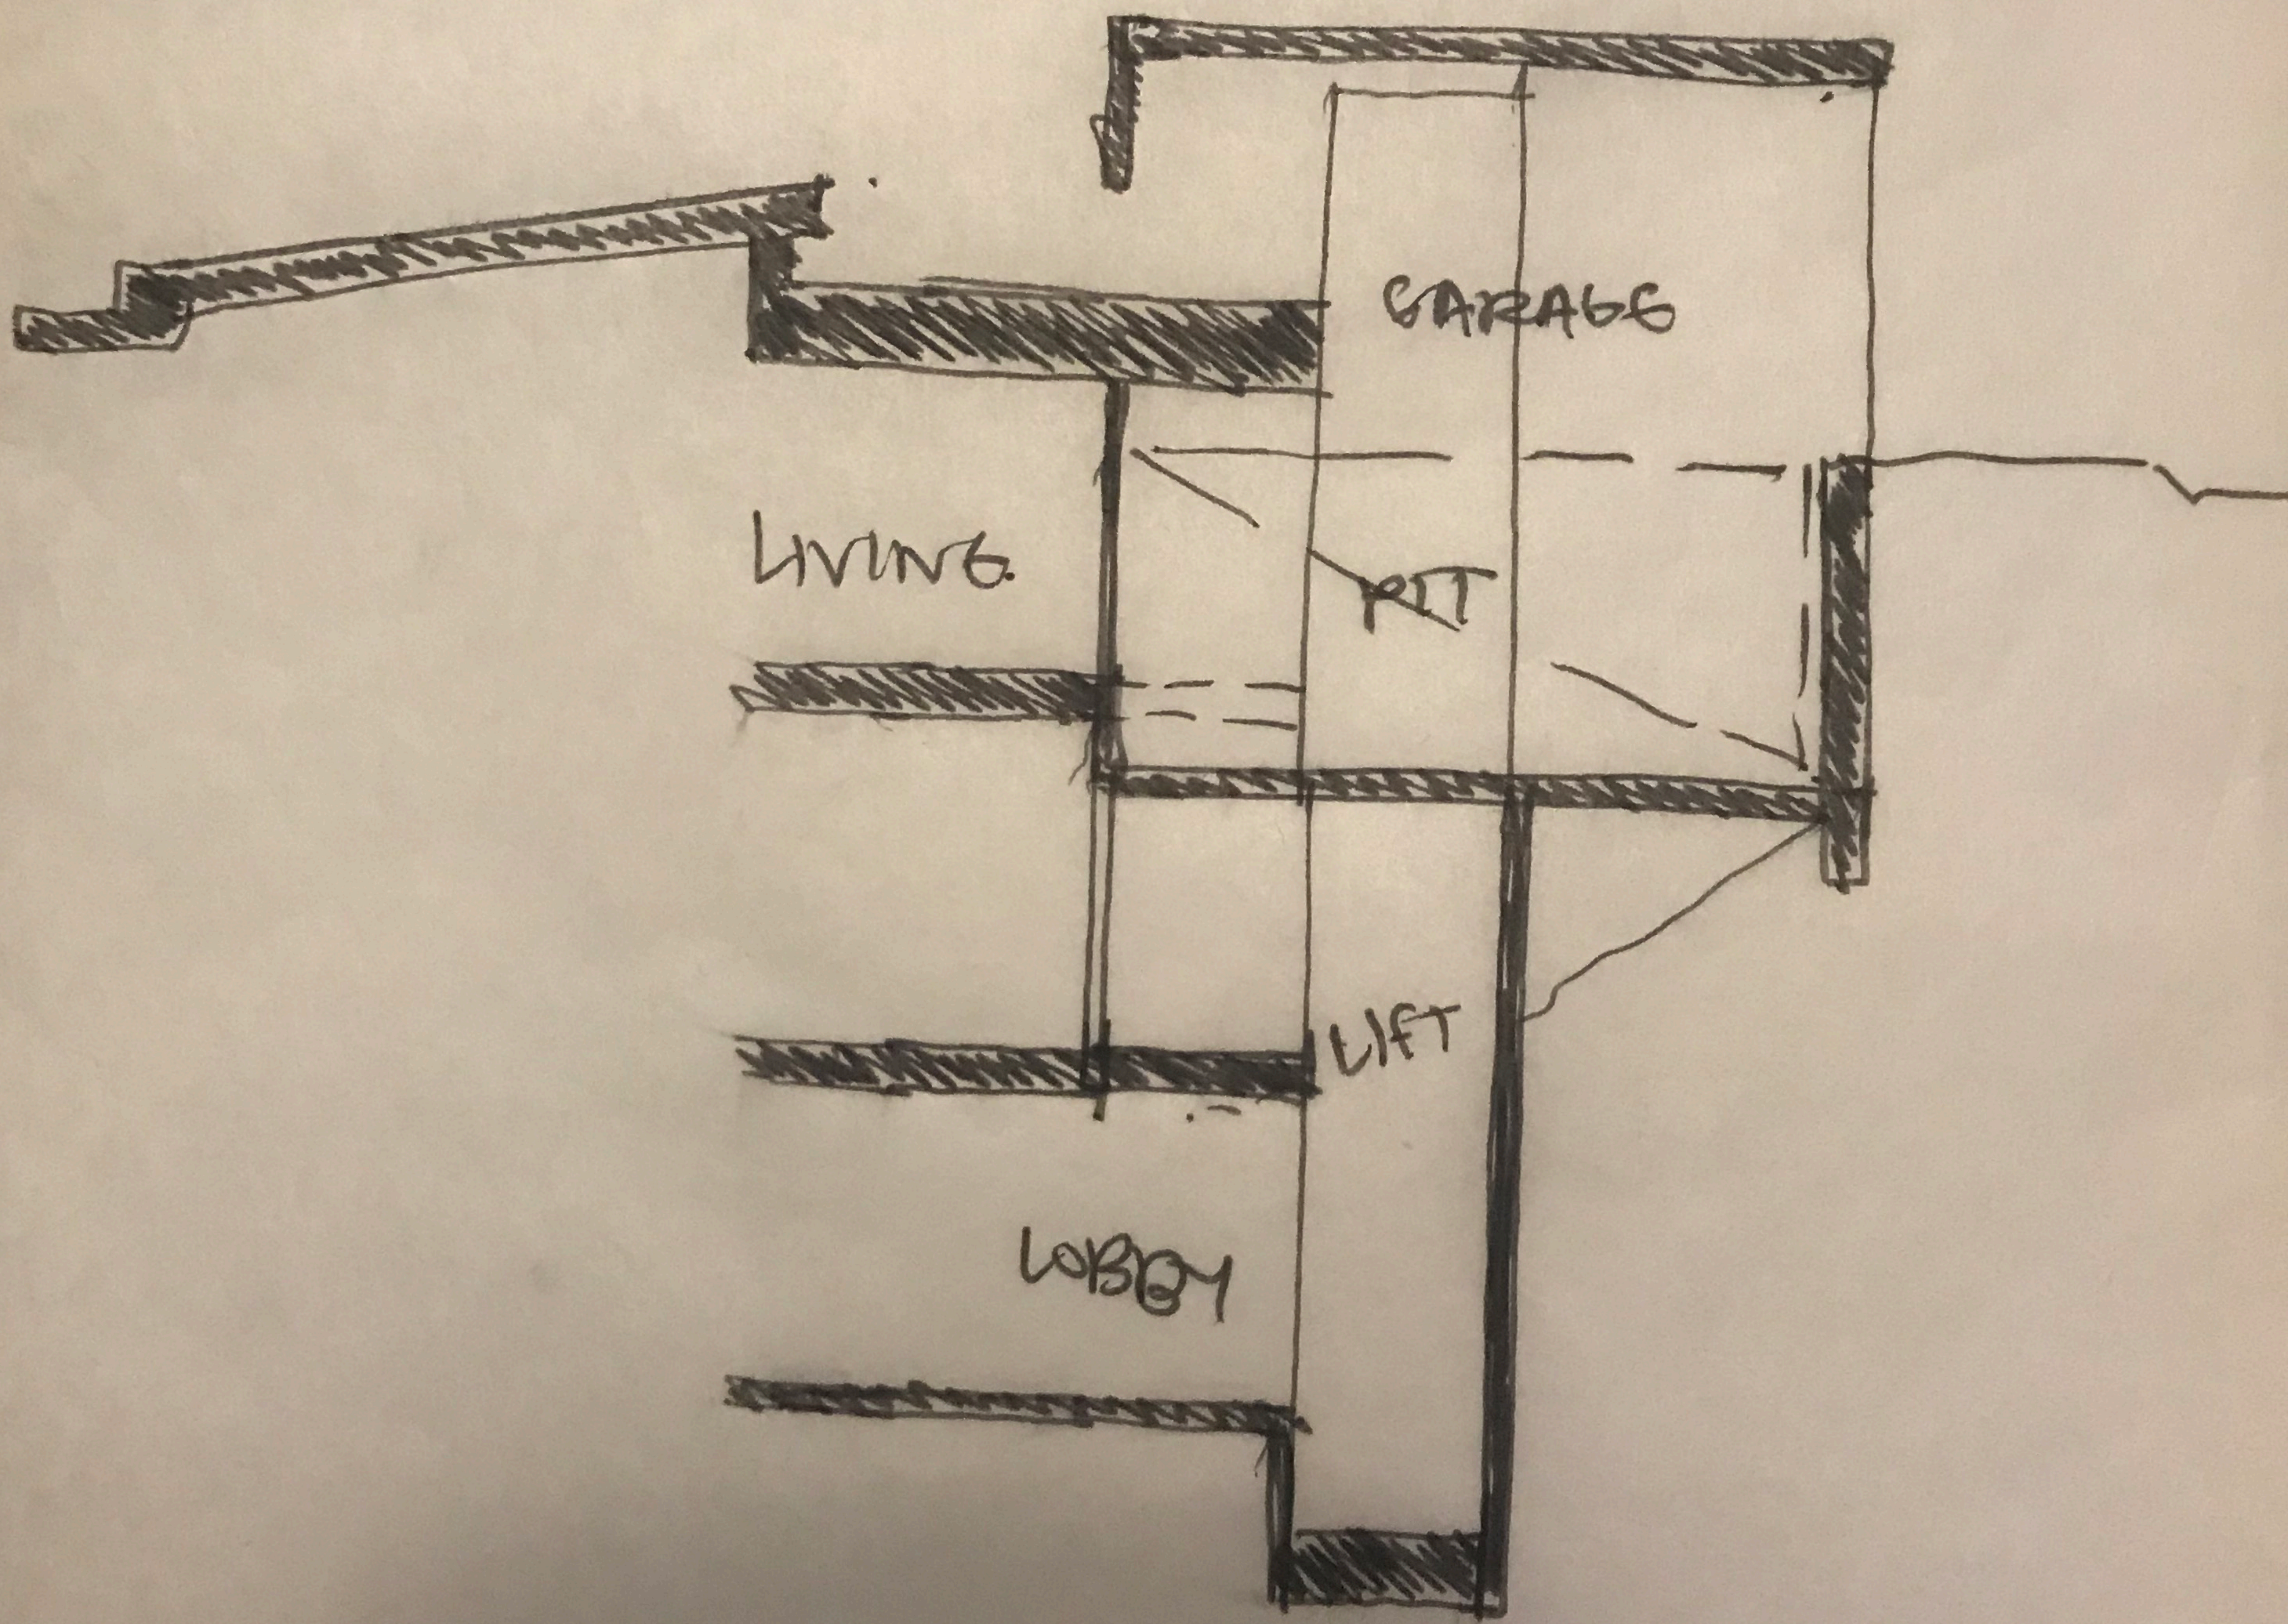

SECTION.



QUADROPARKER N4902

THE IDEAL SOLUTION FOR THE EXTERIORS; ON 2 LEVELS



SHORT DESCRIPTION

INDEPENDENT PARKING SYSTEM ON 2 LEVELS

LOWER LEVEL: SYSTEM COLUMNS ON THE CORNERS

UPPER LEVEL: WITHOUT COLUMNS

INDIVIDUAL CONFIGURATION POSSIBILITIES FOR THE UPPER

PLATFORM AVAILABLE ON REQUEST (e.g. WOODEN COVERING)

SINGLE (2 CARS) AND DOUBLE SYSTEM (4 CARS)

LOAD PER PARKING SPACE: 2.000 KG (STANDARD)

UP TO 2.600 KG (OPTIONAL)

APPLICATION

FOR EXTERIORS, WITH PIT

SINGLE-FAMILY DWELLINGS

MULTI-FAMILY DWELLINGS


HOTELS

OFFICE BUILDINGS

CONDOMINIUMS

COMMERCIALS

FOR PERMANENT USERS ONLY

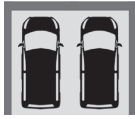S-system
for 2 carsD-system
for 4 cars

NOTE

The total height of the car including roof rail and antenna fixture must not exceed the maximum car height mentioned in the table below. Standard cars do not feature sport equipment (e.g. spoiler, etc.)



No need of separate shafts near to the pit for service or the power unit. Everything can be inside the system's pit.

No need of chains. The system is driven by cylinders.


Platforms are horizontally accessible

For permanent and instructed users only

All dimensions in cm

Hydraulic power unit in the system


In case of partition walls: 10x10 cm wall opening (position: +/- 0 m) for electrical and hydraulic lines

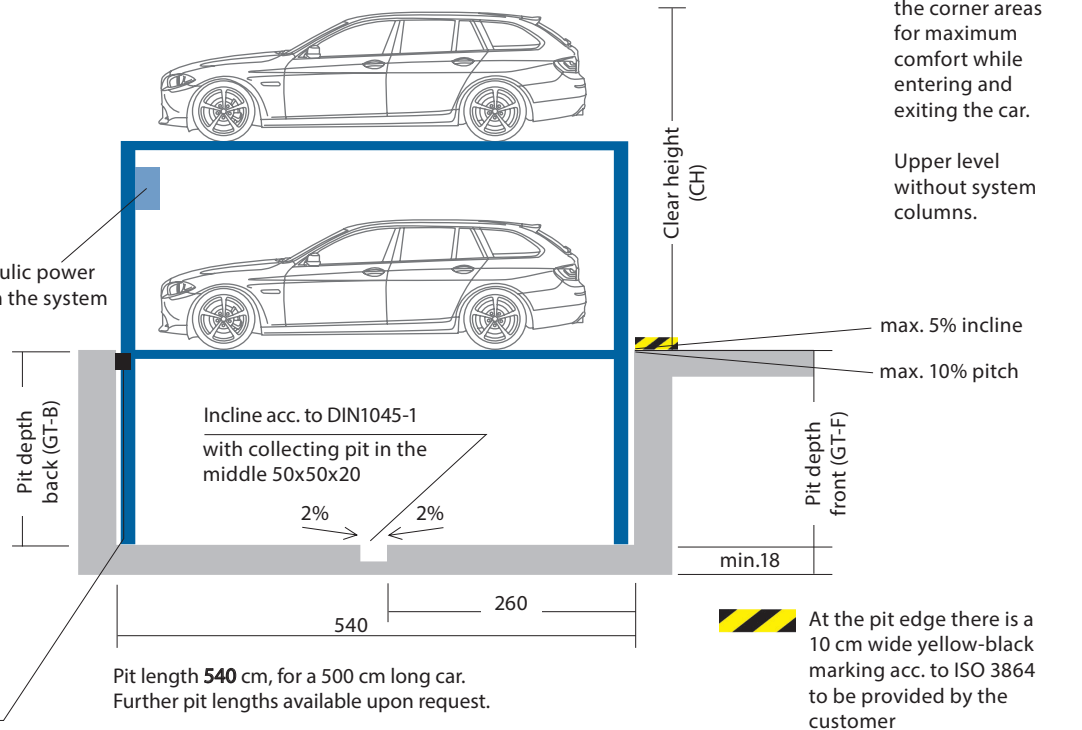


Load per parking space: max. 2.000kg, wheel load: max. 500kg. Optional: max. 2.600kg, wheel load: max. 650kg

PIT DEPTH FRONT (GT-F)	PIT DEPTH BACK (GT-B)	CLEAR HEIGHT (CH)	CAR HEIGHT BELOW	CAR HEIGHT ABOVE
190	190	from 330	155	from 155
200	200	from 340	165	from 155
210	210	from 350	175	from 155
220	220	from 360	185	from 155
230	230	from 370	195	from 155
260	260	from 400	225	from 155

VEHICLE DATA: STANDARD CAR

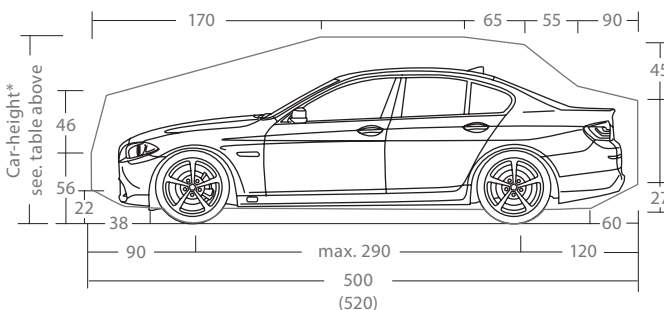

VEHICLE DATA: STANDARD ESTATE CAR

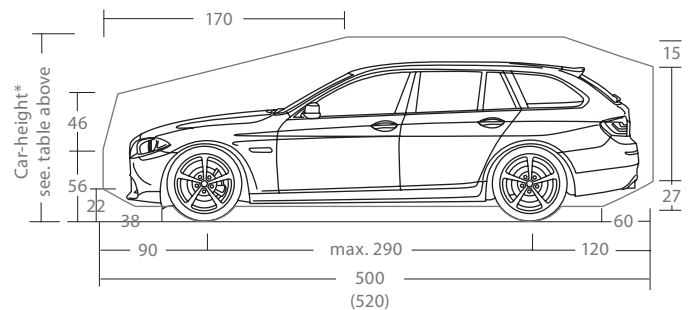


ELECTRICAL INSTALLATION AND FOUNDATION LOADS

Services covered by the NUSSBAUM Company

POS.	QTY.	DESCRIPTION
1	1x	Hydraulic power unit with three-phase motor 230/400V, 50Hz, 6kW (2x 3,0kW)
2	1x	Control line 4x 1,0 ² (for the standard key-operated switch)
3	1x	Control line 7x 1,0 ² (for the locking of the key-operated switch)
4	1x	Control element

Positions 1 to 4 are covered by the Nussbaum company unless otherwise agreed in the offer or in the contract.

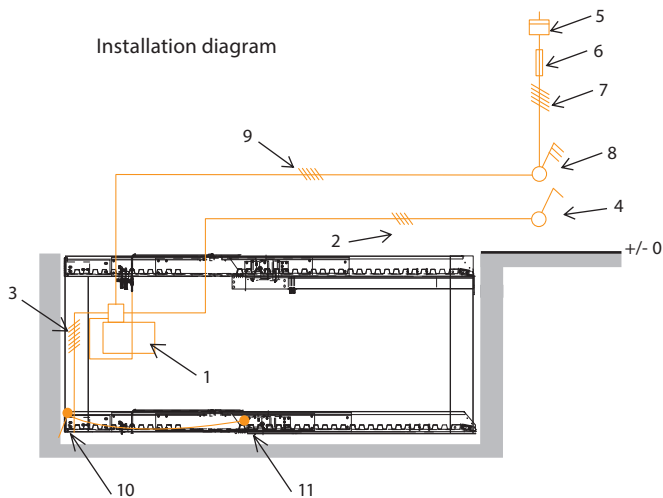


Services to be provided by the customer

POS.	QTY.	DESCRIPTION	POSITION	FREQUENCY
5	1x	Electricity meter	in the supply line	
6	1x	Blade fuse or circuit breaker 3x 25A, slow acc. to DIN VDE 0100 part 430	in the supply line	1x power unit
7	1x	Supply line 5x 4,0 mm ² (3 PH + N + PE) with marked leads + protective earth conductor	to the mains switch	1x power unit
8	1x	Lockable network facility (main control switch)	near power unit	1x power unit
9	1x	Supply line 5x 4,0 mm ² (3 PH + N + PE) with marked leads + protective earth conductor	to the power unit	1x power unit
10	1x	Foundation earth electrodes	pit floor corner	1x pit
11	1x	Equipotential bonding according to DIN EN 60204 from the connector of the foundation earth electrodes to the system	on the pit floor	1x system

FOUNDATION LOADS AND CONSTRUCTION

Foundation and pit walls must be planned so that they can absorb the loads of the parking system according to the schematic diagram shown below. All forces are discharged to the ground by base plates with a minimum area of 150cm². The base plates of the parking system are fastened with metal heavy duty anchor bolts; the borehole is approx. 14 cm deep. Optionally, instead of metal heavy duty anchor bolts, the base plates can be fastened using shear connectors, e.g. in case of watertight concrete or increased noise insulation. The clarification of the fastening methods shall be provided by the customer, if necessary, the shear connectors can be delivered against surcharge.

Foundation, walls and ceilings shall be provided by the customer and completed prior to assembly start and must be true to size, clean and dry. Floor and walls (below the entrance level) made of armoured concrete, concrete quality at least: C25/30.

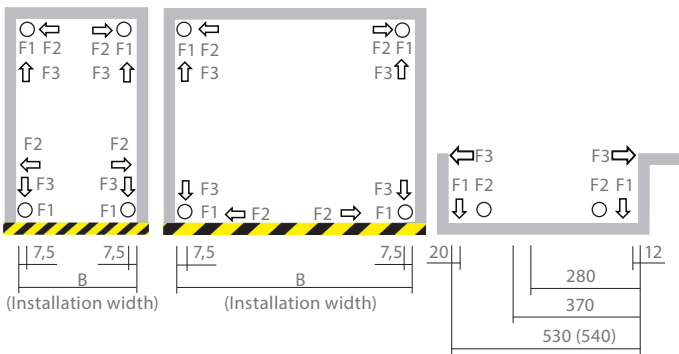

LOADS F	SINGLE SYSTEM 2.000KG	DOUBLE SYSTEM 2.000KG	SINGLE SYSTEM 2.600KG	DOUBLE SYSTEM 2.600KG
F1	20 kN	35 kN	28 kN	45 kN
F2	6 kN	6 kN	6 kN	6 kN
F3	6 kN	6 kN	6 kN	6 kN

Dimensions in cm. All Dimensions are minimum dimensions. Tolerances shall be taken into account additionally, see page „width dimensions for garages“.

WIDTH DIMENSIONS AND PIT FLOOR


All dimensions in cm. All dimensions are minimum dimensions. Advice for planning and tendering: Generally masonry and concrete works are to be conducted according to the German norm VOB/C (DIN 18330 and DIN 18331). In the mentioned norm are pointed the tolerances that are to be fulfilled according to DIN 18202. In this norm are defined the maximum permissible dimension variations as exceedance and shortfall of the nominal size. The nominal size should be planned in order to meet the minimum dimensions necessary for the parking system.

PARTITION WALLS


Single system for 2 cars



Double system for 4 cars

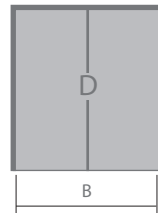

Double system + single system for 6 cars

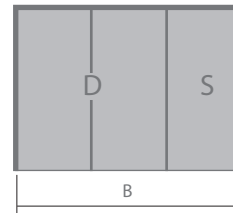

CLEAR PLATFORM WIDTH	INSTALLATION WIDTH B 2,0t - 2,6t	CLEAR PLATFORM WIDTH	INSTALLATION WIDTH B 2,0t - 2,6t	CLEAR PLATFORM WIDTH	INSTALLATION WIDTH B 2,0t - 2,6t
230	265	460	495	460+230	760
		470	505	•	
240	275	480	515	480+240	790
		490	525	•	
250	285	500	535	500+250	820
260	295				


Driving lane width
acc. to country specific regulations.

The power unit is installed on the system and moves together with the system. No extra space needed.

INFORMATION ABOUT THE PIT FLOOR

The pit floor should be built according to the drawing on the right. The four corners, On this surface are the lifting cylinders. These surface must have dimensions 50 x 50 cm and must be even.

In the middle of the pit floor there must be a sump hole in which there must be installed a pump to draw the water that may fall in the pit while dripping from cars or from the sides of the pit and brought out of the pit by a hose. Local regulations for prevention of water pollution shall be observed.

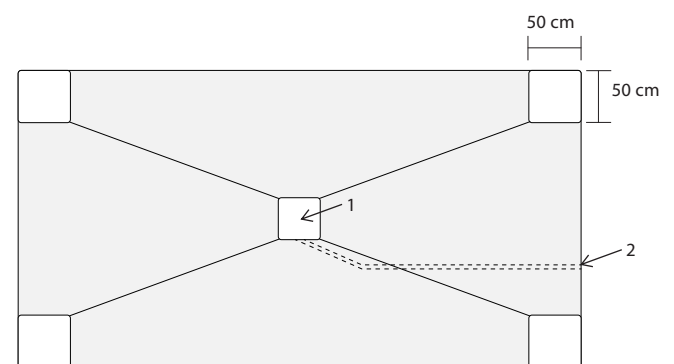

1. Sump hole with pump. Surrounding surfaces' incline to the middle: approx. 2%
2. Drainage pipe to connect to the existing drainage system

For maintenance purposes, in emergency cases, the system can be brought to its basis position (lowered) by unscrewing the upper platform. In case the upper platform is covered with other materials than trapezoidal metal sheet, a shaft shall be built on the side of the pit in order to provide the possibility to come into the pit and maintain the system as the material covering the upper platform can't be unscrewed or removed.

The wall thickness of the pit depends on the loads from outside and must be calculated individually for each pit and each system.

STANDARD FEATURES – IN THE SCOPE OF DELIVERY

NOTE

We suggest periodical maintenance, care and cleaning. Take advantage of NUSSBAUM maintenance agreements.


COMPONENT PARTS

Single system: consisting of 2 single platforms, 4 Telescope columns with hydraulic cylinders, hydraulic block and piping

and/or:

Double system: consisting of 2 double platforms 4 telescope columns with hydraulic cylinders, hydraulic block and piping

DRIVING SHEETS

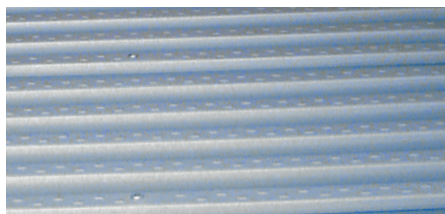

Platforms with sidewalls and driving sheets made of trapezoidal sheet.

DIMENSIONS OF THE SYSTEM

Parking space length: 500 cm

Parking space width: 230 cm

Parking space height: ab 155 cm

Pit depth: 190 cm.

Load per parking space: 2.000 kg.

DOCUMENTATION

Brief operating instructions (fastened to the control unit), documentation (test book and operating instructions).

ELECTRICAL INSTALLATION

For a list of services and interfaces please see the respective table in this brochure.

LOCKABLE KEY SWITCH



Control unit consisting of a lockable key switch (key can be taken off only in the basis position) with emergency-off in dead-man's control. Lifting and lowering by using the respective button.

HYDRAULIC POWER UNIT

Power unit „Silencio“



With hydraulic canalization and cabling to the main control switch. (The under oil unit is not loud thanks to the motor-pumps-combination that absorbs sound and insulates form noise).

Measurements of the power unit + mains switch:

115 x 25 x 75 cm.

Position of the power unit:

The power unit is fastened on the system and each system is provided with its own power unit.

The power unit will be installed on the left side of the lower platform.

CORROSION PROTECTION

C3-Line


For Regions with average snowfall and humidity levels (standard in Germany).

C2-Line

Recommended only for regions with small or no snowfall and low humidity levels.

SAFETY DEVICES

- „Kommando-Folge-cylinder“ (mounted on cross) to improve the synchronous drive of the platforms in case of unequal load charge.
- Safety device to avoid lowering in case of pipeline rupture.
- Fastening of the parking system and hydraulic power unit with stud-bolts, electrical cabling fastened with impact dowels.
- Handrails on the platforms where necessary to avoid danger of falling down from the system.

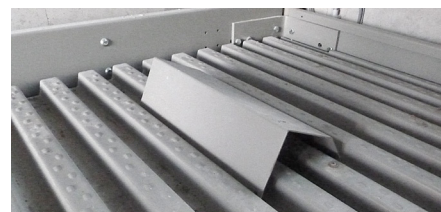

- Wedge to help position the vehicle.

Note:

- Safety fences against shear and crushing points are a priority and must be provided by the customer.

OPTIONS AND EXTRA EQUIPMENT

Available upon request - Examples

NOTE

We suggest periodical maintainance, care and cleaning. Take advantage of NUSSBAUM maintainance agreements.

DIMENSIONS OF THE SYSTEM

Parking space length: from 510 to 540 cm

Parking space width: from 240 to 250 cm
(S-system up to 260 cm)

Parking space height: from 165 to 225 cm

Pit depths: from 200/200 to 260/260 cm.

Fastening of the parking system with chemical anchors in case of heighthened foundation requirements or sound insulation.

VEHICLE WEIGHT

Higher load per parking space:
up to 2.300 kg or 2.600 kg.

WEATHERPROOF CASING AND SUPPORTING PILLAR



Optionally with the key switch it is possible to deliver the following features:

- Weatherproof casing for the key switch.
- Supporting pillar for the key switch.

MOBILE SAFETY FENCES

The basis configuration is provided with wired grating. Alternatively it is possible to get plastic plates as safety fence.

DRIVING SHEETS




Upper platforms with Aluminium-bulb plates driving sheets and special driving wedge to help position the vehicle.

UPPER PLATFORM COVERINGS

It is possible to deliver a special covering for the upper platform. For more information see next page. Details upon request.

LAUFSTEGE

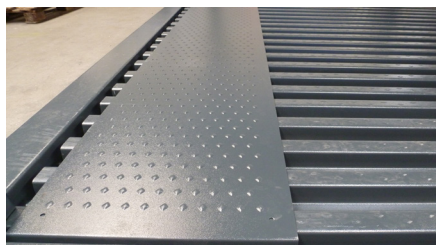

Catwalk on trapez. sheet for more walking comfort

For better walking comfort
Positioned on the left side of the parking space. 1,5 mm galvanized sheet, coined surface area. The catwalk is bolted to the driving sheet.

CARPORT

It is possible to deliver a mobile roof for the system. For more information see next page. Details upon request.

CORROSION PROTECTION

C4-Line: driving sheets powdered on both sides
For regions with highly corrosive humidity levels.

HYDRAULIC

- HVLP 32-330 oil for extreme temperature variations.
- Heated hydraulic power unit.

EXTRA SOUND INSULATION



Sound insulation hood for the power unit

Airborne noise package
For the power unit to reduce the airborne noise.

Structure/borne noise package
Measures to reduce the sound propagation from the parking system to the building.

Note

- In order to comply with the DIN 4109/A1 Table 4 - requirements for the allowed noise level in areas in need of protection from noises coming from the technical equipment, the perimetral parts of the garage building shall be built with a sound reduction index R_w' of at least 57 dB.

OPTIONAL CONFIGURATION POSSIBILITIES

The fitting solution for every situation. Ask us!

NOTE

Frame constructions cause a loss in the lower parking space height.

CARPORT - THE MOBILE ROOF

A mobile roof offers not only high protection against bad weather but is also a special eye-catcher. The wooden roof will be mounted on the existing platforms.



Systems with mobile roof seen from the front



Systems with mobile roof seen from the side

UPPER PLATFORM COVERINGS - AS DECORATION

Upon request it is possible to install special coverings on the upper platform. These coverings are available in different materials and configurations so that they can adapt to the existing floor.



Gravel covering



Gravel-plants covering



Rubber covering in stone structure (3 cm thick)



Synthetic stone covering (3 cm thick)



Wooden covering



Greenery

SERVICES TO BE PROVIDED BY THE CUSTOMER AND PLANNING INDICATIONS

During the planning phase please observe and comply with the following notes!

SERVICES TO BE PROVIDED BY THE CUSTOMER

Safety fences

Safety fences acc. to DIN EN ISO 13857 must be provided by the customer.

Parking spaces' numeration

For the allocation of the parking spaces we suggest our customers to numerate the parking spaces.

Noise abatement measures

The compliance with these measures must be carried out by the customer acc. to norm DIN 4109: „Sound insulation in building construction“.

Lighting

To be carried out by the customer acc. to DIN 67528: „Lighting for parking areas and indoor car parks“.

Pit-foundation

To be carried out by the customer acc. to the specifications in this brochure.

Electrical installation

Prior to starting the assembly the customer must provide a lockable main control switch out of the system/pit and close to the power unit. Electrical services to be provided by the customer acc. to this brochure's spec.

Installation requirements

The compliance with installation requirements acc. to quotation.

Drainage

Drainage channel 10 cm x 10 cm with collecting pit 50 cm x 50 cm x 20 cm acc. to this brochure's spec to be carried out by the customer.

Fire protection

The customer must agree upon the fire protection requirements and the required measures with the local fire department and realise them.

Marking

The customer must provide a 10 cm wide yellow-black marking on the front pit edge according to the norm ISO 3864.

Wall openings

In case of partition walls the customer must realise a 10 cm x 10 cm wall opening for hosting hydraulic and electrical cables.

Building permit

The customer must apply for and get the required permits in order to allow the installation of the parking system.

Control unit

The customer must make sure that a plan surface of (L x W) 50 cm x 20 cm for the installation of the control unit is directly close to the power unit and out of the platforms' moving area.

PLANNING INDICATIONS

Parking space width and driving lanes

While planning the parking space and driving lane dimensions please observe and comply with the local/national prescriptions for the Garages' construction. For more parking comfort we suggest you to plan parking spaces of at least 250 cm width.

Group of users

Our parking systems are conceived for a permanent and instructed group of users.

Maintenance and care

We suggest a timely conclusion of a maintenance agreement.

We suggest also to perform maintenance, care and cleaning at regular time intervals.

EG-Machinery directive

Our parking systems comply with the EG-Machinery directive and are CE certified according to the norm DIN EN 14010.

Ramps' inclination

Ramps leading to garages shall not have more than 15% inclination.

Modifications

The company Nussbaum Parking GmbH reserves the right to make dimensional, design and technical modifications.