

Peter J Boyce & Associates

Accredited Building Surveyors

Planning NSW Accreditation No: BPB0043
ABN: 92 616 124 481

t 9868 2855 | f 9868 2655
e info@boycecorp.com.au

PO Box 375, Strathfield NSW 2135
Level 2, 41 Rawson Street, Epping NSW 2121

2 September 2015

Pittwater Council
Attention: The General Manager
PO Box 882
MONA VALE NSW 1660

Dear Sir / Madam

975 Barrenjoey Road, Palm Beach Submission of Modified Construction Certificate AO787(M)

I have received application for a Modified Construction Certificate ("Modified CC") in respect of the above property in relation to Development Consent N0099/05 & N0099/05/S96/1. The Modified CC has been approved.

As such, please find enclosed:

1. Modified CC
2. Cheque for \$36 for the registration of the Modified CC
3. Completed application form
4. Architectural plans

Should any of the above documents not be received please advise me immediately.

Yours faithfully



Peter Boyce



\$36 REC 383930 3/9/15

Peter J Boyce & Associates

Accredited Building Surveyors



Planning NSW Accreditation No: BPP0043

ABN: 92 616 124 481

t 9868 2855 | f 9868 2655

e info@boycecorp.com.au

PO Box 375, Strathfield NSW 2135

Level 2, 41 Rawson Street, Epping NSW 2121

Modified Construction Certificate

Certificate No.

AO787(M)

SECTION A. The Application

1. Details of the Applicant

Name

Robert Gilman

Address

975 Barrenjoey Road

Suburb or town

Palm Beach

State

NSW

Postcode

2108

2. Details of the Property

Unit/Street no.

975

Street name

Barrenjoey Road

Suburb or town

Palm Beach

State

NSW

Postcode

2108

Lot no.

Lot 1

Section

DP / SP no.

DP 205296

Volume/folio

3. Description of the proposed development

Alterations and additions to the existing dwelling – **This CC does not include the piers already constructed to support the extension of the inclinator or the inclinator.**

4. Development Consent

Date of Development
Consent

5 August 2005 & 12 November 2014

Development Consent
reference no.

N0099/05 & N0099/05/S96/1

Name of Council

Pittwater Council

5. Date of the application for Modified Construction Certificate

2 September 2015

6. Date Application received by the Certifying Authority

2 September 2015

SECTION B. Certifying Authority

Name

Peter Boyce

Accreditation no.

BPB0043

Address

Level 2, 41 Rawson Street, Epping NSW 2121

SECTION C. Class of building

Class of the proposed building under the Building Code of Australia.
Note: If parts of the building will have different classes, include all classes.

1a

SECTION D. Conditions

☐ This certificate is subject to the conditions set out in the attached Schedule of Conditions (indicate if applicable)

SECTION E. Attachments (Indicate as appropriate)

☐ Conditions schedule

☐ Fire safety schedule

☐ Fire link conversion schedule

SECTION F. Date

Date of this Certificate

2 SEP 2015

SECTION G. Certification


I certify that work completed in accordance with the documentation accompanying the Application for this Certificate (with such modifications, if any, verified by me as may be shown on that documentation) will comply with the requirements of the *Environmental Planning & Assessment Regulation 2000* as referred to in s.81A(5) of the *Environmental Planning & Assessment Act 1979*.

The documents listed below accompanied the Application for this Certificate.

Note: The Certificate is to be endorsed upon all relevant plans and specifications.

Jmh living design drawing nos 14 38 01 to 09.

SECTION H. Signature*

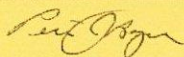

* Must only be signed by the Certifying Authority

Peter J Boyce & Associates

Accredited Building Surveyors

Planning NSW Accreditation No. BPB0043
ABN: 92 616 124 481

t 9868 2855 f 9868 2655
e info@boycecorp.com.au

PO Box 375, Strathfield NSW 2135
Level 2, 41 Rawson Street, Epping NSW 2101

2 SEP 2015

Application for a modified construction certificate

Information for the Applicant

- This form may be used to apply for a modified construction certificate to carry out building work under your development consent from Council.
- To minimise delay in receiving a decision about the Application, please fill in all sections and ensure all relevant information and documents are provided.
- Once completed, this Application form should be submitted to Peter J Boyce & Associates for determination.
- A modified construction certificate has no effect if it is issued after the building work or subdivision work to which it relates is physically commenced on the land to which the relevant development consent applies.

SECTION A. Details of the Applicant*

*An application for a modified construction certificate may only be made by a person who has the benefit of the development consent. An application may not be made by person who will carry out the building work or subdivision work unless that person owns the land on which the work is to be carried out.

i) Where the Applicant is a natural person or persons:

Applicant 1:

Mr ☒ Ms ☐ Mrs ☐ Dr ☐ Other ☐

First name

ROBERT

Family name

GILMAN

Applicant 2:

Mr ☐ Ms ☐ Mrs ☐ Dr ☐ Other ☐

First name

Family name

ii) Where the Applicant is a corporate entity:

Company (if applicable)

ABN (if applicable)

Unit/Street no.

975

Street Name

BARRENJOEY Rd PALM BEACH

Suburb or town

PALM BEACH

State

NSW

Postcode

2108

Daytime telephone

Fax

Mobile

0419208735

Email

ROBERT.GILMAN@HOTMAIL.COM

SECTION B. Location and title details of the land where the building work or subdivision work is to be carried out

Unit/Street no. 975	Street Name BARRENJOEY RD		
Suburb or town PALM BEACH		State NSW	Postcode 2108
Lot no. 1	Section		
DP / SP no. 205296	Volume/folio		

SECTION C. Description of the building work or subdivision work to be carried out

Briefly describe the development. For example, if a dwelling is proposed, include information such as the type of building (house, townhouse, villa etc), the number of floors, the number of bedrooms, the major building material (brick, brick veneer, timber clad etc).

ALTERATIONS

Class(s) of building(s) under the Building Code of Australia

1/a

SECTION D. Estimated cost of the development

No CHANGE
\$

The contract price, or if there is no contract a genuine and accurate estimate, for all labour and material costs associated with all demolition and construction required for the development, including the cost of construction of any building and the preparation of a building for the purpose for which it is to be used (such as the costs of installing plant, fittings, fixtures and equipment). GST is also to be included.

SECTION E. Development consent

Date of development consent (if already granted)	5/8/2005 12 November 2014
Development consent reference no.	N0099/05 Section 96 N009/05/s.96/1
Name of consent authority:	Pittwater Council
Name of applicant for development consent	Robert Gilman

Provide:

A copy of the development consent, including:

- approved plans endorsed by the consent authority
- conditions of development consent
- other documents referenced by the development consent that are relevant to this Application.

Application for a modified construction certificate

SECTION F. Planning agreements

If the development or the land upon which the development is to be carried out is subject to a planning agreement as referred to in section 93F EP&A Act, provide a copy of the planning agreement.

SECTION G. Attachments relating to the proposed development

Applicants must provide the documents listed below that are relevant to the type of development that is proposed. Please place a cross in the appropriate box(s) to indicate the type of development involved. Confirm with our office how many copies of each document are required prior to lodging this Application.

1. Does the Application relate ONLY to a FIRE LINK CONVERSION? ☐ Yes ☐ No

If Yes-provide:

A document that describes the design and construction and mode of operation of the new fire alarm communication link.

2. Does the development involve SUBDIVISION WORK? ☐ Yes ☐ No

If Yes-provide:

Appropriate subdivision work plans and specifications, which include copies of:

- (a) details of the existing and proposed subdivision pattern (including the number of lots and the location of roads)
- (b) details as to which public authorities have been consulted with as to the provision of utility services to the land concerned
- (c) detailed engineering plans as to the following matters:
 - (i) earthworks
 - (ii) roadworks
 - (iii) road pavement
 - (iv) road furnishings
 - (v) stormwater drainage
 - (vi) water supply works
 - (vii) sewerage works
 - (viii) landscaping works
 - (ix) erosion control works
- (d) copies of any compliance certificates to be relied on.

3. BUILDINGS

3.1 Does the development involve building work (including in relation to a dwelling house or building or structure ancillary to a dwelling house)? ☐ Yes ☐ No

If Yes-provide:

(1) A detailed description of the development, indicating:

- (a) for each proposed new building:
 - (i) the number of storeys (including underground storeys) in the building
 - (ii) the gross floor area of the building (in square metres)
 - (iii) the gross site area of the land on which the building is to be erected (in square metres)
- (b) for each proposed new residential building:
 - (i) the number of existing dwellings on the land on which the new building is to be erected
 - (ii) the number of those existing dwellings that are to be demolished in connection with the erection of the new building
 - (iii) the number of dwellings to be included in the new building
 - (iv) whether the new building is to be attached to any existing building
 - (v) whether the new building is to be attached to any other new building
 - (vi) whether the land contains a dual occupancy
 - (vii) the materials to be used in the construction of the new building by completing the table in SECTION M

(2) Appropriate building work plans and specifications, which include copies of:

- (a) detailed plans, drawn to a suitable scale and consisting of a block plan and a general plan, that show:
























- (i) a plan of each floor section
- (ii) a plan of each elevation of the building
- (iii) the levels of the lowest floor and of any yard or unbuilt on area belonging to that floor and the levels of the adjacent ground
- (iv) the height, design, construction and provision for fire safety and fire resistance (if any)
- (b) specifications for the development:
 - (i) that describe the construction and materials of which the building is to be built and the method of drainage, sewerage and water supply, and
 - (ii) that state whether the materials to be used are new or second-hand and (in the case of second-hand materials) give particulars of the materials to be used
- (c) a statement as to how the performance requirements of the *Building Code of Australia* are to be complied with (if an alternative solution, to meet the performance requirements, is to be used)
- (d) a description of any accredited building product or system sought to be relied on for the purposes of section 79C(4) of the *Environmental Planning and Assessment Act 1979* (EP&A Act)*
- (e) copies of any compliance certificate to be relied on
- (f) if the development involves building work to alter, expand or rebuild an existing building, a scaled plan of the existing building
- (g) if a BASIX certificate has been obtained for the development, such other matters as the BASIX certificate requires to be included in the plans and specifications.

* S.79C(4) EP&A Act provides that a consent authority must not refuse to grant consent to development on the ground that any building product or system relating to the development does not comply with a requirement of the *Building Code of Australia* if the building product or system is accredited in respect of that requirement in accordance with the EP&A regulations 2000.

3.2 Does the development involve building work (other than work in relation to a dwelling-house or a building or structure that is ancillary to a dwelling-house or work that relates only to fire link conversion)? ☐ Yes ☐ No

If Yes-provide:

- (a) A list of any existing fire safety measures provided in relation to the land or any existing building on the land.
- (b) A list of the proposed fire safety measures to be provided in relation to the land and any building on the land as a consequence of the building work.

3.3 Does the development involve an alternative solution under the Building Code of Australia ("BCA") in respect of a fire safety requirement? ☐ Yes ☐ No

If Yes-provide:

Either or both of the following from a "fire safety engineer" (a private accredited certifier holding Category C10 accreditation):

- (a) A compliance certificate (as referred to in s.109C(1)(a)(v) EP&A Act) that certifies that the alternative solution complies with the relevant performance requirements of the BCA.
- (b) A written report that includes a statement that the alternative solution complies with the relevant requirements of the BCA.

Note: The above requirement only applies to building work in respect of:

- (a) a class 9a building that is proposed to have a total floor area of 2000 square metres or more
- (b) any building (other than a class 9a building) that is proposed to have:
 - (i) a fire compartment with a total floor area of more than 2000 square metres or
 - (ii) a total floor area of more than 6000 square metres

that involves an alternative solution under the BCA in respect of the requirements set out in EP1.4, EP2.1, EP2.2, DP4 and DP5 in Volume 1 of the BCA.

3.4 Does the Application relate to a residential flat development for which the development application was required under Clause 50(1A) of the EP&A Regulation to be accompanied by a design verification from a qualified designer? ☐ Yes ☐ No

If Yes-provide:

A statement from a qualified designer which verifies that the plans and specifications achieve or improve the design quality of the development for which development consent was granted, having regard to the design quality principles set out in Part 2 of *State Environmental Planning Policy No. 65: Design Quality of Residential Flat Development* (SEPP 65)

Note: If the development application was also required to be accompanied by a BASIX certificate with respect to any building, the statement need not verify the design quality principles set out in SEPP 65 to the extent to which they aim to:

- reduce consumption of mains-supplied potable water, or reduce emissions of greenhouse gases, in the building or in the use of the land that it is built on, or
- improve the thermal performance of the building

3.5 Has the Fire Commissioner granted an exemption under clause 188 EP&A Regulation from compliance with any specified Category 3 fire safety provision?
☐ Yes ☐ No

If Yes-provide:

A copy of the exemption together with any conditions imposed.

3.6 Is any long service payment levy payable under s.34 of the Building and Construction Industry Long Service Payments Act 1986? ☐ Yes ☐ No

If Yes-provide:

A copy of a receipt for any long service payment levy that has been made (or, where such a levy is payable by instalments, a receipt for the first instalment of the levy).

Where a council is the certifying authority, the levy may be made to the council when this Application is lodged.

3.7 Does the Application involve a BASIX affected development, or a BASIX optional development for which a BASIX certificate has been obtained? ☐ Yes ☐ No

If Yes-provide:

The BASIX certificate(s) for the development (being either the BASIX certificate issued when the development consent was granted or some other BASIX certificate(s) that have been issued no earlier than three months before the date of the Application being made), and such other documents as the BASIX certificate(s) for the development requires to accompany the Application.

BASIX (the Building and Sustainability Index) ensures homes are built to be more energy and water efficient. BASIX uses an online program to assess a building's design and compares it against energy and water reduction targets. The design must meet these targets before a BASIX certificate can be issued. Any changes made to a building's design after a BASIX certificate has been issued requires another BASIX assessment and new BASIX certificate. "BASIX affected buildings" contain one or more dwellings (but do not include hotels or motels).

A BASIX certificate **MUST** be obtained for every "BASIX affected development", which are any of the following (other than development that is "BASIX excluded development"):

- (a) development that involves the erection (but not the relocation) of a BASIX affected building
- (b) development that involves a change of building use by which a building becomes a BASIX affected building
- (c) development that involves the alteration, enlargement or extension of a BASIX affected building, where the estimated construction cost of the development is \$50,000 or more
- (d) development for the purpose of a swimming pool or spa, or combination of swimming pools and spas, that services or service only one dwelling and that has a capacity, or combined capacity, of 40,000 litres or more.

"BASIX excluded development" is

- (a) development for the purpose of a garage, storeroom, car port, gazebo, verandah or awning
- (b) alterations, enlargements or extensions to a building listed on the State Heritage Register under the Heritage Act 1977
- (c) alterations, enlargements or extensions that result in a space that cannot be fully enclosed (for example, a veranda that is open or enclosed by screens, mesh or other materials that permit the free and uncontrolled flow of air), other than a space can be fully enclosed but for a vent needed for the safe operation of a gas appliance
- (d) alterations, enlargements or extensions that the Director-General has declared, by order published in the Gazette, to be BASIX excluded development.

A BASIX Certificate **MAY** be obtained for certain developments by an Applicant even though there is no obligation to do so. This is called "BASIX optional development". "BASIX optional development" means any of the following development that is not BASIX excluded development:

- (a) development that involves the alteration, enlargement or extension of a BASIX affected building, where the estimate of the construction cost of the development is less than \$50,000
- (b) development for the purpose of a swimming pool or spa, or combination of swimming pools and spas, that services or service only one dwelling and that has a capacity, or combined capacity, of less than 40,000 litres.

If the proposed development involves the alteration, enlargement or extension of a BASIX affected building that contains more than one dwelling, a separate BASIX certificate is required for each dwelling concerned.

Further information about BASIX and to obtain a BASIX Certificate, go to <http://www.basix.nsw.gov.au>

SECTION H. List of documents

Prepare and attach a list of all of the documents to be provided under SECTIONS E, F and G above and as may otherwise be advised as required.

SECTION I. Authority to enter and inspect land


A certifying authority must not issue a modified construction certificate for development on a site which affects an existing building unless the certifying authority, or an accredited certifier, council or consent authority on behalf of the certifying authority, has carried out an inspection of the site of the development.

If the Applicant is the owner of the land, by signing this Application authority is given to the certifying authority, or an accredited certifier, council or consent authority, to enter the subject property at any reasonable time for the purpose of carrying out an inspection in connection with the assessment of this Application. The Applicant undertakes to take all necessary steps make access available to the property to enable the inspection to be carried out.

If the Applicant is not the owner of the land, the owner(s) must sign the following statement.

As the owner(s) of the above property, I/we consent to the certifying authority, or an accredited certifier, council or consent authority, to enter the subject property at any reasonable time for the purpose of carrying out an inspection in connection with the assessment of this Application. I/we undertake to take all necessary steps make access available to the property to enable the inspection to be carried out.

Owners Signature(s)

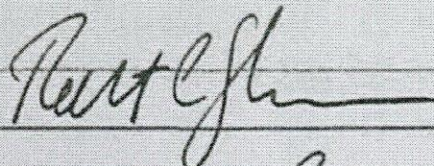

Name(s)

ROBERT C. GILMAN

Date

2/9/15

SECTION J. Delivery of the Application


Applications for construction certificates must be delivered by hand, by post or transmitted electronically to this office at:

- Level 2, 41 Rawson Street, Epping NSW 2121; or
- PO Box 375, Strathfield NSW 2135; or
- info@boycecorp.com.au

Applications MAY NOT be sent by facsimile transmission.

SECTION K. Signature of Applicant(s)

Signature of Applicant(s)

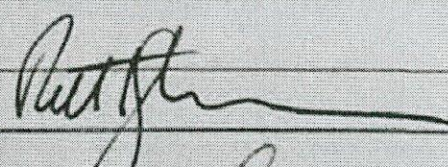

Name(s)

ROBERT C. GILMAN

Date

2/9/15

SECTION L. Date of Receipt of Application

To be completed by the certifying authority immediately after receiving this Application.

This Application was received on (insert date).

SECTION M. Development statistics

Place a cross in each appropriate box.

Walls	Code	Roof	Code	Floor	Code	Frame	Code
☐ Brick (double)	11	☐ Tiles	10	☐ Concrete/slate	20	☐ Timber	40
☐ Brick (veneer)	12	☐ Concrete/slate	20	☐ Timber	40	☐ Steel	60
☐ Concrete/stone	20	☐ Fibre cement	30	☐ Other	80	☐ Aluminium	70
☐ Fibre cement	30	☐ Steel	60	☐ Not specified	90	☐ Other	80
☐ Timber	40	☐ Aluminium	70			☐ Not specified	90
☐ Curtain glass	50	☐ Other	80				
☐ Steel	60	☐ Not specified	90				
☐ Aluminium cladding	70						
☐ Timber/ weatherboard	40						
☐ Other	80						
☐ Not specified	90						

Gross site area (m²)

Number of dwellings to be demolished

Gross floor area of existing building (m²)

Number of dwellings to be constructed

Gross floor area of new building work (m²)

Will the new building be attached to an existing building

Number of pre-existing dwellings on the site

Does the site contain a dual occupancy

How many storeys will the building have

What are the current uses of the building

What will be the new building uses (if changed)

DRAWING LIST				
Sheet Number	Sheet Name	current amendment	current amendment description	Sheet Issue Date
01	COVER SHEET			28.08.15
02	SITE PLAN			28.08.15
03	DEMOLITION PLAN			28.08.15
04	LOWER/GROUND FLOOR PLANS			28.08.15
05	GARAGE FLOOR LEVEL			28.08.15
06	ELEVATIONS			28.08.15
07	CROSS SECTION			28.08.15
08	LONG SECTION			28.08.15
09	SAFETY IN DESIGN			28.08.15

NOTE:


THESE PLANS ARE TO BE READ IN CONJUNCTION WITH:

1. THE APPROVED DEVELOPMENT APPLICATION/ CONSTRUCTION CERTIFICATE PREPARED BY JO GILLIES ARCHITECT, DA N0099/05, CC 0148/05

2. THE APPROVED MODIFICATION OF DEVELOPMENT CONSENT PREPARED BY NIC PYNER, S96 CONSENT NO. N0099/05/S96/1

3. ANY PREVIOUS AND/OR NEW OR MODIFIED ENGINEERING DETAIL DRAWINGS WHICH WERE A INCLUDED IN PREVIOUS APPLICATIONS

AND ARE SUBJECT TO THE LOCAL PITTWATER COUNCIL CONDITIONS OF CONSENT

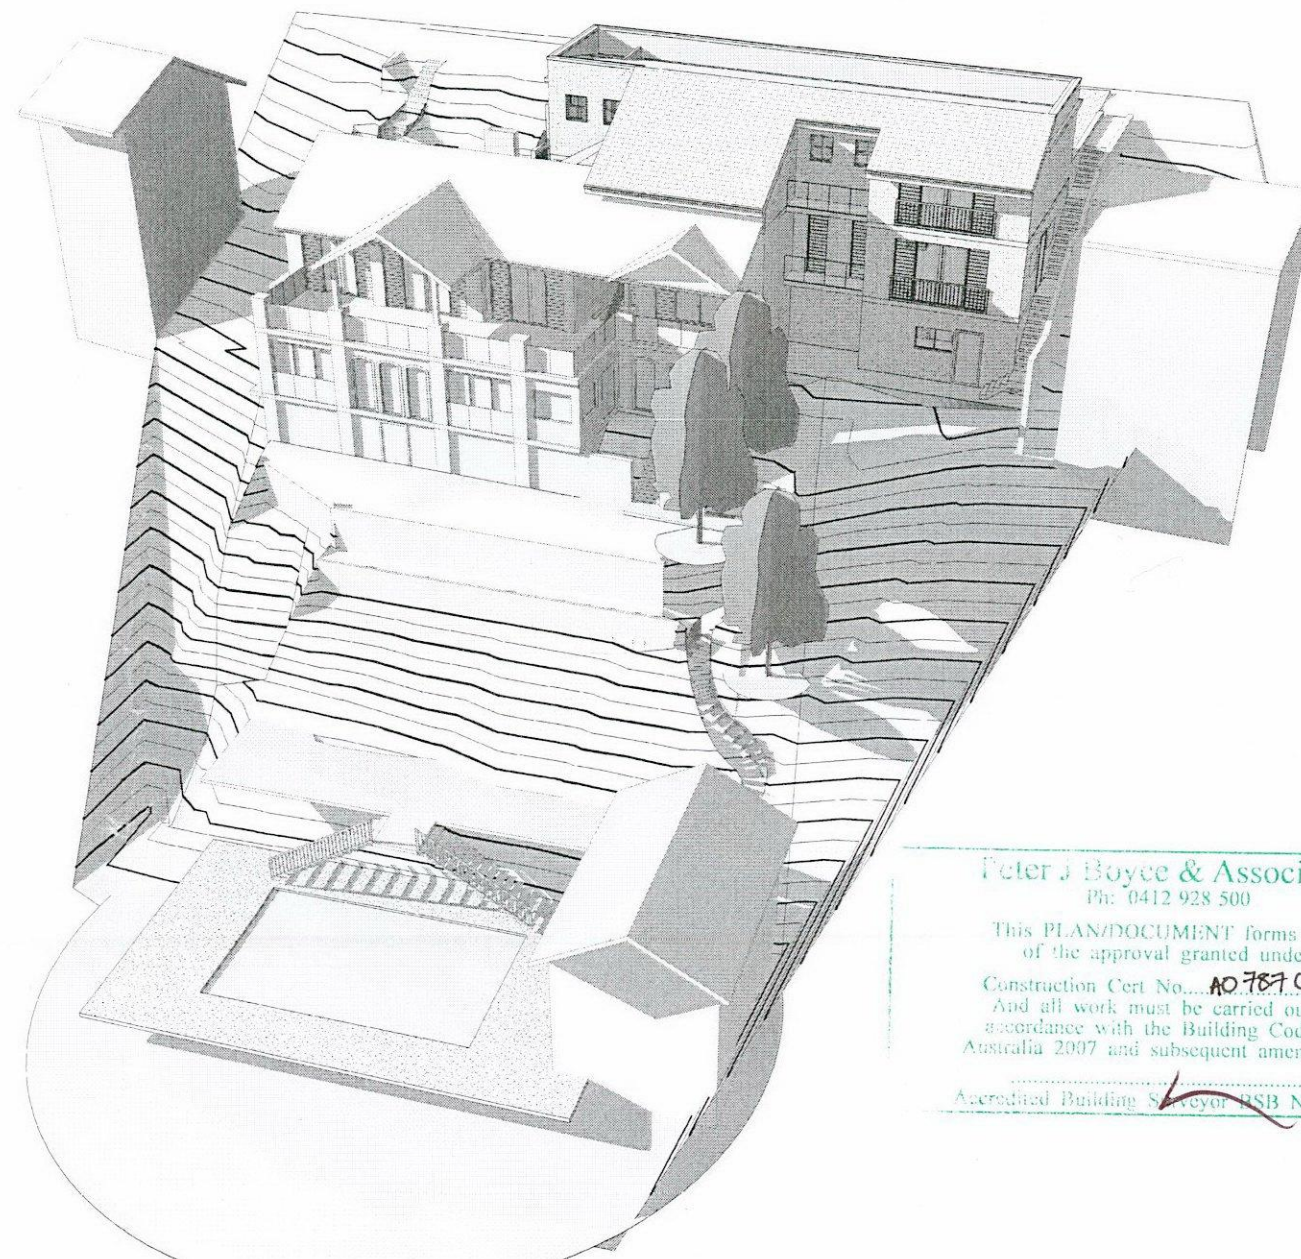

Peter J Boyce & Associates
Ph: 0412 928 500

This PLAN/DOCUMENT forms part of the approval granted under
Construction Cert No. AO 787 LM
And all work must be carried out in accordance with the Building Code of Australia 2007 and subsequent amendments

Accredited Building Surveyor BSB No. 0043

ALTERATIONS AND ADDITIONS TO EXISTING RESIDENCE

FOR
MRS D GILMAN

AT
975 BARRENJOEY ROAD, PALM BEACH

28.08.2015

14_38

jmh
living design

ABN 41 280 852 669

Principal

John Hatch
Accredited Building Designer
Member no. 6025 NSW

President Building Designers
Australia NSW Chapter

Chartered fellow member
Building Designers Australia
NSW Chapter

National council member
Building Designers Australia

Member Master Builders
Association

M 0447 681 736
E john@jmlivingdesign.com.au
W www.jmlivingdesign.com.au

Office

O 1st floor 8 Park Lane Caringbah
NSW 2229

P po box 74 Caringbah NSW 1495

T (02) 9540 3626

F (02) 9525 8339


W www.jmlivingdesign.com.au




W www.mba.nsw.au



W www.bda.org.au

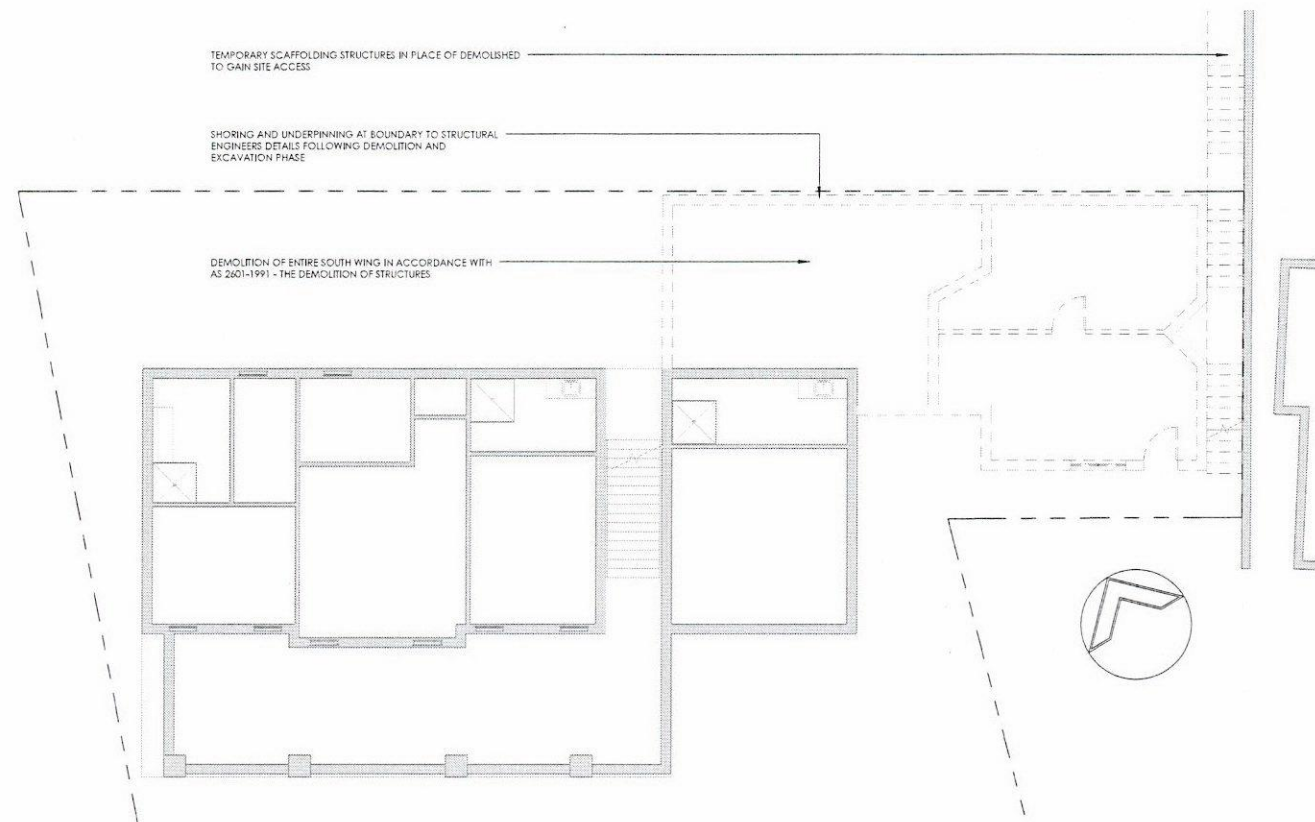

1 01 LOWER DEMOLITION
1:100

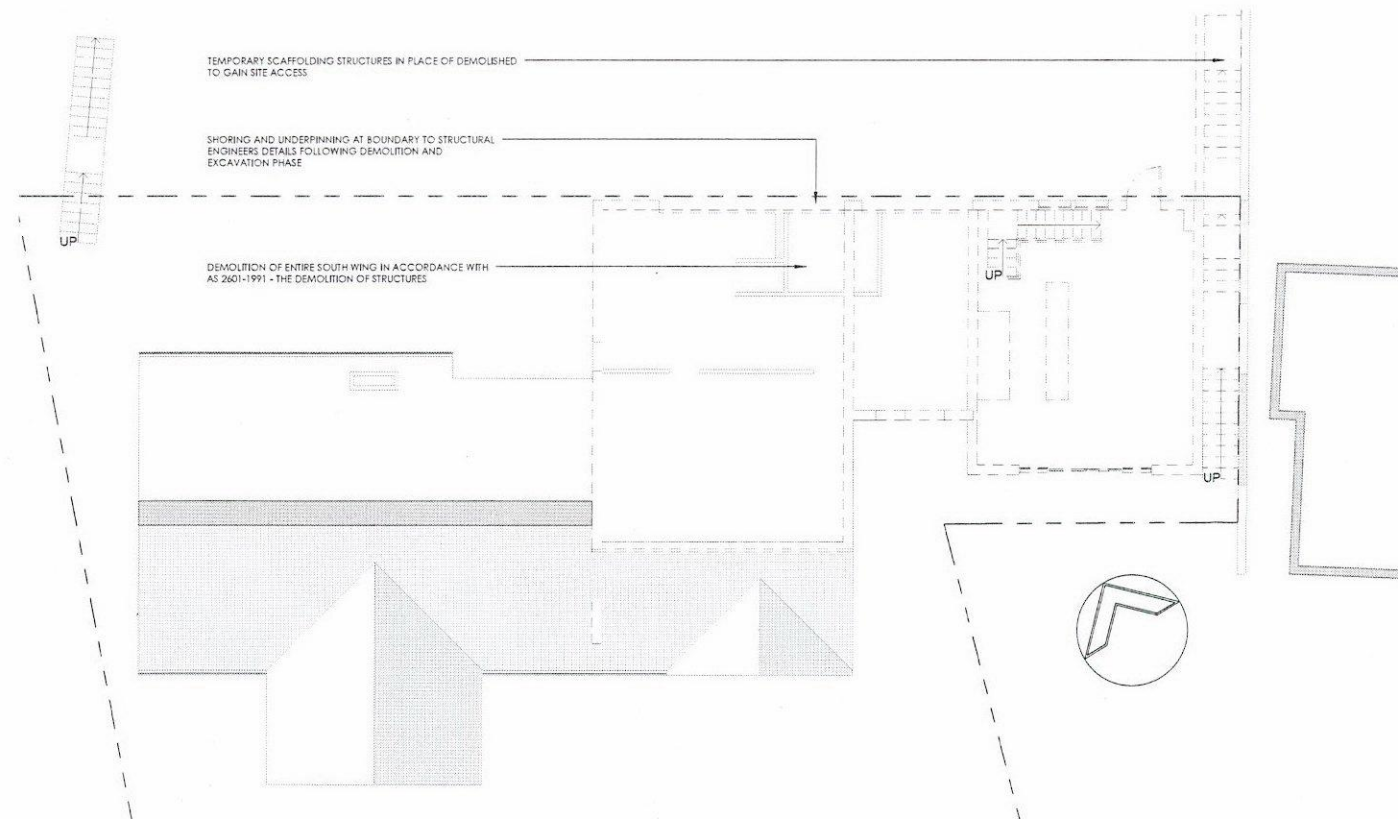

2 02 UPPER DEMOLITION
1:100

3 PRELIMINARY NOTES

SEE SITE
The client is advised to visit the site of the proposed alterations and additions before tendering. They must satisfy themselves as to the nature and extent of all the work to be done as no extra will be allowed for necessary work unless by the builder through lack of having taken this precaution.

NOTIFICATION OF BUILDING
The client must notify the building for demolition information regarding parts and portions which are to be altered, demolished or removed, and the nature and extent of all the work to be done as no extra will be allowed for necessary work unless by the builder through lack of having taken this precaution.

DRAWINGS
Where any item of work is not wholly indicated on the drawings, the builder shall in the execution of the work, complete same to correspond with existing work of a similar nature. In making alterations to the existing building, the builder must necessarily be guided by existing work to determine its location or position on drawings.

INSURANCES
The builder shall take out policies for the amounts as follows:
* Public Liability Insurance \$ 20,000,000.00
* Workers Compensation and Employers Liability Insurance \$ 20,000,000.00
* Contract Works Insurance Full replacement of materials on site.

WORKMANSHIP AND MATERIALS
The whole of the work shall be faithfully executed in the most workmanlike manner. All materials shall be new and of the best quality of their respective kinds. Except where otherwise stated, the standard of quality shall be that which would comply with the relevant S.A.A. code. All work shall be completed to the satisfaction of the proprietor.

DAMAGED WORK
Any work damaged as a result of the execution of this contract shall be repaired to a state equivalent to the existing adjacent undamaged work of a similar nature.

BARRETS ETC.
The builder shall provide, erect and maintain all necessary temporary hoardings, screens, barriers, carways etc. together with night lighting for the protection of the public, land and property and of the completion of the work, all of these items shall remain to the requirements of the relevant authorities. They shall be erected prior to the commencement of demolition or building operations.

CLEAN UP
The premises and site affected by this contract shall be cleaned up on completion and all debris removed from the site and building. Clean all new glass and leave premises through clean and fit for occupation.

PRE CAUTION DURING DEMOLITION
The builder shall be responsible to and shall take precautions to support or stay the partly completed structure until it is completed or until it has developed through fabrication or curing, its full working strength.

VARIATIONS
No variation of any kind will be allowed or paid for without written order for each item signed by the proprietor. The cost of any variation will be agreed upon, before work is put in hand.

BUILDER'S LICENSE
The builder shall provide proof to the proprietor that he holds a current builder's licence.

DEMOLITION
The work of demolition shall be executed in a careful and orderly manner. Property shall be supported and temporarily support all work that the builder may decide requires support. Working shall conform to standard methods. Cut away, break down, take up and remove in relation to those way for new work.

PROTECTION
All openings made in the existing building during the progress of the work shall be made and kept waterproof by means of tarpaulins or other approved manner until the affected portions are completed.

Peter J Boyce & Associates
Ph: 0412 928 500

This PLAN/DOCUMENT forms part
of the approval granted under
Construction Cert No. 10767 (U)
And all work must be carried out in
accordance with the Building Code of
Australia 2007 and subsequent amendments

Surveyor No. 0043

AMENDMENTS
DRAWING TITLE
DEMOLITION PLAN

CONSTRUCTION CERTIFICATE

PROJECT
ALTERATIONS AND ADDITIONS TO
EXISTING RESIDENCE

ADDRESS
975 BARRENJOEY ROAD, PALM
BEACH

CLIENT
MRS D GILMAN

Date: 28.08.2015

Drawing No: 14_38

Sheet No: 03

Scale: 1:100

Drawn: JS

Checked: JMH

jmh
living design
ABN: 41 280 952 869
Principal
John Welch
Accredited Building Designer
Member no. 6025 NSW

President Building Designers
Australia NSW Chapter
Chartered fellow member Building
Designers Australia NSW Chapter


National council member Building
Designers Australia
Member Master Builders Association
M 0417 681 734
E john@jmlivingdesign.com.au
W www.jmlivingdesign.com.au

Office
O 1/11 Bloor & Park Lane Carlingbah
NSW 2229
P po box 74 Carlingbah NSW 1495
F (02) 9540 3626
F (02) 9525 8339
W www.jmlivingdesign.com.au

This set of drawings is subject to copyright
and may not be used or copied without the
consent of JMH Living Design.

28/08/2015 8:45:14 AM
Master Builders Association
bda BUILDING DESIGNERS AUSTRALIA

W www.jmhlivingdesign.com.au
W www.bda.org.au

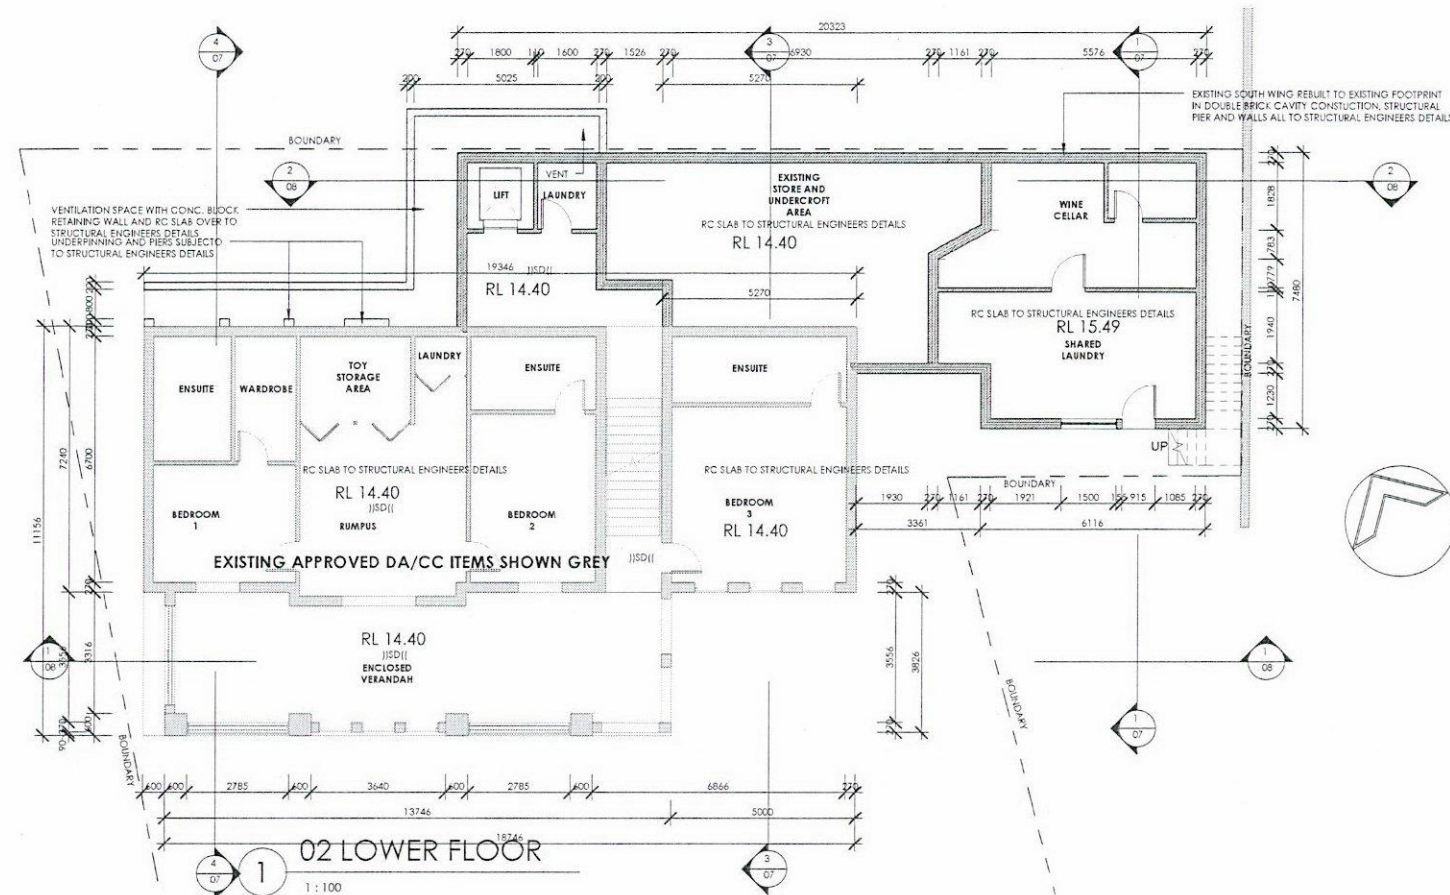

PROTECTION OF OPENABLE WINDOWS

- EXTRACT FROM NCC VOL 1 SECTION D ACCESS AND EGRESS, CLAUSE 2.24 AND NCC VOL 2 SAFE MOVEMENT AND ACCESS, PART 3.9.2.5
Protection of openable windows
- (a) A window opening must be provided with protection, if the floor below the window is 2 m or more above the surface beneath it—
(i) a bedroom in a Class 2 or 3 building or Class 4 part of a building; or
(ii) a Class 9a early childhood centre.
- (b) Where the lowest level of the window opening is less than 1.7 m above the floor, a window opening covered by (a) must comply with the following:
(i) The openable portion of the window must be protected with—
(A) a device capable of restricting the window opening; or
(B) a screen with secure fittings.
(ii) A device or screen required by (i) must—
(A) not permit a 125 mm sphere to pass through the window opening or screen; and
(B) resist an outward horizontal action of 250 N against the—
(aa) window restrained by a device; or
(bb) screen protecting the opening; and
(C) have a child resistant release mechanism if the screen or device is able to be removed, unlocked or overridden.
- (c) A barrier with a height not less than 865 mm above the floor is required to an openable window—
(i) in addition to window protection, when a child resistant release mechanism is required by (b)(i)(C); and
(ii) where the floor below the window is 4 m or more above the surface beneath it if the window is not covered by (a).
- (d) A barrier covered by (c) must not—
(i) permit a 125 mm sphere to pass through it; and
(ii) have any horizontal or near horizontal element between 150 mm and 760 mm above the floor that facilitate climbing.

GENERAL NOTES

- 3 JSD(I) DENOTES LOCATION OF APPROVED SMOKE DETECTORS TO BE INSTALLED IN ACCORDANCE WITH BCA PART 3.7.4
- STORMWATER TO BE DIRECTED TO RAINWATER TANK TO BE INSTALLED. COLLECTED RAINWATER TO BE RE-USED FOR GARDENS AND TOILET & LAUNDRY. OVERFLOW TO BE DIRECTED TO THE STREET
- RC SLABS, SUSPENDED RC SLABS, PIERS, BEAMS & FOOTINGS TO STRUCTURAL ENGINEER'S DETAILS
- ALL EXTERNAL WINDOW AND DOORS TO BE SELECTED BY CLIENT AND ARE SUBJECT TO MANUFACTURERS STANDARD WINDOW AND DOOR SEES. WINDOWS AND DOORS WILL BE MANUFACTURED BY SYDNEY WOODWORKERS WINDOWS+DOORS AND ARE SUBJECT TO MANUFACTURERS SPECIFICATIONS AND INSTALLATION REQUIREMENTS AND SHALL ADHERE TO CONTROLS SET OUT BY THE AMENDED BASIX CERTIFICATE (A201718_02, DATED 9 OCTOBER 2014)

Peter J Boyce & Associates
Ph: 0412 928 500

This PLAN/DOCUMENT forms part of the approval granted under Construction Cert No. **10767 CM** And all work must be carried out in accordance with the Building Code of Australia 2007 and subsequent amendments

Accredited Building Surveyor BSB No. 0043

AMENDMENTS
DRAWING TITLE
LOWER/GROUND FLOOR PLANS

CONSTRUCTION CERTIFICATE

PROJECT
ALTERATIONS AND ADDITIONS TO EXISTING RESIDENCE

ADDRESS
975 BARRENJOEY ROAD, PALM BEACH

CLIENT
MRS D GILMAN

Date: 28.08.2015

Drawing No: 14_38

Sheet No: 04

Scale: 1:100

Drawn: JS

Checked: JMH

The whole works to be in accordance with the Building Code of Australia, all relevant Australian Standards, and all other governing authorities concerned.

All dimensions to be in millimetres unless otherwise stated.

Use written dimensions in preference to scaled dimensions.

The builder to check all dimensions on site prior to the commencement of work.

No responsibility will be accepted by JMH Living Design for builders details, methods, setup or design contradictions, nor council variations and conditions.

This set of drawings is subject to copyright and may not be used or copied without the consent of JMH Living Design.

28/08/2015 8:45:16 AM

Master Builders Association

Building Designers Australia

jmh
living design

ABN: 41 280 552 869

Principal
John Welch

Accredited Building Designer
Member no. 6025 NSW

President Building Designers
Australia NSW Chapter

Chartered Fellow member Building
Designers Australia NSW Chapter

National council member Building
Designers Australia

Member Master Builders Association
NSW 2229

E john@jmhlivingdesign.com.au

W www.jmhlivingdesign.com.au

Office

O 1st floor 8 Park Lane Caringbah


NSW 2229

P PO Box 74 Caringbah NSW 1595

T (02) 9540 3626

F (02) 9523 8339

W www.jmhlivingdesign.com.au

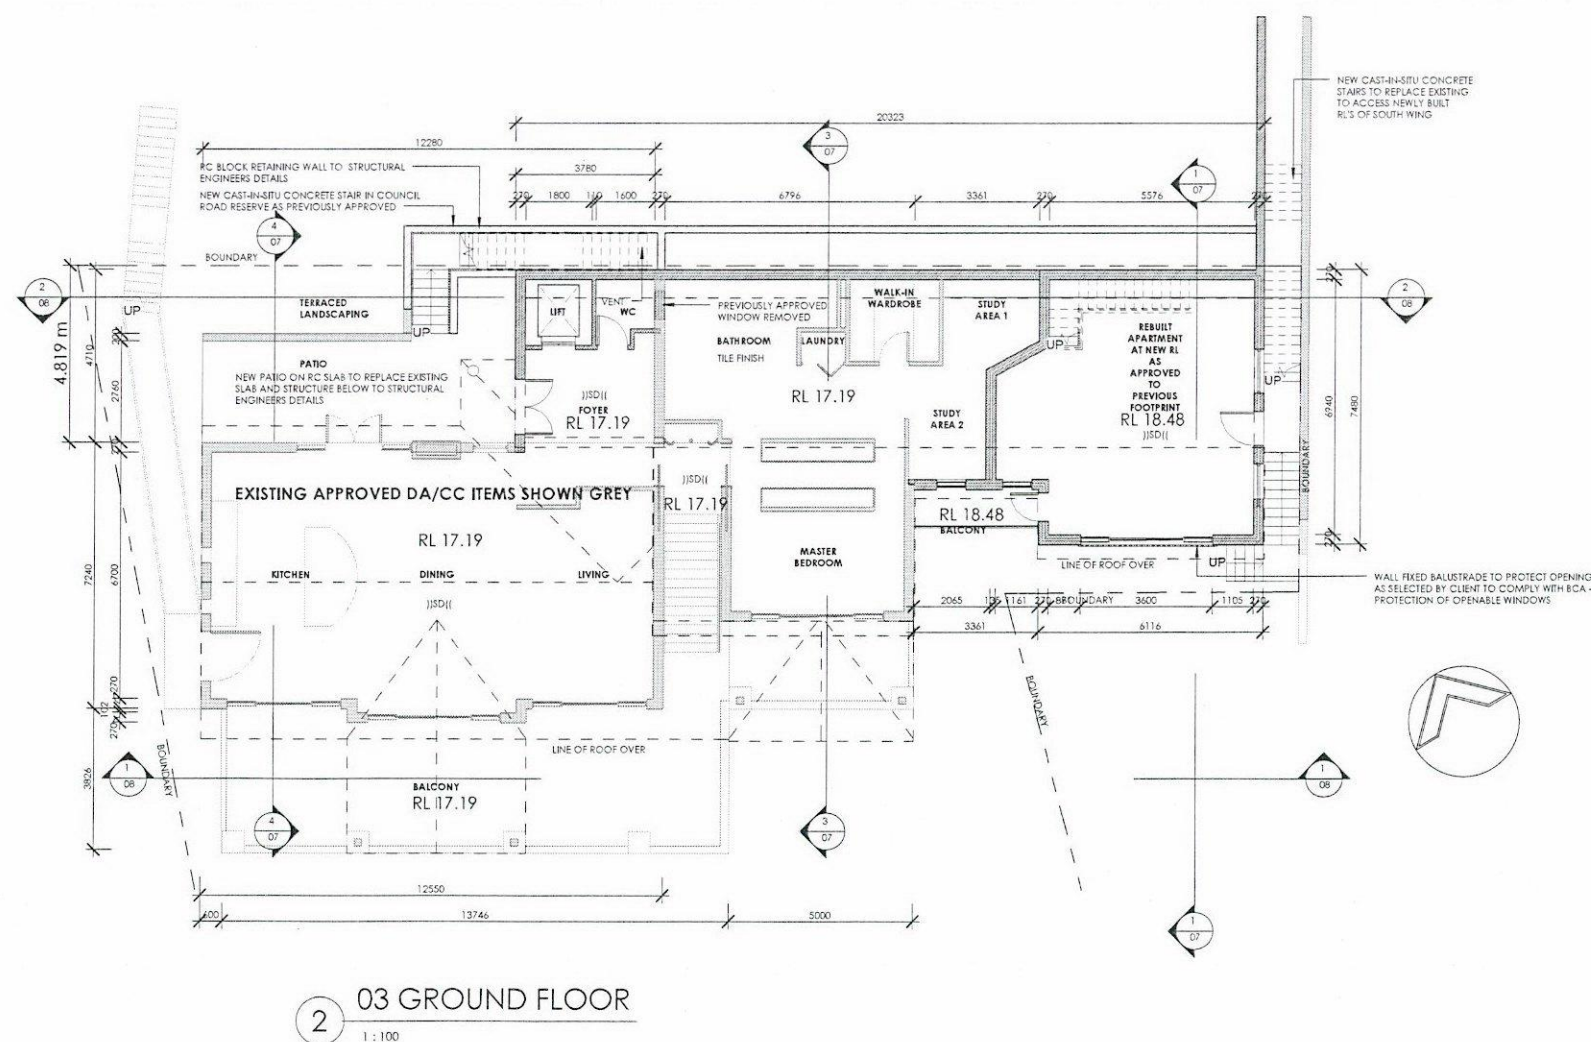

PROTECTION OF OPENABLE WINDOWS

EXTRACT FROM NCC VOL 1 SECTION D ACCESS AND EGRESS, CLAUSE 2.2.4
AND NCC VOL 2 SAFE MOVEMENT AND ACCESS, PART 3.9.2.5

Protection of openable windows

- (a) A window opening must be provided with protection, if the floor below the window is 2 m or more above the surface beneath it—
- (i) a bedroom in a Class 2 or 3 building or Class 4 part of a building; or
 - (ii) a Class 9b early childhood centre.
- (b) Where the lowest level of the window opening is less than 1.7 m above the floor, a window opening covered by (a) must comply with the following:
- (i) The openable portion of the window must be protected with—
 - (A) a device capable of restricting the window opening; or
 - (B) a screen with secure fittings.
 - (ii) A device or screen required by (i) must—
 - (A) not permit a 125 mm sphere to pass through the window opening or screen; and
 - (B) resist an outward horizontal action of 250 N against the—
 - (aa) window restrained by a device; or
 - (bb) screen protecting the opening; and
 - (C) have a child resistant release mechanism if the screen or device is able to be removed, unlocked or overridden.
 - (c) A barrier with a height not less than 865 mm above the floor is required to an openable window—
 - (i) in addition to window protection, when a child resistant release mechanism is required by (b)(ii)(C); and
 - (ii) where the floor below the window is 4 m or more above the surface beneath it if the window is not covered by (a).
 - (d) A barrier covered by (c) must not—
 - (i) permit a 125 mm sphere to pass through it; and
 - (ii) have any horizontal or near horizontal elements between 150 mm and 760 mm above the floor that facilitate climbing.

Peter J Boyce & Associates
Ph: 0412 928 500

This PLAN/DOCUMENT forms part
of the approval granted under
Construction Cert No. **10767CM**
And all work must be carried out in
accordance with the Building Code of
Australia 2007 and subsequent amendments

Registered Building Surveyor BSB No. 0043

AMENDMENTS
DRAWING TITLE

GARAGE FLOOR LEVEL

CONSTRUCTION CERTIFICATE

PROJECT
ALTERATIONS AND ADDITIONS TO
EXISTING RESIDENCE

ADDRESS
975 BARRENJOEY ROAD, PALM
BEACH

CLIENT
MRS D GILMAN

Date: 28.08.2015

Drawing No: 14_38

Sheet No: 05

Scale: 1 : 100

Drawn: JS

Checked: JMH

The whole work to be in accordance with the Building Code of Australia, all relevant Australian Standards, and all other governing authorities concerned.

All dimensions to be in millimetres unless otherwise stated.

Use written dimensions in preference to scaled dimensions.

The builder to check all dimensions on site prior to the commencement of work.

No responsibility will be accepted by JMH Living Design for building a structure, materials, layout or design contraventions, nor council variations and conditions.

This set of drawings is subject to copyright and may not be used or copied without the consent of JMH Living Design.

jmh
living design

ABN: 41 280 852 889
Principal
John Welch
Accredited Building Designer
Member no. 6025 NSW

President Building Designers
Australia NSW Chapter

Chartered fellow member Building
Designers Australia NSW Chapter

National council member Building
Designers Australia

Member Master Builders Association
NSW 2229

M 0417 681 734
E john@jmhlivingdesign.com.au
W www.jmhlivingdesign.com.au

O 1/1 Rock & Park Lane Carlingbah
NSW 2229

P po box 74 Carlingbah NSW 1495
T (02) 9440 3626
F (02) 9525 8397
W www.jmhlivingdesign.com.au

28/08/2015 8:45:17 AM

A1

Master Builders Association
NSW

bda BUILDING DESIGNERS AUSTRALIA

W www.mba.org.au

W www.bda.org.au

07 HEIGHT LIMIT OF UPPER ROOF
25.330 RL

06 (A) NEW GARAGE LEVEL
21.420 RL


05 (A) NEW LEVEL UNDER GARAGE
18.480 RL

03 GROUND FLOOR
17.190 RL

02 (A) WINE CELLAR LEVEL
15.490 RL

02 LOWER FLOOR
14.400 RL

01 UNDERCROFT
12.200 RL

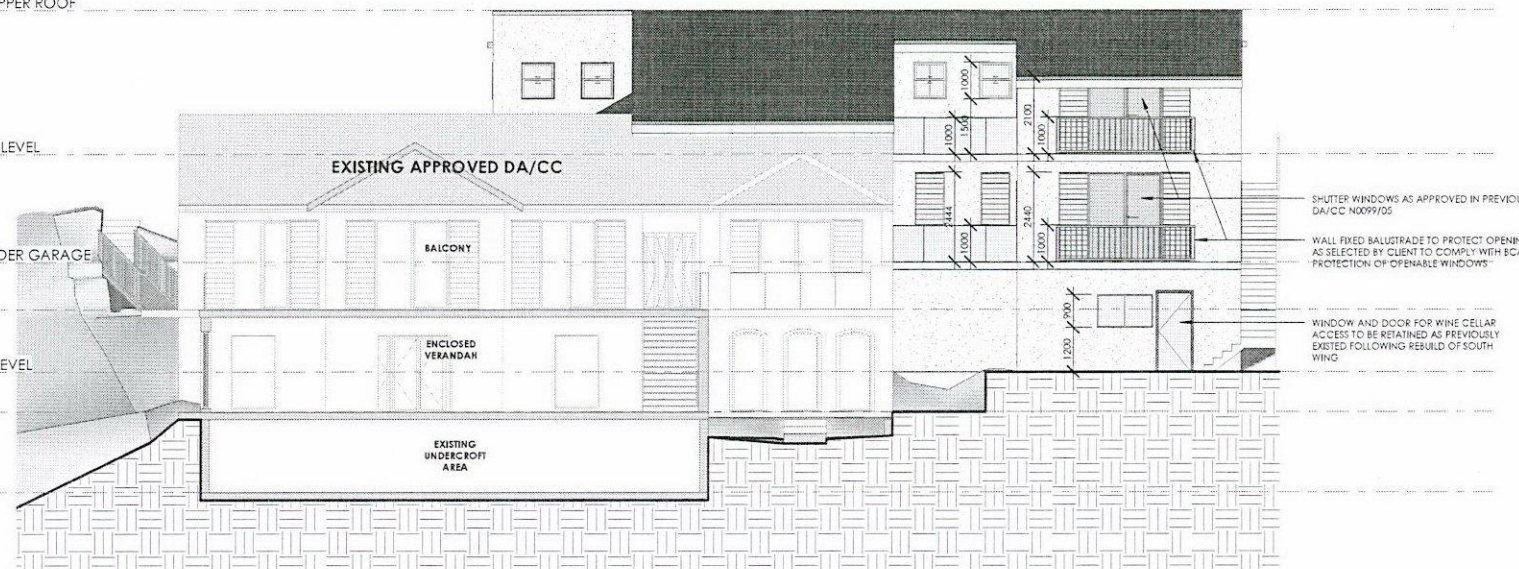

1 LONG SECTION - COVERED VERANDAH/UNDERCROFT AREA
1:100

PROTECTION OF OPENABLE WINDOWS

EXTRACT FROM NCC VOL 1 SECTION D ACCESS AND EGRESS, CLAUSE 2.24
AND NCC VOL 2 SAFE MOVEMENT AND ACCESS, PART 3.9.2.5
Protection of openable windows

- (a) A window opening must be provided with protection, if the floor below the window is 2 m or more above the surface beneath it—
- (i) a bedroom in a Class 2 or 3 building or Class 4 part of a building; or
 - (ii) a Class 9a early childhood centre.
- (b) Where the lowest level of the window opening is less than 1.7 m above the floor, a window opening covered by (a) must comply with the following:
- (i) The openable portion of the window must be protected with—
 - (A) a device capable of restricting the window opening; or
 - (B) a screen with secure fittings.
 - (ii) A device or screen required by (i) must—
 - (A) not permit a 125 mm sphere to pass through the window opening or screen; and
 - (B) resist an outward horizontal action of 250 N against the—
 - (aa) window restrained by a device; or
 - (bb) screen protecting the opening; and
 - (C) have a child resistant release mechanism if the screen or device is able to be removed, unlocked or overridden.
- (c) A barrier with a height not less than 865 mm above the floor is required to an openable window—
- (i) in addition to window protection, when a child resistant release mechanism is required by (b)(ii)(C); and
 - (ii) where the floor below the window is 4 m or more above the surface beneath it if the window is not covered by (a).
- (d) A barrier covered by (c) must not—
- (i) permit a 125 mm sphere to pass through it; and
 - (ii) have any horizontal or near horizontal elements between 150 mm and 760 mm above the floor that facilitate climbing.

Peter J. Boyce & Associates
Ph: 0412 928 500

This PLAN/DOCUMENT forms part
of the approval granted under
Construction Cert No. 10 767 (M)
And all work must be carried out in
accordance with the Building Code of
Australia 2007 and subsequent amendments

Accredited Building Surveyor BSB No. 0043

AMENDMENTS
DRAWING TITLE

LONG SECTION

CONSTRUCTION CERTIFICATE

PROJECT

ALTERATIONS AND ADDITIONS TO
EXISTING RESIDENCE

ADDRESS

975 BARRENJOEY ROAD, PALM
BEACH

CLIENT

MRS D GILMAN

Date:

28.08.2015

Drawing No:

14_38

Sheet No:

08

Scale:

1:100

Drawn:

JS

Checked:

JMH

The whole works to be in accordance with
the Building Code of Australia, all relevant
Australian Standards, and all other governing
authorities concerned.

All dimensions to be in millimetres unless
otherwise stated.

Use written dimensions in preference to
scaled dimensions.

The builder to check all dimensions on site
prior to the commencement of work.

No responsibility will be accepted by JMH
Living Design for builders details, methods,
sequence or design contradictions, nor sound
variation and conditions.

This set of drawings is subject to copyright
and may not be used or copied without the
consent of JMH Living Design.

jmh
living design

AKR 41 280 552 889
Principal
John Welch
Accredited Building Designer
Member no. 6025 NSW

President Building Designers
Australia NSW Chapter

Chartered fellow member Building
Designers Australia NSW Chapter

National council member Building
Designers Australia

Member Master Builders Association
NSW 2229

P 60 Box 74 Collingwood NSW 1595
T (02) 9540 3626
F (02) 9525 8337
W www.jmhlivingdesign.com.au

28/08/2015 8:45:27 AM

A1

Master
Builders
Association

bdc
BUILDING
DESIGNERS
AUSTRALIA

1. FALLS, SLIPS, TRIPS

a) WORKING AT HEIGHTS

DURING CONSTRUCTION

Wherever possible, components for this building should be prefabricated off-site or at ground level to minimise the risk of workers falling more than two metres. However, construction of this building will require workers to be working at heights where a fall in excess of two metres is possible and injury is likely to result from such a fall. The builder should provide a suitable barrier wherever a person is required to work in a situation where falling more than two metres is a possibility.

DURING OPERATION OR MAINTENANCE

For houses or other low-rise buildings where scaffolding is appropriate:

Cleaning and maintenance of windows, walls, roof or other components of this building will require persons to be situated where a fall from a height in excess of two metres is possible. Where this type of activity is required, scaffolding, ladders or trestles should be used in accordance with relevant codes of practice, regulations or legislation.

For buildings where scaffold, ladders, trestles are not appropriate: Cleaning and maintenance of windows, walls, roof or other components of this building will require persons to be situated where a fall from a height in excess of two metres is possible. Where this type of activity is required, scaffolding, fall barriers or Personal Protective Equipment (PPE) should be used in accordance with relevant codes of practice, regulations or legislation.

b) SLIPPERY OR UNEVEN SURFACES

FLOOR FINISHES Specified

If finishes have been specified by designer, these have been selected to minimise the risk of floors and paved areas becoming slippery when wet or when walked on with wet shoes/feet. Any changes to the specified finish should be made in consultation with the designer or, if this is not practical, surfaces with an equivalent or better slip resistance should be chosen.

FLOOR FINISHES By Owner

If designer has not been involved in the selection of surface finishes, the owner is responsible for the selection of surface finishes in the pedestrian trafficable areas of this building. Surfaces should be selected in accordance with AS HB 197:1999 and AS/NZ 4586:2004.

STEPS, LOOSE OBJECTS AND UNEVEN SURFACES

Due to design restrictions for this building, steps and/or ramps are included in the building which may be a hazard to workers carrying objects or otherwise occupied. Steps should be clearly marked with both visual and tactile warning during construction, maintenance, demolition and at all times when the building operates as a workplace.

Building owners and occupiers should monitor the pedestrian access ways and in particular access to areas where maintenance is routinely carried out to ensure that surfaces have not moved or cracked so that they become uneven and present a trip hazard. Spills, loose material, stray objects or any other matter that may cause a slip or trip hazard should be cleaned or removed from access ways.

Contractors should be required to maintain a tidy work site during construction, maintenance or demolition to reduce the risk of trips and falls in the workplace. Materials for construction or maintenance should be stored in designated areas away from access ways and work areas.

2. FALLING OBJECTS

LOOSE MATERIALS OR SMALL OBJECTS

Construction, maintenance or demolition work on or around this building is likely to involve persons working above ground level or above floor levels. Where this occurs one or more of the following measures should be taken to avoid objects falling from the area where the work is being carried out onto persons below.

1. Prevent or restrict access to areas below where the work is being carried out.
2. Provide toeboards to scaffolding or work platforms.
3. Provide protective structure below the work area.
4. Ensure that all persons below the work area have Personal Protective Equipment (PPE).

BUILDING COMPONENTS

During construction, renovation or demolition of this building, parts of the structure including fabricated steelwork, heavy panels and many other components will remain standing prior to or after supporting parts are in place. Contractors should ensure that temporary bracing or other required support is in place at all times when collapse which may injure persons in the area is a possibility.

Mechanical lifting of materials and components during construction, maintenance or demolition presents a risk of falling objects. Contractors should ensure that appropriate lifting devices are used, that loads are properly secured and that access to areas below the load is prevented or restricted.

3. TRAFFIC MANAGEMENT

For building on a major road, narrow road or steeply sloping road: Parking of vehicles or loading/unloading of vehicles on this roadway may cause a traffic hazard. During construction, maintenance or demolition of this building designated parking for workers and loading areas should be provided. Trained traffic management personnel should be responsible for the supervision of these areas.

For building where on-site loading/unloading is restricted:

Construction of this building will require loading and unloading of materials on the roadway. Deliveries should be well planned to avoid congestion of loading areas and trained traffic management personnel should be used to supervise loading/unloading areas.

For all buildings:

Busy construction and demolition sites present a risk of collision where deliveries and other traffic are moving within the site. A traffic management plan supervised by trained traffic management personnel should be adopted for the work site.

4. SERVICES

GENERAL

Rupture of services during excavation or other activity creates a variety of risks including release of hazardous material. Existing services are located on or around this site. Where known, these are identified on the plans but the exact location and extent of services may vary from that indicated. Services should be located using an appropriate service (such as Dial Before You Dig), appropriate excavation practice should be used and, where necessary, specialist contractors should be used.

Locations with underground power:

Underground power lines MAY be located in or around this site. All underground power lines must be disconnected or carefully located and adequate warning signs used prior to any construction, maintenance or demolition commencing.

Locations with overhead power lines:

Overhead power lines MAY be near or on this site. These pose a risk of electrocution if struck or approached by lifting devices or other plant and persons working above ground level. Where there is a danger of this occurring, power lines should be, where practical, disconnected or relocated. Where this is not practical adequate warning in the form of bright coloured tape or signage should be used or a protective barrier provided.

5. MANUAL TASKS

Components within this design with a mass in excess of 25kg should be lifted by two or more workers or by mechanical lifting device. Where this is not practical, suppliers or fabricators should be required to limit the component mass.

All material packaging, building and maintenance components should clearly show the total mass of packages and where practical all items should be stored on site in a way which minimises bending before lifting. Advice should be provided on safe lifting methods in all areas where lifting may occur. Construction, maintenance and demolition of this building will require the use of portable tools and equipment. These should be fully maintained in accordance with manufacturer's specifications and not used where faulty or (in the case of electrical equipment) not carrying a current electrical safety tag. All safety guards or devices should be regularly checked and Personal Protective Equipment should be used in accordance with manufacturer's specification.

6. HAZARDOUS SUBSTANCES

ASBESTOS

For alterations to a building constructed prior to 1990: If this existing building was constructed prior to 1990 - it therefore may contain asbestos 1986 - it therefore is likely to contain asbestos either in cladding material or in fire retardant insulation material. In either case, the builder should check and, if necessary, take appropriate action before demolishing, cutting, sanding, drilling or otherwise disturbing the existing structure.

POWDERED MATERIALS

Many materials used in the construction of this building can cause harm if inhaled in powdered form. Persons working on or in the building during construction, operational maintenance or demolition should ensure good ventilation and wear Personal Protective Equipment including protection against inhalation while using powdered material or when sanding, drilling, cutting or otherwise disturbing or creating powdered material.

TREATED TIMBER

The design of this building may include provision for the inclusion of treated timber within the structure. Dust or fumes from this material can be harmful. Persons working on or in the building during construction, operational maintenance or demolition should ensure good ventilation and wear Personal Protective Equipment including protection against inhalation of harmful material when sanding, drilling, cutting or using treated timber in any way that may cause harmful material to be released. Do not burn treated timber.

VOLATILE ORGANIC COMPOUNDS

Many types of glue, solvents, spray packs, paints, varnishes and some cleaning materials and disinfectants have dangerous emissions. Areas where these are used should be kept well ventilated while the material is being used and for a period after installation. Personal Protective Equipment may also be required. The manufacturer's recommendations for use must be carefully considered at all times.

SYNTHETIC MINERAL FIBRE

Fibreglass, rockwool, ceramic and other material used for thermal or sound insulation may contain synthetic mineral fibre which may be harmful if inhaled or if it comes in contact with the skin, eyes or other sensitive parts or the body. Personal Protective Equipment including protection against inhalation of harmful material should be used when installing, removing or working near bulk insulation material.

TIMBER FLOORS

This building may contain timber floors which have an applied finish. Areas where finishes are applied should be kept well ventilated during sanding and application and for a period after installation. Personal Protective Equipment may also be required. The manufacturer's recommendations for use must be carefully considered at all times.

7. CONFINED SPACES

EXCAVATION

Construction of this building and some maintenance on the building will require excavation and installation of items within excavations. Where practical, installation should be carried out using methods which do not require workers to enter the excavation. Where this is not practical, adequate support for the excavated area should be provided to prevent collapse. Warning signs and barriers to prevent accidental or unauthorised access to all excavations should be provided.

ENCLOSED SPACES

For buildings with enclosed spaces where maintenance or other access may be required: Enclosed spaces within this building may present a risk to persons entering for construction, maintenance or any other purpose. The design documentation calls for warning signs and barriers to unauthorised access. These should be maintained throughout the life of the building. Where workers are required to enter enclosed spaces, air testing equipment and Personal Protective Equipment should be provided.

SMALL SPACES

For buildings with small spaces where maintenance or other access may be required: Some small spaces within this building will require access by construction or maintenance workers. The design documentation calls for warning signs and barriers to unauthorised access. These should be maintained throughout the life of the building. Where workers are required to enter small spaces they should be scheduled so that access is for short periods. Manual lifting and other manual activity should be restricted in small spaces.

8. PUBLIC ACCESS

Public access to construction and demolition sites and to areas under maintenance causes risk to workers and public. Warning signs and secure barriers to unauthorised access should be provided. Where electrical installations, excavations, plant or loose materials are present they should be secured when not fully supervised.

9. OPERATIONAL USE OF BUILDING
RESIDENTIAL BUILDINGS

This building has been designed as a residential building. If, at a later date, it is used or intended to be used as a workplace, the provisions of the Work Health and Safety Act 2011 or subsequent replacement Act should be applied to the new use.

10. OTHER HIGH RISK ACTIVITY

All electrical work should be carried out in accordance with Code of Practice: Managing Electrical Risks at the Workplace, AS/NZ 3012 and all licensing requirements. All work using Plant should be carried out in accordance with Code of Practice: Managing Risks of Plant at the Workplace. All work should be carried out in accordance with Code of Practice: Managing Noise and Preventing Hearing Loss at Work. Due to the history of serious incidents it is recommended that particular care be exercised when undertaking work involving steel construction and concrete placement. All the above applies.

Peter J. Boyce & Associates
Ph: 0412 928 500

This PLAN/DOCUMENT forms part
of the approval granted under
Construction Cert No. 10787 LM
And all work must be carried out in
accordance with the Building Code of
Australia 2007 and subsequent amendments

Accredited Building Surveyor BSB No. 0043

AMENDMENTS
DRAWING TITLE

SAFETY IN DESIGN

CONSTRUCTION CERTIFICATE

PROJECT

ALTERATIONS AND ADDITIONS TO
EXISTING RESIDENCE

ADDRESS

975 BARRENJOEY ROAD, PALM
BEACH

CLIENT

MRS D GILMAN

Date: 28.08.2015

Drawing No: 14_38

Sheet No: 09

Scale: 1 : 60

Drawn: JS

Checked: JMH

The whole work to be in accordance with the Building Code of Australia, all relevant Australian Standards, and all other governing authorities concerned.

All dimensions to be in millimetres unless otherwise stated.

Use written dimensions in preference to scaled dimensions.

The builder to check all dimensions on site prior to the commencement of work.

No responsibility will be accepted by JMH Living Design for builders' details, methods, labour or design contradictions, nor council variations and conditions.

This set of drawings is subject to copyright and may not be used or copied without the consent of JMH Living Design.

28/08/2015 8:45:27 AM

A1



W www.mba.org.au

W www.jmhlivingdesign.com.au

THESE NOTES MUST BE READ AND UNDERSTOOD BY ALL INVOLVED IN THE PROJECT.

THIS INCLUDES (but is not excluded to): OWNER, BUILDER, SUB-CONTRACTORS, CONSULTANTS, RENOVATORS, OPERATORS, MAINTENORS, DEMOLISHERS.